
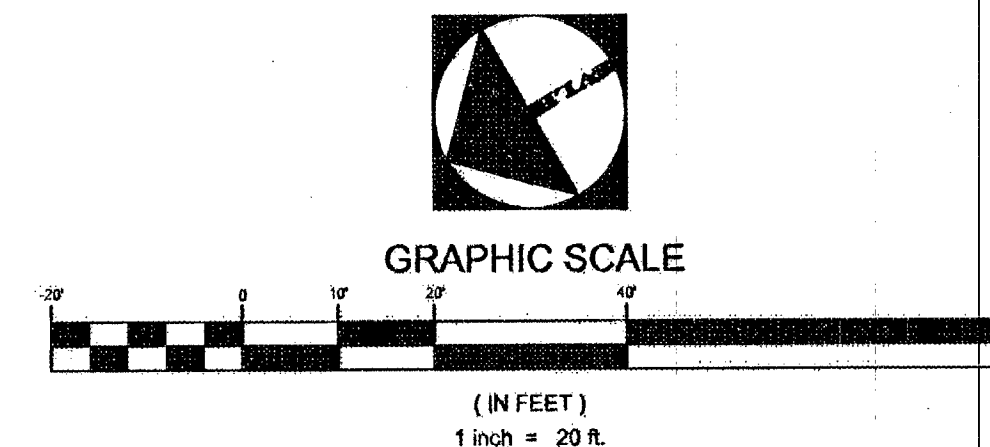


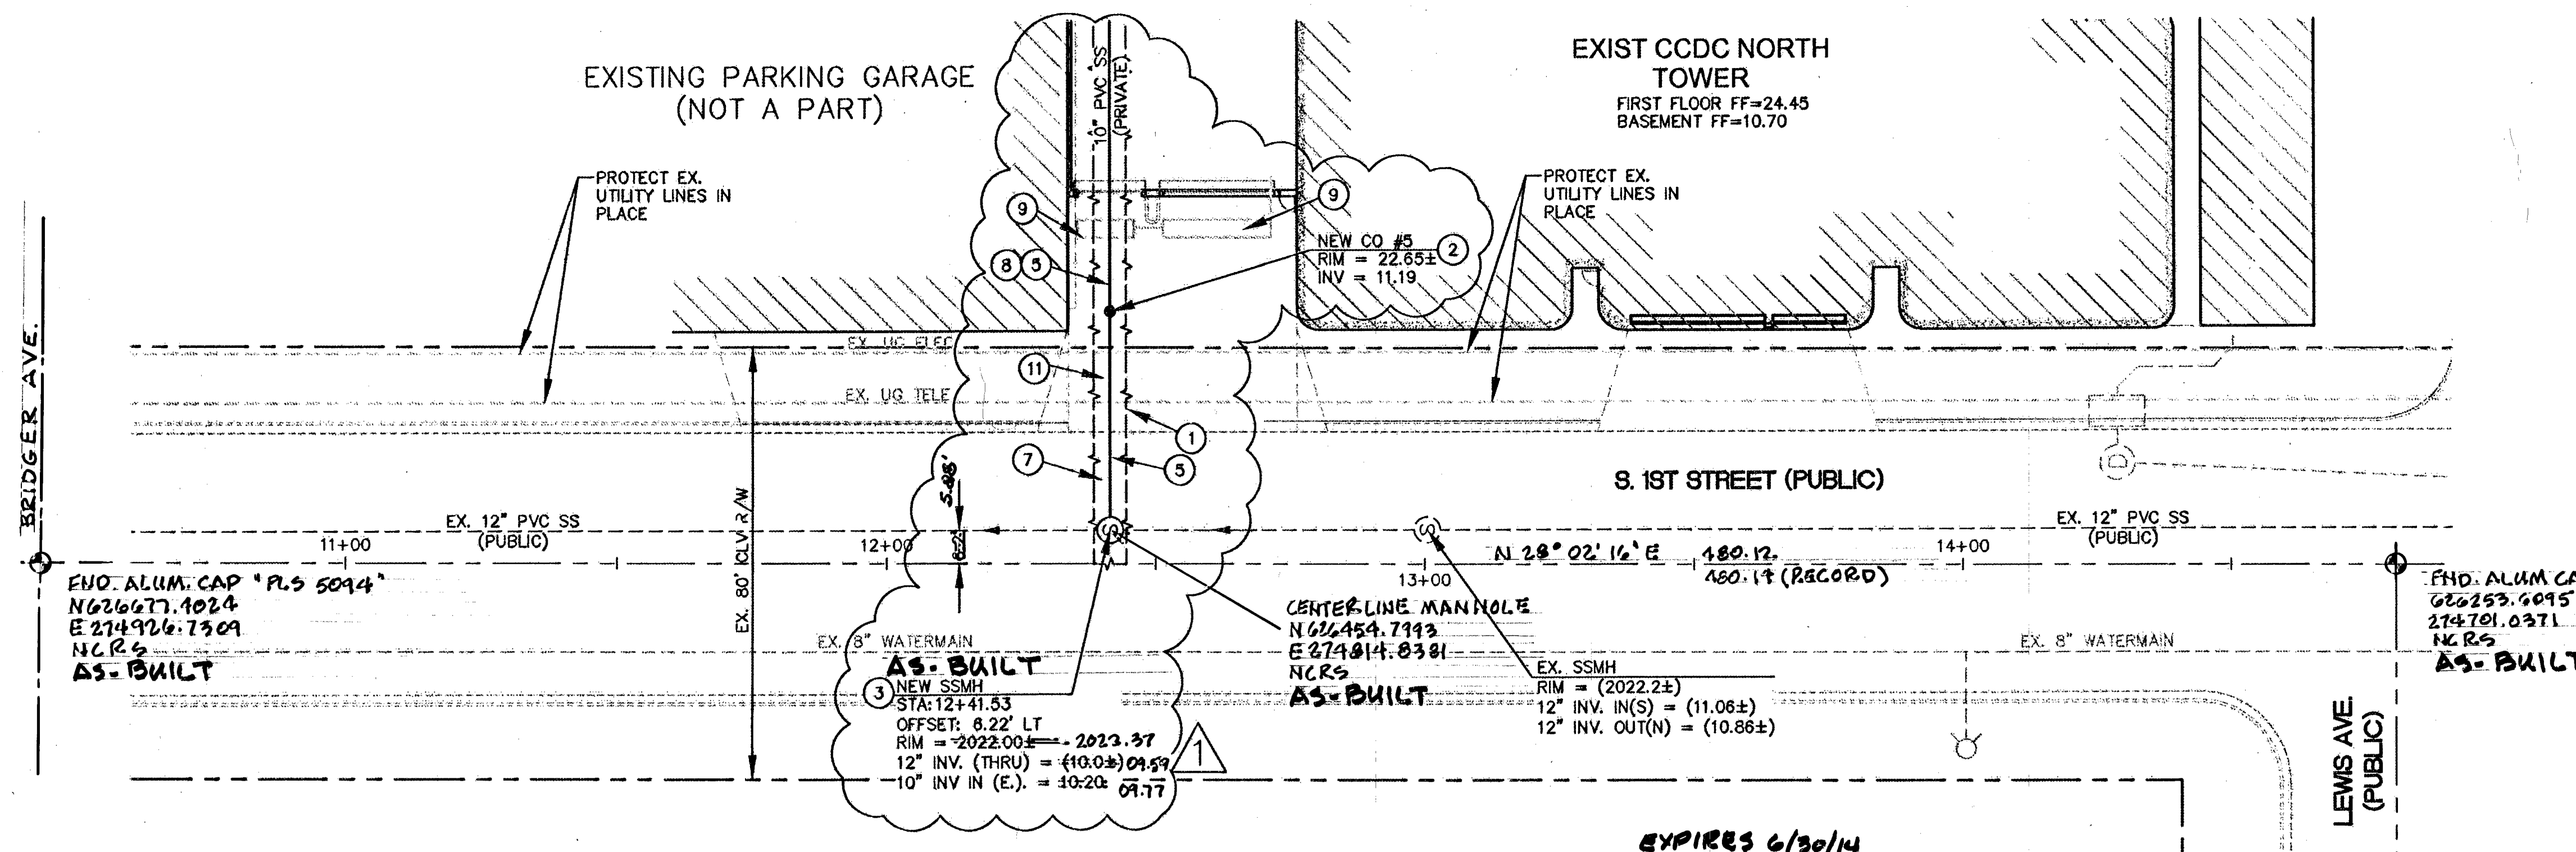


CONSTRUCTION NOTES



- SAWCUT EXISTING CONCRETE OR ASPHALT AND REMOVE AND PROPERLY DISPOSE OF FOR SEWER INSTALLATION.
- INSTALL 6\"/>

1ST STREET
SCALE: 1\"/>

EXPIRES 6/30/14

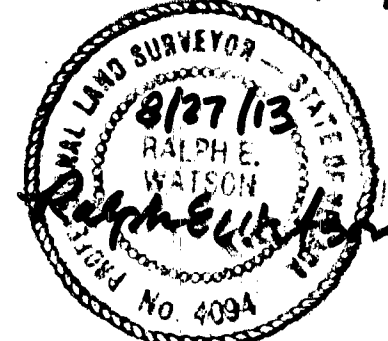


AS-BUILT INFORMATION ONLY

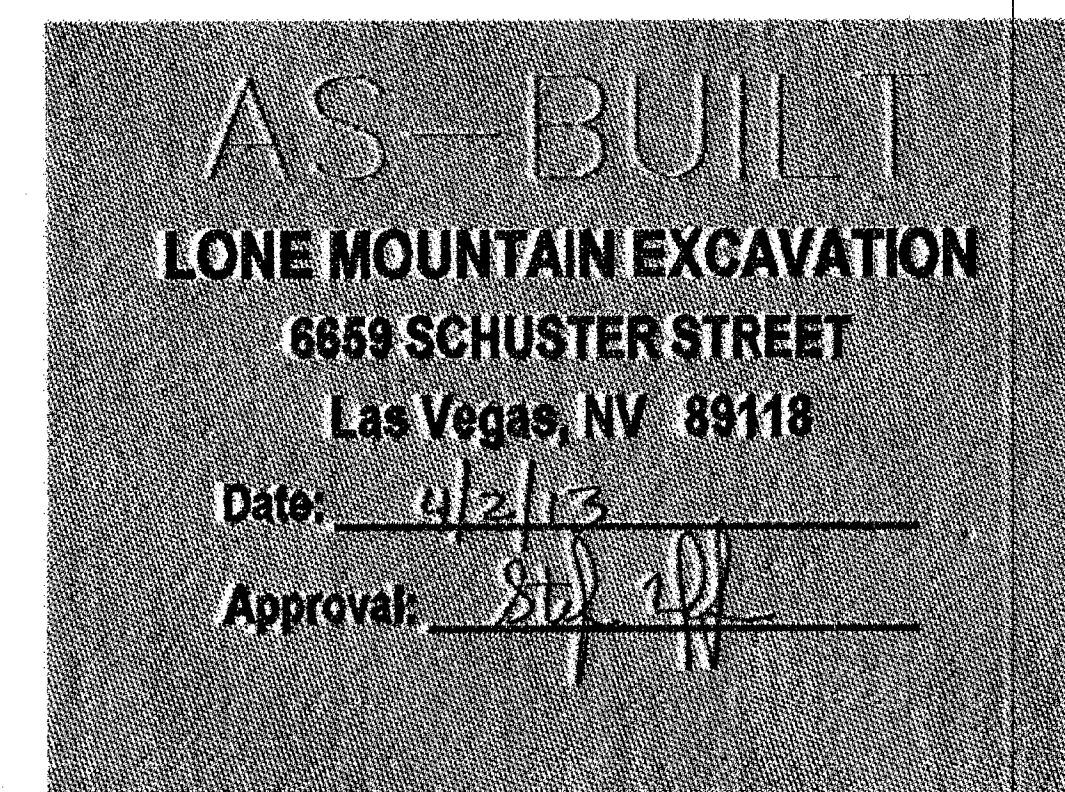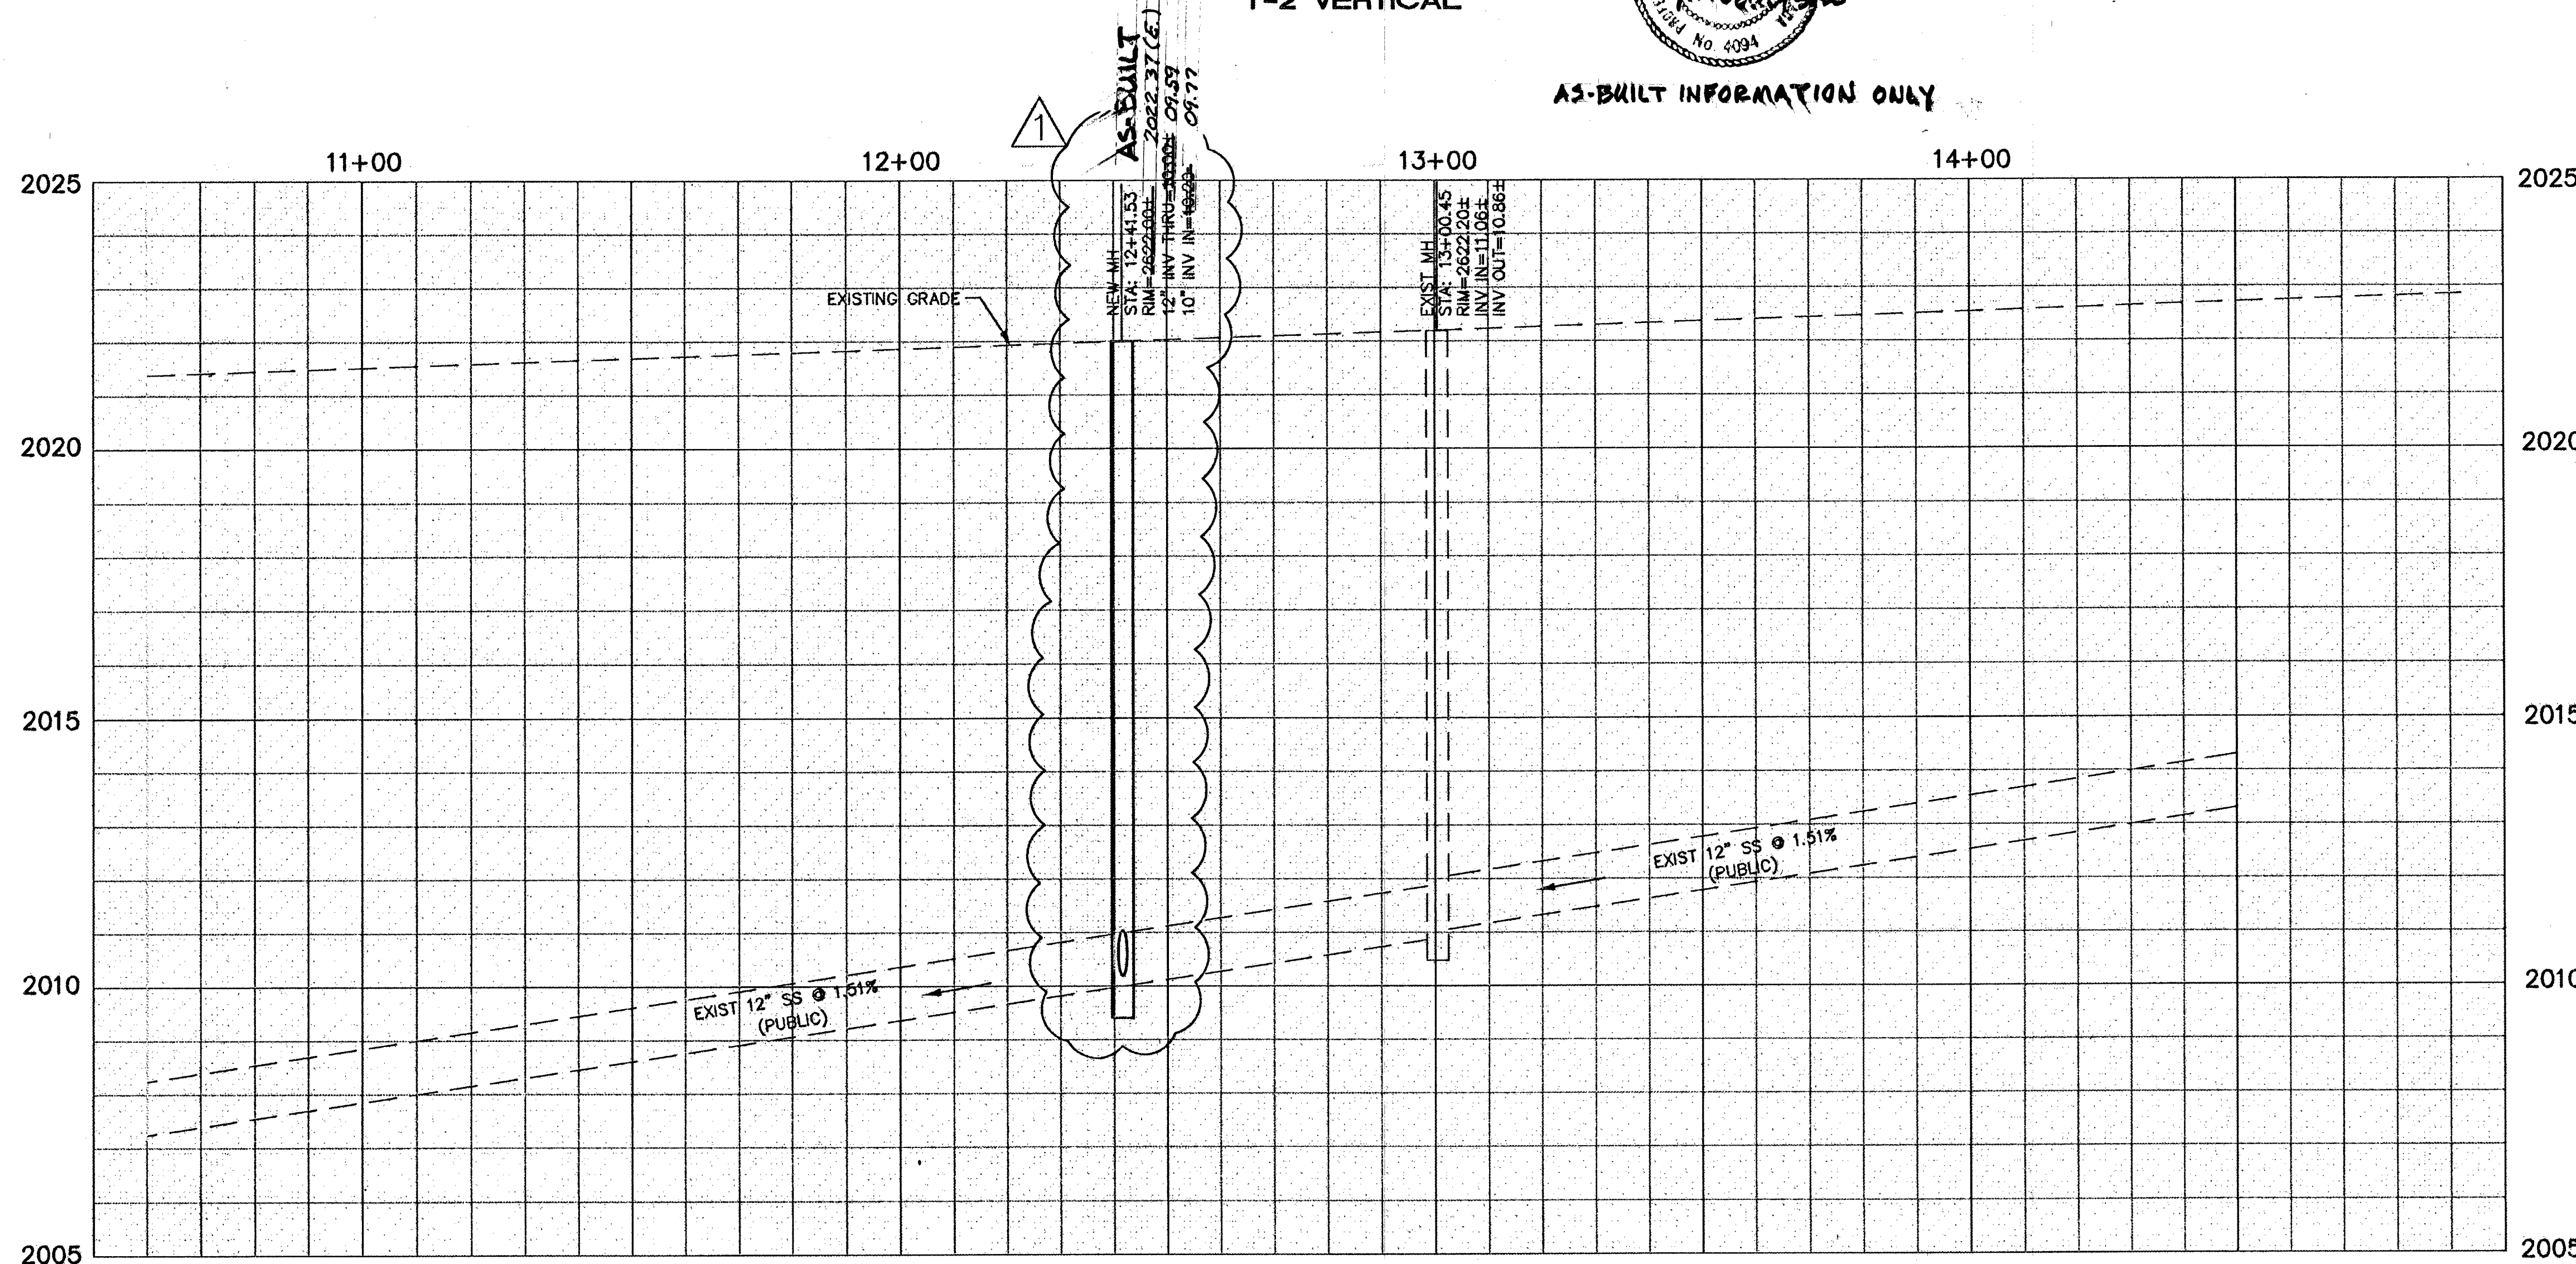

BASIS OF BEARING:
BEING THE CENTERLINE OF MAIN STREET PER PM FILE 97 PAGE 72 HAVING A BEARING OF N27°55'28\"/>

BENCHMARK:
3\"/>

NO.	DATE	REVISIONS	BY	APPROVAL
1	8-10-12	REVISED SEWER		

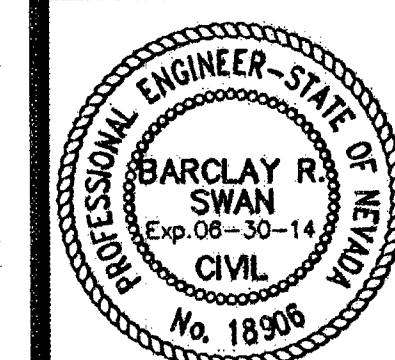

The WLB Group
Engineering, Architecture, Planning, Surveying
2251 N. Green Valley Pkwy., Suite 400
HENDERSON, NV 89014 (702) 498-2551

SHEET TITLE:
PLAN AND PROFILE SHEET

PROJECT:
CCDC NORTH TOWER RENOVATIONS

Scale:
Job No.: **412002-A001**
Date: **08/10/2012**
Drawn by: **AP**
Designed by: **BRS**
Checked by: **BRS**
Sheet: **4** of **5**

107V5765