


- NOTES**
1. ALL DIMENSIONS TO BACK OF CURB
 2. FOR GENERAL NOTES, SEE SHEET NO. 1
 3. FOR PLAN AND PROFILE, SEE SHEET NO. 3

APPROVED BY:	<i>[Signature]</i>	1-21-45
City Traffic Engineer		Date
REVISIONS		
DATE	DESCRIPTION	APPROVED
3/8/66	* 17+84.10 TO 15+53.36 CHANGED C&G AND ISLAND ALIGNMENT (SEE DWG NO. 107V594A-SHEET 10A)	<i>[Signature]</i>
VOORHEIS-TRINDLE CO. OF NEVADA 953A E. SAHARA AVE., SUITE 28B, LAS VEGAS, NEV.		
EASTERN AVENUE CONSTRUCTION CONTROL PLAN From Sta. 9151.45 to Sta. 13+53.36		
SUBMITTED BY:	<i>[Signature]</i>	
Victor G. Kramelbauer		R.C.E. 1511
APPROVED BY:	<i>[Signature]</i>	2-12-45
City Engineer		1018
		107V594

CONTRACT DRAWING
MAR. 9 1966

AS BUILT

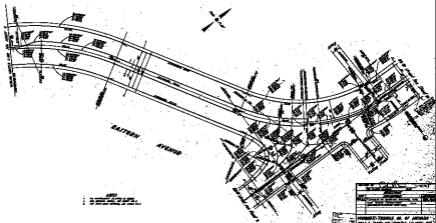

<p>PROJECT: TRACKS AT ST. JOHNS SHEET: TRACKS AT ST. JOHNS</p>	
DATE:	SCALE:
<p>DESIGNED BY: [Name] DRAWN BY: [Name] CHECKED BY: [Name]</p>	
<p>APPROVED BY: [Name]</p>	