




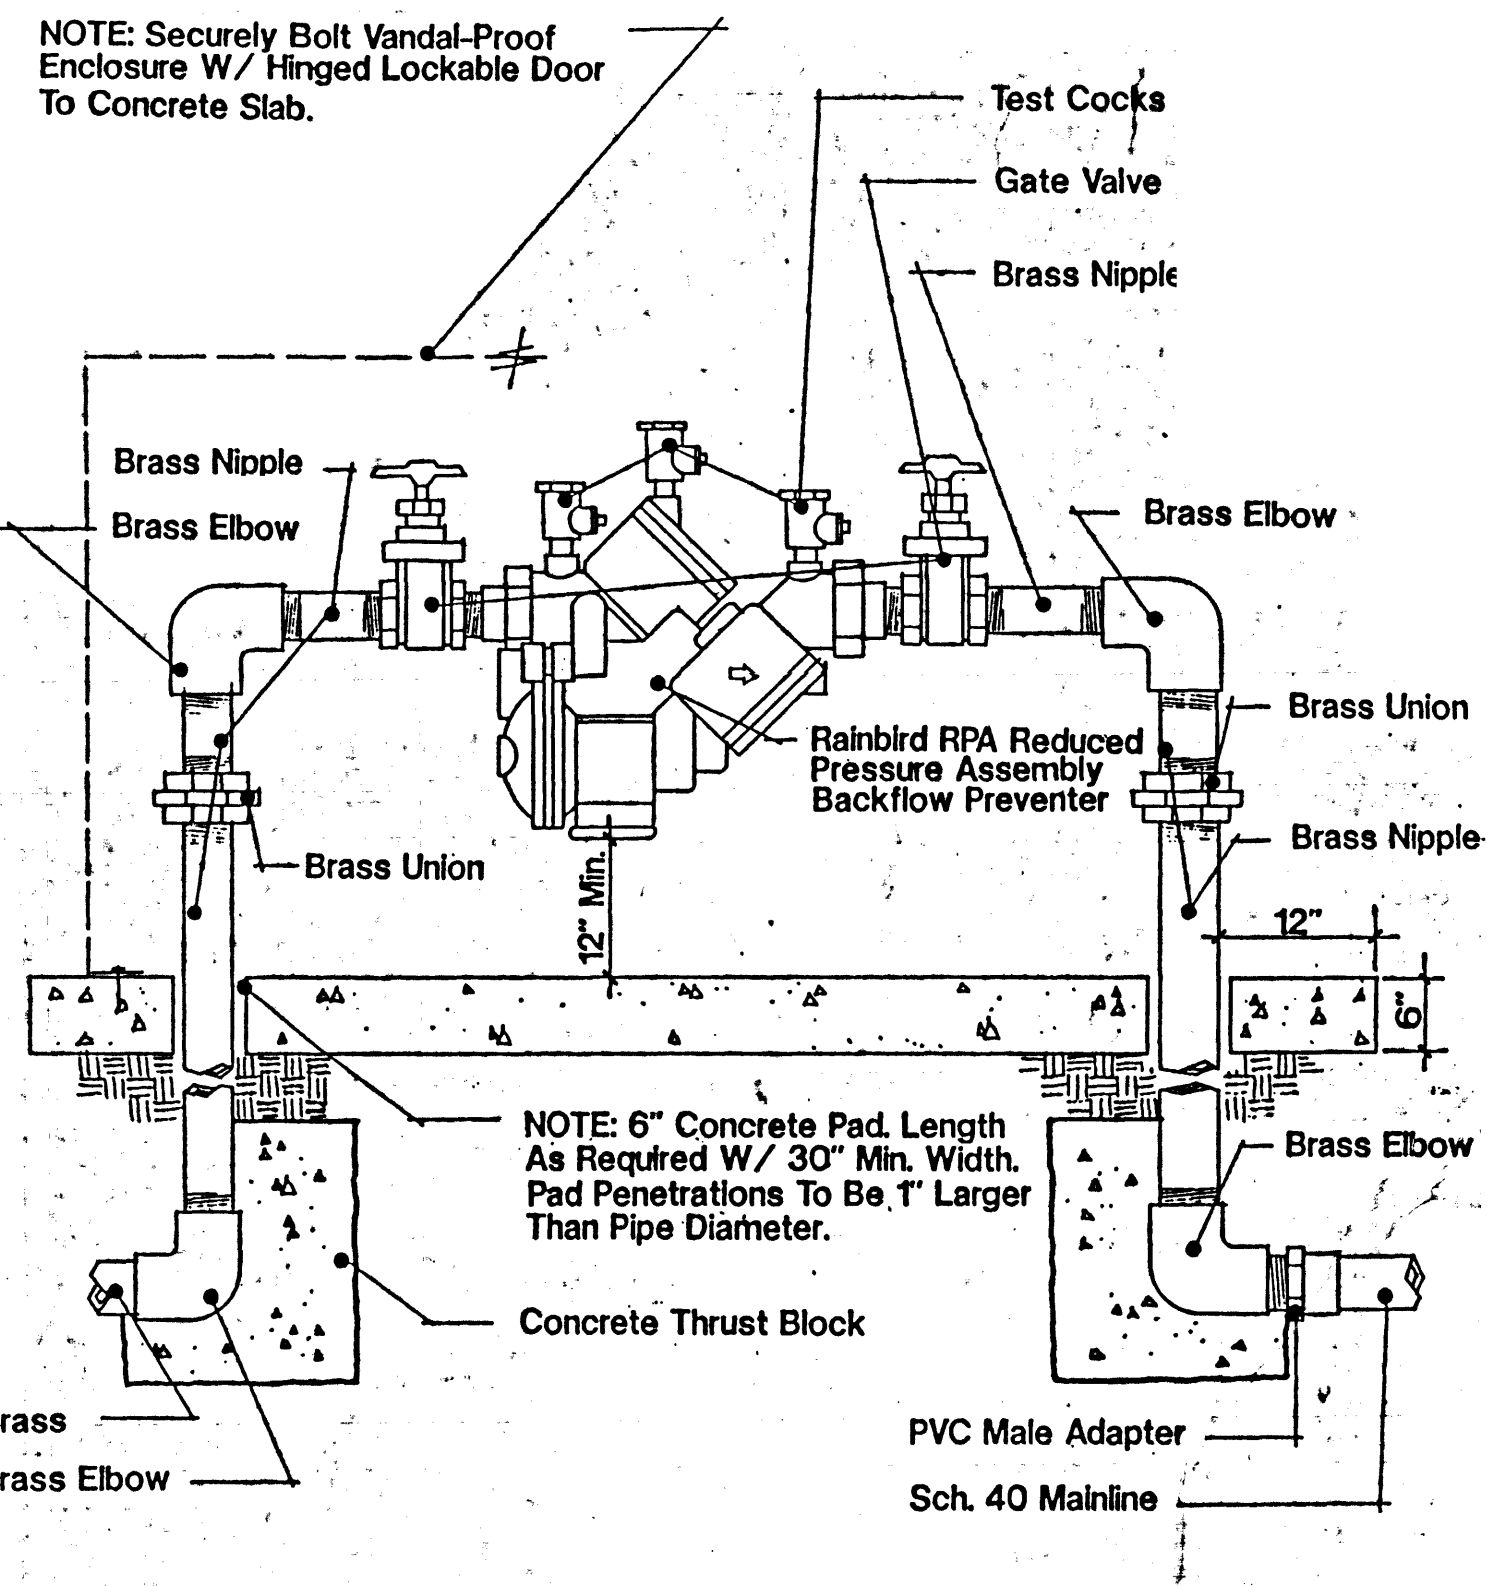


A RPA Backflow Preventer N.T.S.

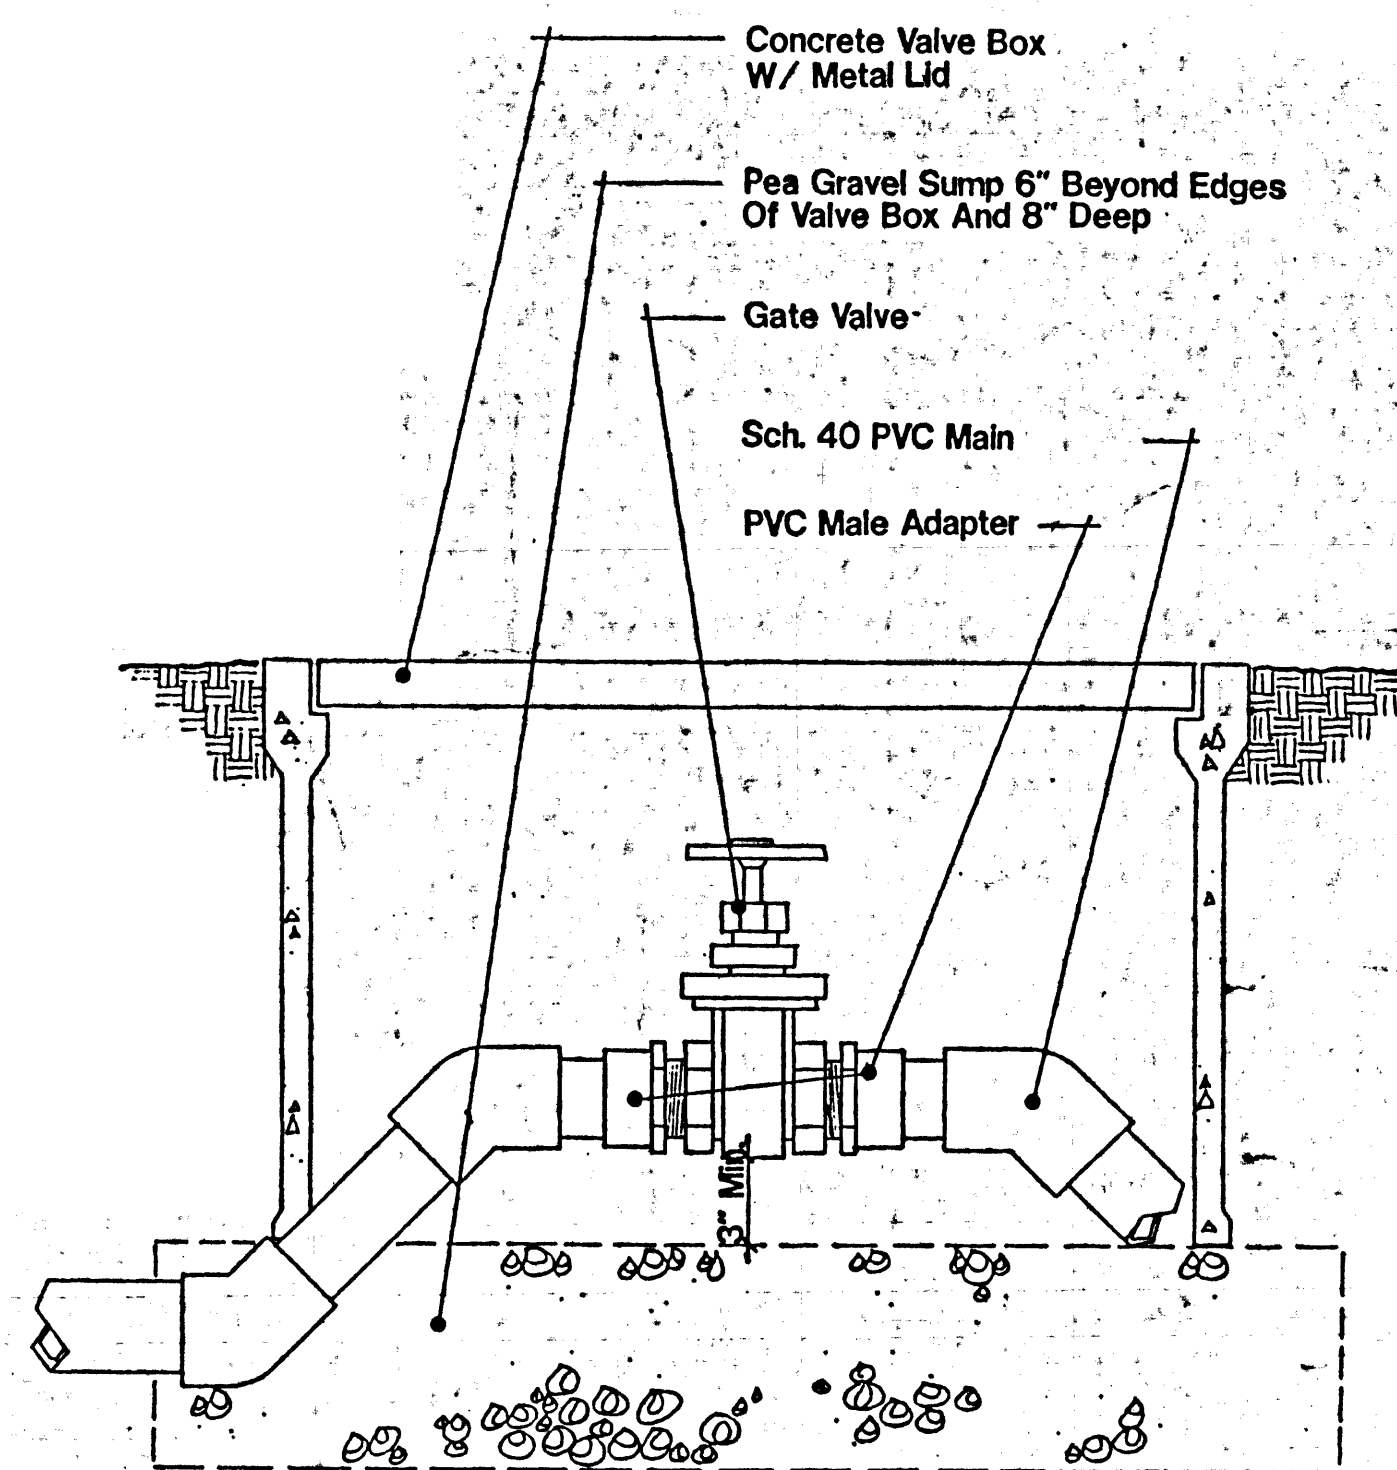


B Gate Valve N.T.S.

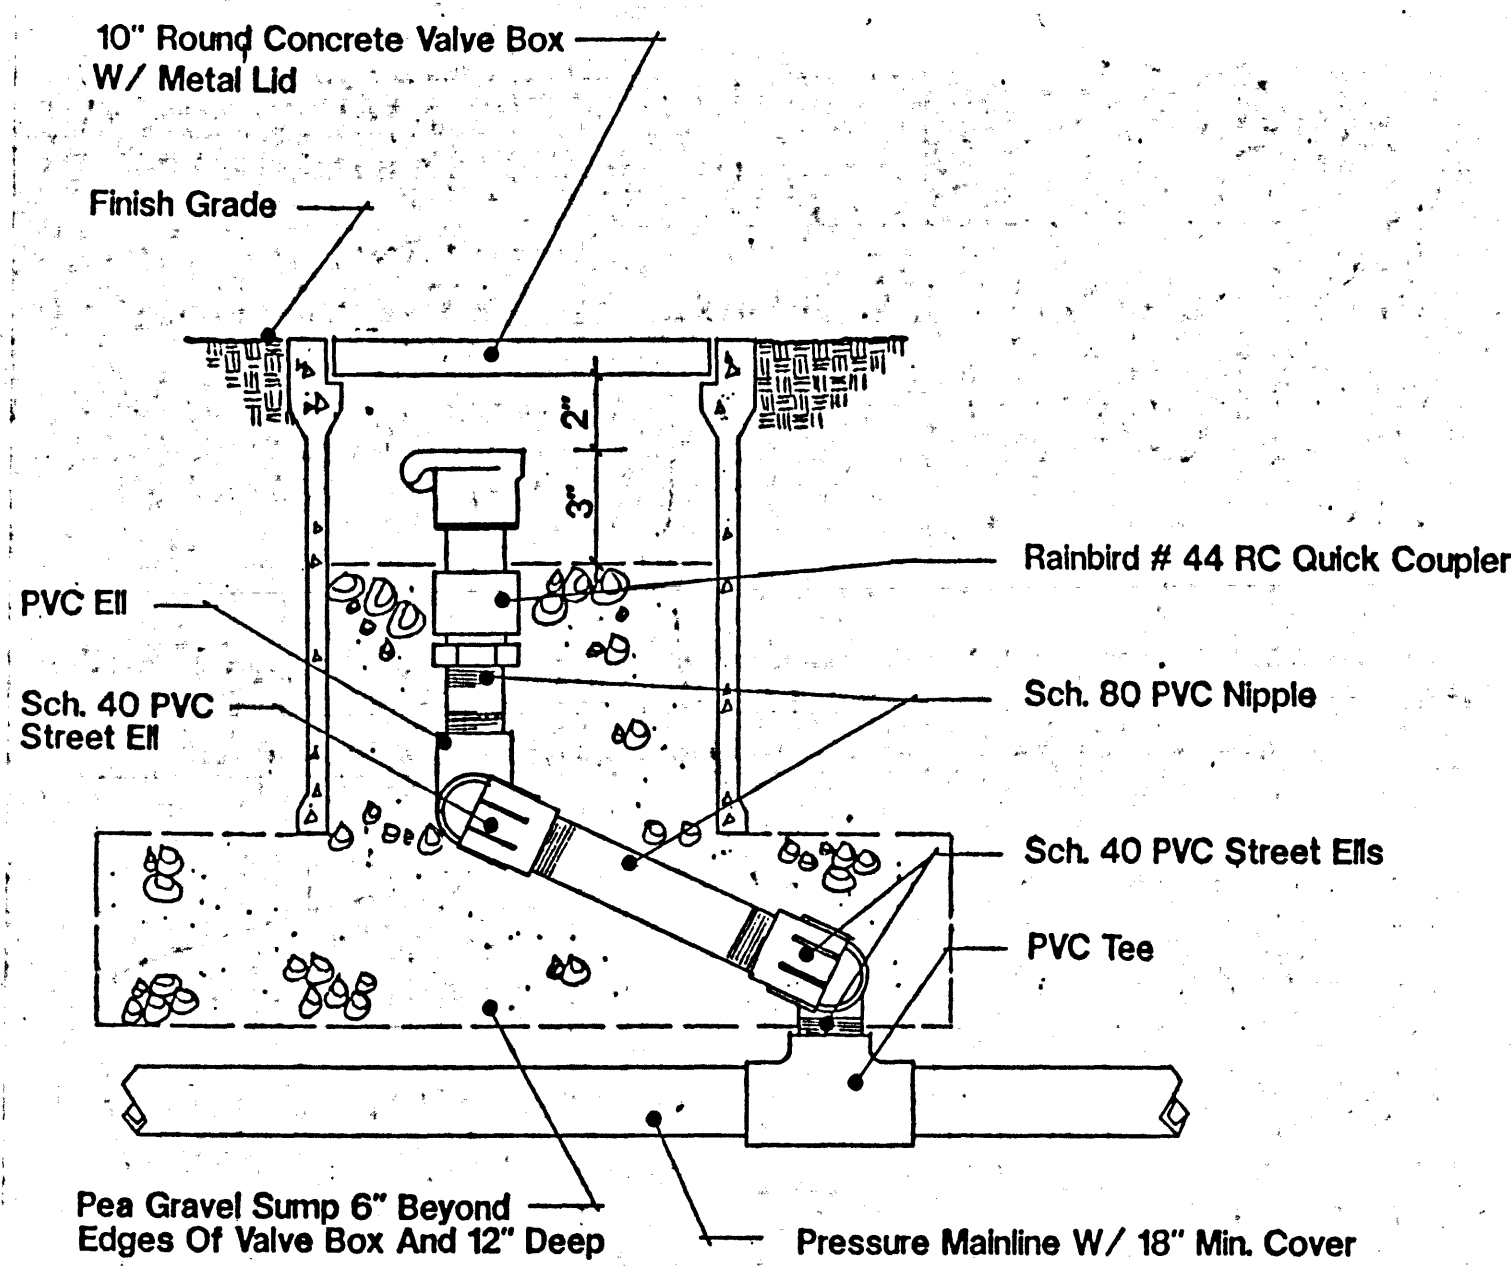


C Quick Coupler N.T.S.

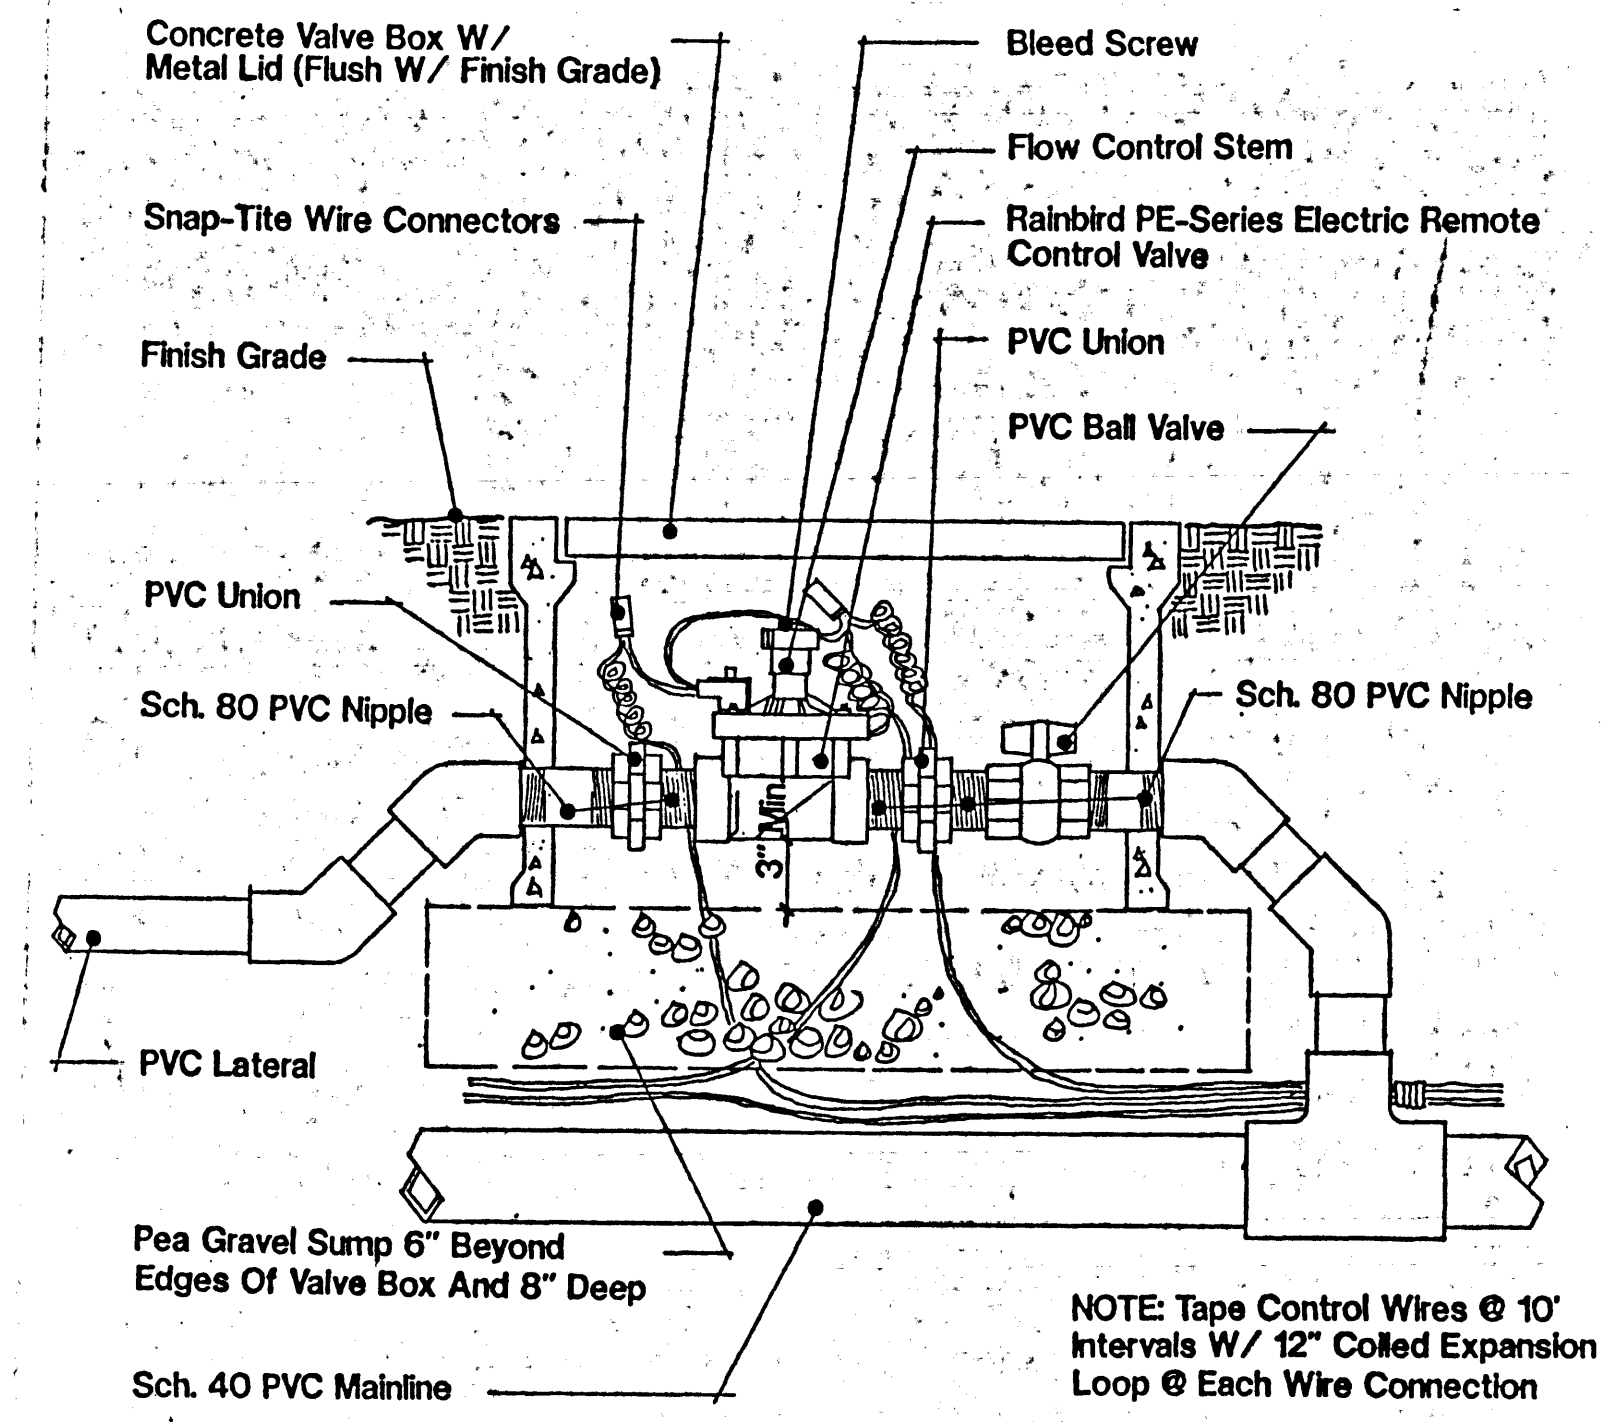


D Automatic Control Valve N.T.S.

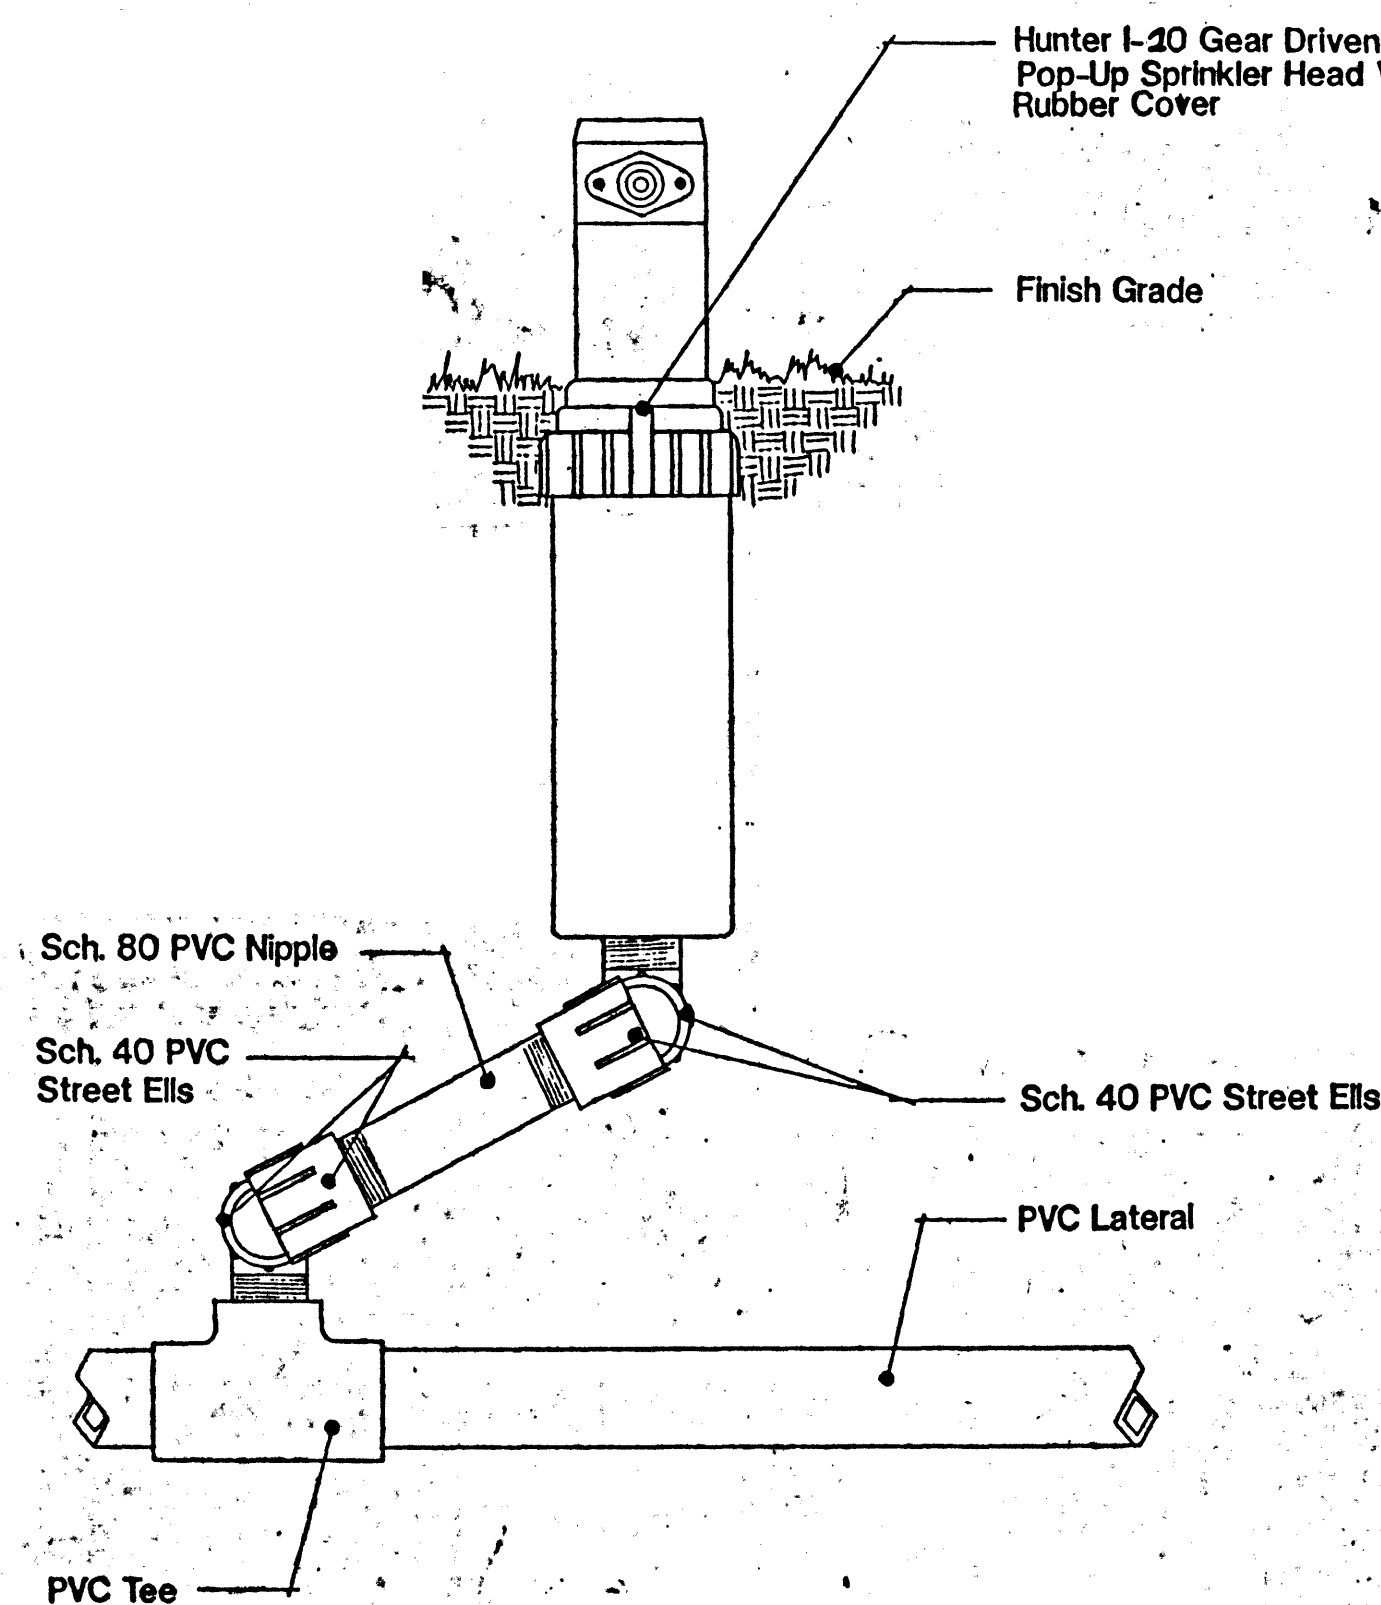


E Gear Driven Pop-Up Sprinkler Head N.T.S.

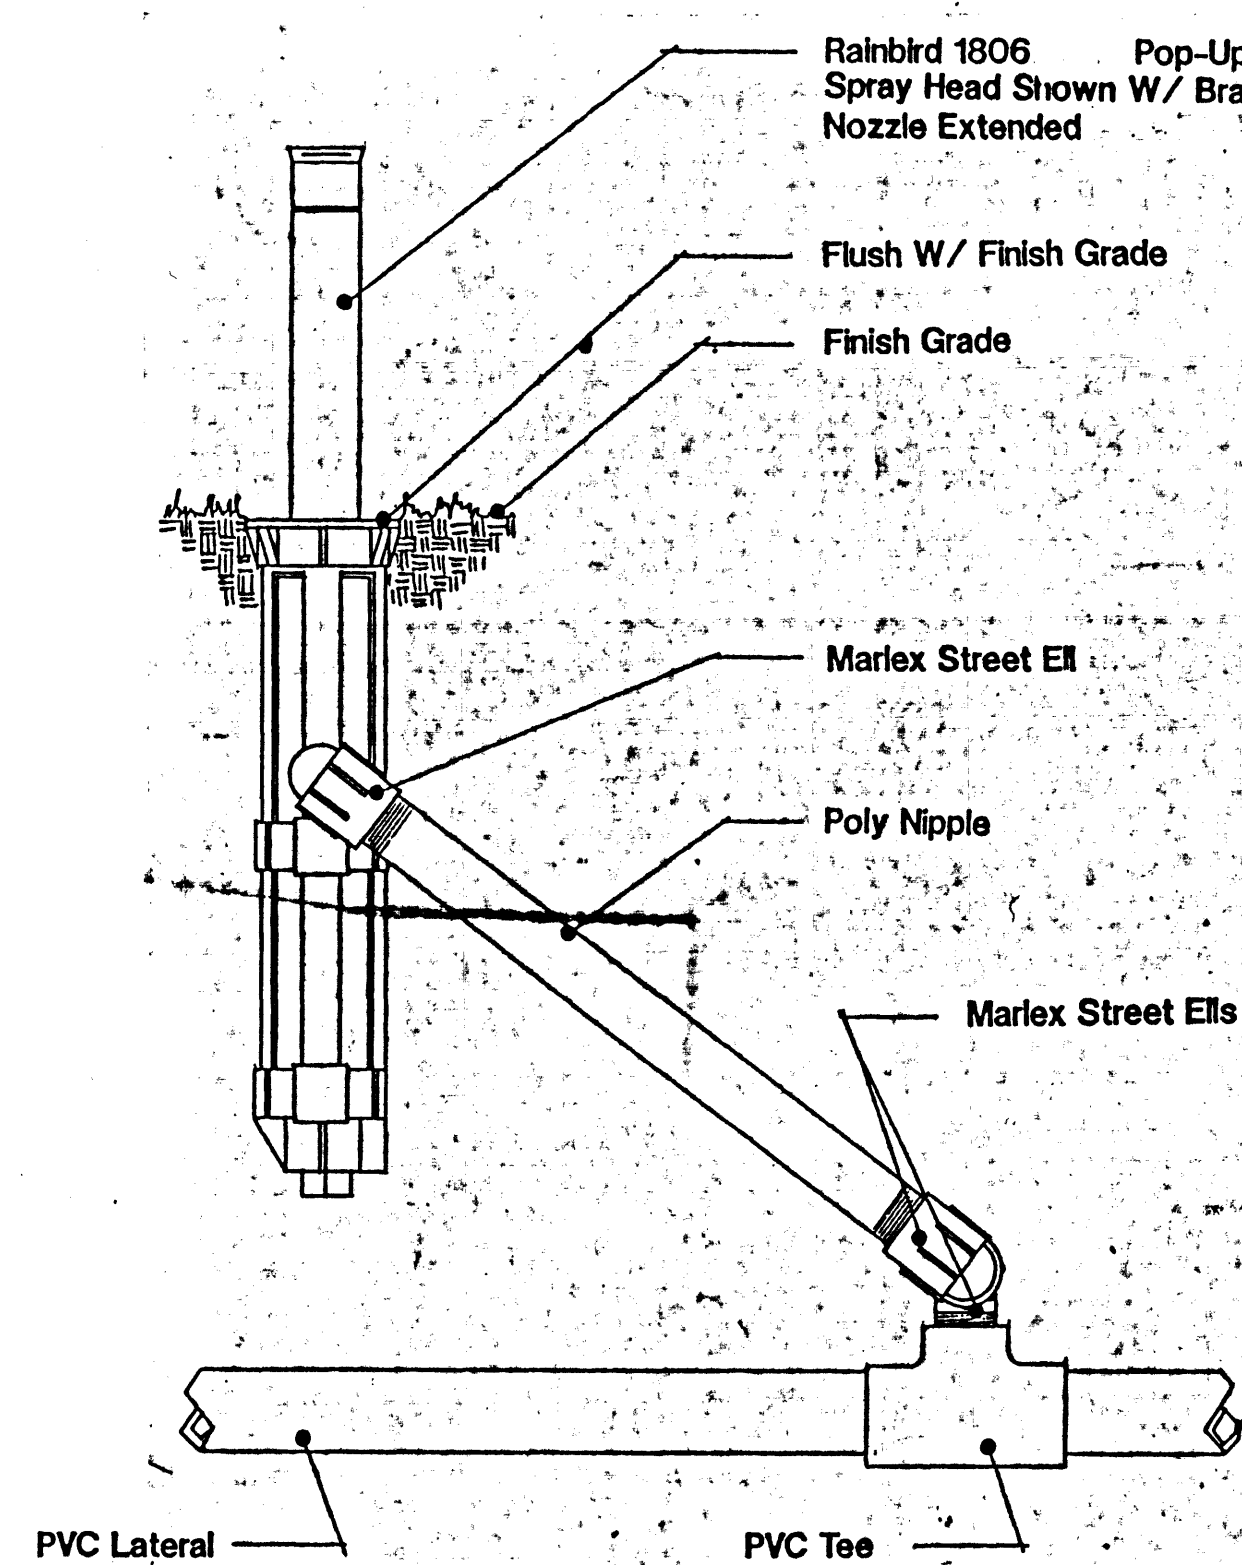


F Rainbird Pop-Up Spray Head N.T.S.

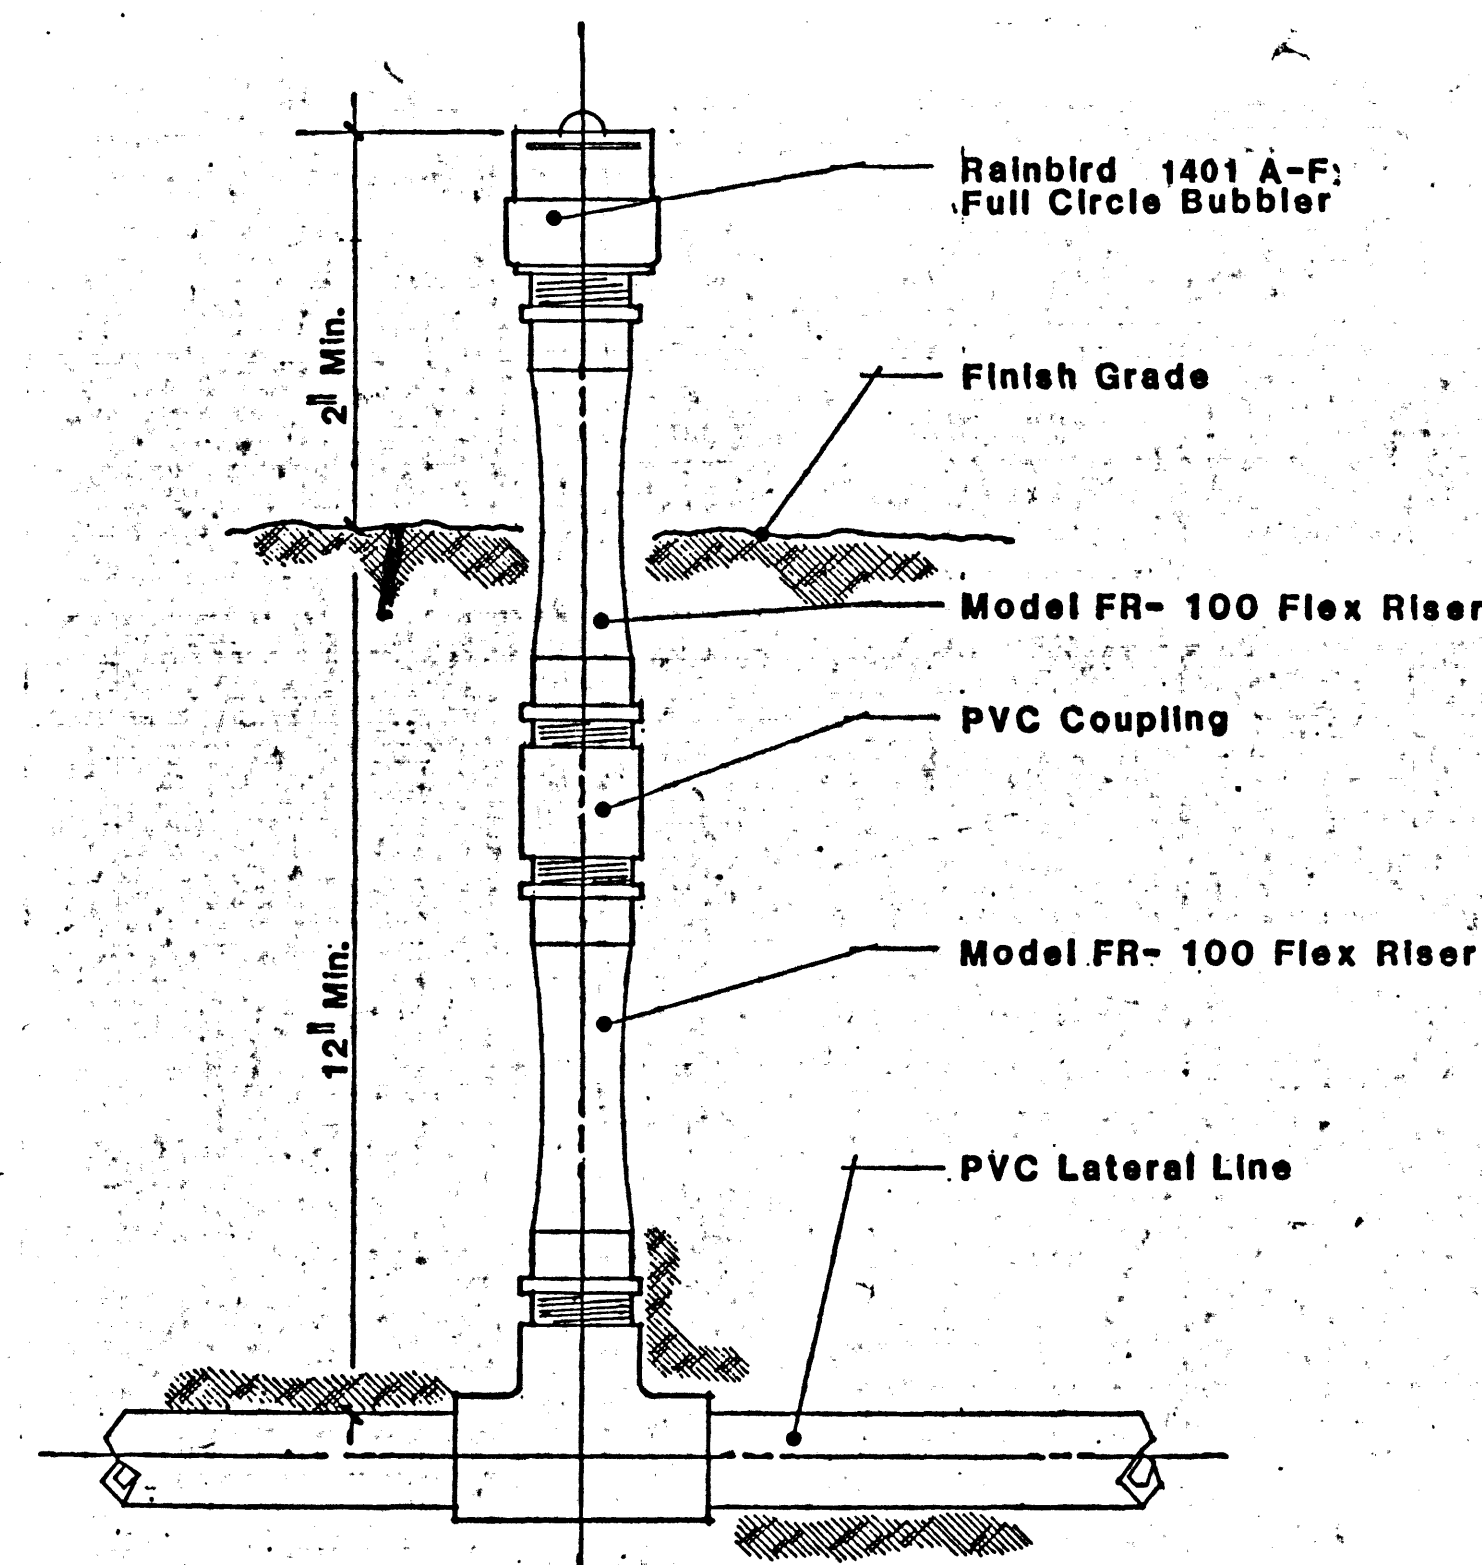

G Flood Bubbler N.T.S.

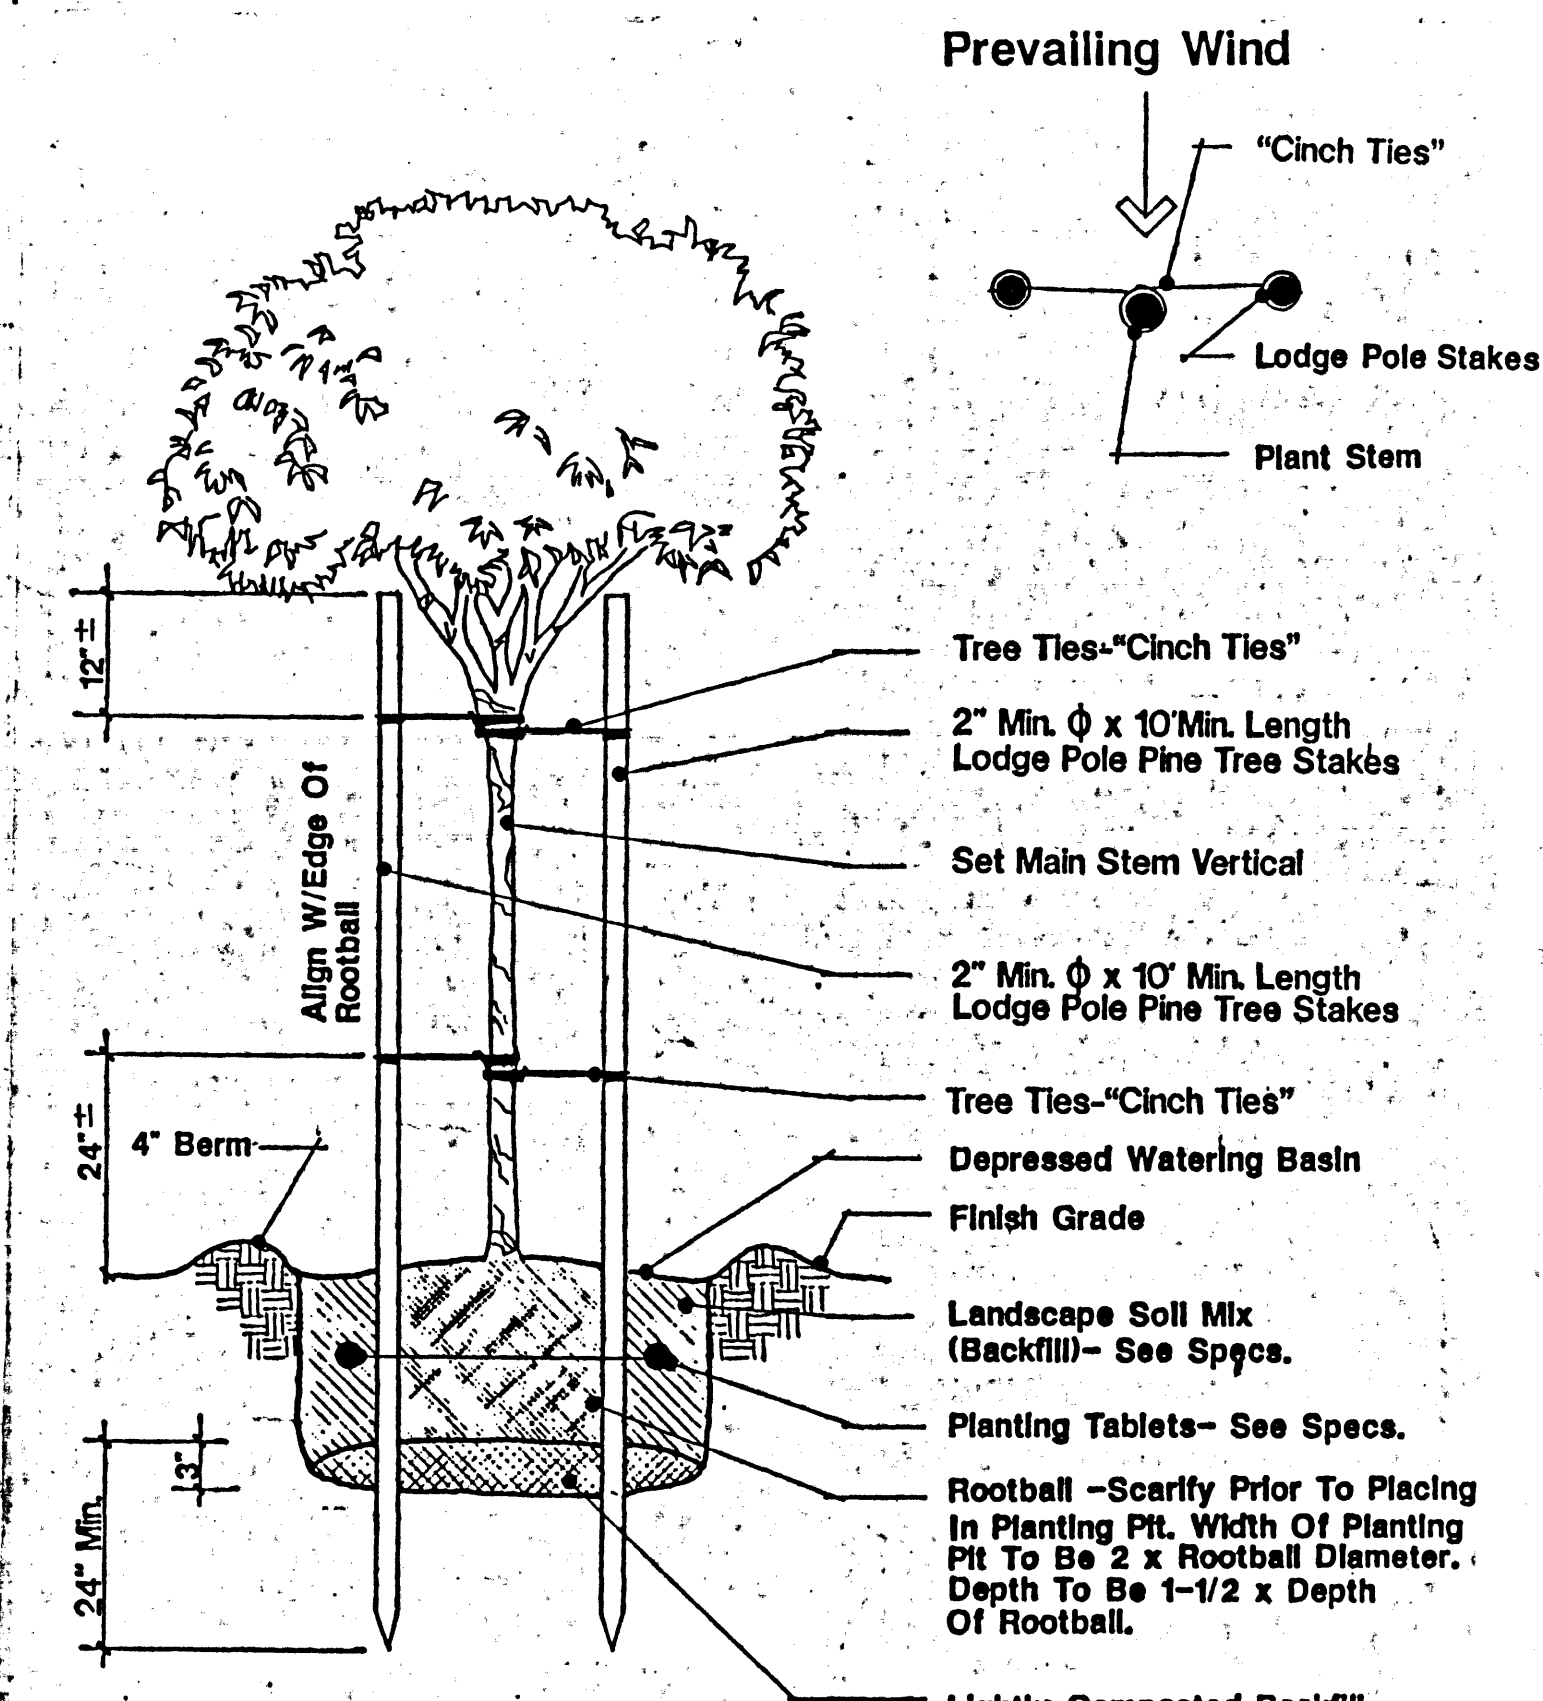

H Tree Planting Detail N.T.S.

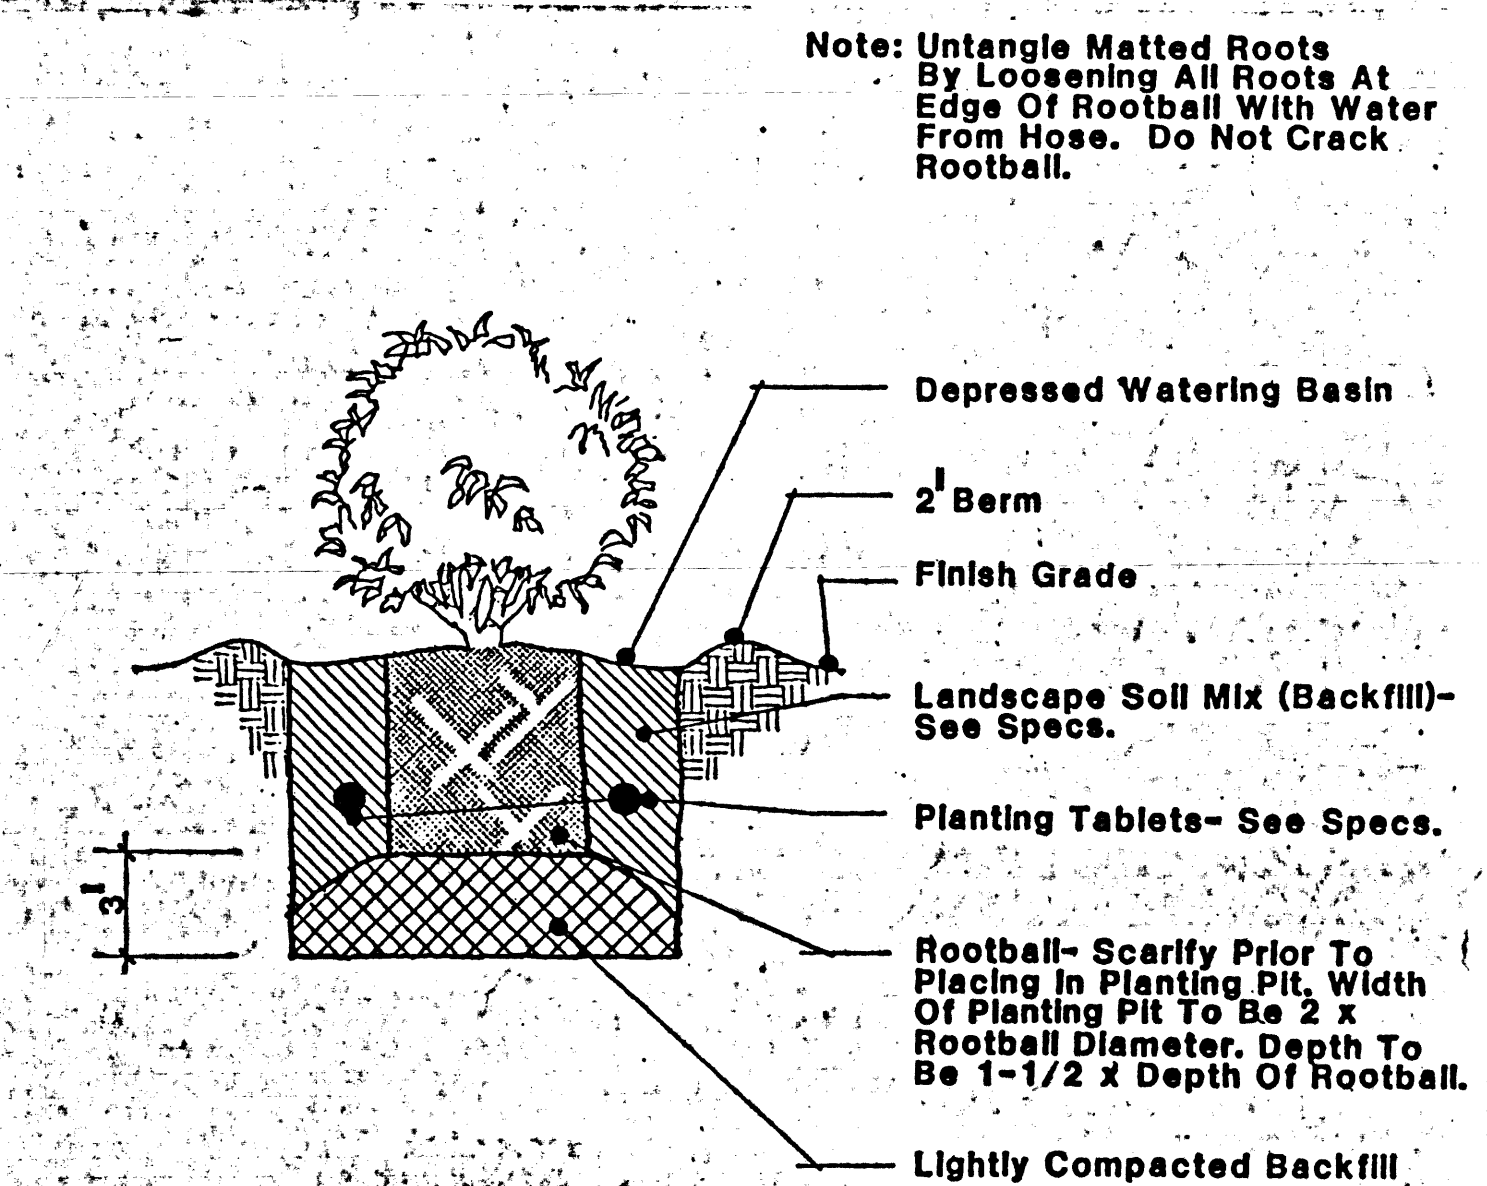

I Shrub Planting Detail N.T.S.

REVISIONS		
REV	DESCRIPTION	DATE

AS-BUILT RECORD DRAWING
CONSTRUCTION CHANGES SHOWN HEREON
ARE BASED ON DATA
FURNISHED BY THE CONTRACTOR

All ideas, designs, arrangements and plans indicated or presented by this drawing, as instruments of service, are owned by and the property of DOMINGO CAMBEIRO CORPORATION. The use of these plans and/or specifications shall be restricted to the original site for which they were prepared and publication thereof is expressly limited to such use. Reproduction, publication or re-use by any method, in whole or in part, is prohibited. None of such ideas, designs, arrangements or plans shall be used by or disclosed to any person, firm, agency, or corporation without the written permission of DOMINGO CAMBEIRO CORPORATION. Visual contact with these plans and specifications shall constitute prima facie evidence of acceptance of these restrictions.



DRAWN BY JSM	CHECKED BY JWZ	ISSUED DATE 11-15-90
-----------------	-------------------	-------------------------

JV ZUNINO & ASSOCIATES
A LANDSCAPE ARCHITECTURAL FIRM
3305 W. SPRING MOUNTAIN ROAD, SUITE 100 LAS VEGAS, NV 89102
DO NOT SCALE DRAWINGS


CITY OF LAS VEGAS,
DETENTION FACILITY EXPANSION,
3100 EAST STEWART AVENUE,
LAS VEGAS, NEVADA
LANDSCAPE DETAILS






Domingo Cambeiro Corporation
ARCHITECTURE • ENGINEERING • PLANNING • INTERIORS
3555 PECOS-MCLEOD IC. LAS VEGAS, NEVADA 89121 (702) 732-0084



SHEET NO. JWZ NO. 89118

L 3.1
10 OF 163

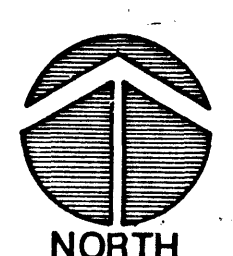

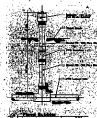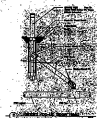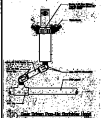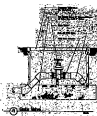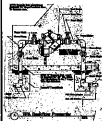[illegible]

WORLD WITH CARE
 100% MONEY BACK GUARANTEE
 1-800-850-8500
 100% MONEY BACK GUARANTEE

1. **Introduction**
 2. **Background**
 3. **Methodology**
 4. **Results**
 5. **Conclusion**
 6. **References**



1	2	3
4	5	6
7	8	9
367	368	369
370	37	

MAZUMENDRA ASSOCIATES
CORPORATE AND FINANCIAL
100 WEST 42ND STREET, 10TH FLOOR
NEW YORK, NY 10018-3601
TEL: 212 512-2000 FAX: 212 512-2001

STANDARD
SPECIALTY
SERVICES
CORPORATION
A DIVISION OF
THE STANLEY GROUP
OF COMPANIES

Denise Combelle Corporation



L 2.1