


COOL VALLEY

SEWER LATERAL LINES AS-BUILT


BALLERINA SUNRISE

--- NOT A PART ---

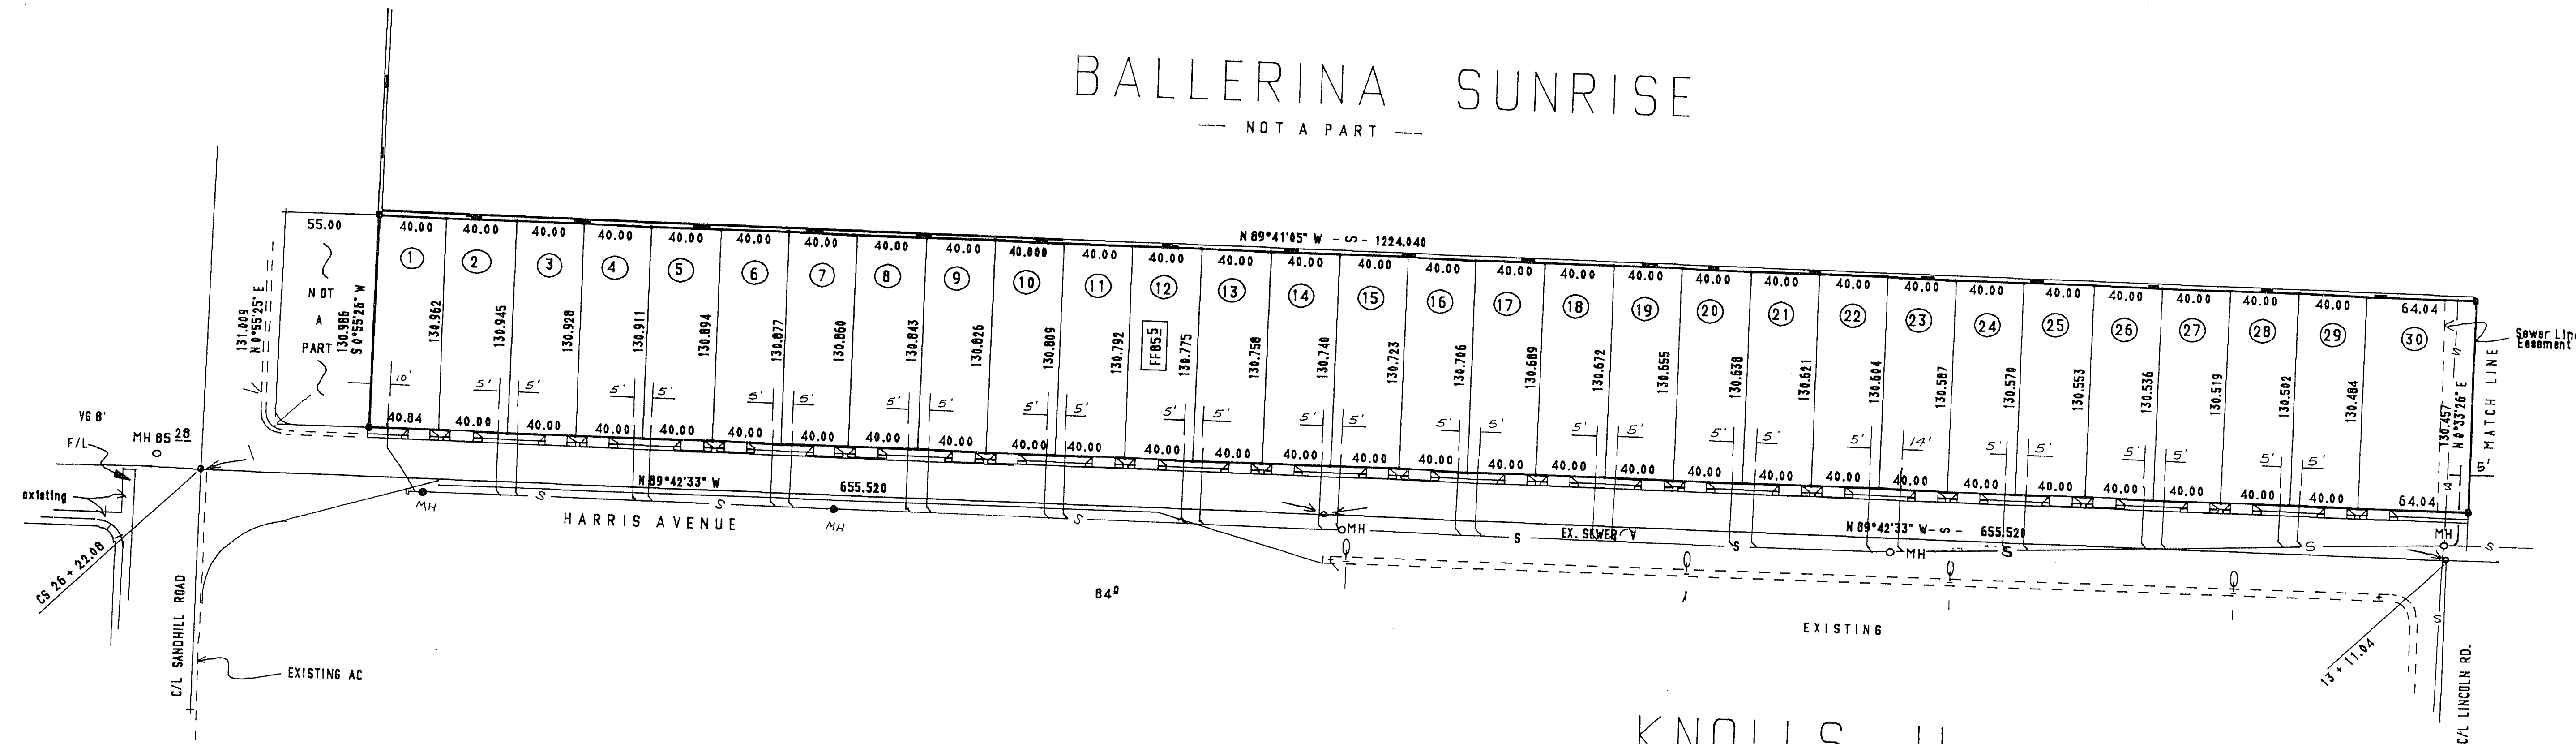

LEGEND:


- E Center Line
- T/C Top of Curb
- FF Finished Floor
- ④ Lot Number
- CS Construction Station
- MH Man Hole
- EL Elevation
- AC Asphalt Cement
- FTG Footing
- EX Existing
- FND Found
- F/L Flow Line
- VG Valley Gutter
- (XX.XX) Ex. Elev.
- XX.XX Design Elev.
- Black Wall
- Existing

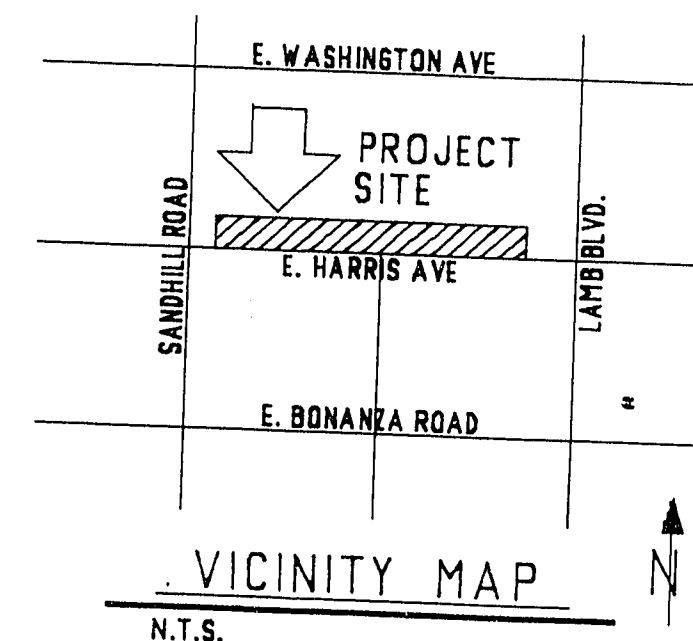

KNOLLS II

BOOK 39 PAGE 51

--- NOT A PART ---

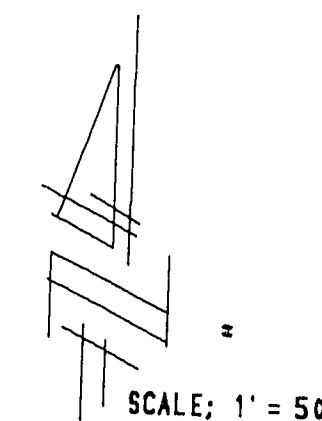

SEWER LATERAL AS-BUILT
FOR
COOL VALLEY SUBDIVISION

SHEET ONE OF TWO

As Built 3074-4185