
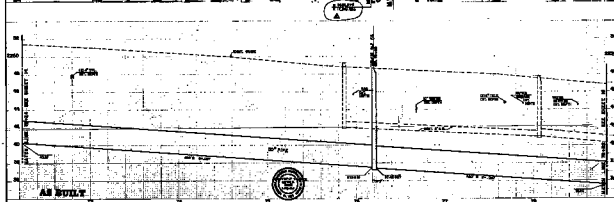


2 7-13-94 WM ASBUILT 1 2-28-88 ST CITY'S 95% COMPLETION REVIEW COMMENTS		Job No. 48901.00 SCALE 1" = 20' HORIZ. 1" = 2' VERT.	Designed D.J.M. & K.J.E. Drawn by D.J.M. & C.D.M. Checked by K.S. & ST.	Proj. Dir. K.S. & ST. Approved by M.G. & ST. Date 9-30-88	URS CONSULTANTS INC Engineering and Environmental Consultants Las Vegas, Nevada	CITY OF LAS VEGAS CHEYENNE / WESTSIDE INTERCEPTOR	PLAN & PROFILE CHEYENNE AVE. STA. 72+24 TO 78+82 MICHAEL WAY CROSSING	SHEET 15 27
--	--	---	---	---	--	--	--	---------------------------------

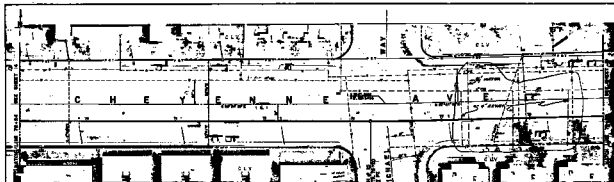

1 SHEET NO. OF 27	PROJECT NO. 15-1-97	DRAWN BY DATE CHECKED BY DATE	LRS CONSULTANTS INC. Engineering and Construction Services Las Vegas, Nevada	CITY OF LAS VEGAS OUTSIDE / WESTERN INTERCEPT	PLAN & PROFILE CHEYENNE AVE. STA. 74+24 TO 76+82 MICHAEL WAY CROSSING	15 27
-------------------------	------------------------	--	---	--	--	----------