



**PLAN**  
**MH 21 STA. 63+70**  
 SCALE: 3/4" = 1'-0"


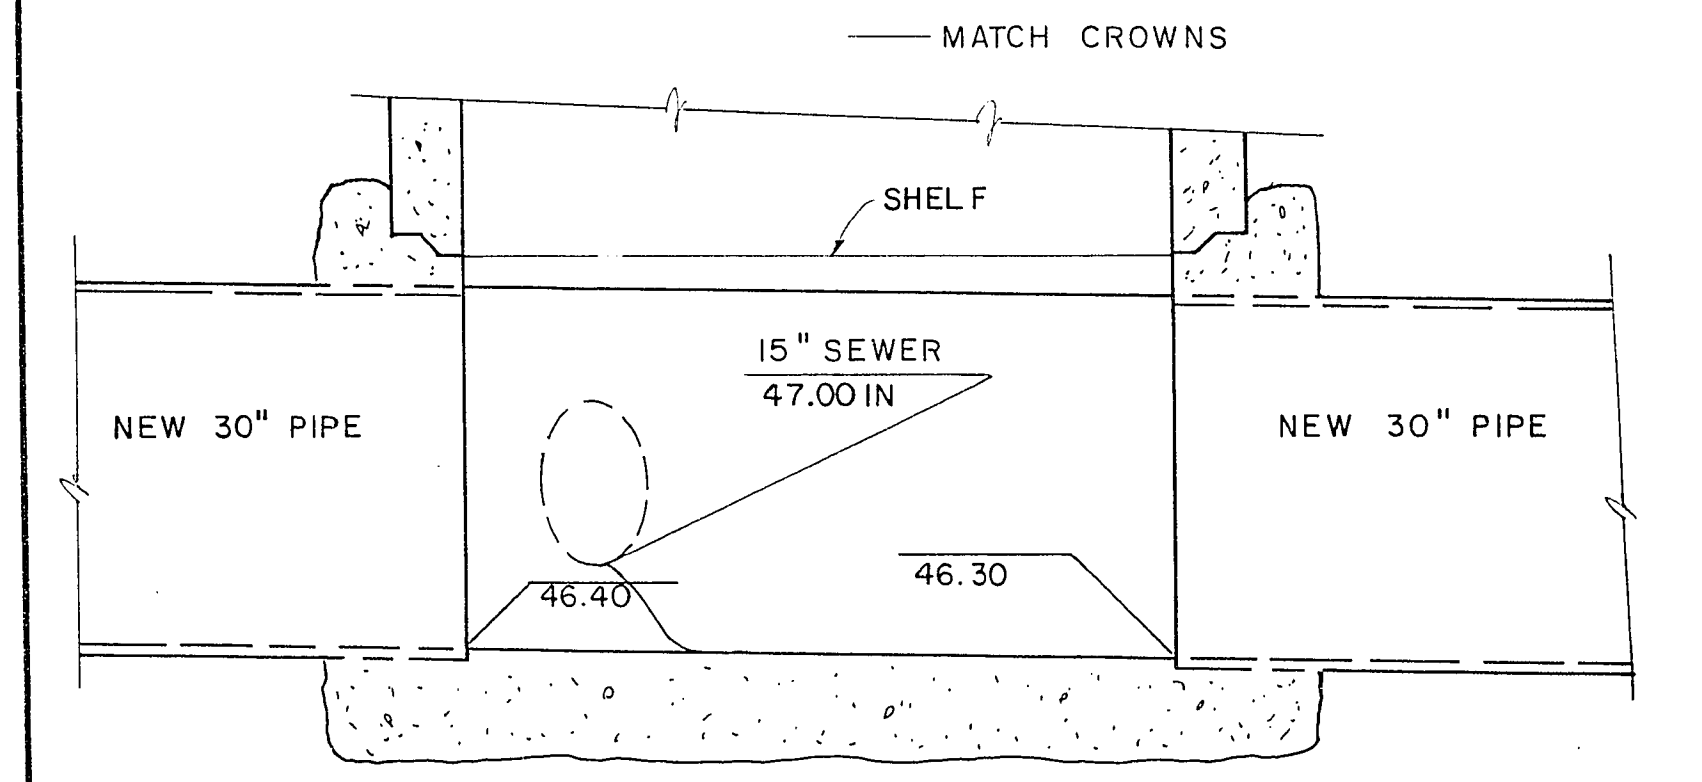


**SECTION**  
 SCALE: 3/4" = 1'-0"

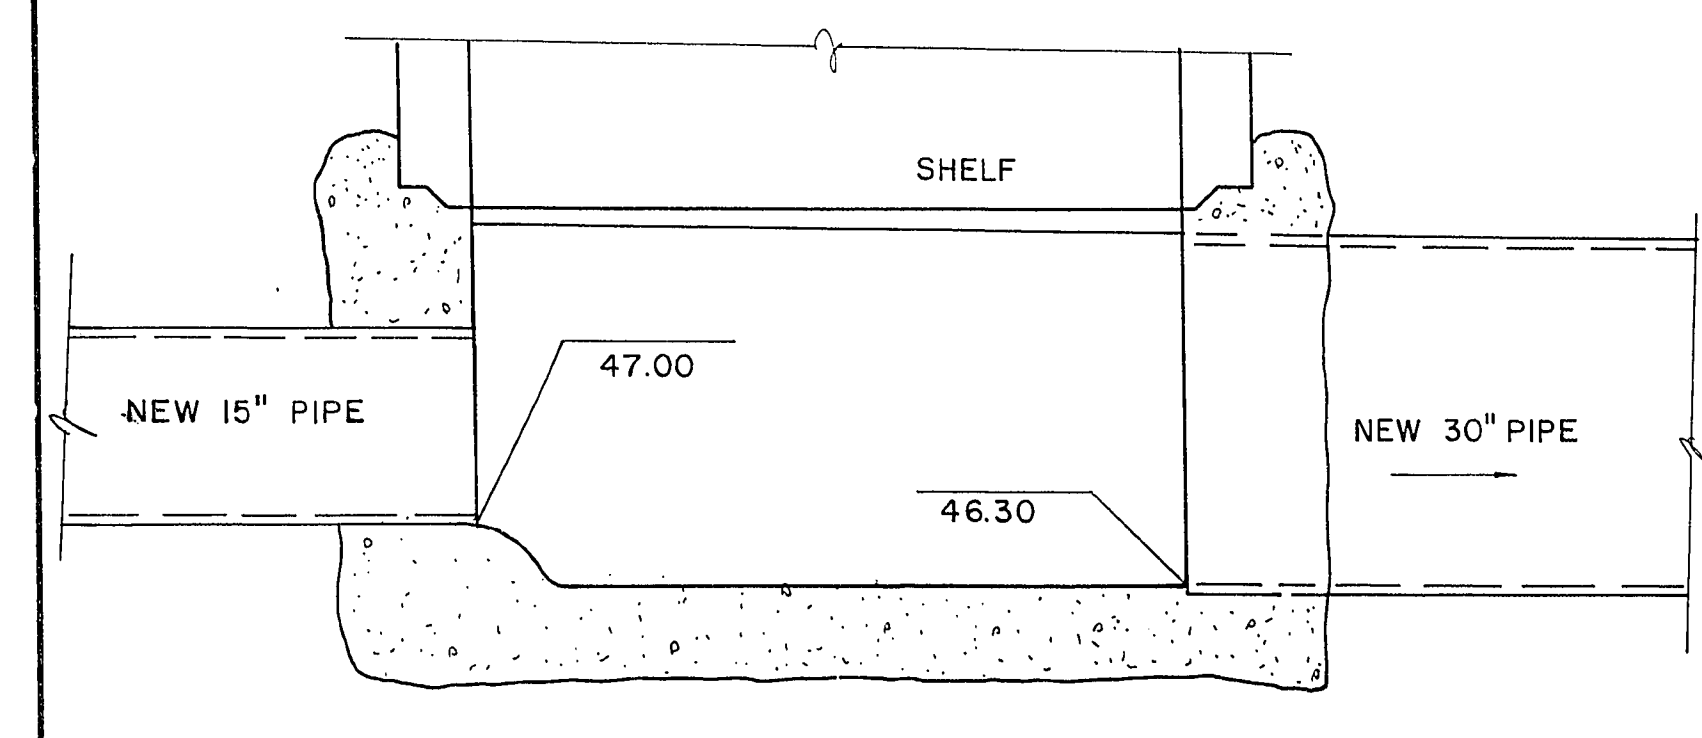


**SECTION**  
 SCALE: 3/4" = 1'-0"


**AS BUILT**

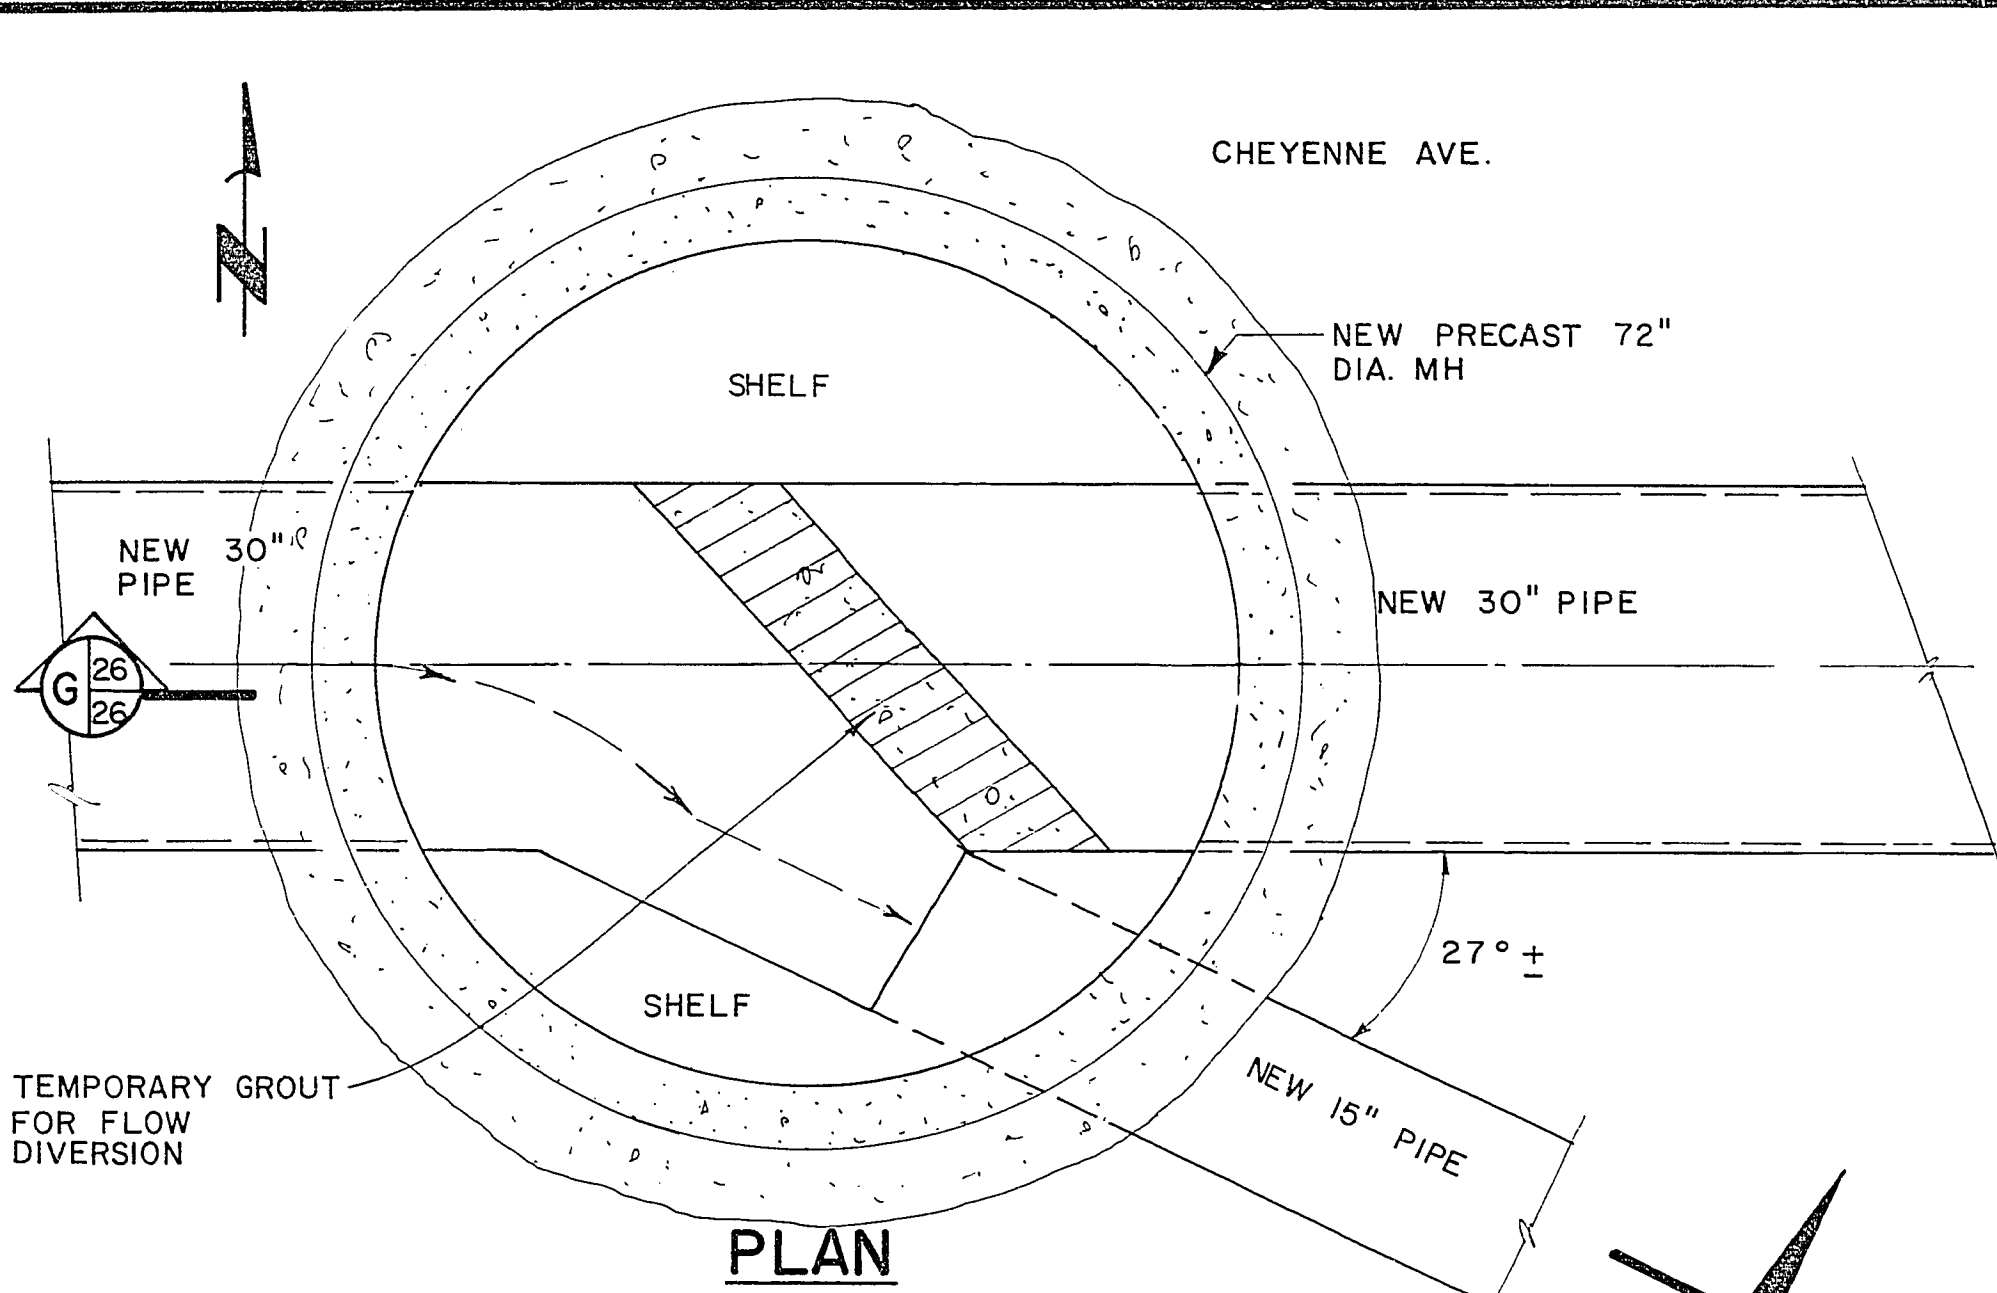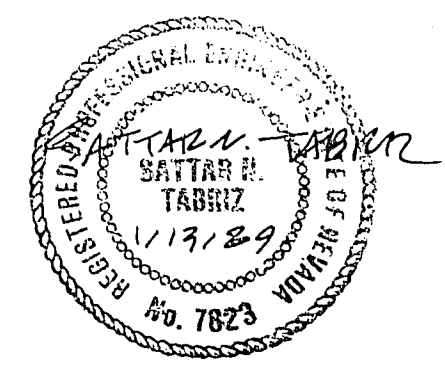


**PLAN**  
**MH 26 STA. 89+60**  
 SCALE: 3/4" = 1'-0"

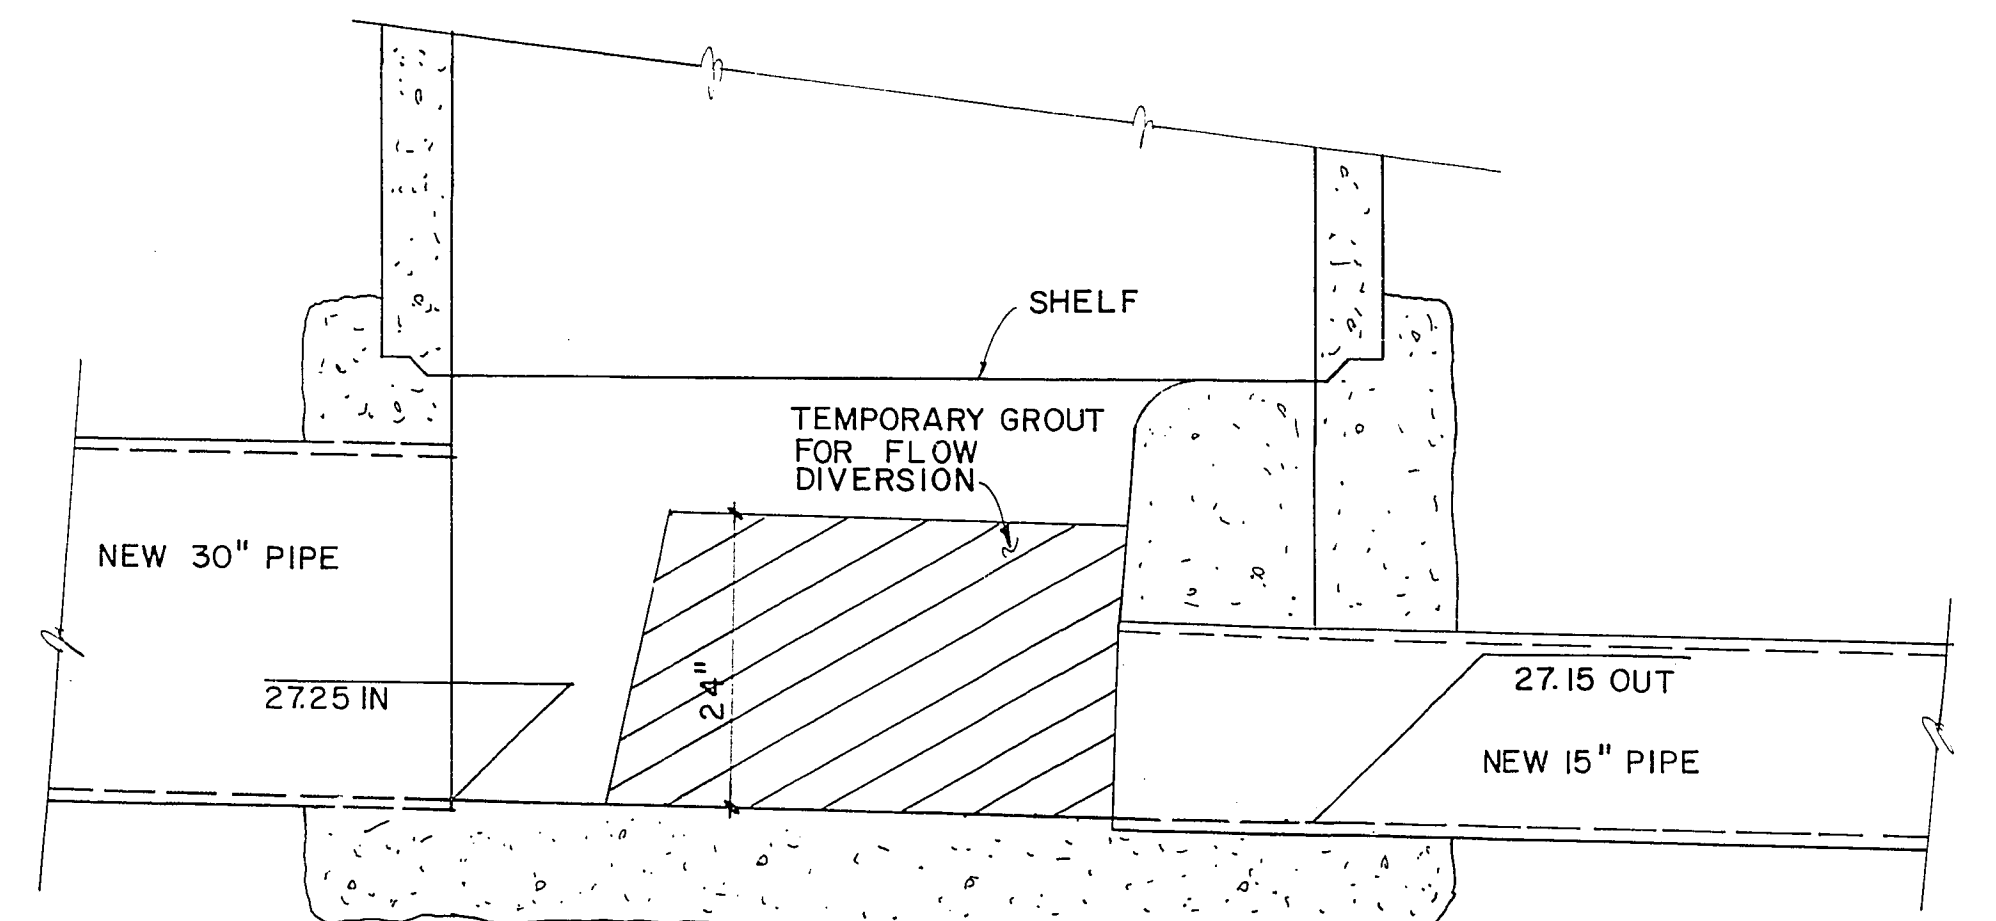


**SECTION**  
 SCALE: 3/4" = 1'-0"

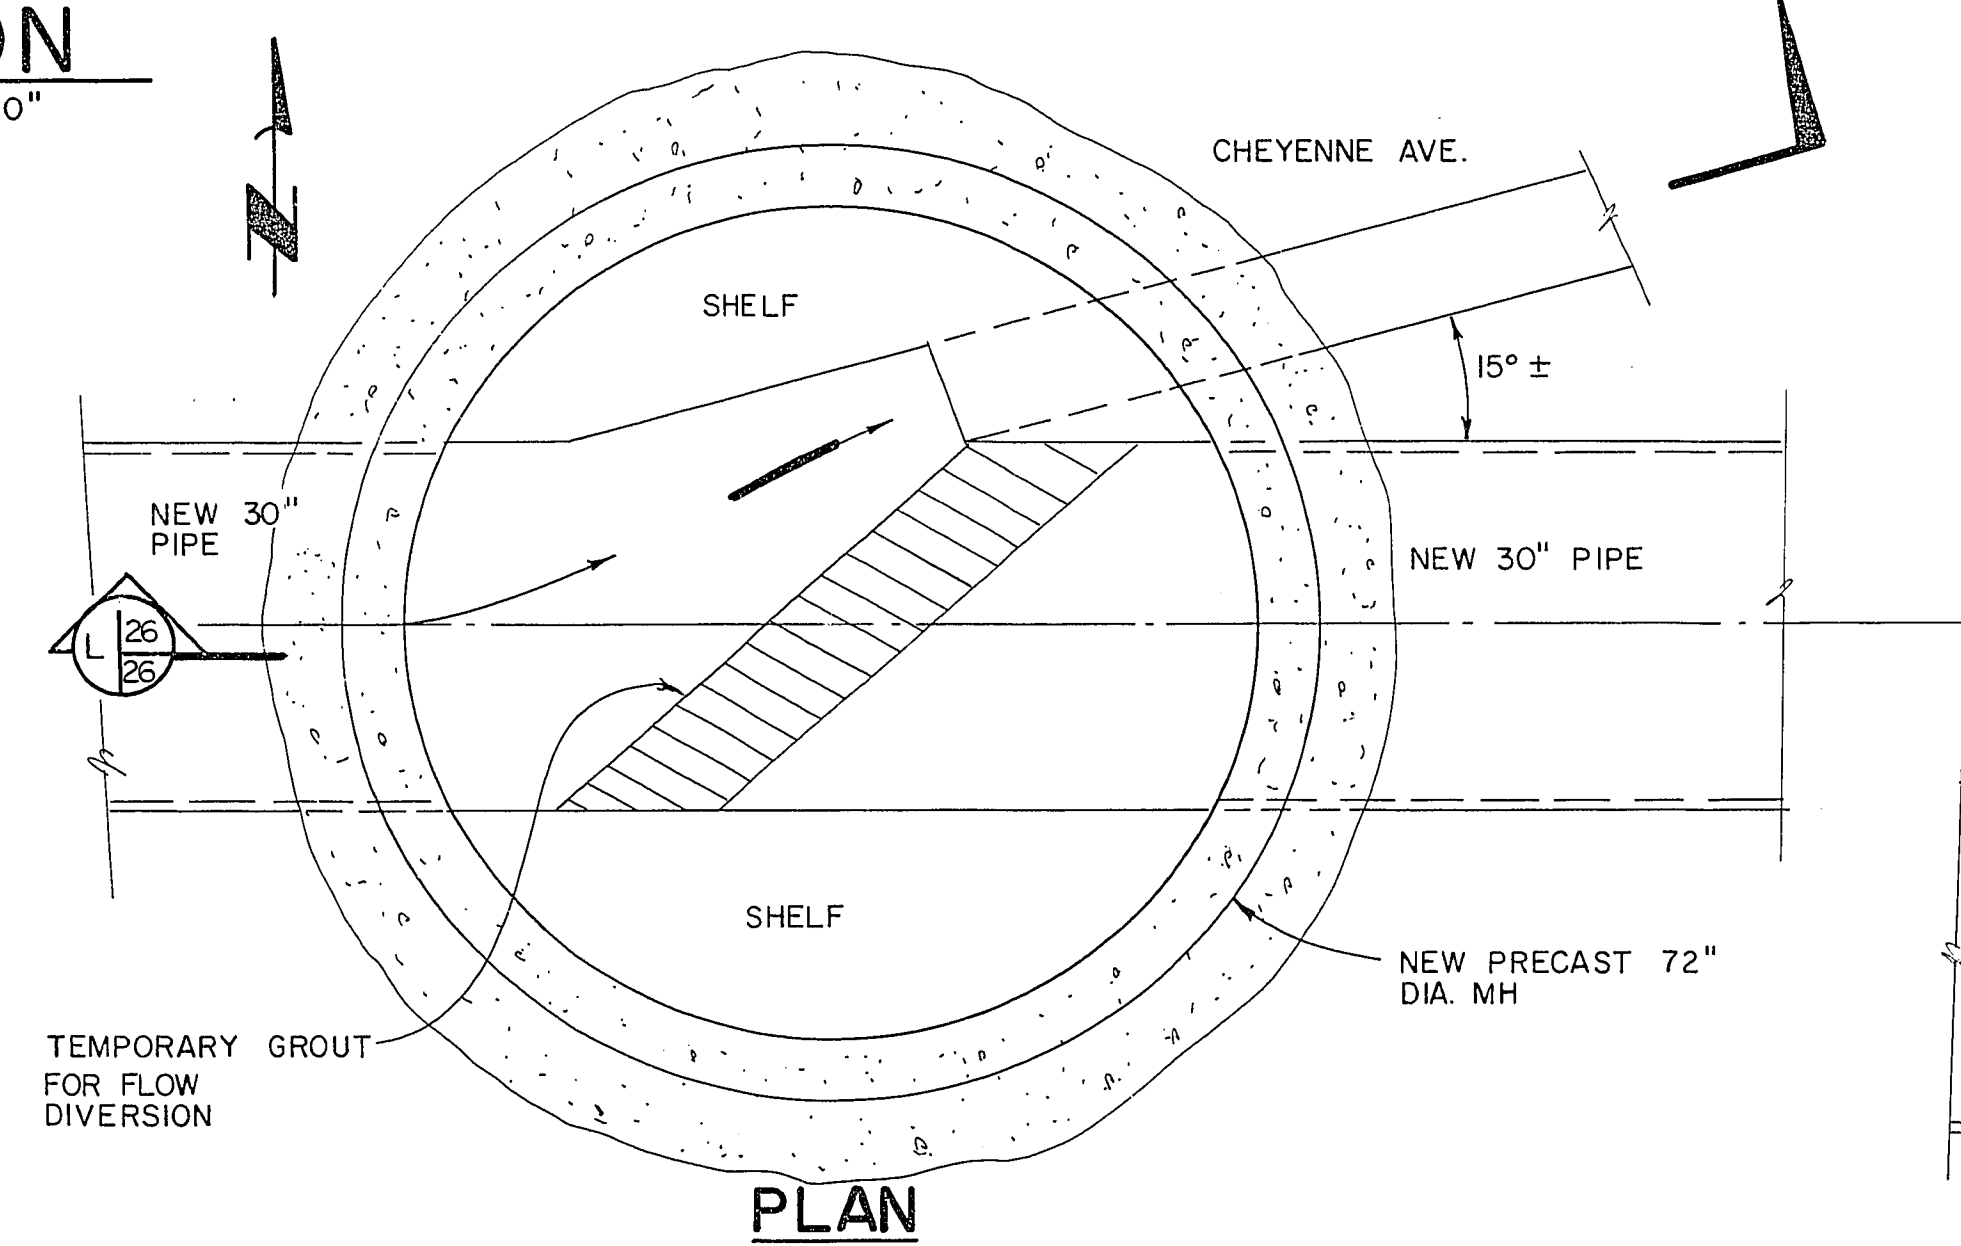


**PLAN**  
**MH 31 STA. 100+40**  
 SCALE: 3/4" = 1'-0"

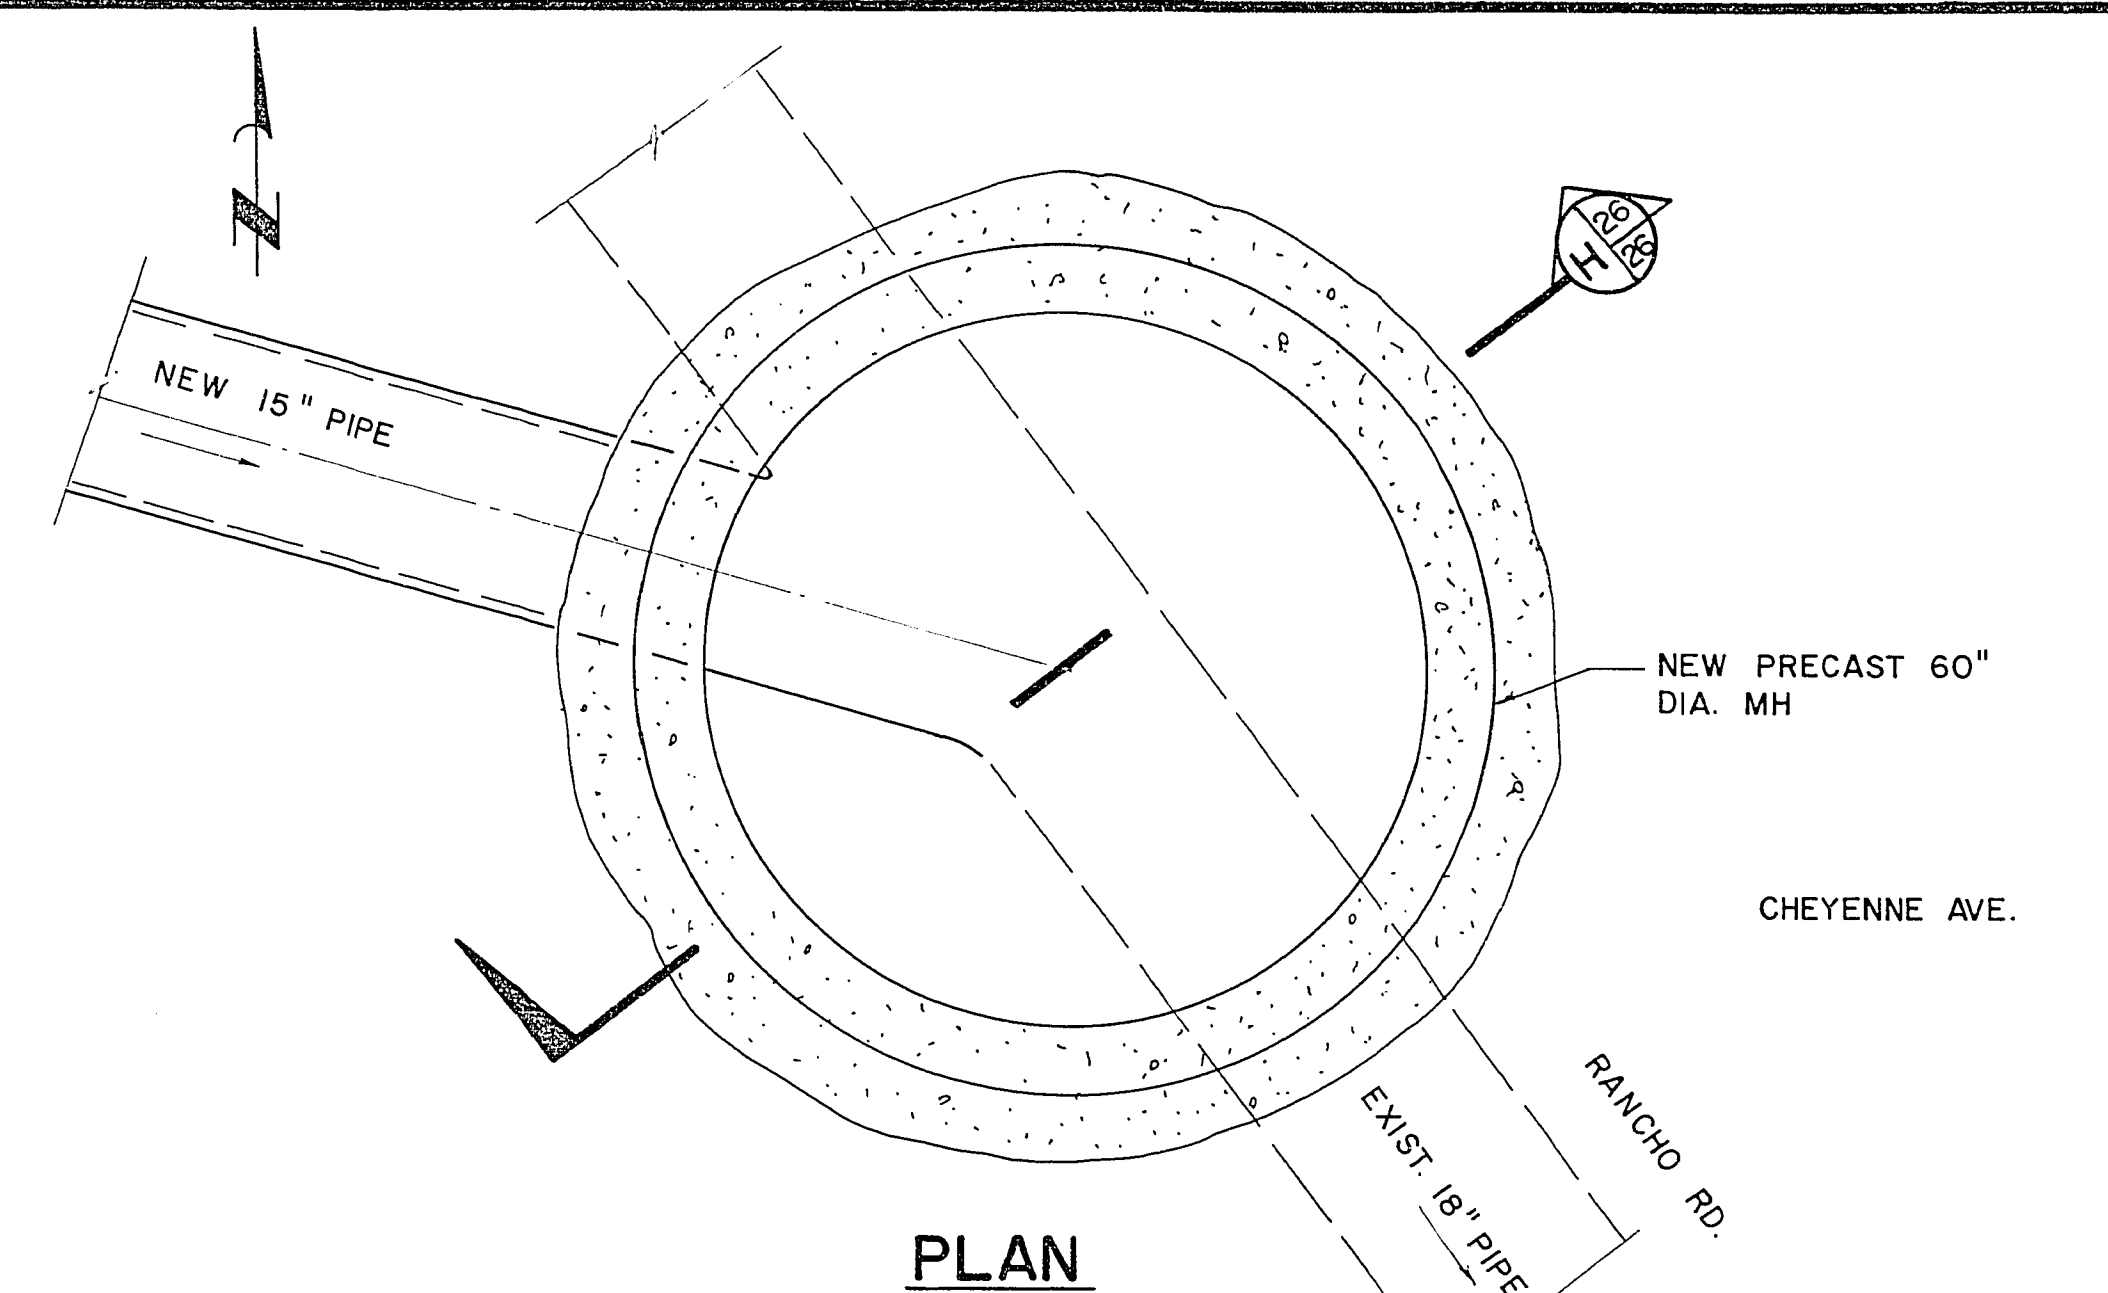

**PLAN**  
**MH 27**  
 SCALE: 3/4" = 1'-0"

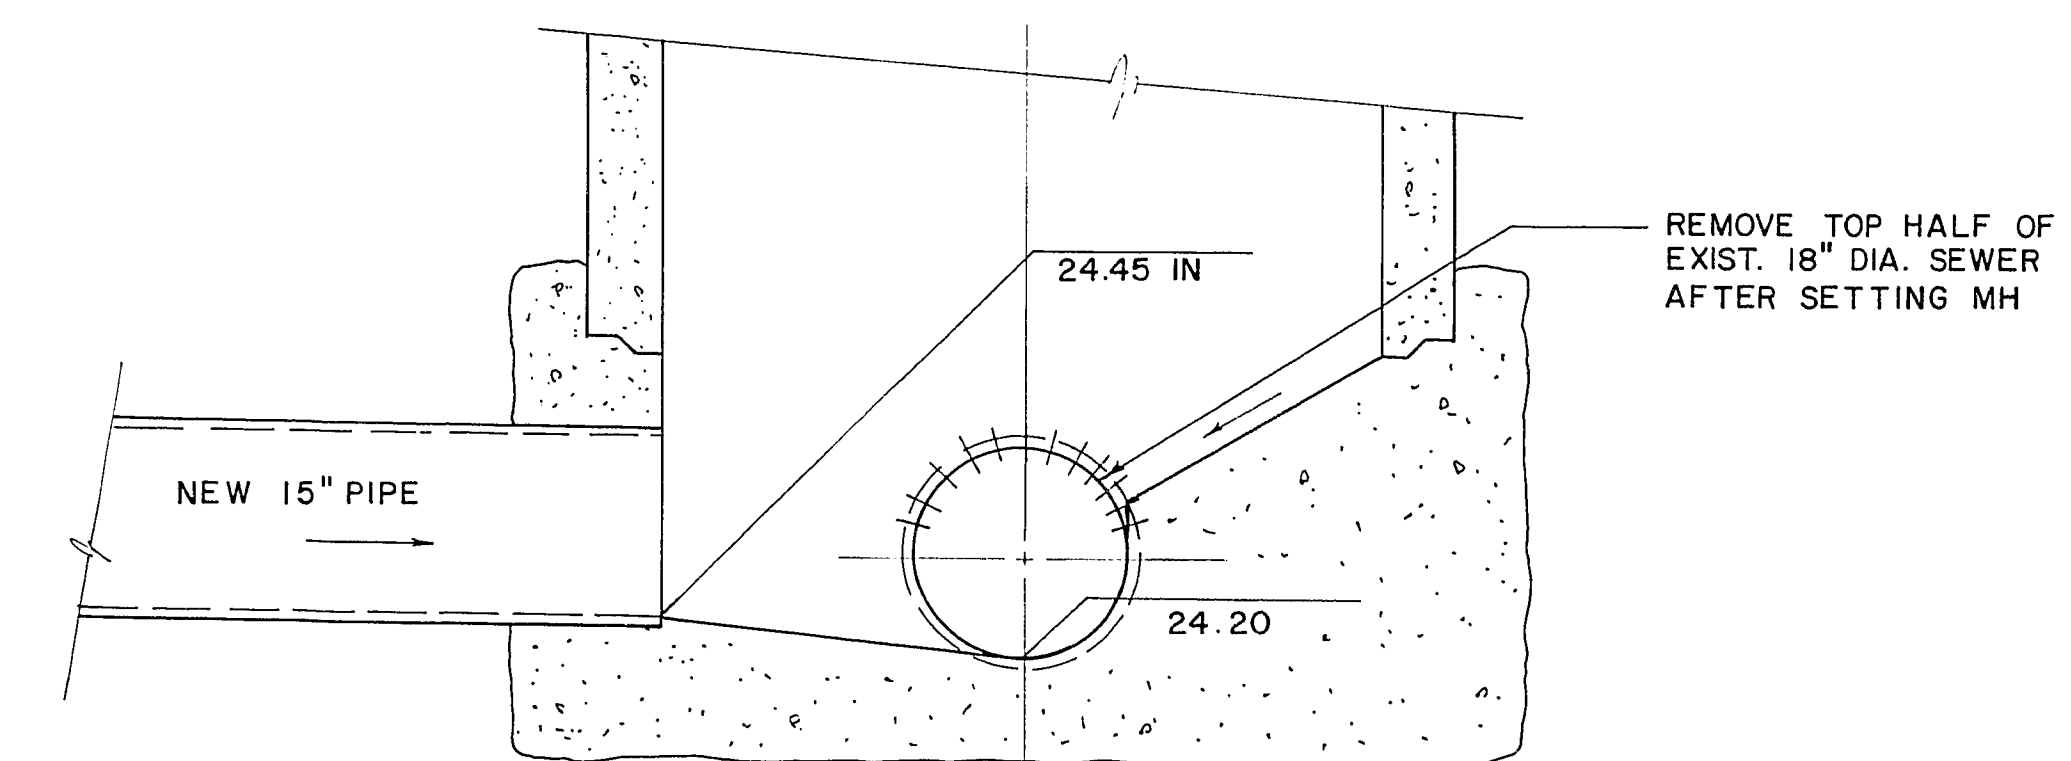

**SECTION**  
 SCALE: 3/4" = 1'-0"

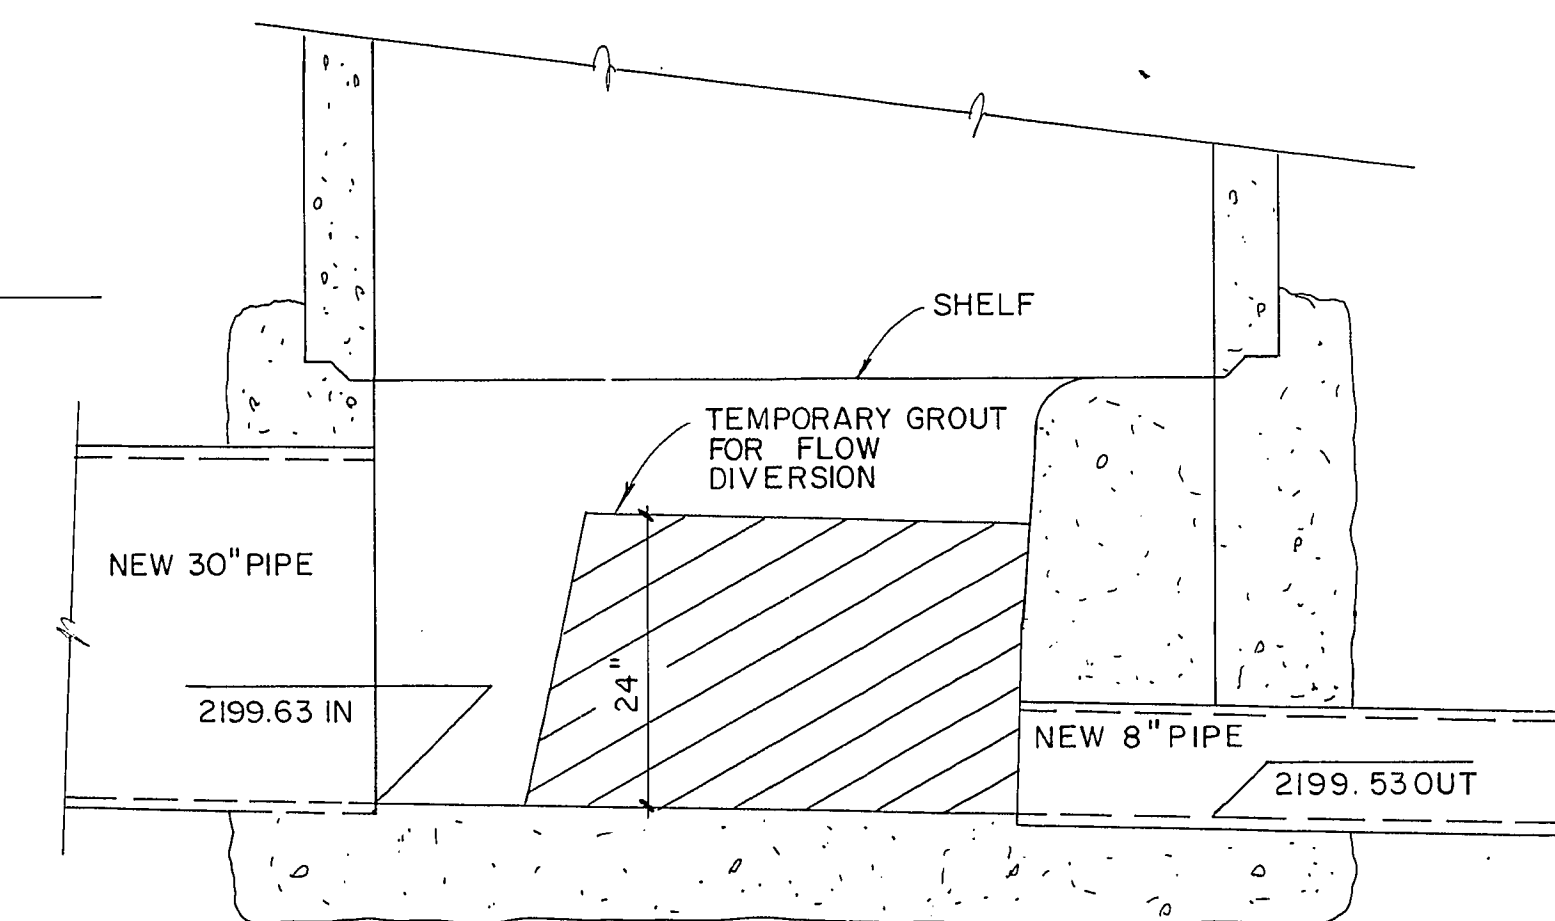

**SECTION**  
 SCALE: 3/4" = 1'-0"

No.	DATE	BY	REVISION
2	1-20-89	ST	REVISIONS
1	12-28-88	ST	CITY'S 95% COMPLETION REVIEW COMMENTS

Job No. 48901.00	Designed DJM & KJE	Proj. Engr. KS & ST
SCALE AS NOTED	Drawn by CDM	Approved by MG & ST
	Checked by KS & ST	Date 9-30-88

**URS CONSULTANTS, INC.**  
 Engineering and Environmental Consultants  
 Las Vegas, Nevada

**CITY OF LAS VEGAS**  
**CHEYENNE / WESTSIDE INTERCEPTOR**

**MANHOLE DETAILS**  
 SHEET **26** / **27**  
 307-V634

24-1-78