

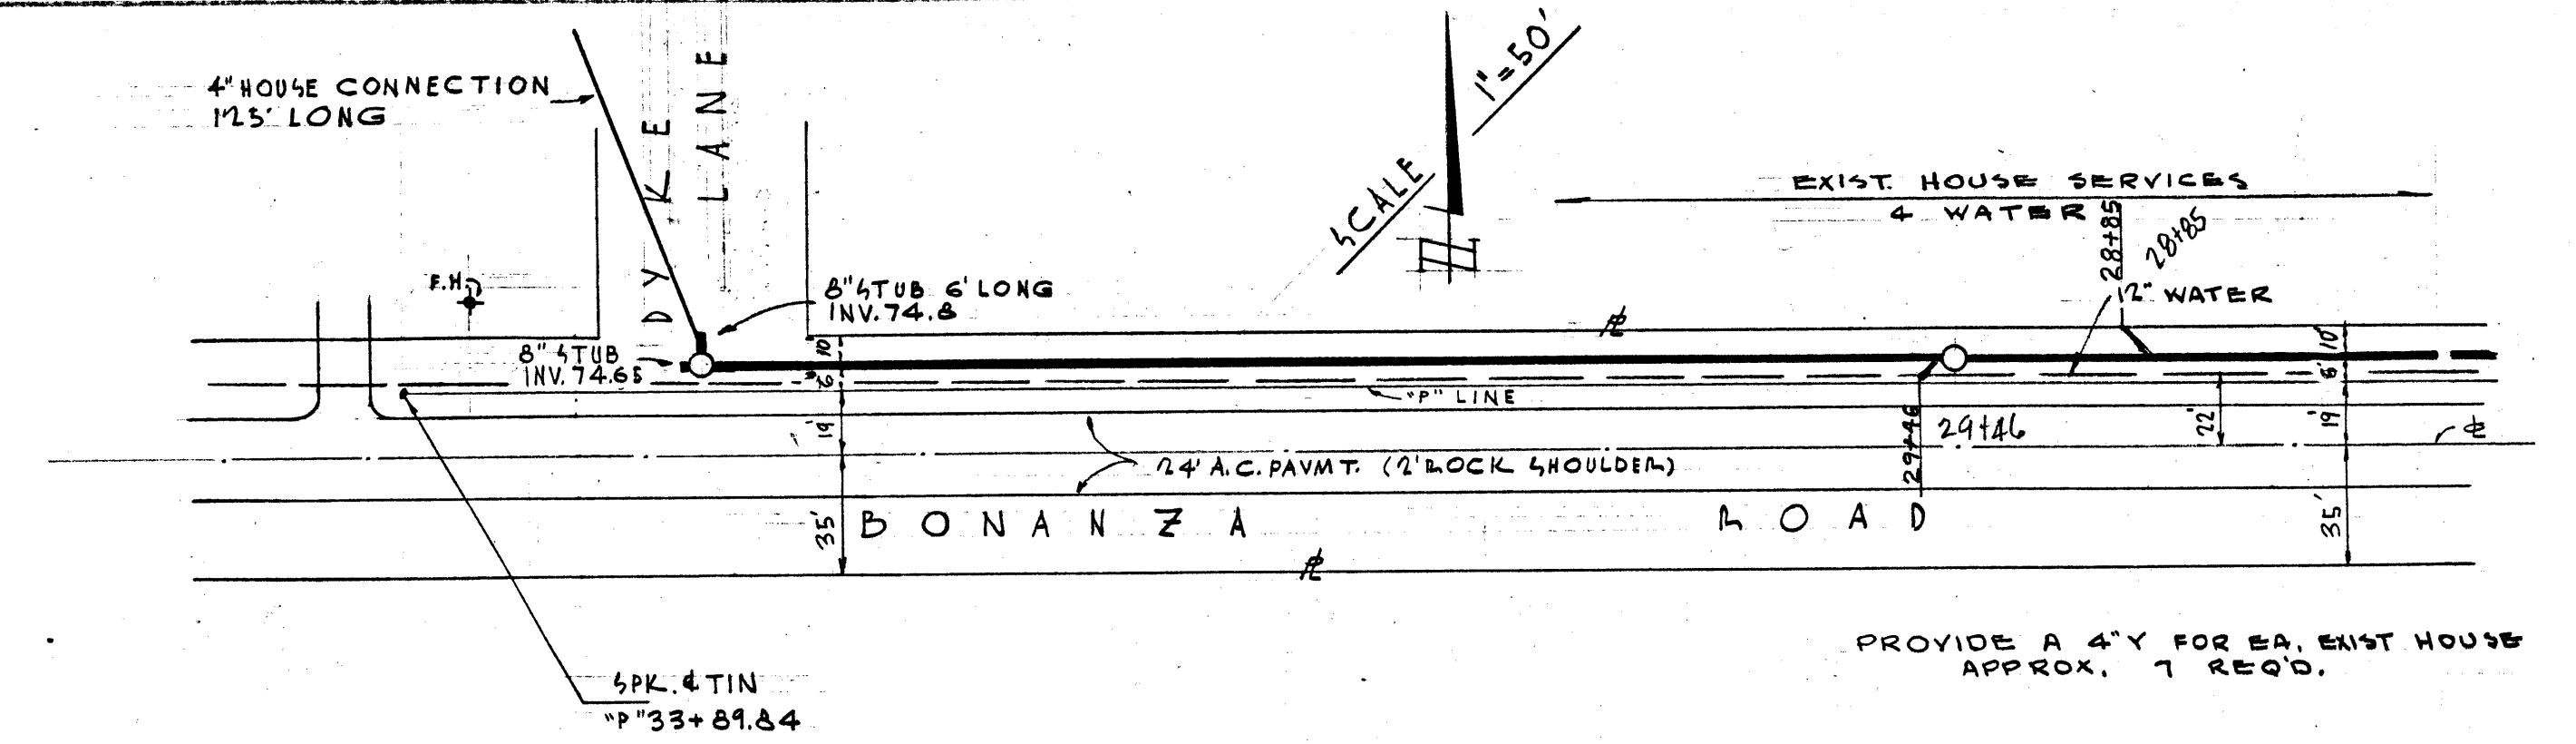


PLAN
 PROPERTY
 PROJECT
 SHEET NO.
 DATE

SCALE
 CHECKED
 DATE

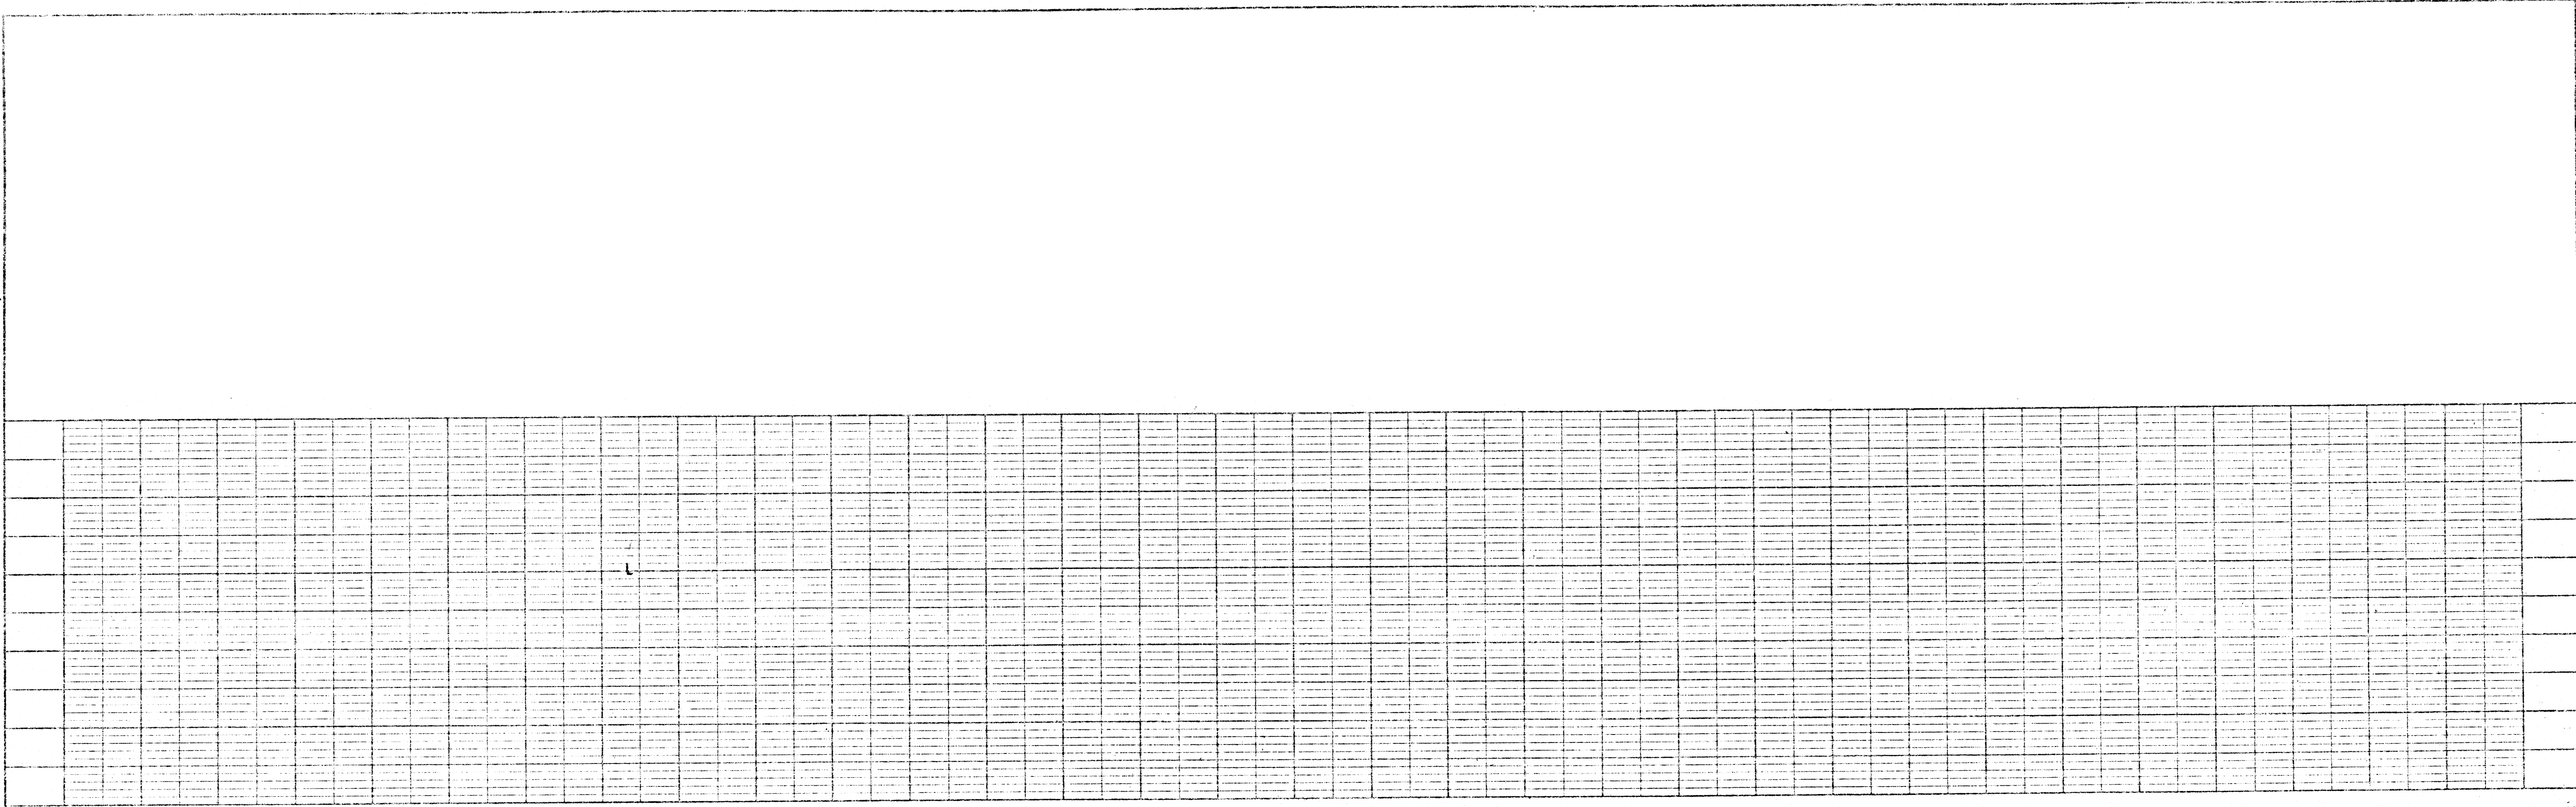

NOTE: "P" LINE STA. 6' GEMEN & STA. SAME FOR THIS PORTION

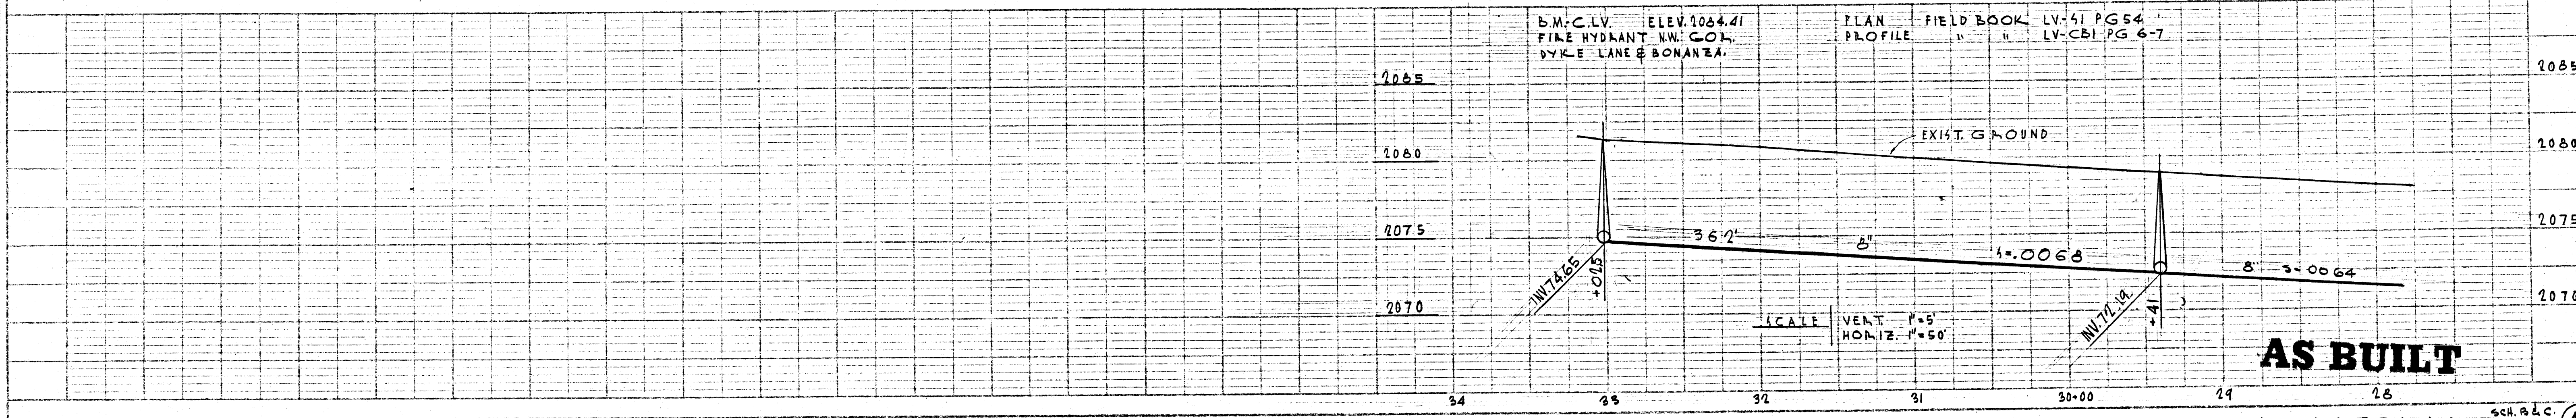

AS BUILT

Δ NOV. 1954 - ADDED SERVICE STA. 28+00 TO STA. 23+02 TO SCHEDULE "C"