


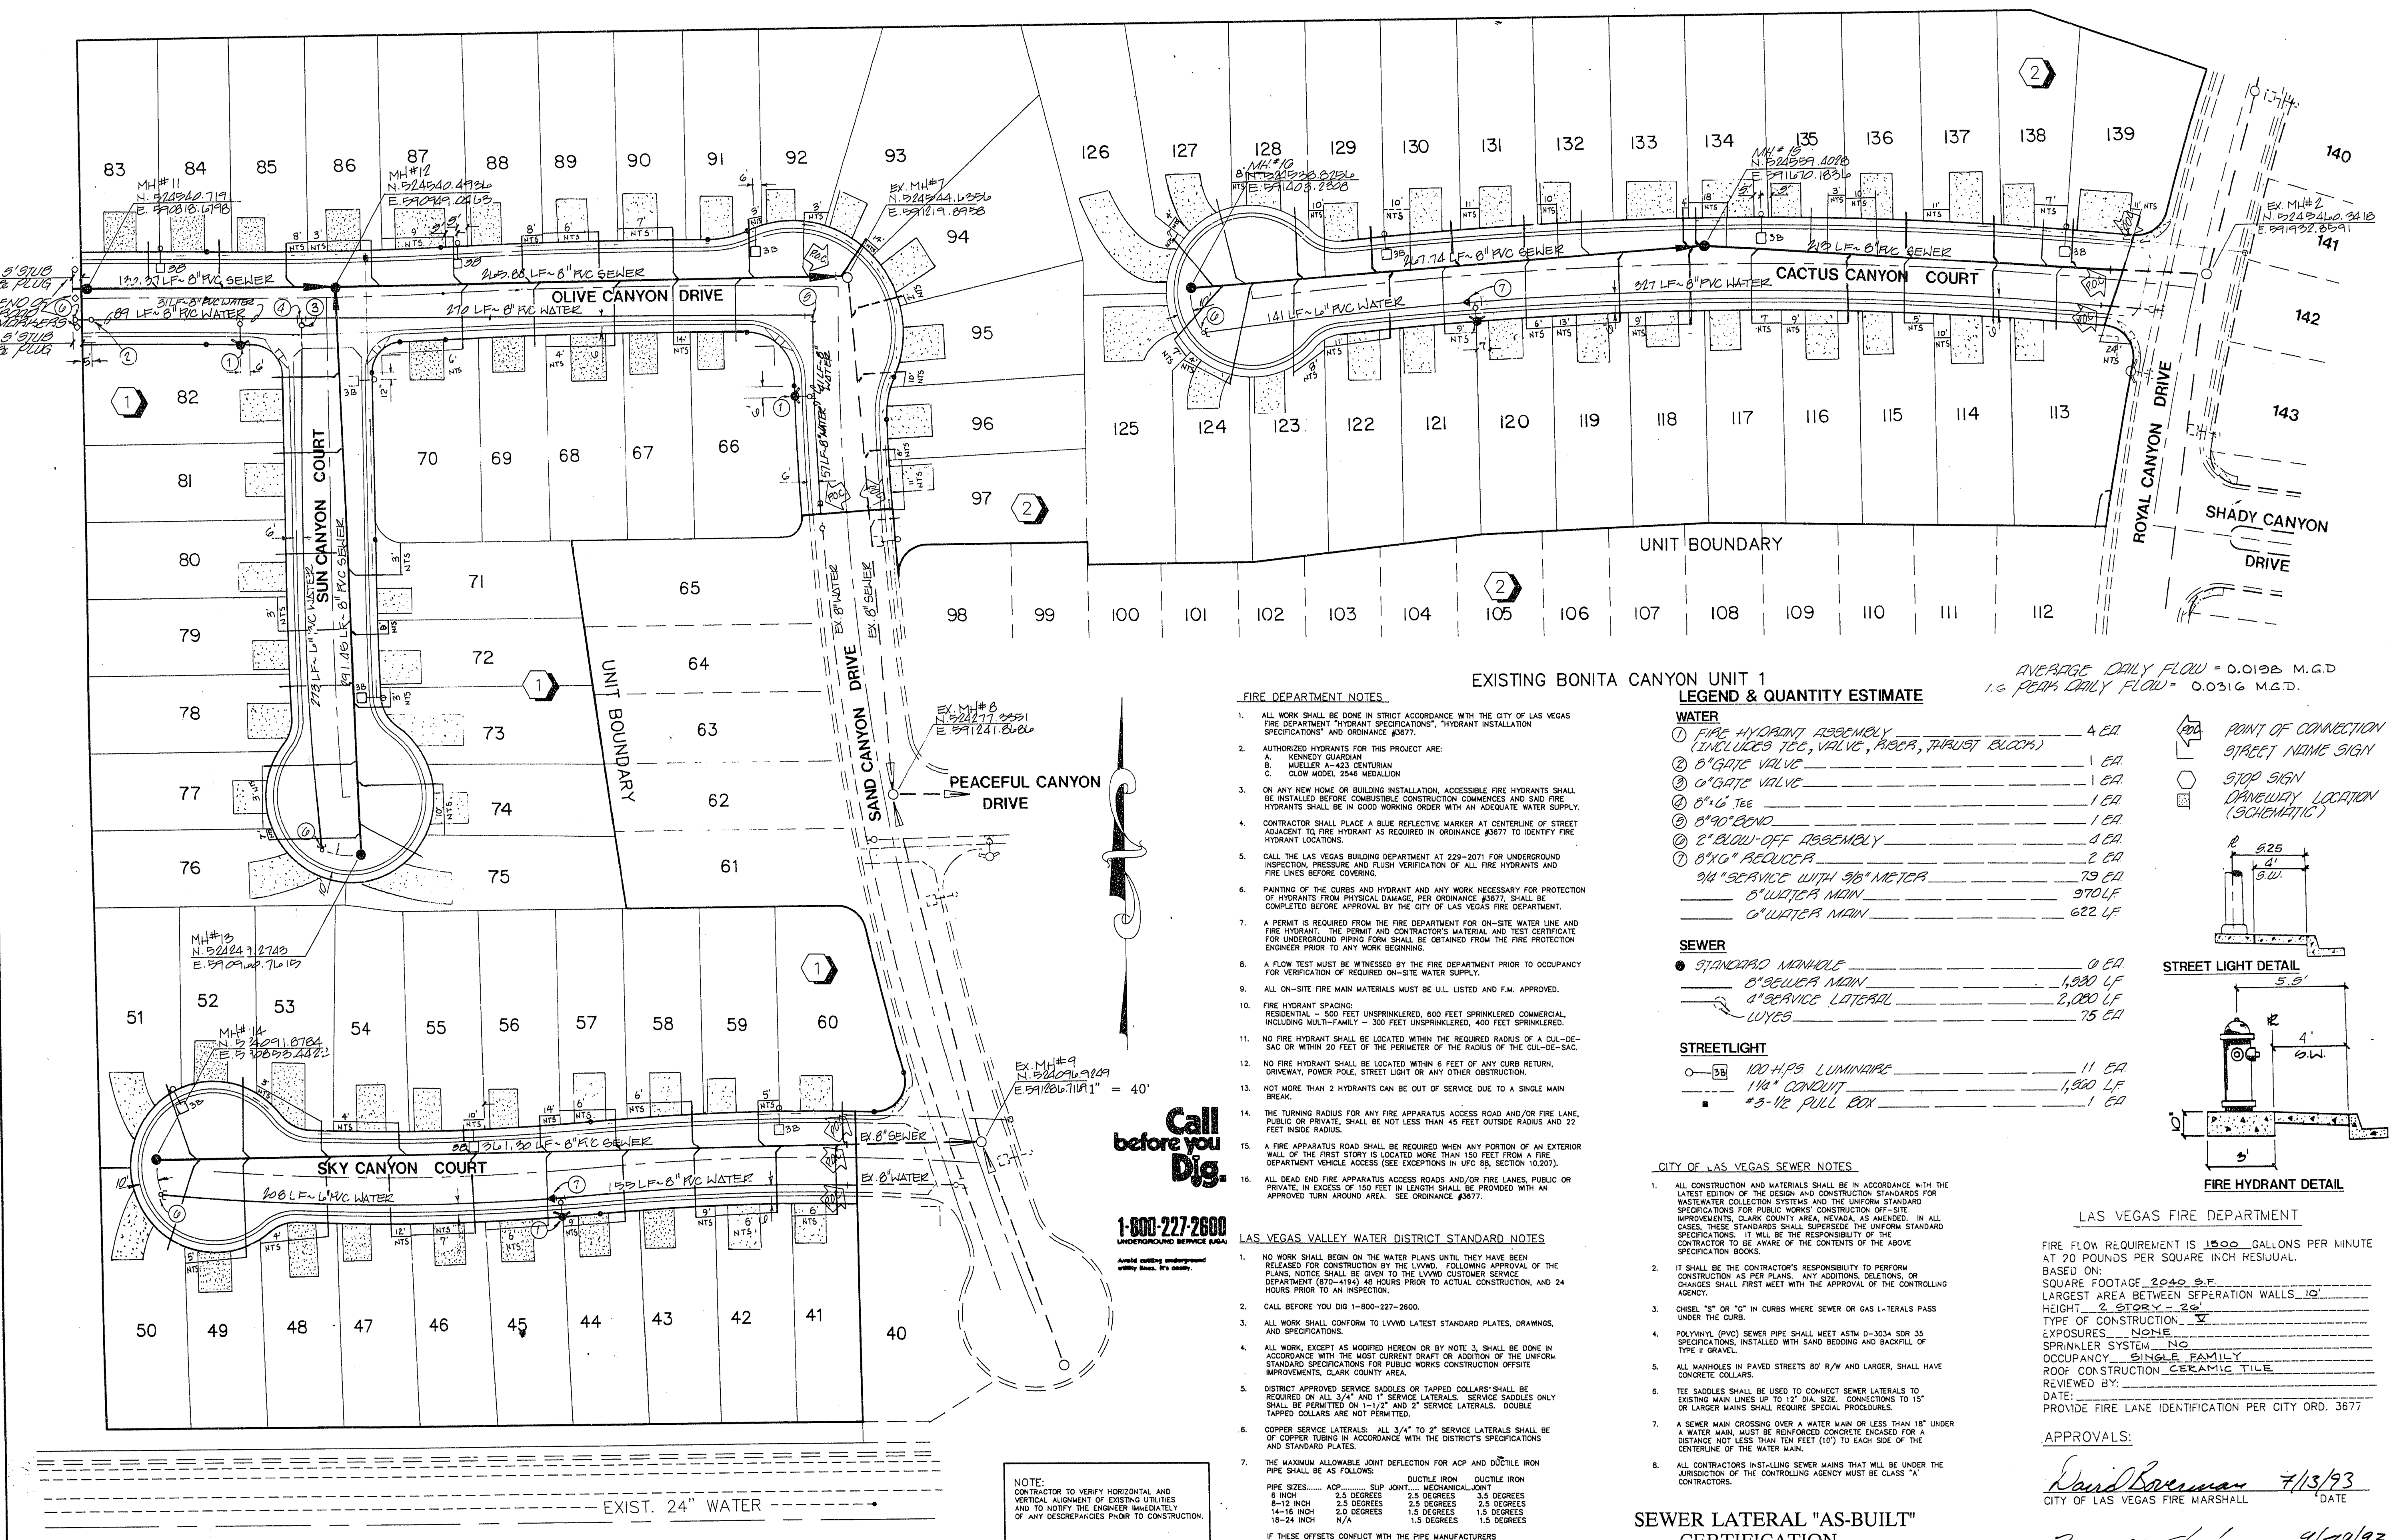

EXISTING BONITA CANYON UNIT 1
LEGEND & QUANTITY ESTIMATE

1.	ALL WORK SHALL BE DONE IN STRICT ACCORDANCE WITH THE CITY OF LAS VEGAS FIRE DEPARTMENT "HYDRANT SPECIFICATIONS", "HYDRANT INSTALLATION SPECIFICATIONS" AND ORDINANCE #877.	
2.	AUTHORIZED HYDRANTS FOR THIS PROJECT ARE: A. KENNEDY GUARDIAN B. MUELLER A-425 CENTURION C. CLOW MODEL 2546 MEDALLION	
3.	ON ANY NEW HOME OR BUILDING INSTALLATION, ACCESSIBLE FIRE HYDRANTS SHALL BE INSTALLED BEFORE COMPLETION OF CONSTRUCTION COMMENCES AND SAID FIRE HYDRANTS SHALL BE IN GOOD WORKING ORDER WITH AN ADEQUATE WATER SUPPLY.	
4.	CONTRACTOR SHALL PLACE A BLUE REFLECTIVE MARKER AT CENTERLINE OF STREET ADJACENT TO FIRE HYDRANT AS REQUIRED IN ORDINANCE #877 TO IDENTIFY FIRE HYDRANT LOCATIONS.	
5.	CALL THE LAS VEGAS BUILDING DEPARTMENT AT 229-2071 FOR UNDERGROUND INSPECTION, PRESSURE AND FLOW VERIFICATION OF ALL FIRE HYDRANTS AND FIRE LINES BEFORE COVERING.	
6.	PAINTING OF THE CURBS AND HYDRANT AND ANY WORK NECESSARY FOR PROTECTION OF HYDRANTS FROM PHYSICAL DAMAGE, PER ORDINANCE #877, SHALL BE COMPLETED BEFORE APPROVAL BY THE CITY OF LAS VEGAS FIRE DEPARTMENT.	
7.	A PERMIT IS REQUIRED FROM THE FIRE DEPARTMENT FOR ON-SITE WATER LINE AND FIRE HYDRANT. THE PERMIT AND CONTRACTOR'S MATERIAL AND TEST CERTIFICATE FOR UNDERGROUND PIPING FORM SHALL BE OBTAINED FROM THE FIRE PROTECTION ENGINEER PRIOR TO ANY WORK BEGINNING.	
8.	A FLOW TEST MUST BE WITNESSED BY THE FIRE DEPARTMENT PRIOR TO OCCUPANCY FOR VERIFICATION OF REQUIRED ON-SITE WATER SUPPLY.	
9.	ALL ON-SITE FIRE MAIN MATERIALS MUST BE U.L. LISTED AND F.M. APPROVED.	
10.	FIRE HYDRANT SPACING: RESIDENTIAL - 500 FEET UNSPRINKLERED, 600 FEET SPRINKLERED COMMERCIAL, INCLUDING MULTI-FAMILY - 300 FEET UNSPRINKLERED, 400 FEET SPRINKLERED.	
11.	NO FIRE HYDRANT SHALL BE LOCATED WITHIN THE REQUIRED RADIUS OF A CUL-DE-SAC OR WITHIN 20 FEET OF THE PERIMETER OF THE RADIUS OF THE CUL-DE-SAC.	
12.	NO FIRE HYDRANT SHALL BE LOCATED WITHIN 6 FEET OF ANY CURB RETURN, DRIVEWAY, POWER POLE, STREET LIGHT OR ANY OTHER OBSTRUCTION.	
13.	NOT MORE THAN 2 HYDRANTS CAN BE OUT OF SERVICE DUE TO A SINGLE MAIN BREAK.	
14.	THE TURNING RADIUS FOR ANY FIRE APPARATUS ACCESS ROAD AND/OR FIRE LANE, PUBLIC OR PRIVATE, SHALL BE NOT LESS THAN 45 FEET OUTSIDE RADIUS AND 22 FEET INSIDE RADIUS.	
15.	A FIRE APPARATUS ROAD SHALL BE REQUIRED WHEN ANY PORTION OF AN EXTERIOR WALL OF THE FIRST STORY IS LOCATED MORE THAN 150 FEET FROM A FIRE DEPARTMENT VEHICLE ACCESS (SEE EXCEPTIONS IN UFG 88, SECTION 10.207).	

LAS VEGAS VALLEY WATER DISTRICT STANDARD NOTES																					
1. NO WORK SHALL BEGIN ON THE WATER PLANS UNTIL THEY HAVE BEEN RELEASED FOR CONSTRUCTION BY THE LVWD. FOLLOWING APPROVAL OF THE PLANS, NOTICE SHALL BE GIVEN TO THE LVWD CUSTOMER SERVICE DEPARTMENT (870-4194) 48 HOURS PRIOR TO ACTUAL CONSTRUCTION, AND 24 HOURS PRIOR TO AN INSPECTION.																					
2. CALL BEFORE YOU DIG 1-800-227-2600.																					
3. ALL WORK SHALL CONFORM TO LVWD LATEST STANDARD PLATES, DRAWINGS, AND SPECIFICATIONS.																					
4. ALL WORK, EXCEPT AS MODIFIED HEREON OR BY NOTE 3, SHALL BE DONE IN ACCORDANCE WITH THE MOST CURRENT DRAFT OR ADDITION OF THE UNIFORM STANDARD SPECIFICATIONS FOR PUBLIC WORKS CONSTRUCTION OFF-SITE IMPROVEMENTS, CLARK COUNTY AREA.																					
5. DISTRICT APPROVED SERVICE SADDLES OR TAPPED COLLARS SHALL BE REQUIRED ON ALL 3/4" AND 1" SERVICE LATERALS. SERVICE SADDLES ONLY SHALL BE PERMITTED ON 1-1/2" AND 2" SERVICE LATERALS. DOUBLE TAPPED COLLARS ARE NOT PERMITTED.																					
6. COPPER SERVICE LATERALS: ALL 3/4" TO 2" SERVICE LATERALS SHALL BE OF COPPER TUBING IN ACCORDANCE WITH THE DISTRICT'S SPECIFICATIONS AND STANDARD PLATES.																					
7. THE MAXIMUM ALLOWABLE JOINT DEFLECTION FOR ACP AND DUCTILE IRON PIPE SHALL BE AS FOLLOWS: <table><tr><th>PIPE SIZES</th><th>... ACP</th><th>... SLIP JOINT</th><th>... DUCTILE IRON</th></tr><tr><td>6 INCH</td><td>2.5 DEGREES</td><td>2.5 DEGREES</td><td>3.5 DEGREES</td></tr><tr><td>8-12 INCH</td><td>2.5 DEGREES</td><td>2.5 DEGREES</td><td>2.5 DEGREES</td></tr><tr><td>14-16 INCH</td><td>2.0 DEGREES</td><td>1.5 DEGREES</td><td>1.5 DEGREES</td></tr><tr><td>18-24 INCH</td><td>N/A</td><td>N/A</td><td>1.5 DEGREES</td></tr></table> IF THESE OFFSETS CONFLICT WITH THE PIPE MANUFACTURERS RECOMMENDATION, THE MORE STRINGENT REQUIREMENT SHALL APPLY.		PIPE SIZES	... ACP	... SLIP JOINT	... DUCTILE IRON	6 INCH	2.5 DEGREES	2.5 DEGREES	3.5 DEGREES	8-12 INCH	2.5 DEGREES	2.5 DEGREES	2.5 DEGREES	14-16 INCH	2.0 DEGREES	1.5 DEGREES	1.5 DEGREES	18-24 INCH	N/A	N/A	1.5 DEGREES
PIPE SIZES	... ACP	... SLIP JOINT	... DUCTILE IRON																		
6 INCH	2.5 DEGREES	2.5 DEGREES	3.5 DEGREES																		
8-12 INCH	2.5 DEGREES	2.5 DEGREES	2.5 DEGREES																		
14-16 INCH	2.0 DEGREES	1.5 DEGREES	1.5 DEGREES																		
18-24 INCH	N/A	N/A	1.5 DEGREES																		
8. ALL WATER METER BOXES SHALL BE LOCATED OUTSIDE OF DRIVEWAY AREAS.																					
9. ALL VALVES SHALL BE LOCATED OUTSIDE OF DRIVEWAYS AND VALVE OUTLETS.																					
10. DETECTOR TAPE SHALL BE REQUIRED IN ACCORDANCE WITH STANDARD PLATE NO. WHERE INDICATED, AND AS FOLLOWS: A) OVER ALL MAINS NOT INSTALLED 6 FEET FROM BACK OF CURB. B) OVER ALL SERVICE LATERALS NOT INSTALLED AT RIGHT ANGLES TO MAIN.																					
11. ALL WATER MAINS SHALL BE PRESSURE TESTED AT 200 PSI FOR A CONTINUOUS TWO HOUR PERIOD, IN ACCORDANCE WITH DISTRICT STANDARDS.																					
12. ALL WATER MAINS SHALL BE DISINFECTED, FLUSHED, AND AN ACCEPTABLE HEALTH SAMPLE OBTAINED, PRIOR TO THE CONNECTION OF THE WATER MAIN(S) AND/OR LATERAL(S) TO THE DISTRICT'S SYSTEM.																					
13. CONTRACTOR TO OBTAIN ALL METERS 2" AND SMALLER FROM LVWD. CENTRAL STORES. TELEPHONE 228-3102. FORTY-EIGHT (48) HOURS FROM TO PICKUP.																					

FIRE DEPARTMENT	
1	ALL WORK SHALL BE DONE IN STRICT ACCORDANCE WITH THE CITY OF LAS VEGAS FIRE DEPARTMENT "HYDRANT SPECIFICATIONS", "HYDRANT INSTALLATION SPECIFICATIONS" AND ORDINANCE #877.
2	AUTHORIZED HYDRANTS FOR THIS PROJECT ARE: A. KENNEDY GUARDIAN B. MUELLER A-425 CENTURION C. CLOW MODEL 2546 MEDALLION
3	ON ANY NEW HOME OR BUILDING INSTALLATION, ACCESSIBLE FIRE HYDRANTS SHALL BE INSTALLED BEFORE COMPLETION OF CONSTRUCTION COMMENCES AND SAID FIRE HYDRANTS SHALL BE IN GOOD WORKING ORDER WITH AN ADEQUATE WATER SUPPLY.
4	CONTRACTOR SHALL PLACE A BLUE REFLECTIVE MARKER AT CENTERLINE OF STREET ADJACENT TO FIRE HYDRANT AS REQUIRED IN ORDINANCE #877 TO IDENTIFY FIRE HYDRANT LOCATIONS.
5	CALL THE LAS VEGAS BUILDING DEPARTMENT AT 229-2071 FOR UNDERGROUND INSPECTION, PRESSURE AND FLOW VERIFICATION OF ALL FIRE HYDRANTS AND FIRE LINES BEFORE COVERING.
6	PAINTING OF THE CURBS AND HYDRANT AND ANY WORK NECESSARY FOR PROTECTION OF HYDRANTS FROM PHYSICAL DAMAGE, PER ORDINANCE #877, SHALL BE COMPLETED BEFORE APPROVAL BY THE CITY OF LAS VEGAS FIRE DEPARTMENT.
7	A PERMIT IS REQUIRED FROM THE FIRE DEPARTMENT FOR ON-SITE WATER LINE AND FIRE HYDRANT. THE PERMIT AND CONTRACTOR'S MATERIAL AND TEST CERTIFICATE FOR UNDERGROUND PIPING FORM SHALL BE OBTAINED FROM THE FIRE PROTECTION ENGINEER PRIOR TO ANY WORK BEGINNING.
8	A FLOW TEST MUST BE WITNESSED BY THE FIRE DEPARTMENT PRIOR TO OCCUPANCY FOR VERIFICATION OF REQUIRED ON-SITE WATER SUPPLY.
9	ALL ON-SITE FIRE MAIN MATERIALS MUST BE U.L. LISTED AND F.M. APPROVED.
10	FIRE HYDRANT SPACING: RESIDENTIAL - 500 FEET UNSPRINKLERED, 600 FEET SPRINKLERED COMMERCIAL, INCLUDING MULTI-FAMILY - 300 FEET UNSPRINKLERED, 400 FEET SPRINKLERED.
11	NO FIRE HYDRANT SHALL BE LOCATED WITHIN THE REQUIRED RADIUS OF A CUL-DE-SAC OR WITHIN 20 FEET OF THE PERIMETER OF THE RADIUS OF THE CUL-DE-SAC.
12	NO FIRE HYDRANT SHALL BE LOCATED WITHIN 6 FEET OF ANY CURB RETURN, DRIVEWAY, POWER POLE, STREET LIGHT OR ANY OTHER OBSTRUCTION.
13	NOT MORE THAN 2 HYDRANTS CAN BE OUT OF SERVICE DUE TO A SINGLE MAIN BREAK.
14	THE TURNING RADIUS FOR ANY FIRE APPARATUS ACCESS ROAD AND/OR FIRE LANE, PUBLIC OR PRIVATE, SHALL BE NOT LESS THAN 45 FEET OUTSIDE RADIUS AND 22 FEET INSIDE RADIUS.
15	A FIRE APPARATUS ROAD SHALL BE REQUIRED WHEN ANY PORTION OF AN EXTERIOR WALL OF THE FIRST STORY IS LOCATED MORE THAN 150 FEET FROM A FIRE DEPARTMENT VEHICLE ACCESS (SEE EXCEPTIONS IN UFG 88, SECTION 10.207).

LAS VEGAS VALLEY WATER DISTRICT STANDARD NOTES																					
1. NO WORK SHALL BEGIN ON THE WATER PLANS UNTIL THEY HAVE BEEN RELEASED FOR CONSTRUCTION BY THE LVWD. FOLLOWING APPROVAL OF THE PLANS, NOTICE SHALL BE GIVEN TO THE LVWD CUSTOMER SERVICE DEPARTMENT (870-4194) 48 HOURS PRIOR TO ACTUAL CONSTRUCTION, AND 24 HOURS PRIOR TO AN INSPECTION.																					
2. CALL BEFORE YOU DIG 1-800-227-2600.																					
3. ALL WORK SHALL CONFORM TO LVWD LATEST STANDARD PLATES, DRAWINGS, AND SPECIFICATIONS.																					
4. ALL WORK, EXCEPT AS MODIFIED HEREON OR BY NOTE 3, SHALL BE DONE IN ACCORDANCE WITH THE MOST CURRENT DRAFT OR ADDITION OF THE UNIFORM STANDARD SPECIFICATIONS FOR PUBLIC WORKS CONSTRUCTION OFF-SITE IMPROVEMENTS, CLARK COUNTY AREA.																					
5. DISTRICT APPROVED SERVICE SADDLES OR TAPPED COLLARS SHALL BE REQUIRED ON ALL 3/4" AND 1" SERVICE LATERALS. SERVICE SADDLES ONLY SHALL BE PERMITTED ON 1-1/2" AND 2" SERVICE LATERALS. DOUBLE TAPPED COLLARS ARE NOT PERMITTED.																					
6. COPPER SERVICE LATERALS: ALL 3/4" TO 2" SERVICE LATERALS SHALL BE OF COPPER TUBING IN ACCORDANCE WITH THE DISTRICT'S SPECIFICATIONS AND STANDARD PLATES.																					
7. THE MAXIMUM ALLOWABLE JOINT DEFLECTION FOR ACP AND DUCTILE IRON PIPE SHALL BE AS FOLLOWS: <table><tr><th>PIPE SIZES</th><th>... ACP</th><th>... SLIP JOINT</th><th>... DUCTILE IRON</th></tr><tr><td>6 INCH</td><td>2.5 DEGREES</td><td>2.5 DEGREES</td><td>3.5 DEGREES</td></tr><tr><td>8-12 INCH</td><td>2.5 DEGREES</td><td>2.5 DEGREES</td><td>2.5 DEGREES</td></tr><tr><td>14-16 INCH</td><td>2.0 DEGREES</td><td>1.5 DEGREES</td><td>1.5 DEGREES</td></tr><tr><td>18-24 INCH</td><td>N/A</td><td>N/A</td><td>1.5 DEGREES</td></tr></table> IF THESE OFFSETS CONFLICT WITH THE PIPE MANUFACTURERS RECOMMENDATION, THE MORE STRINGENT REQUIREMENT SHALL APPLY.		PIPE SIZES	... ACP	... SLIP JOINT	... DUCTILE IRON	6 INCH	2.5 DEGREES	2.5 DEGREES	3.5 DEGREES	8-12 INCH	2.5 DEGREES	2.5 DEGREES	2.5 DEGREES	14-16 INCH	2.0 DEGREES	1.5 DEGREES	1.5 DEGREES	18-24 INCH	N/A	N/A	1.5 DEGREES
PIPE SIZES	... ACP	... SLIP JOINT	... DUCTILE IRON																		
6 INCH	2.5 DEGREES	2.5 DEGREES	3.5 DEGREES																		
8-12 INCH	2.5 DEGREES	2.5 DEGREES	2.5 DEGREES																		
14-16 INCH	2.0 DEGREES	1.5 DEGREES	1.5 DEGREES																		
18-24 INCH	N/A	N/A	1.5 DEGREES																		
8. ALL WATER METER BOXES SHALL BE LOCATED OUTSIDE OF DRIVEWAY AREAS.																					
9. ALL VALVES SHALL BE LOCATED OUTSIDE OF DRIVEWAYS AND VALVE OUTLETS.																					
10. DETECTOR TAPE SHALL BE REQUIRED IN ACCORDANCE WITH STANDARD PLATE NO. WHERE INDICATED, AND AS FOLLOWS: A) OVER ALL MAINS NOT INSTALLED 6 FEET FROM BACK OF CURB. B) OVER ALL SERVICE LATERALS NOT INSTALLED AT RIGHT ANGLES TO MAIN.																					
11. ALL WATER MAINS SHALL BE PRESSURE TESTED AT 200 PSI FOR A CONTINUOUS TWO HOUR PERIOD, IN ACCORDANCE WITH DISTRICT STANDARDS.																					
12. ALL WATER MAINS SHALL BE DISINFECTED, FLUSHED, AND AN ACCEPTABLE HEALTH SAMPLE OBTAINED, PRIOR TO THE CONNECTION OF THE WATER MAIN(S) AND/OR LATERAL(S) TO THE DISTRICT'S SYSTEM.																					
13. CONTRACTOR TO OBTAIN ALL METERS 2" AND SMALLER FROM LVWD. CENTRAL STORES. TELEPHONE 228-3102. FORTY-EIGHT (48) HOURS FROM TO PICKUP.																					

FIRE DEPARTMENT	
1	ALL WORK SHALL BE DONE IN STRICT ACCORDANCE WITH THE CITY OF LAS VEGAS FIRE DEPARTMENT "HYDRANT SPECIFICATIONS", "HYDRANT INSTALLATION SPECIFICATIONS" AND ORDINANCE #877.
2	AUTHORIZED HYDRANTS FOR THIS PROJECT ARE: A. KENNEDY GUARDIAN B. MUELLER A-425 CENTURION C. CLOW MODEL 2546 MEDALLION
3	ON ANY NEW HOME OR BUILDING INSTALLATION, ACCESSIBLE FIRE HYDRANTS SHALL BE INSTALLED BEFORE COMPLETION OF CONSTRUCTION COMMENCES AND SAID FIRE HYDRANTS SHALL BE IN GOOD WORKING ORDER WITH AN ADEQUATE WATER SUPPLY.
4	CONTRACTOR SHALL PLACE A BLUE REFLECTIVE MARKER AT CENTERLINE OF STREET ADJACENT TO FIRE HYDRANT AS REQUIRED IN ORDINANCE #877 TO IDENTIFY FIRE HYDRANT LOCATIONS.
5	CALL THE LAS VEGAS BUILDING DEPARTMENT AT 229-2071 FOR UNDERGROUND INSPECTION, PRESSURE AND FLOW VERIFICATION OF ALL FIRE HYDRANTS AND FIRE LINES BEFORE COVERING.
6	PAINTING OF THE CURBS AND HYDRANT AND ANY WORK NECESSARY FOR PROTECTION OF HYDRANTS FROM PHYSICAL DAMAGE, PER ORDINANCE #877, SHALL BE COMPLETED BEFORE APPROVAL BY THE CITY OF LAS VEGAS FIRE DEPARTMENT.
7	A PERMIT IS REQUIRED FROM THE FIRE DEPARTMENT FOR ON-SITE WATER LINE AND FIRE HYDRANT. THE PERMIT AND CONTRACTOR'S MATERIAL AND TEST CERTIFICATE FOR UNDERGROUND PIPING FORM SHALL BE OBTAINED FROM THE FIRE PROTECTION ENGINEER PRIOR TO ANY WORK BEGINNING.
8	A FLOW TEST MUST BE WITNESSED BY THE FIRE DEPARTMENT PRIOR TO OCCUPANCY FOR VERIFICATION OF REQUIRED ON-SITE WATER SUPPLY.
9	ALL ON-SITE FIRE MAIN MATERIALS MUST BE U.L. LISTED AND F.M. APPROVED.
10	FIRE

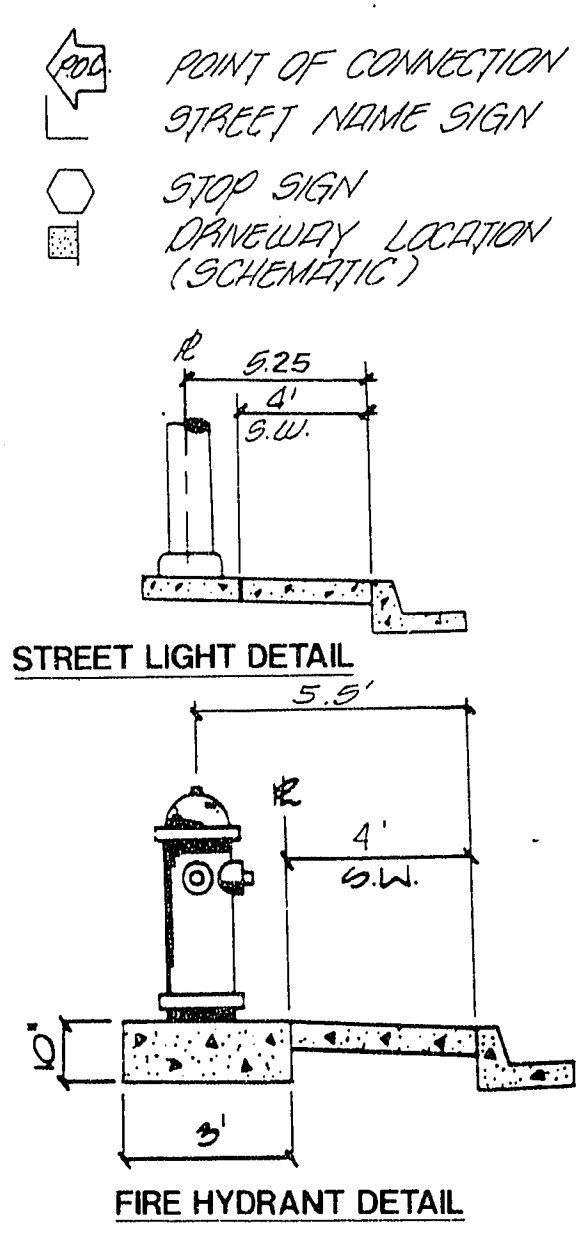

SEWER LATERAL "AS-BUILT" CERTIFICATION

STEPHEN P. GURLIKES, P.L.S.
NEVADA CERT. NO.: 9105
6/15/98

LAS VEGAS FIRE DEPARTMENT

FIRE FLOW REQUIREMENT IS 1500 GALLONS PER MINUTE AT 20 POUNDS PER SQUARE INCH RESIDUAL.
BASED ON:
SQUARE FOOTAGE 2040 S.F.
LARGEST AREA BETWEEN SEPARATION WALLS 10'
HEIGHT 2 STORIES
TYPE OF CONSTRUCTION 2
EXPOSURES NONE
SPRINKLER SYSTEM NO
OCCUPANCY SINGLE FAMILY
ROOF CONSTRUCTION CERAMIC TILE
REVIEWED BY:
DATE:
PROVIDE FIRE LANE IDENTIFICATION PER CITY ORD. 3677

APPROVALS:


David Bowman 7/13/93
CITY OF LAS VEGAS FIRE MARSHALL
DATE
LAS VEGAS VALLEY WATER DISTRICT
DATE
Nevada Power Company
DATE

NEVADA POWER COMPANY APPROVAL IS ONLY FOR THE PLACEMENT AND CLEARANCE OF STREET LIGHTS AND SIGNAL LIGHT INSTALLATION.

BENCHMARK

CITY OF LAS VEGAS BENCHMARK
CHISELED "X" IN TOP OF CURB, AT END OF CURB ON THE WEST SIDE OF DURANCO DR., APPROX. 250' SOUTH OF WESTCLIFF DR.
ELEVATION = 2610.16'

PROJECT NAME: BONITA CANYON UNIT 2
THIS PROJECT WATER PLAN COMPLIES WITH THE LAS VEGAS VALLEY WATER DISTRICT'S TECHNICAL REQUIREMENTS. HOWEVER, THIS WATER PLAN IS NOT APPROVED FOR CONSTRUCTION AT THIS TIME AND THIS SIGNATURE DOES NOT PROVIDE OR IMPLY A WATER COMMITMENT.
7/13/93
LVWD

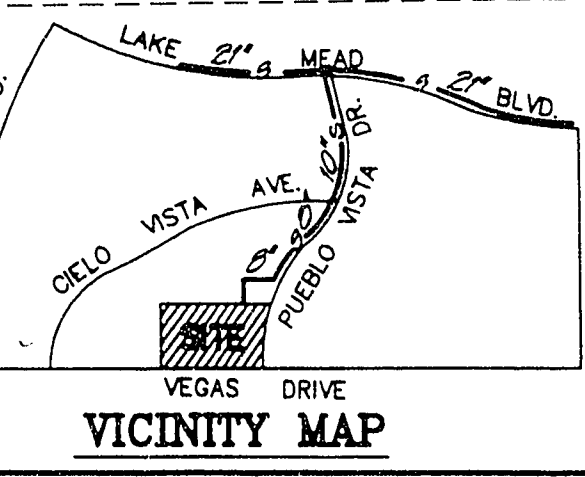

STREET LIGHT NOTE

ALL STREET LIGHTING INSTALLATION SHALL CONFORM TO SUMMERLIN STREET LIGHT TECHNICAL DESIGN REQUIREMENT DWG. NO. E-1 AND SUMMERLIN STREET LIGHT P.O.E. AND FIXTURE DETAIL DWG. NO. E-2.
ALL HAND HOLE COVERS MUST BE INSTALLED, POLE CAPS POURED, AND PULL BOX LIDS BOLTED DOWN PRIOR TO ENERGIZING CIRCUIT.
ALL WIRE MUST HAVE THW INSULATION.

PLASTER DEVELOPMENT
CITY OF LAS VEGAS, NEVADA
CONSULTING ENGINEERS • PLANNERS • LAND SURVEYORS
2727 SOUTH RAINBOW BOULEVARD
LAS VEGAS, NEVADA 89102-5148 PHONE (702) 873-7550 FAX (702) 362-2597

SEWER ASBUILT
BONITA CANYON
UNIT - 2

DATE: 2/28/93
SCALE: 1"=40'
SHEET: 6 OF 9 SHEETS
WD NO. 4407-2
BY: EEB/KFN
DATE: 2/28/93
SCALE: 1"=40'
SHEET: 6 OF 9 SHEETS