


DISCLAIMER NOTE:

UTILITY LOCATIONS SHOWN HEREON ARE APPROXIMATE ONLY. IT SHALL BE THE CONTRACTOR'S RESPONSIBILITY TO DETERMINE THE EXACT HORIZONTAL AND VERTICAL LOCATION OF ALL EXISTING UNDERGROUND OR OVERHEAD UTILITIES PRIOR TO COMMENCING CONSTRUCTION. NO REPRESENTATION IS MADE THAT ALL EXISTING UTILITIES ARE SHOWN HEREON. THE ENGINEER ASSUMES NO RESPONSIBILITY FOR UTILITIES NOT SHOWN OR UTILITIES NOT SHOWN IN THEIR PROPER LOCATION. CONTRACTOR TO NOTIFY ENGINEER OF ANY CHANGES OR DISCREPANCIES.

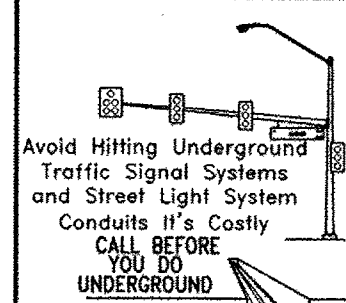

Call before you Dig
Call before you Overhead

Call before you Dig
Avoid cutting underground utility lines. It's costly.
Call before you Overhead
Avoid overhead power line contact. It's costly.
1-702-227-2929
Nevada Power
Environment and Safety
Services Department

Call before you Dig
Avoid cutting underground utility lines. It's costly.
Call before you Overhead
Avoid overhead power line contact. It's costly.
1-702-455-6000
CLARK COUNTY TRAFFIC OPERATIONS
AND
LAS VEGAS AREA COMPUTERIZED TRAFFIC SYSTEM




BENCHMARK

CITY OF LAS VEGAS BENCHMARK 6LV99 245ES
A RIVET AND PLATE IN THE TOP OF CURB AT THE NORTHWEST CORNER OF CENTENNIAL PARKWAY AND HUALAPAI WAY.

ELEVATION=844.924 METERS (NAVD'88)
ELEVATION=2772.06 US SURVEY FEET (NAVD'88)

BASIS OF BEARINGS

SOUTH 89°41'00" EAST BEING THE BEARING OF THE NORTH LINE OF THE NORTHWEST QUARTER (NW 1/4) OF THE NORTHWEST QUARTER (NW 1/4) OF SECTION 30, TOWNSHIP 19 SOUTH, RANGE 60 EAST, M.D.M., CLARK COUNTY, NEVADA AS SHOWN BY MAP THEREOF ON FILE IN THE CLARK COUNTY RECORDER'S OFFICE IN FILE 89, PAGE 3 OF SURVEYS.

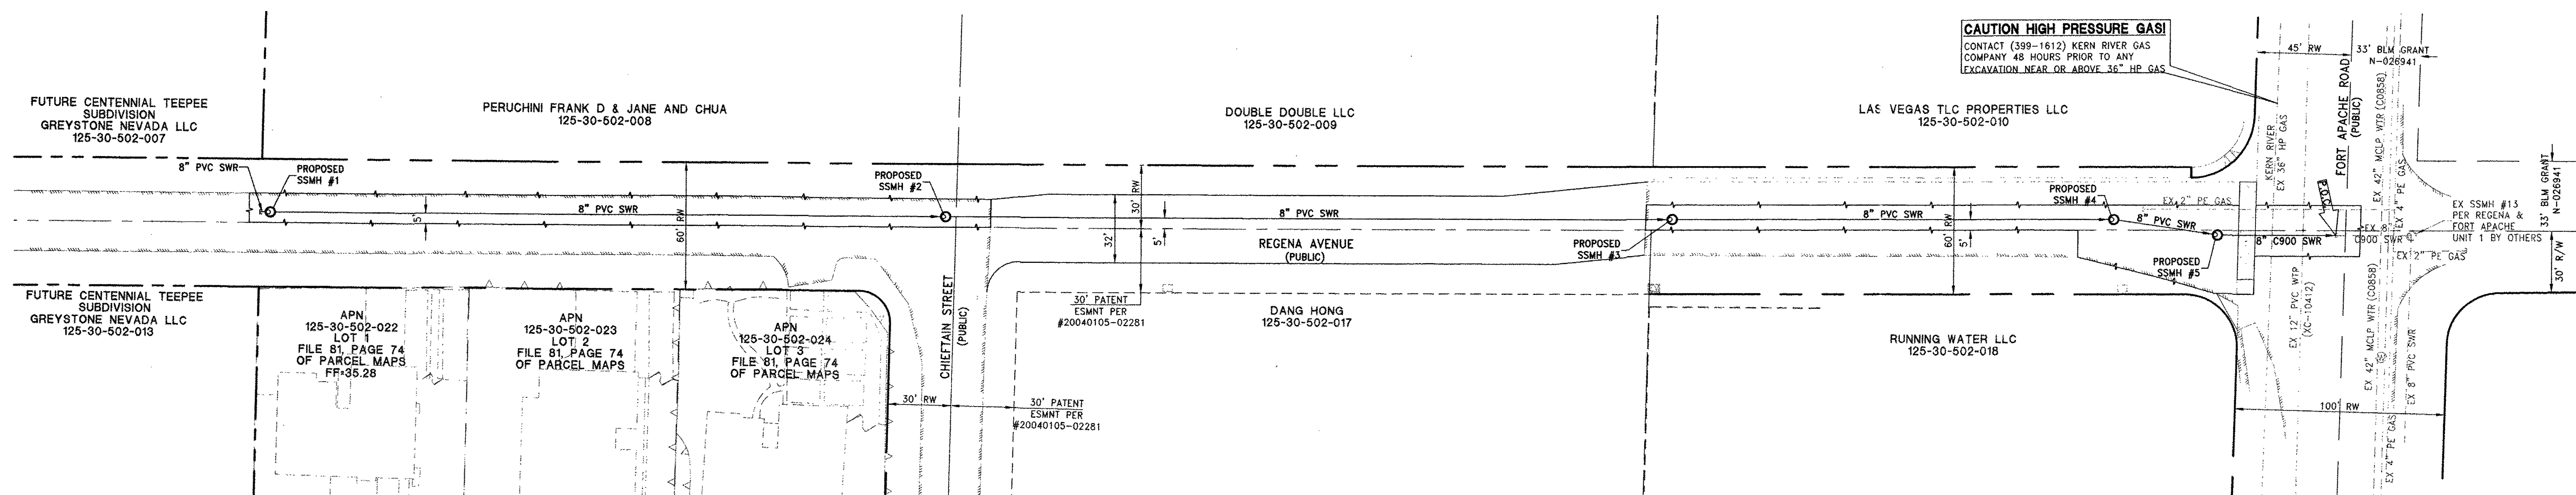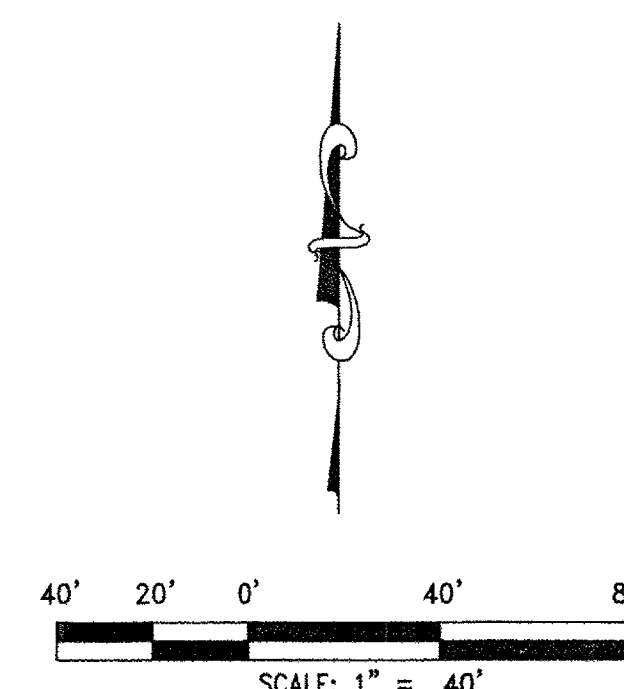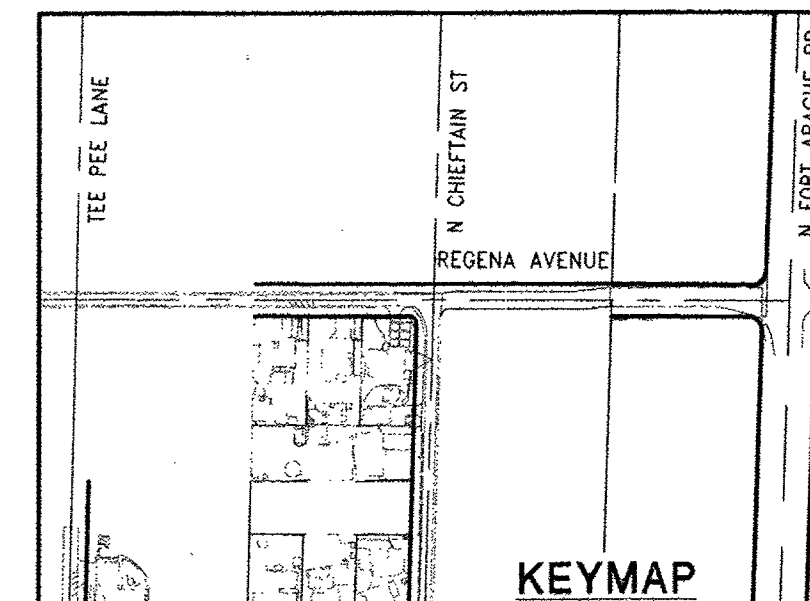

LENNAR®
2490 PASO VERDE PARKWAY SUITE 120 HENDERSON, NV 89074
PHONE: (702) 736-6100 FAX: (702) 736-9200
RCI Engineering
4325 Dean Martin Road, Suite 300, Las Vegas, NV 89103
PH: 702.453.0800 FAX: 702.453.0801

IMPROVEMENT PLANS FOR
**CENTENNIAL AND TEE PEE
REGENA AVENUE OFFSITE SEWER FACILITY
MASTER UTILITY PLAN**

CLARK COUNTY FIRE DEPARTMENT APPROVAL
BY: *[Signature]* DATE: 28 OCT 14
APPROVAL OF THESE PLANS SHALL NOT BE CONSTRUED TO BE A PERMIT FOR, OR ANY APPROVAL OF, ANY VIOLATION OF ANY OF THE PROVISIONS OF THE STATE OR COUNTY LAWS.
APPROVAL BY THE FIRE DEPARTMENT HAVING JURISDICTION IS REQUIRED PRIOR TO OBTAINING FINAL APPROVAL FROM THE LVWD.

APPROVED FOR CONSTRUCTION
[Signature]
LAS VEGAS VALLEY WATER DISTRICT ENGINEERING SERVICES MANAGER
DATE: 11/5/15 PROJECT#: 123116

MU-1
SHT 3 OF 6
HTE NUMBER
14-33533
30-10-1047

MAIN ONLY - SEWER ASBUILTS - NO LATERALS

