

DISCLAIMER NOTE:

UTILITY LOCATIONS SHOWN HEREON ARE APPROXIMATE ONLY. IT SHALL BE THE CONTRACTOR'S RESPONSIBILITY TO DETERMINE THE EXACT HORIZONTAL AND VERTICAL LOCATION OF ALL EXISTING UNDERGROUND OR OVERHEAD UTILITIES PRIOR TO COMMENCING CONSTRUCTION. NO REPRESENTATION IS MADE THAT ALL EXISTING UTILITIES ARE SHOWN HEREON. THE ENGINEER ASSUMES NO RESPONSIBILITY FOR UTILITIES NOT SHOWN OR UTILITIES NOT SHOWN IN THEIR PROPER LOCATION. CONTRACTOR TO NOTIFY ENGINEER OF ANY CHANGES OR DISCREPANCIES.

Call before you Dig
1-800-227-2600
1-702-227-2929
Nevada Power
Environment and Safety
Services Department

LEGAL DESCRIPTION

ALL OF PARCEL Q AS SHOWN ON THE FINAL MAP OF SUMMERLIN VILLAGE 238, UNIT NO. 2 ON FILE IN THE OFFICE OF THE COUNTY RECORDER OF CLARK COUNTY, NEVADA IN BOOK 143 OF PLATS AT PAGE 83, SITUATE IN SECTION 27, TOWNSHIP 20 SOUTH, RANGE 59 EAST, M.D.M., CITY OF LAS VEGAS, CLARK COUNTY, NEVADA.


BENCHMARK

CITY OF LAS VEGAS BENCHMARK STATION 5109 34NE6
RIVET AND PLATE IN TOP OF CURB AT THE NORTHEAST CORNER OF DESERT FOOTHILLS AND ALTA DRIVE.

ELEVATION = 1007.197 METERS (NAVD'83)
ELEVATION = 5304.45 US SURVEY FEET (NAVD'83)

BASIS OF BEARINGS

NORTH 89°45'49" EAST, BEING THE BEARING OF THE NORTH LINE OF SECTION 27, TOWNSHIP 20 SOUTH, RANGE 59 EAST, M.D.M., CITY OF LAS VEGAS, CLARK COUNTY, NEVADA AS SHOWN BY MAP THEREOF ON FILE IN FILE 91, PAGE 28 OF PARCEL MAPS IN THE COUNTY RECORDER'S OFFICE, CLARK COUNTY, NEVADA.

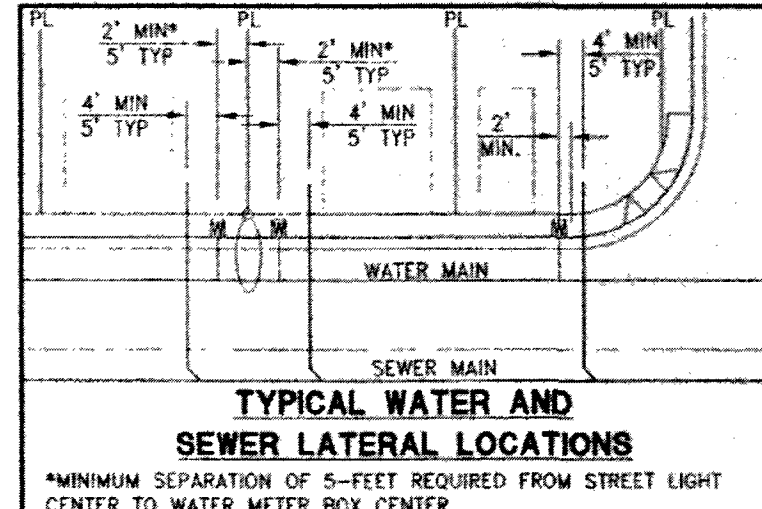

WATER MAIN JOINT DEFLECTION (PVC 4"-24")

PVC PIPE SHALL BE DEFLECTED AT THE JOINT ONLY. THE MAXIMUM ALLOWABLE DEFLECTION SHALL BE ONE (1) DEGREE PER JOINT WITH A MINIMUM RADIUS OF CURVATURE OF 1,150 FEET, PER UDACS 2.07.01 AND 2.07.02. FOR CHANGES IN DIRECTION EXCEEDING THE MAXIMUM ALLOWABLE JOINT DEFLECTION, FITTINGS SHALL BE USED.

PRV NOTE:

LOTS 33-42 AND 66-81
THIS PROPERTY MAY HAVE STATIC WATER PRESSURE IN EXCESS OF 80 PSI. THE UNIFORM PLUMBING CODE REQUIRES THAT INDIVIDUAL, ON-SITE (PRIVATE), PRESSURE REDUCING VALVES BE INSTALLED WHENEVER THE PRESSURE EXCEEDS 80 PSI. PRVs ARE THE DEVELOPER'S RESPONSIBILITY, AND WILL NOT BE INSPECTED OR INCLUDED IN THE ACCEPTANCE OF LVWD FACILITIES.

BACKWATER VALVE


ALL LOTS WITH THIS SYMBOL REQUIRE A BACKWATER VALVE

ASBUILT

WESTERN STATES CONTRACTING, INC.
4129 W. CHEYENNE AVE. SUITE D
N. LAS VEGAS, NV 89032

SEWER CONNECTION NOTE:

ONE OR MORE SEGMENTS OF THE DOWNSTREAM SEWER SYSTEM THAT WILL SERVE THIS PROJECT HAS NOT BEEN COMPLETED AND/OR ACCEPTED FOR MAINTENANCE BY THE CITY OF LAS VEGAS. ANY WORK DONE ON THIS PROJECT PRIOR TO THE COMPLETION AND/OR ACCEPTANCE OF THE DOWNSTREAM SEWER SYSTEM(S) SHALL BE DONE AT THE DEVELOPER'S OWN RISK. THE CITY OF LAS VEGAS RESERVES THE RIGHT TO PREVENT THE PHYSICAL CONNECTION OF THIS PROJECT INTO THE DOWNSTREAM SEWER SYSTEM UNTIL ALL SEGMENTS HAVE BEEN COMPLETED AND ACCEPTED FOR MAINTENANCE, OR UNTIL SUCH TIME AS THEY ARE DEEMED AVAILABLE FOR SERVICE.

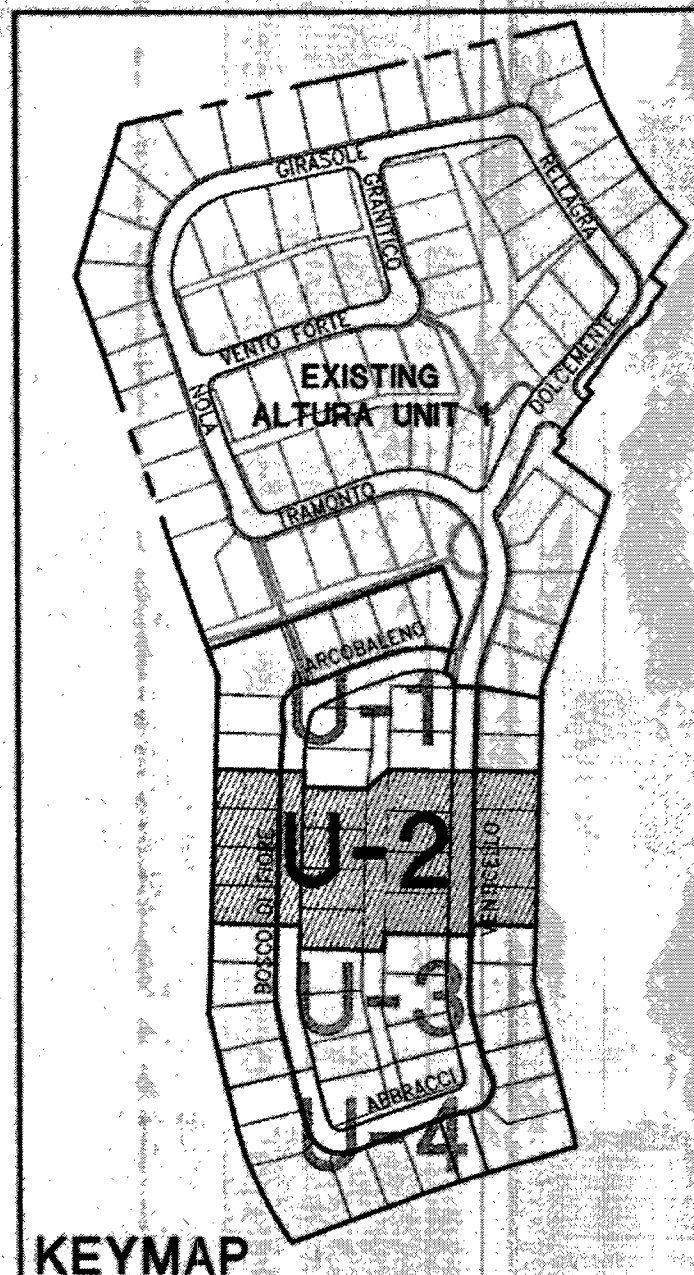

KEYMAP

30' 15' 0' 30' 60'
SCALE: 1" = 30'

WATER CONSTRUCTION NOTES

1. INSTALL FIRE HYDRANT ASSEMBLY PER UDACS PLATE NO. 40 (INCLUDES 6" GATE VALVE)
2. INSTALL 1" COPPER SERVICE LATERAL WITH 3/4" METER PER UDACS PLATE NO. 2
3. INSTALL 8" GATE VALVE PER UDACS PLATE NO. 30 & NO. 39
4. INSTALL 8" X 6" TEE PER UDACS PLATE NO. 31
5. INSTALL 8" 5' BEND PER UDACS PLATE NO. 31
6. INSTALL 8" 11.25' BEND PER UDACS PLATE NO. 31
7. INSTALL 8" 22.5' BEND PER UDACS PLATE NO. 31
8. INSTALL 8" 45' BEND PER UDACS PLATE NO. 31
9. EXISTING FIRE HYDRANT WITH 8" GATE VALVE AND EXISTING EASEMENT
10. REMOVE EX CAP AND BLOWOFF AND CONNECT TO EXISTING WATER MAIN PER UDACS PLATE NO. 36
11. INSTALL (2) 4" SCHEDULE 40 PVC IRRIGATION SLEEVES
12. EXISTING IRRIGATION SLEEVES
13. ADJUST WATER VALVE TO FINISH GRADE PER UDACS PLATE NO. 39. VALVE SHALL BE ACCESSIBLE AT ALL TIMES

BUILDING INFORMATION

TYPE OF CONSTRUCTION: Y-B
TOTAL LIVING AREA: < 4,487 S.F.
TOTAL SF UNDER ROOF: < 5,317 S.F.
NUMBER OF STORES: 2
BUILDING USE: SINGLE FAMILY RESIDENTIAL
SPRINKLERED: NO
NUMBER OF FIRE HYDRANTS: 3
FIRE FLOW: 2,000 GPM AT 20 PSI RESIDUAL

NOTES:

1. ADJUST WATER VALVE BOXES TO FINISH GRADE PER UDACS PLATE NO. 39. VALVES SHALL BE ACCESSIBLE AT ALL TIMES.
2. ALL SEWER/STORM DRAINS CROSSING WATERLINES MUST CONFORM TO SECTION 2.22 OF UNIFORM DESIGN AND CONSTRUCTION STANDARDS FOR POTABLE WATER SYSTEMS (UDACS) FOR WATER AND STORM MAIN CROSSING AND CLEARANCES.
3. ALL WATER PIPE DIMENSIONS SHOWN ARE GIVEN FROM FITTING TO FITTING AND ARE FOR REFERENCE ONLY. CONTRACTOR TO VERIFY ALL DIMENSIONS PRIOR TO CONSTRUCTION.
4. SERVICE LATERALS FOR LOTS: 31-40, 51, 72-83 WILL BE TAPPED ON EXISTING MAIN BY OWNER'S CONTRACTOR UNDER DIRECTION OF LVWD.

SEWER CONSTRUCTION NOTES


1. INSTALL 48" STANDARD MANHOLE WITH A SINGLE LID (PER 21UDCSWCS STD. NO. SD-1A, SD-4, SD-5 & SD-6)
2. (TYP) INSTALL 4" SEWER LATERAL (PER DCSWCS STD. NO. SD-17, SD-22 & SD-25)
3. REMOVE CAP AND CONNECT TO EXISTING 8" SEWER
4. TYPICAL LOCATION FOR SEWER LATERAL AT WATER MAIN CROSSING. ALL SEWER LATERALS MUST MAINTAIN 16" VERTICAL CLEARANCE BELOW WATER MAIN AT CROSSINGS.
5. EXISTING 4" LATERAL PER CLV#57695
6. INSTALL 4" C-900 SEWER LATERAL (PER DCSWCS STD. NO. SD-17, SD-22 & SD-25)

EXISTING UTILITY NOTE:

EXISTING UTILITIES AS SHOWN ARE FOR REFERENCE ONLY. CONTRACTOR TO FIELD VERIFY BOTH VERTICAL AND HORIZONTAL LOCATION OF ALL EXISTING UTILITIES PRIOR TO CONSTRUCTION. CONTRACTOR SHALL NOTIFY ENGINEER OF ANY DISCREPANCIES PRIOR TO CONSTRUCTION. ENGINEER ASSUMES NO RESPONSIBILITY FOR EXISTING UTILITIES SHOWN INCORRECTLY OR OTHERWISE NOT SHOWN.

UTILITY LATERAL NOTE:

WATER AND SEWER LATERAL STATIONS SHOWN ON THIS PLAN SET ARE CALCULATED AT THE BACK OF CURB

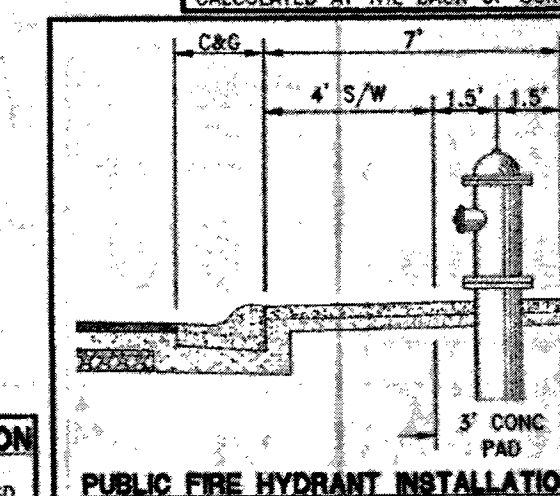

PUBLIC FIRE HYDRANT INSTALLATION WITH SIDEWALK PER UDACS PLT 40

WASTEWATER FLOW CALCULATION

UNIT 2 CALCULATIONS:
53 ERI (53 LOTS) * 250 GPD = 0.01325 MGD
= 0.01325 * 3.5 = 0.0464 MGD PEAK

CITY OF LAS VEGAS FIRE DEPARTMENT APPROVAL

APPROVAL OF THESE PLANS SHALL NOT BE CONSTRUED TO BE A PERMIT FOR, OR ANY APPROVAL OF, ANY VIOLATION OF ANY OF THE PROVISIONS OF THE STATE OR COUNTY LAWS.

APPROVAL BY THE FIRE DEPARTMENT HAVING JURISDICTION IS REQUIRED PRIOR TO OBTAINING FINAL APPROVAL FROM THE LVWD.

FIRE FLOW 2,000 GPM AT 20 PSI RESIDUAL

APPROVED FOR CONSTRUCTION

DATE: 10/6/15 PROJECT: 123882

LVWD APPROVED FIRE FLOW 2,000 GPM AT 20 PSI RESIDUAL

JOHN I. LAND
CIVIL
Exp. 12/31/2015
No. 16441

10/5/2015

U-2

SHT 11 OF 22

CLV DRAWING NUMBER

CLV PROJECT # 60827

NEVADA

ALTA UNIT 2 AT SUMMERLIN AT VILLAGE 238

A SINGLE FAMILY RESIDENTIAL SUBDIVISION

UTILITY PLAN (SHEET 2 OF 4)

CITY OF LAS VEGAS

10/26/15 7:00pm

10/26/15

10/26/15

