
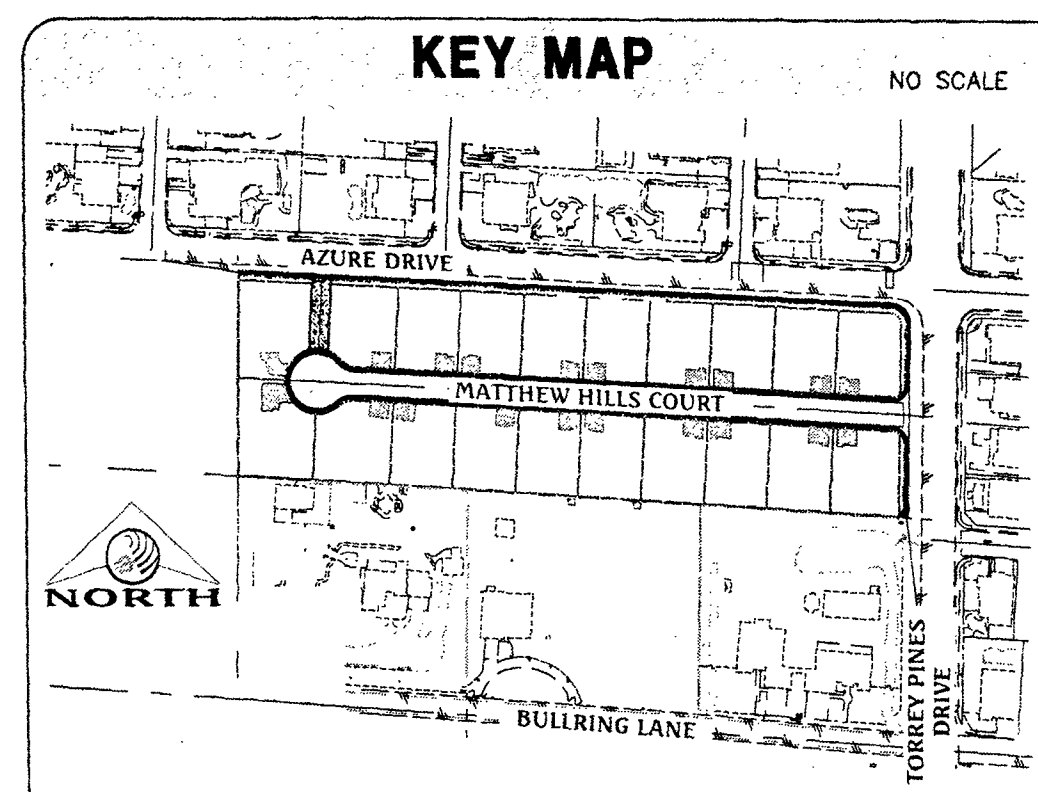


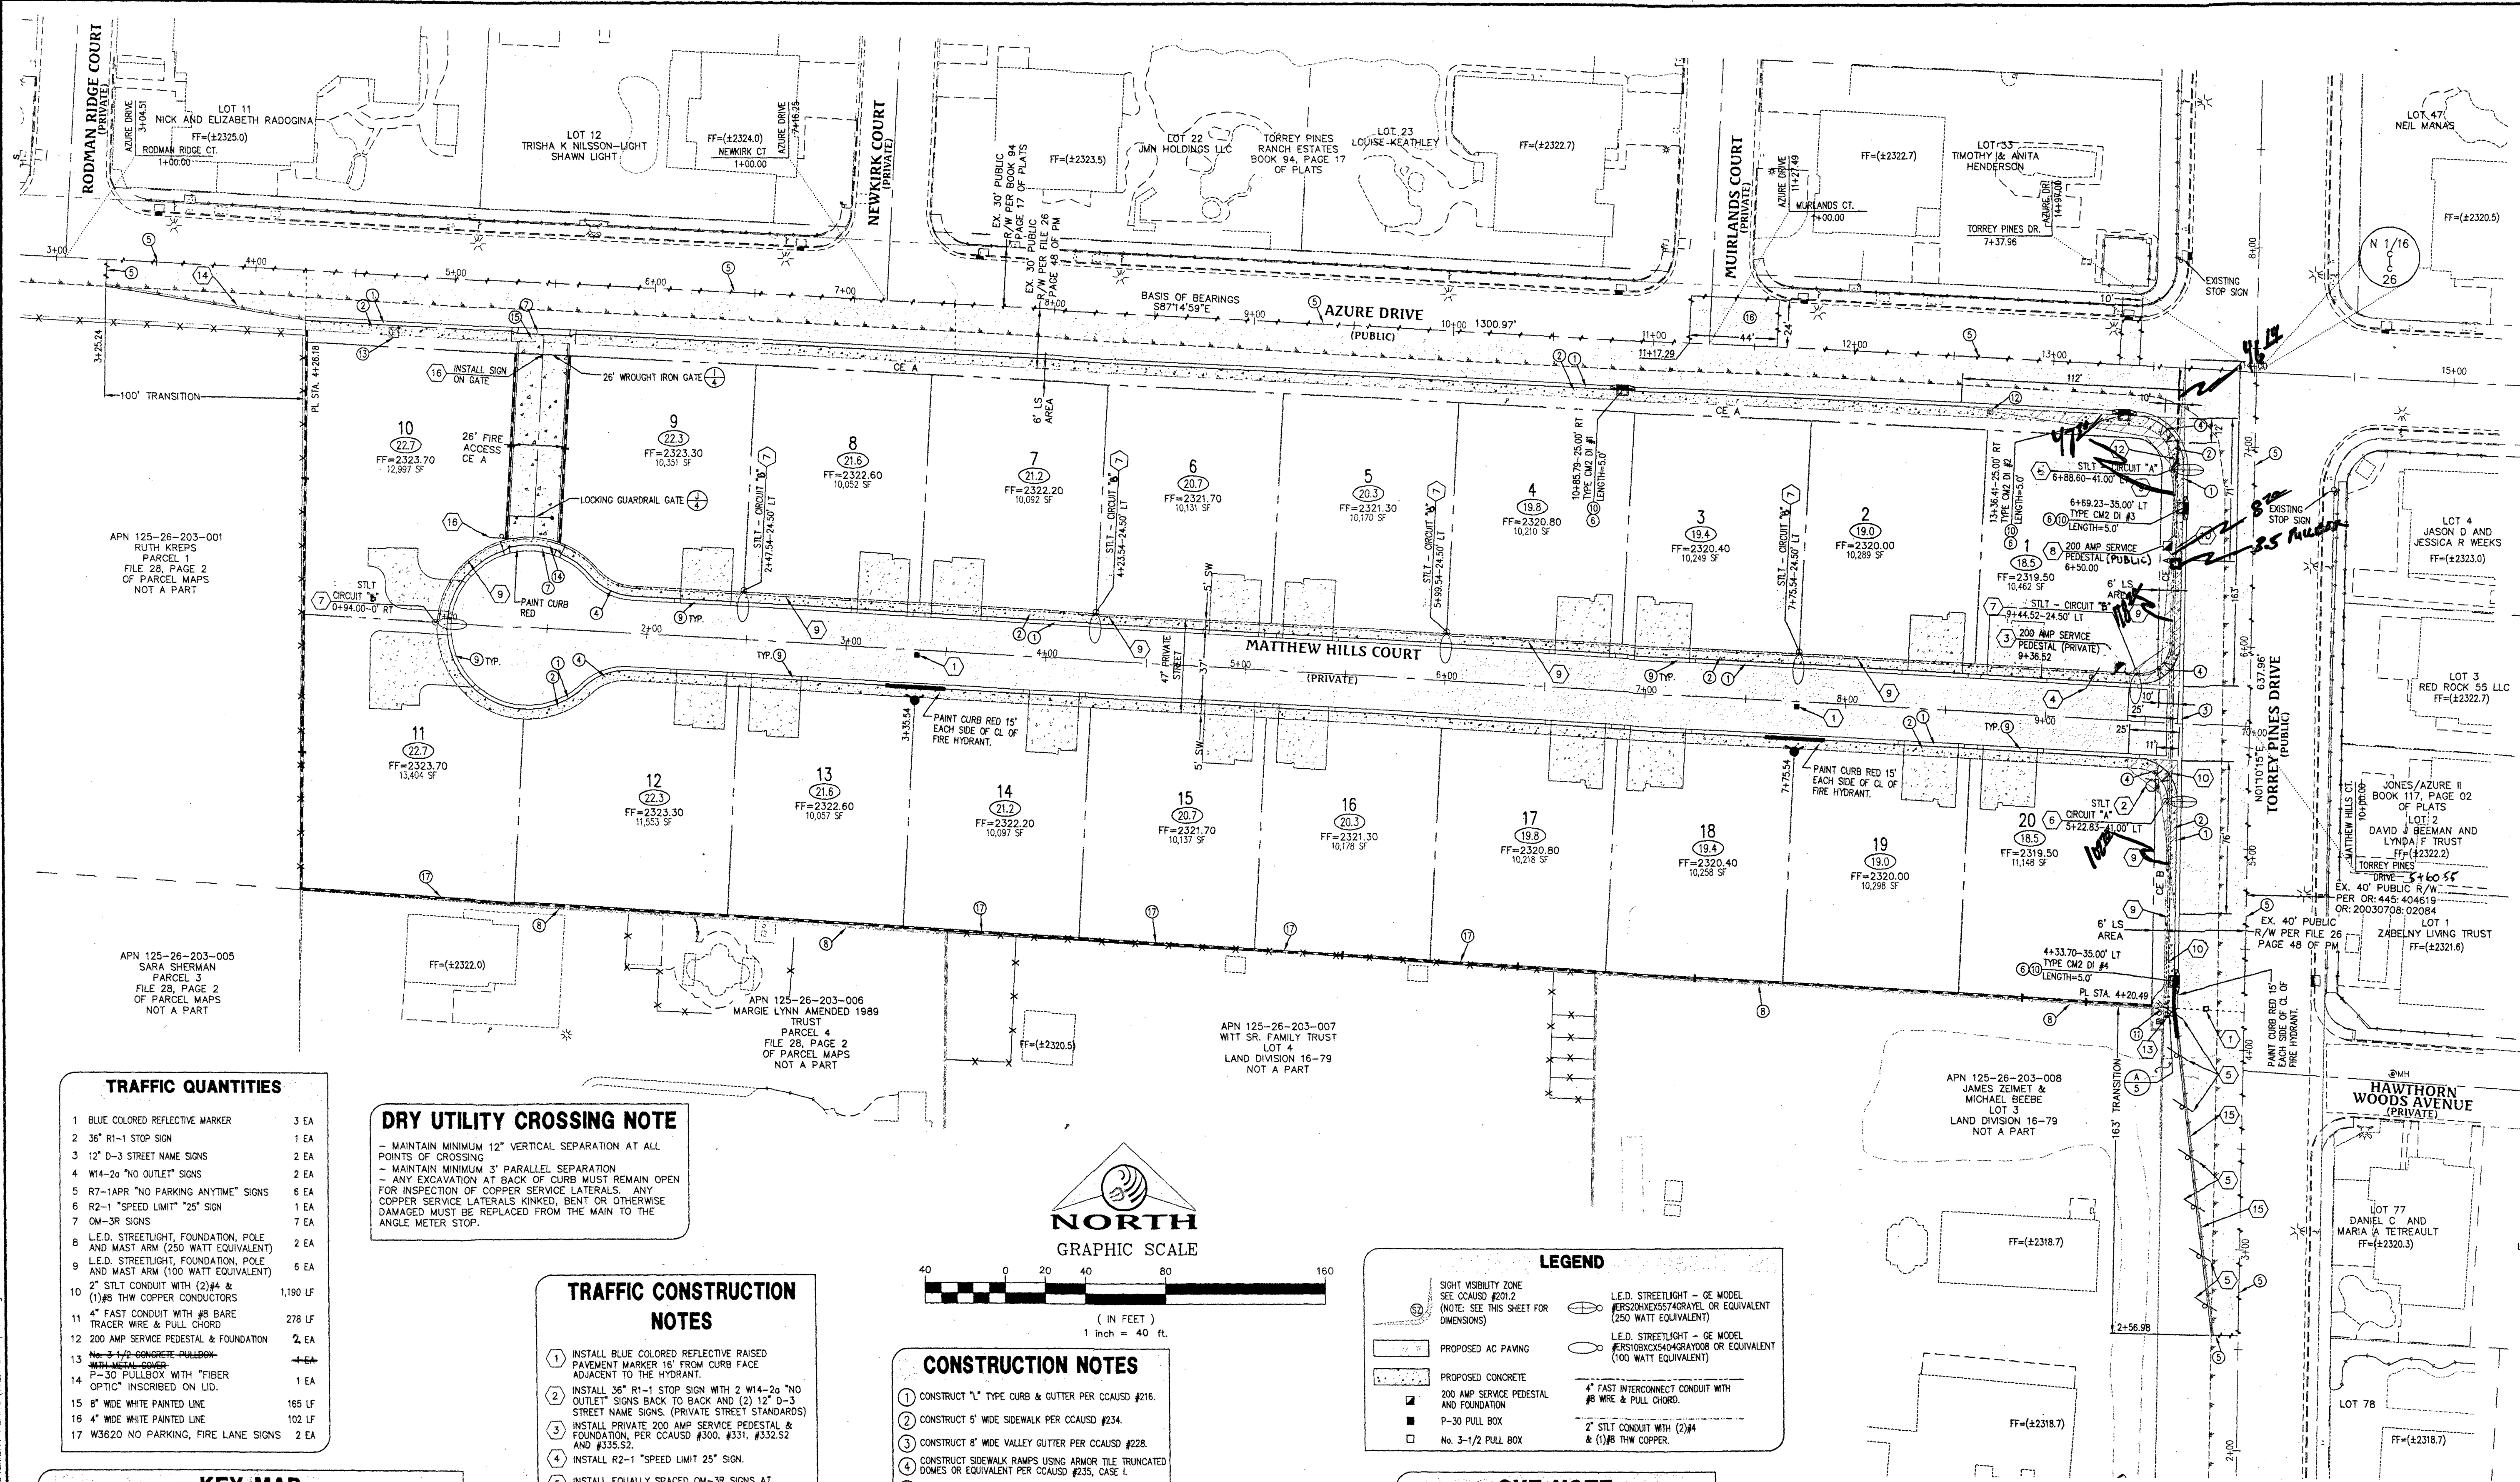

APN 125-26-203-001
RUTH KREPS
PARCEL 1
FILE 28, PAGE 2
OF PARCEL MAPS
NOT A PART

APN 125-26-203-005
SARA SHERMAN
PARCEL 3
FILE 28, PAGE 2
OF PARCEL MAPS
NOT A PART

APN 125-26-203-006
MARGIE LYNN AMENED 1989
TRUST
PARCEL 4
FILE 28, PAGE 2
OF PARCEL MAPS
NOT A PART

APN 125-26-203-007
WITT SR. FAMILY TRUST
LOT 4
LAND DIVISION 16-79
NOT A PART

APN 125-26-203-008
JAMES ZEIMET &
MICHAEL BEEBE
LOT 3
LAND DIVISION 16-79
NOT A PART

LOT 11
NICK AND ELIZABETH RADOGINA
FF=(+2325.0)
1400.00'

LOT 12
TRISHA K NILSSON-LIGHT
SHAWN LIGHT
FF=(+2324.0)
1400.00'

LOT 22
JUN HOLDINGS LLC
FF=(+2323.5)

LOT 23
TORREY PINES RANCH ESTATES
BOOK 94, PAGE 17
OF PLATS
FF=(+2322.7)

LOT 33
TIMOTHY & ANITA
HENDERSON
FF=(+2322.7)

LOT 47
NEIL MANAS
FF=(+2320.5)

LOT 4
JASON D AND
JESSICA R WEEKS
FF=(+2323.0)

LOT 3
RED ROCK 55
FF=(+2322.7)

LOT 2
DAVID J BEEMAN AND
LYNDIA F TRUST
FF=(+2322.2)

LOT 1
ZABELNY LIVING TRUST
FF=(+2321.6)

LOT 77
DANIEL C AND
MARIA A TREHAULT
FF=(+2320.3)

LOT 78
FF=(+2318.7)

TRAFFIC PLAN I

STREET LIGHT

DR HORTON
AZURE / TORREY PINES NORTH

APPROVED FOR CONSTRUCTION

LAS VEGAS VALLEY WATER DISTRICT ENGINEERING SERVICES MANAGER

DATE: PROJECT No.: 124685

APPROVALS

LAS VEGAS FIRE AND RESCUE

FAST

Call before you Dig

Underground

1-702-432-5300

Call before you Overhead

1-702-227-2929

811

Call before you Dig

Underground

1-800-227-2600

ASBUILT

Project: 124685 Agmt#: 115991

OS: 125-26-NW XC-11221

Professional Engineer - State of Nevada

JAMES M. PEARCE

Exp. 12-31-17

CIVIL

No. 9552

Professional Engineer - State of Nevada

JAMES M. PEARCE

Exp. 12-31-17

CIVIL

No. 9552

