

DEPARTMENT OF PUBLIC WORKS

Mayor:

Jan Laverty Jones

Councilmen:

Arnie Adamsen
Mathew Q. Callister
Michael J. McDonald
Gary Reese

City Manager:

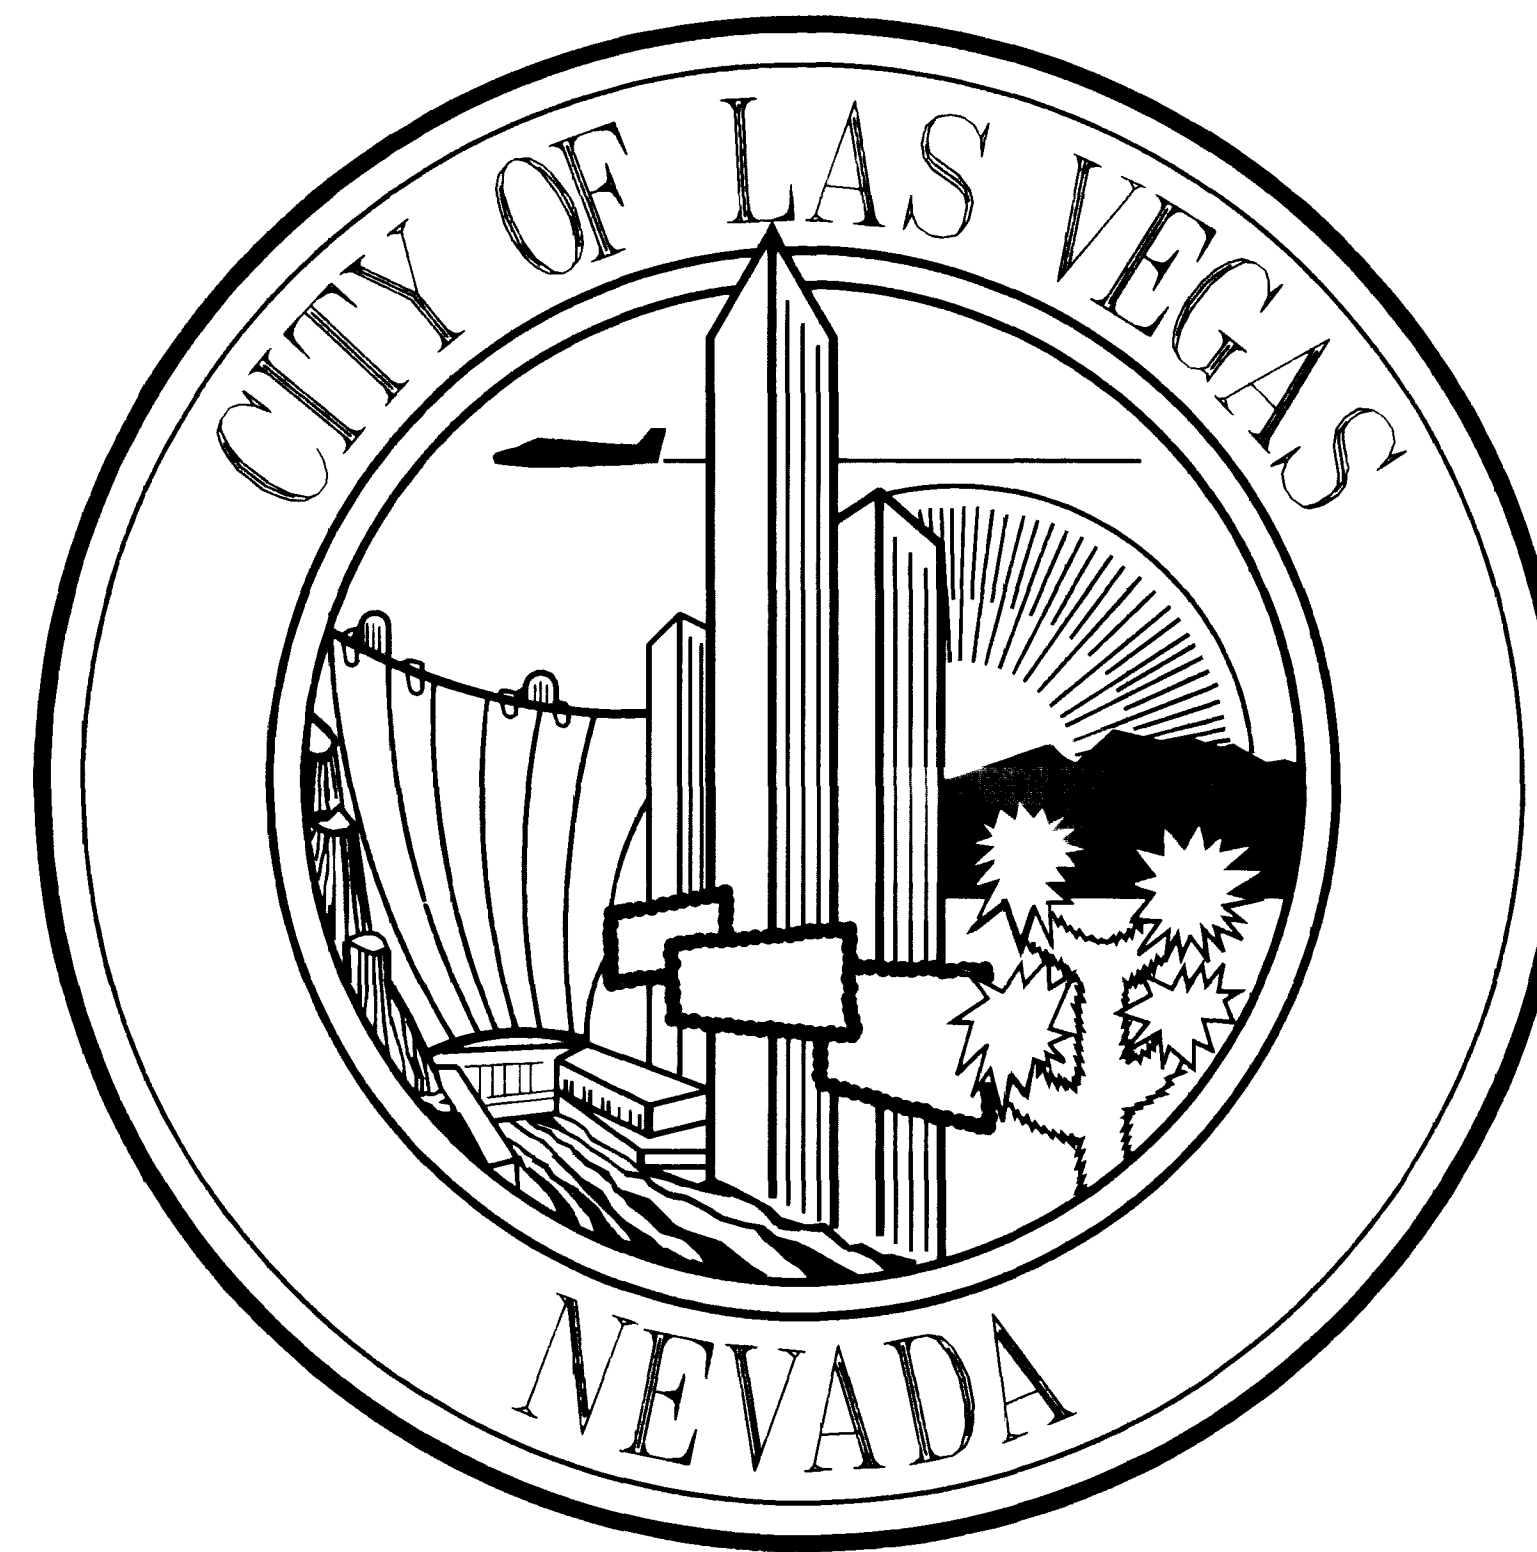
Larry Barton

Director of Public Works:

Richard D. Goecke

City Engineer:

Dennis Anderson, P.E.







WASHINGTON AVENUE CONVEYANCE SYSTEM AND ROADWAY IMPROVEMENTS

EASTERN AVENUE TO SAGMAN STREET


FUNDING PROVIDED BY CLARK COUNTY REGIONAL FLOOD CONTROL DISTRICT
and REGIONAL TRANSPORTATION COMMISSION

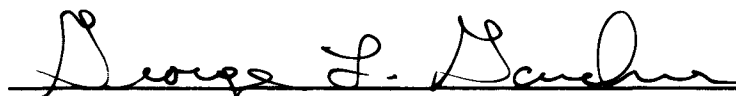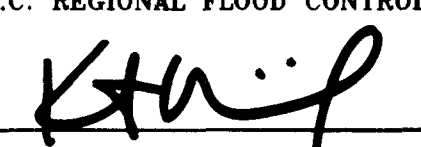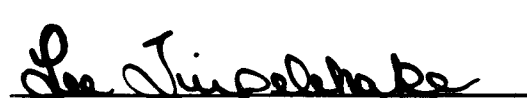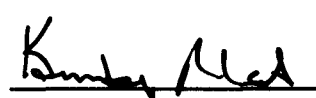APPROVALS

 CITY ENGINEER	7-3-96 DATE
 CLV MANAGER CONSTRUCTION SERVICES	4-16-96 DATE
 CLV ADA ADMINISTRATOR	4/17/96 DATE
 CLV TRAFFIC ENGINEER	4/17/96 DATE
 C.C. REGIONAL FLOOD CONTROL DISTRICT	4/2/96 DATE
 REGIONAL TRANSPORTATION COMMISSION	4/8/96 DATE
 NEVADA POWER COMPANY	3/29/96 DATE
 SOUTHWEST GAS COMPANY	3-28-96 DATE
 SPRINT/CENTRAL TELEPHONE-NEVADA	3-28-96 DATE
 PRIME CABLE COMPANY	3-28-96 DATE
 LAS VEGAS VALLEY WATER DISTRICT	4/08/96 DATE

RECORD DRAWING
These Record Drawings have been prepared based on information provided by others. The Engineer has not verified the accuracy of such information and shall not be responsible for any errors or omissions which may be incorporated herein as a result.

REVISIONS		No.	Date

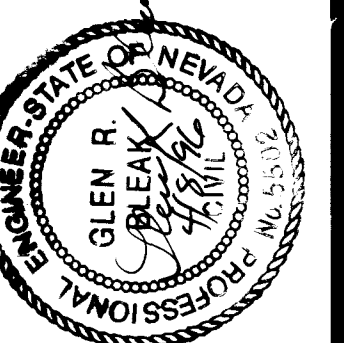

DESIGNED: GRB/JLM
DRAWN: JLM
CHECKED: JLM/RB
JOB NO. 388-4-94
SCALE: ---
HORIZ. ---
VERT. ---

Carter Burgess
Consultants in Engineering, Architecture,
Planning and the Environment
2955 East Sunset Road, Suite 105
Las Vegas, NV 89119
(702) 798-1007 Fax: (702) 798-7056

PROPERTY: CITY OF LAS VEGAS
DESCRIPTION: WASHINGTON AVENUE CONVEYANCE SYSTEM
COVER SHEET
BID No. 96.1730.25

SHEET
1
OF 25

DEPARTMENT OF PUBLIC WORKS

Mayor:

Jan Laverty Jones

Councilmen:

Arnie Adamson
 Mathew Q. Callister
 Michael J. McDonald
 Gary Reese

City Manager:

Larry Barton

Director of Public Works:

Richard D. Goecke

City Engineer:

Dennis Anderson, P.E.



APPROVALS

<i>[Signature]</i>	2/2/86
<i>[Signature]</i>	2/2/86
WASHINGTON AVENUE CONVEYANCE SYSTEM AND ROADWAY IMPROVEMENTS

EASTERN AVENUE TO SAGMAN STREET

FUNDING PROVIDED BY CLARK COUNTY REGIONAL FLOOD CONTROL DISTRICT
 and REGIONAL TRANSPORTATION COMMISSION



CLARK COUNTY

RECORDING

BOOK

PAGE

DATE

TIME

BY

REMARKS

FILE NO.

CLERK

DEPUTY CLERK

RECORDING

BOOK

PAGE

DATE

TIME

BY

REMARKS

FILE NO.

CLERK

DEPUTY CLERK

RECORDING

BOOK

PAGE

DATE

TIME

BY

REMARKS

FILE NO.

CLERK

DEPUTY CLERK

RECORDING

BOOK

PAGE

DATE

TIME

BY

REMARKS

FILE NO.

CLERK