
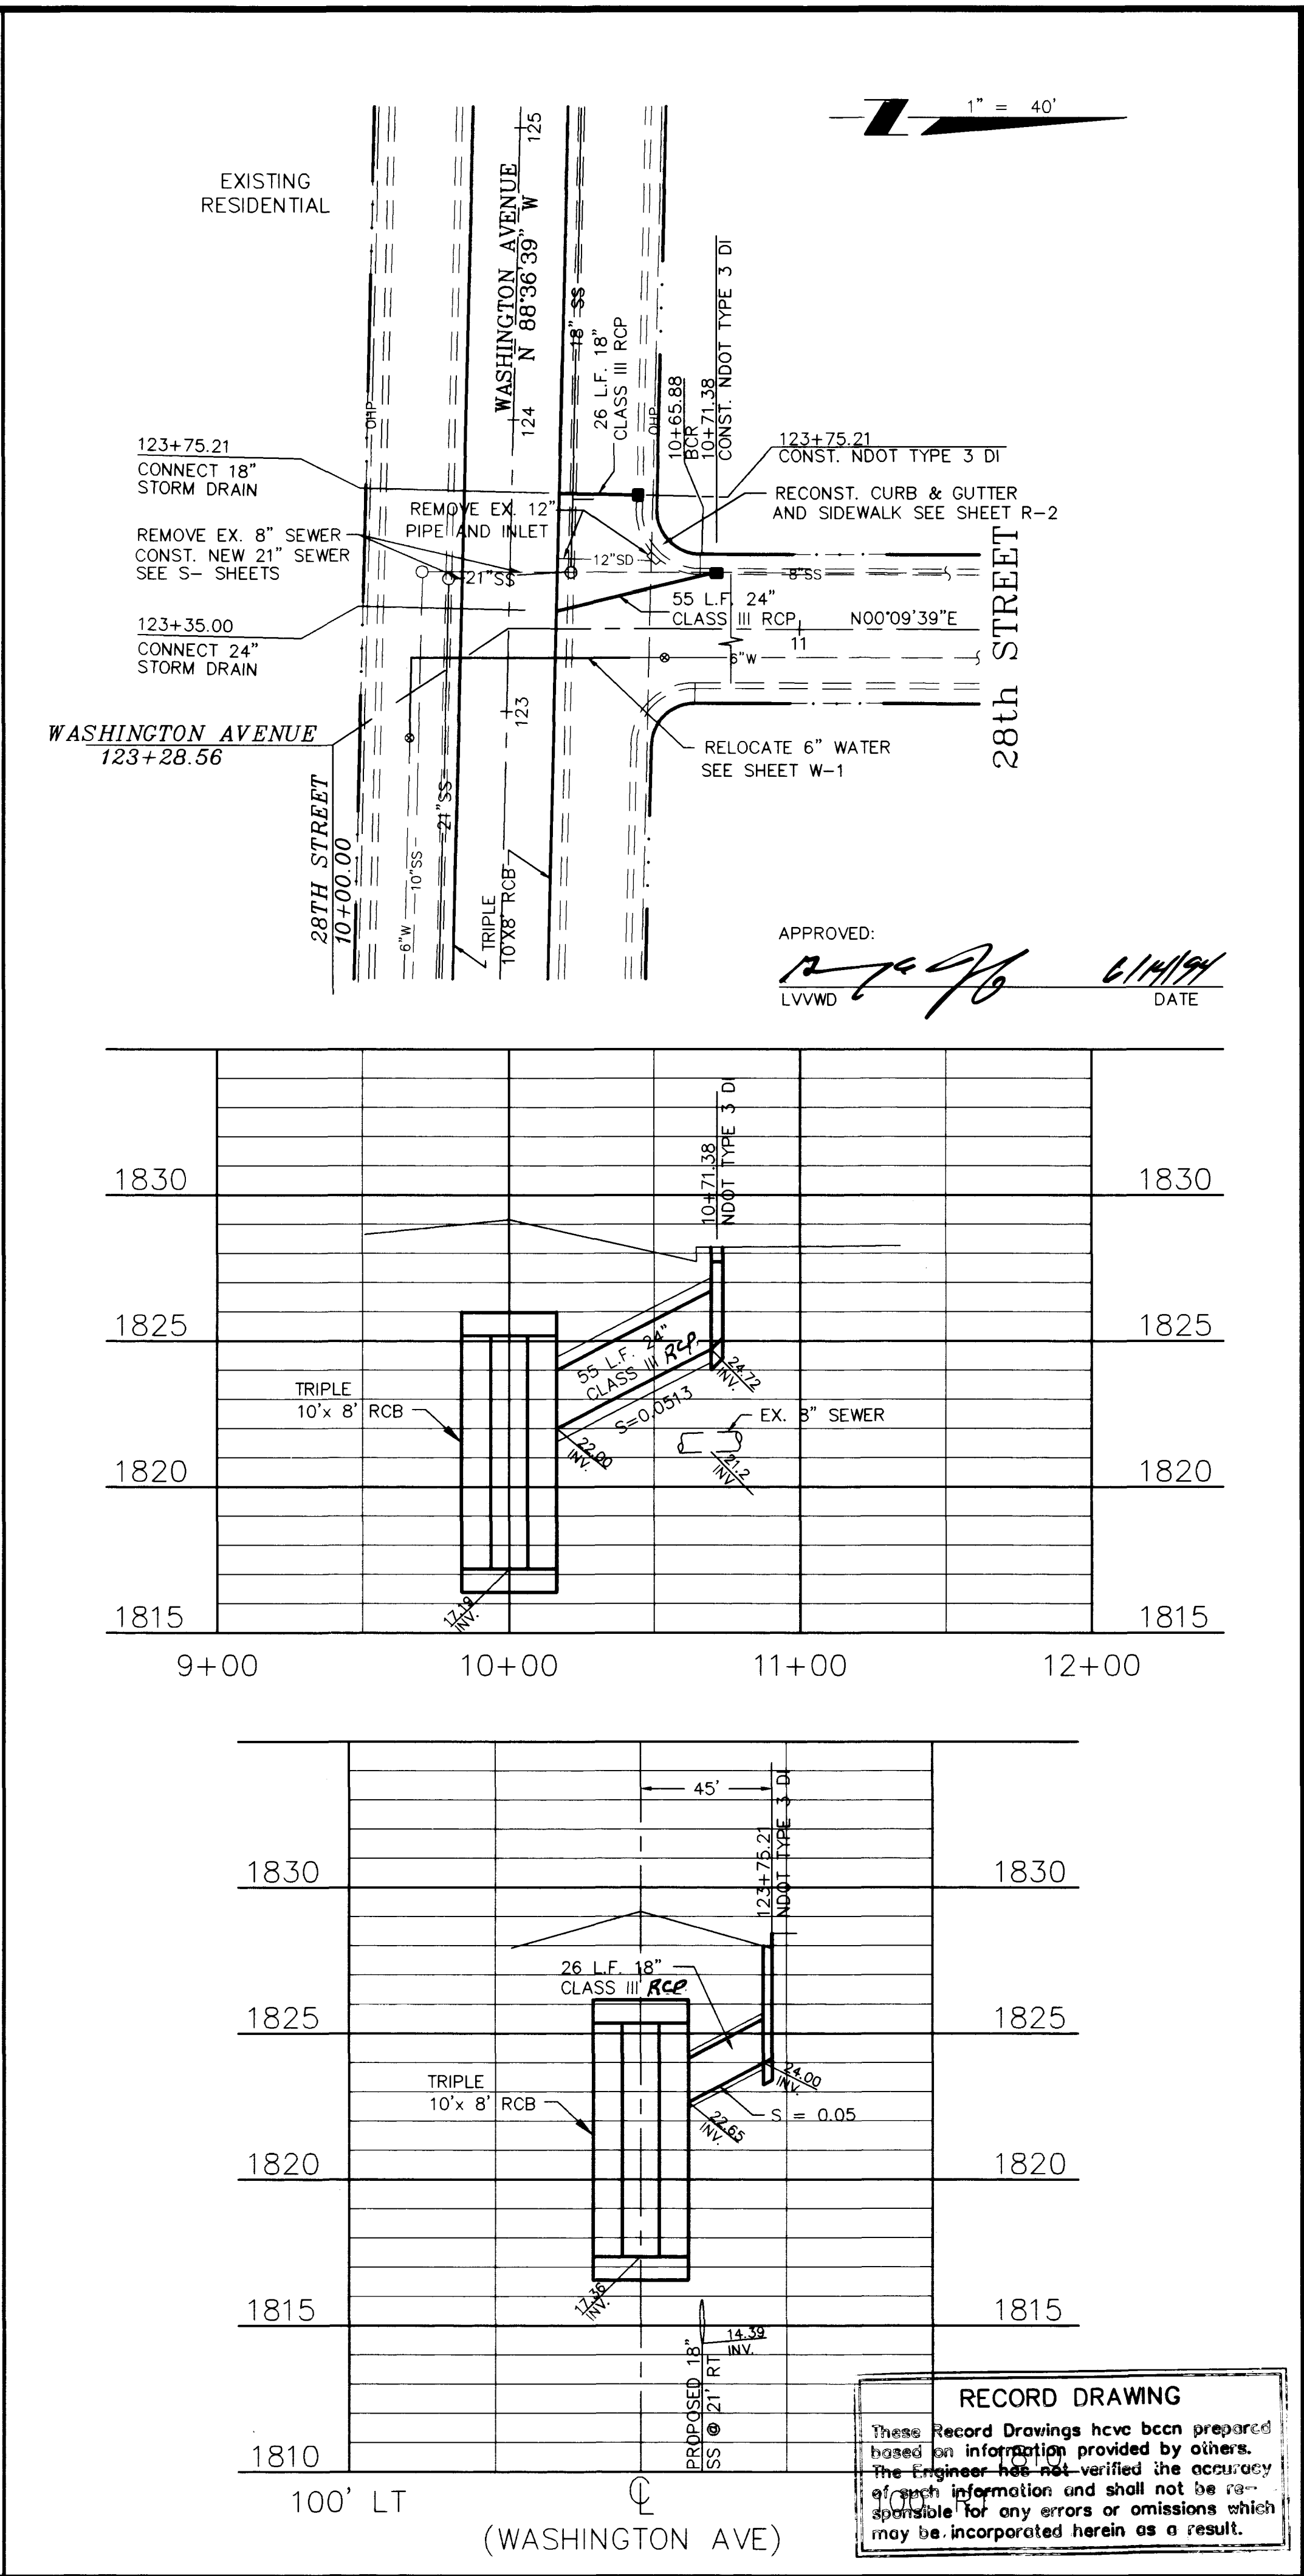
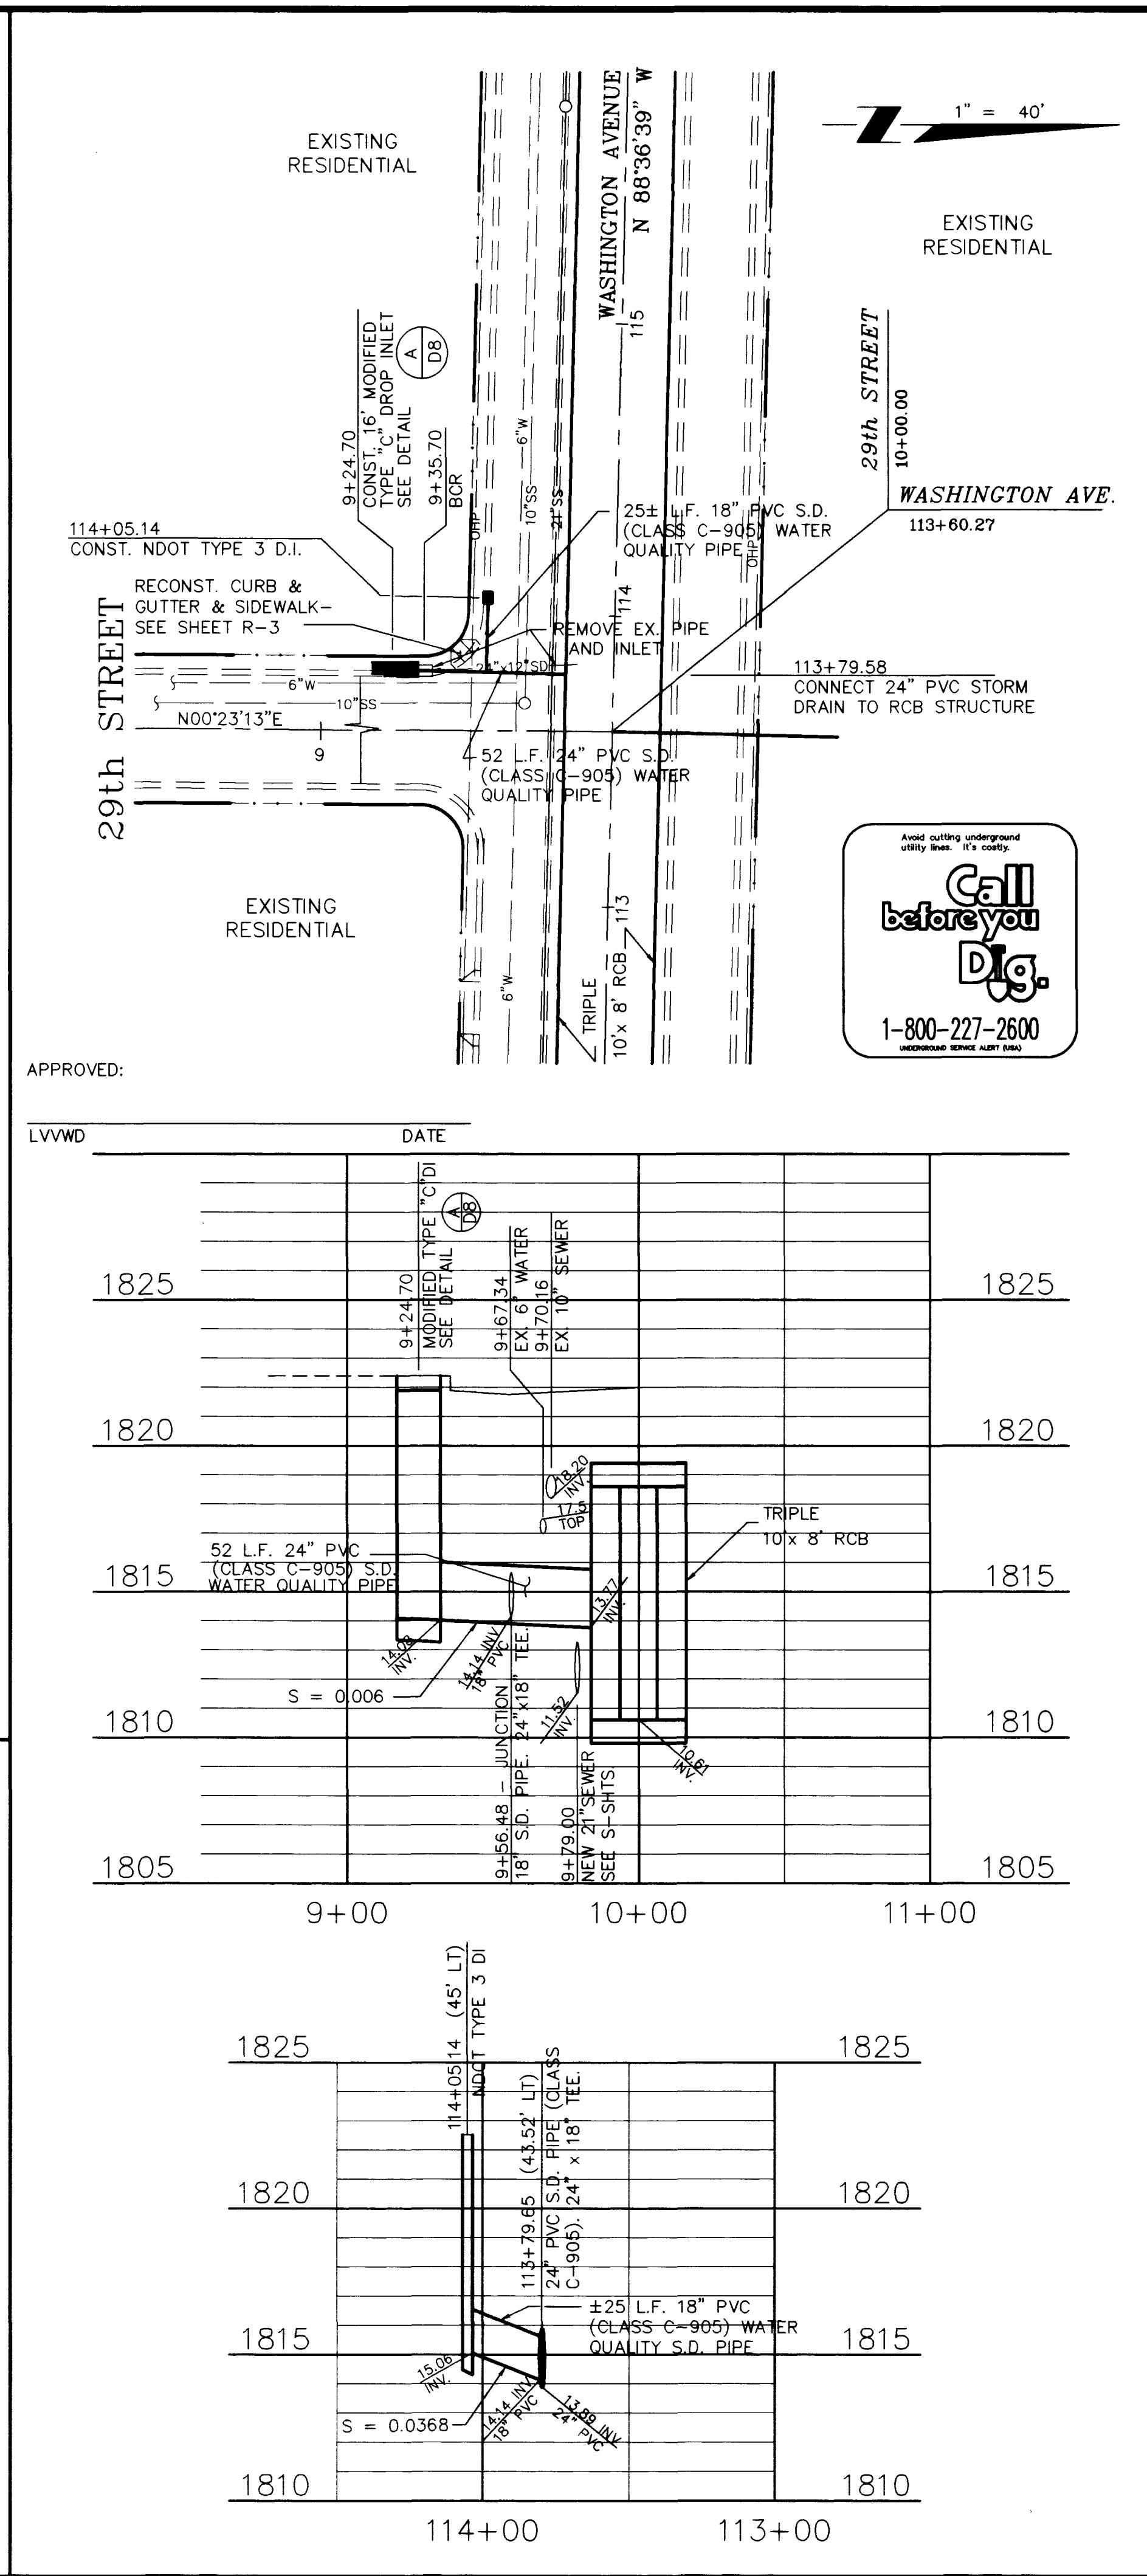


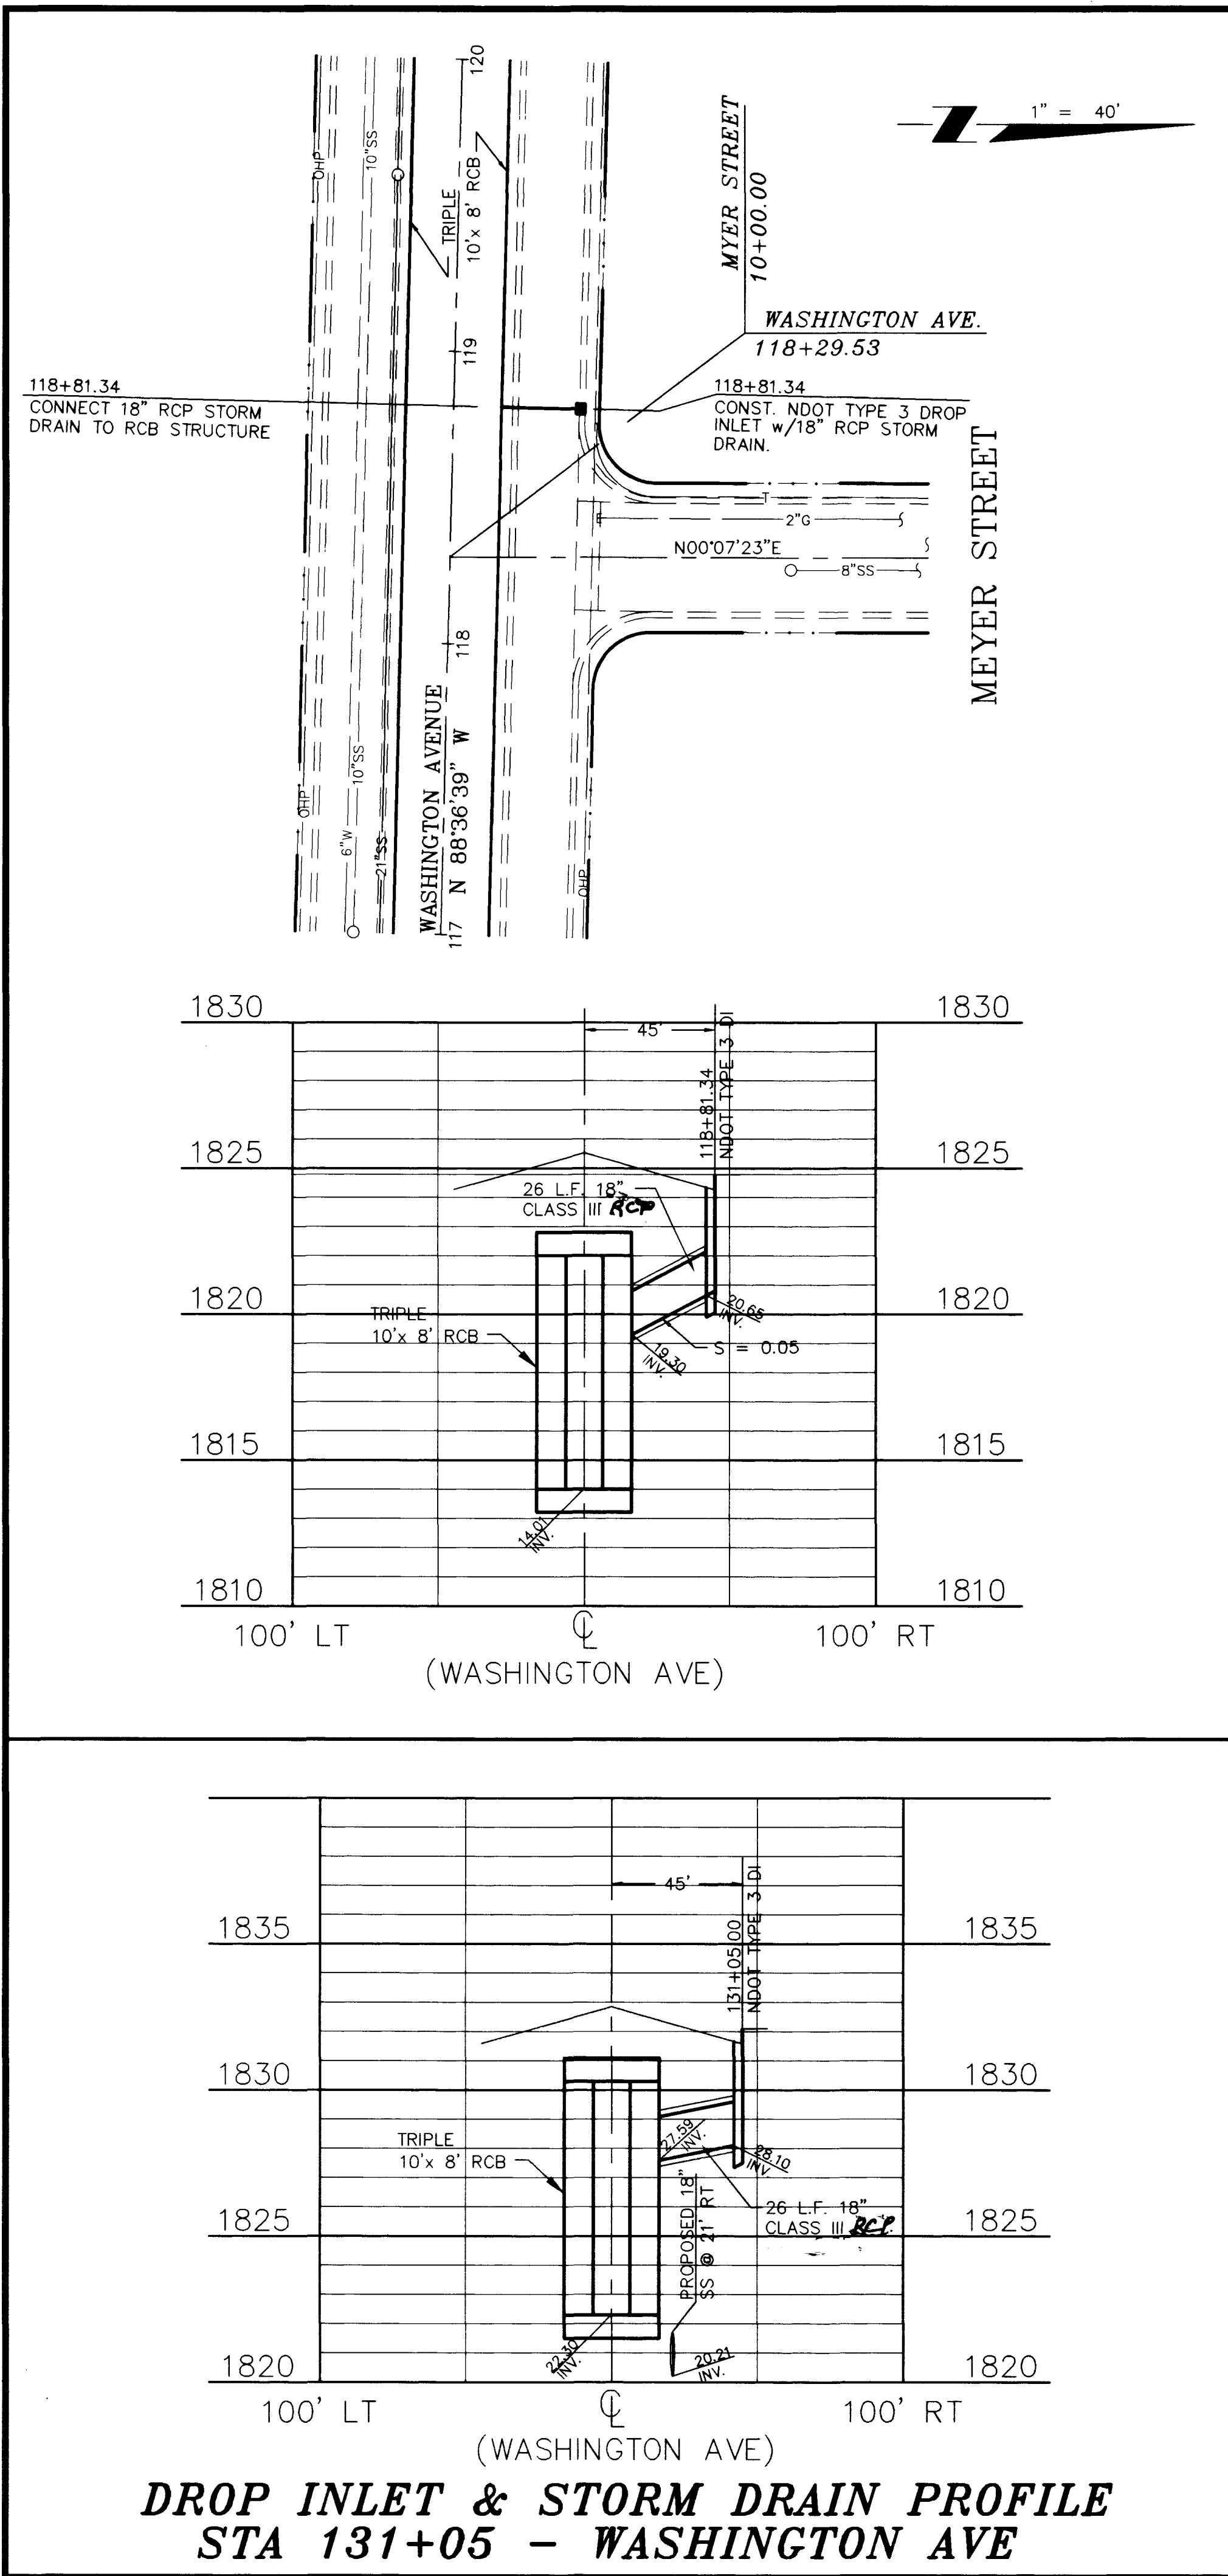

REVISIONS	
No.	Date

DESIGNED: RB/BB
DRAWN: CK/BB
CHECKED: RB
JOB NO. 382-3-91
SCALE: 1" = 40'
HORIZ. 1" = 40'
VERT. 1" = 40'




1055 EAST TROPICANA
SUITE 800
LAS VEGAS, NEVADA 89119
(702)798-1007

NEA
CONSULTING ENGINEERS






CITY OF LAS VEGAS
WASHINGTON AVENUE CONVEYANCE SYSTEM
29th, 28th, AND MEYER STREETS
STORM DRAIN PROFILES

RECORD DRAWING
These Record Drawings have been prepared based on information provided by others. The Engineer has not verified the accuracy of such information and shall not be responsible for any errors or omissions which may be incorporated herein as a result.

SHEET
D-7
10 OF 39

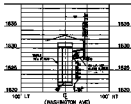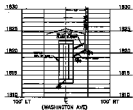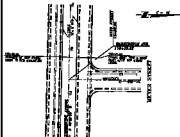

**DROP INLET & STORM DRAIN PROFILE
STA 131+05 - WASHINGTON AVE**

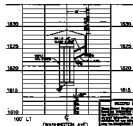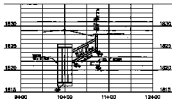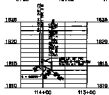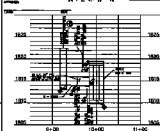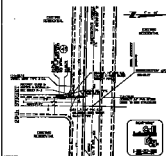

RECORD DRAWING
THIS DRAWING IS TO BE USED FOR RECORD PURPOSES ONLY. IT IS NOT TO BE USED FOR CONSTRUCTION PURPOSES. IT IS THE RESPONSIBILITY OF THE USER TO VERIFY THE ACCURACY OF THE DATA AND THE SUFFICIENCY OF THE DESIGN.

**CITY OF LAS VEGAS
WASHINGTON AVENUE OVERPASS SYSTEM
STRAIGHT
2ND, 3RD, AND 4TH STREETS
STORM DRAIN PROFILES**

D-7