
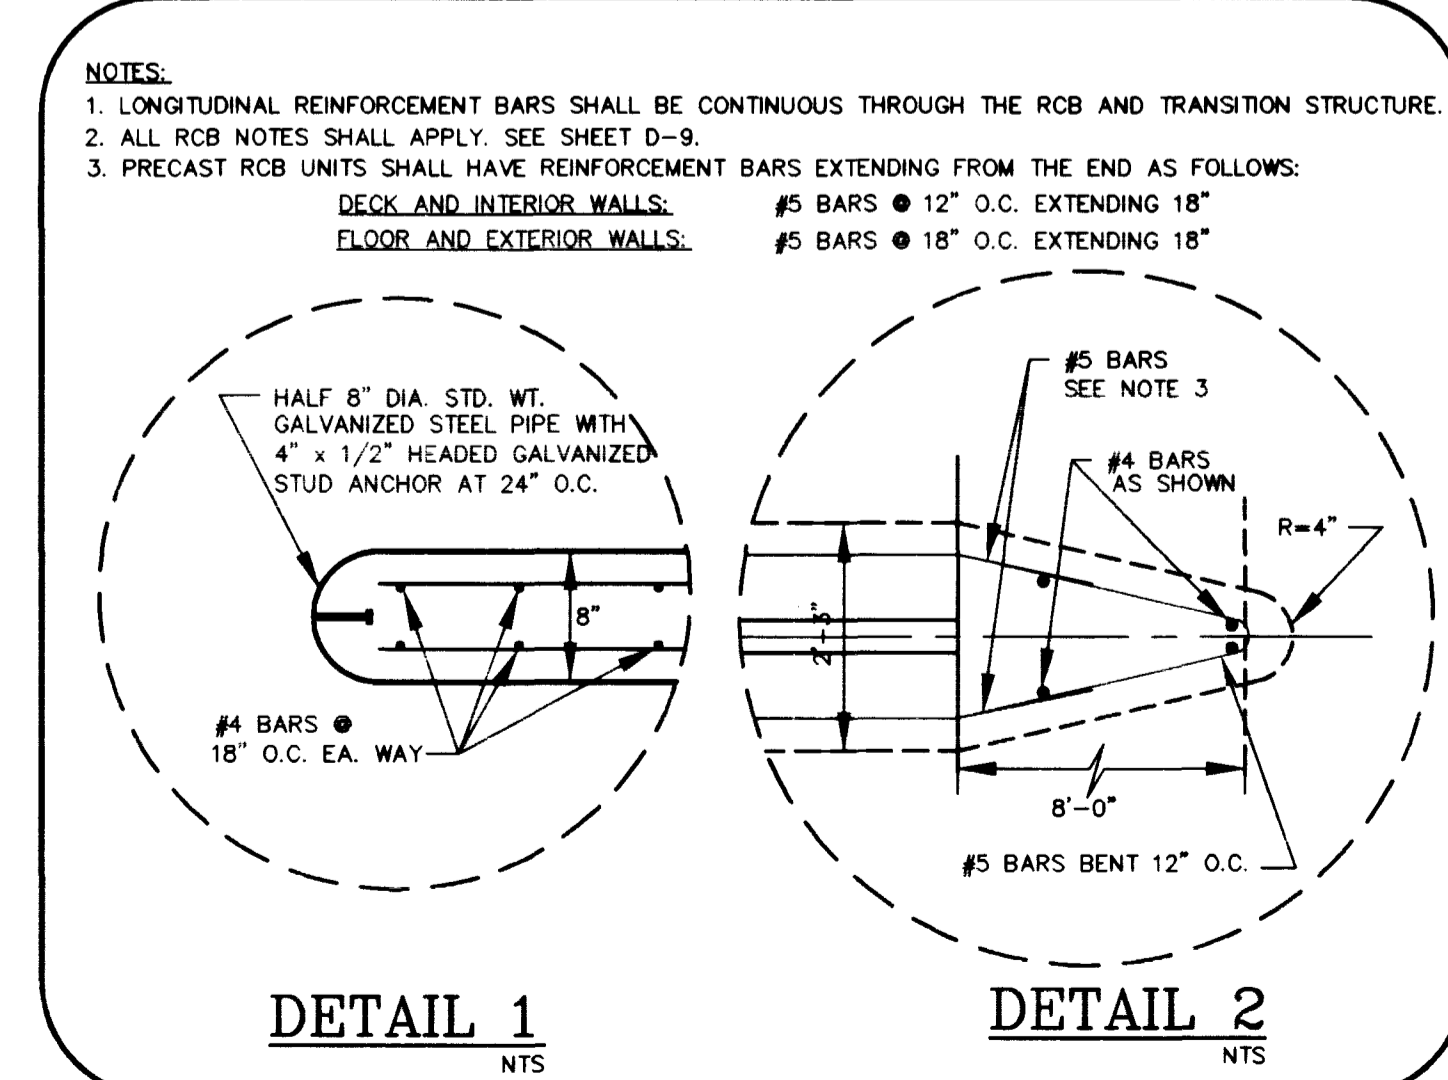
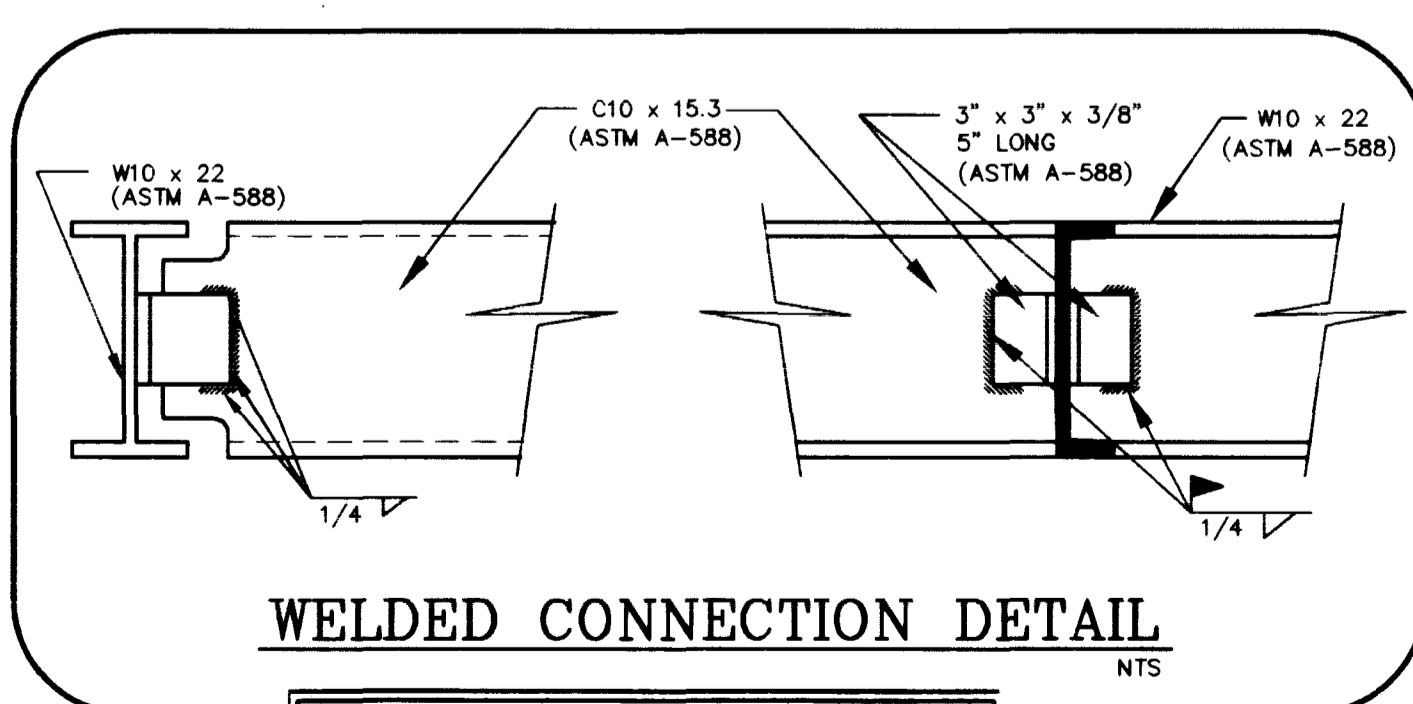


Avoid cutting underground utility lines. It's costly.

Call before you Dig.

1-800-227-2600

UNDERGROUND SERVICE ALERT (USA)

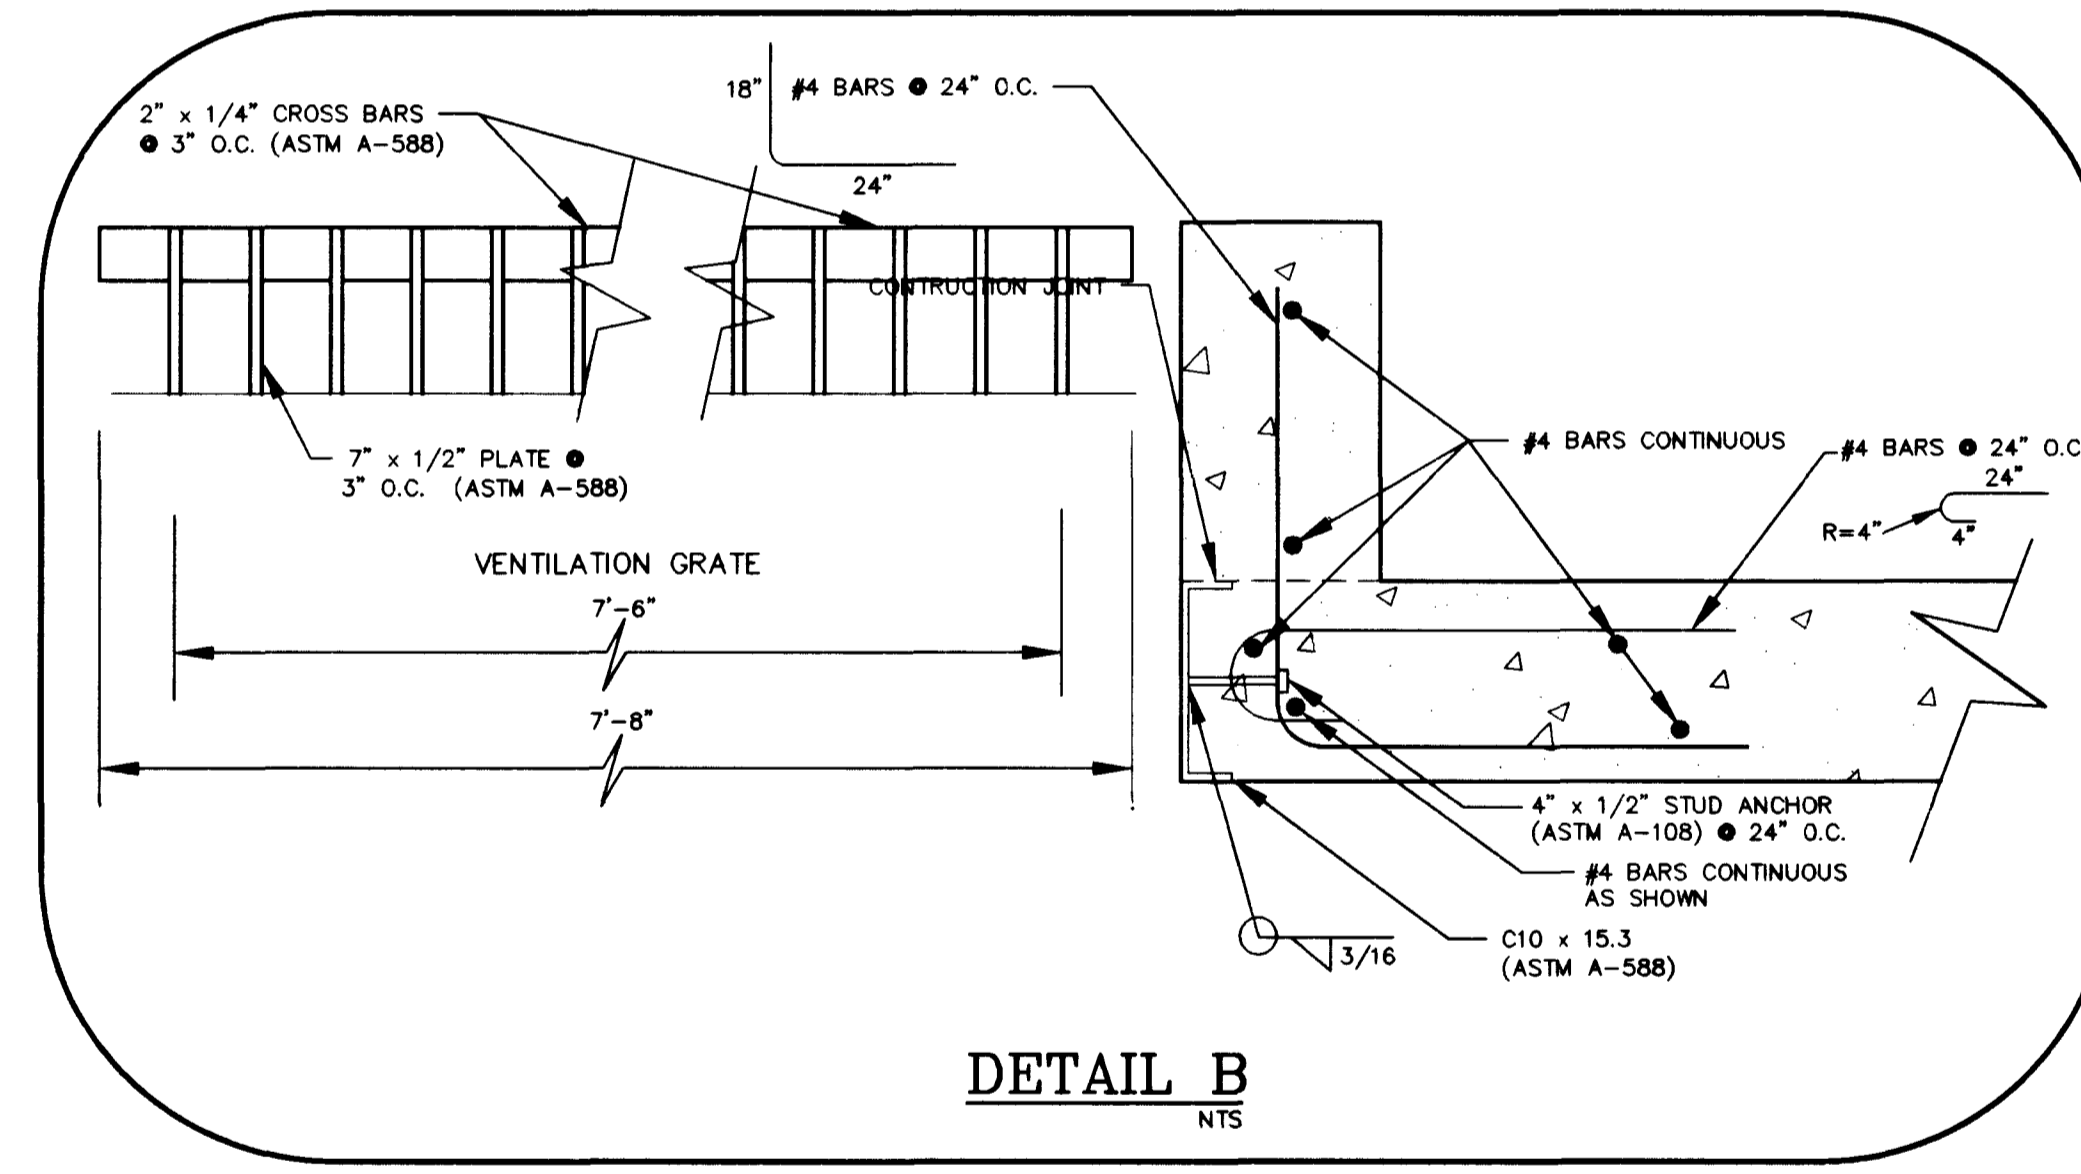

RECORD DRAWING

These Record Drawings have been prepared based on information provided by others. The Engineer has not verified the accuracy of such information and shall not be responsible for any errors or omissions which may be incorporated herein as a result.

REVISIONS

No.	Date	BY	CHKD	APPD
1				
2				
3				





DESIGNED: LEE
 DRAWN: JRH
 CHECKED: RB
 JOB NO. 388-9-81
 SCALE: AS SHOWN
 HORIZ. VERT. NOTED

1055 EAST TROPICANA
 SUITE 800
 LAS VEGAS, NEVADA 89119
 (702) 798-1007


PROJECT: CITY OF LAS VEGAS
 WASHINGTON AVENUE CONVEYANCE SYSTEM

DESCRIPTION: RCB DETAILS
 VENTILATION/ACCESS GRATES

SHEET: D-11
 14 OF 39

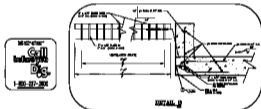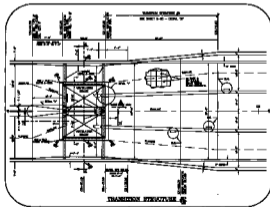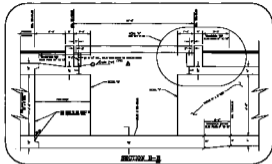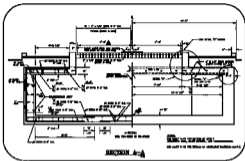

WELDED CONNECTION
 THIS CONNECTION IS TO BE WELDED TO THE STEEL BEAM AND COLUMN. THE WELDS ARE TO BE FULL PENETRATION BUTT JOINTS. THE WELDS ARE TO BE WELDED BY A WELDER QUALIFIED TO WELD TO THE STEEL BEAM AND COLUMN. THE WELDS ARE TO BE WELDED TO THE STEEL BEAM AND COLUMN. THE WELDS ARE TO BE WELDED BY A WELDER QUALIFIED TO WELD TO THE STEEL BEAM AND COLUMN.

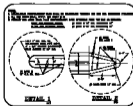

REVISIONS	DATE	BY	CHKD

CITY OF LAS VEGAS
 BUILDING DEPARTMENT
 PERMITS DIVISION
 1-800-735-3000

D-11