




MATCH LINE - STA. 129+00
SEE SHEET S-1

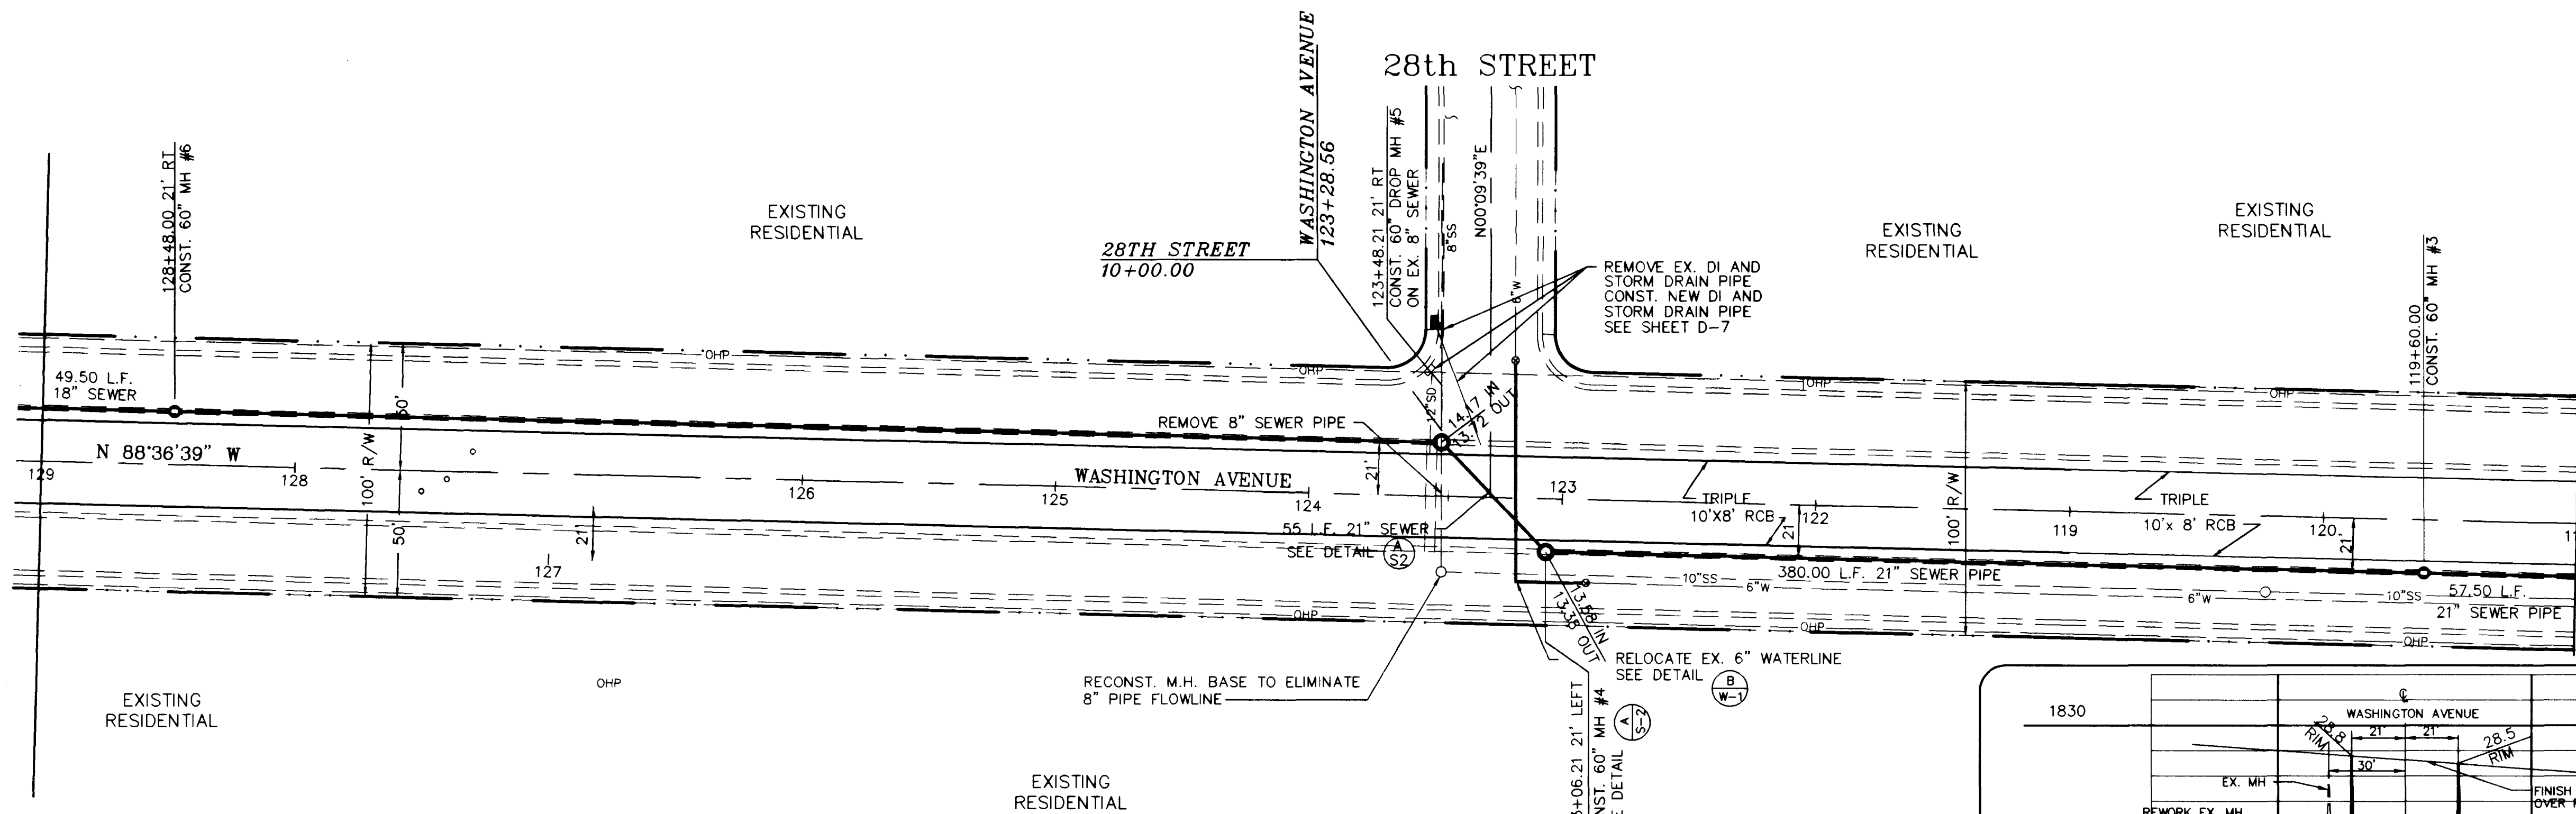

MATCH LINE - STA. 119+00
SEE SHEET S-3

SANITARY SEWER NOTES:

- 1.) SEWER IS TO BE CONSTRUCTED IN THE SAME EXCAVATION AS DRAINAGE STRUCTURE. SEE DETAIL (S-1)
- 2.) ALL SANITARY SEWER PIPE AND FITTINGS SHALL BE ULTRA-RIB PVC GRAVITY SEWER PIPE IN ACCORDANCE WITH ASTM F794 OR APPROVED EQUAL.
- 3.) ALL SANITARY SEWER IMPROVEMENTS SHALL BE CONSTRUCTED IN ACCORDANCE WITH THE "SOUTHERN NEVADA DESIGN AND CONSTRUCTION STANDARDS FOR WASTEWATER COLLECTION SYSTEMS", 1991, UNLESS OTHERWISE NOTED.
- 4.) FOR CONSTRUCTION STAGING AND TRAFFIC CONTROL PLAN THROUGH THE 28th STREET/ WASHINGTON AVENUE INTERSECTION, SEE SHEET R-11 & R-12.

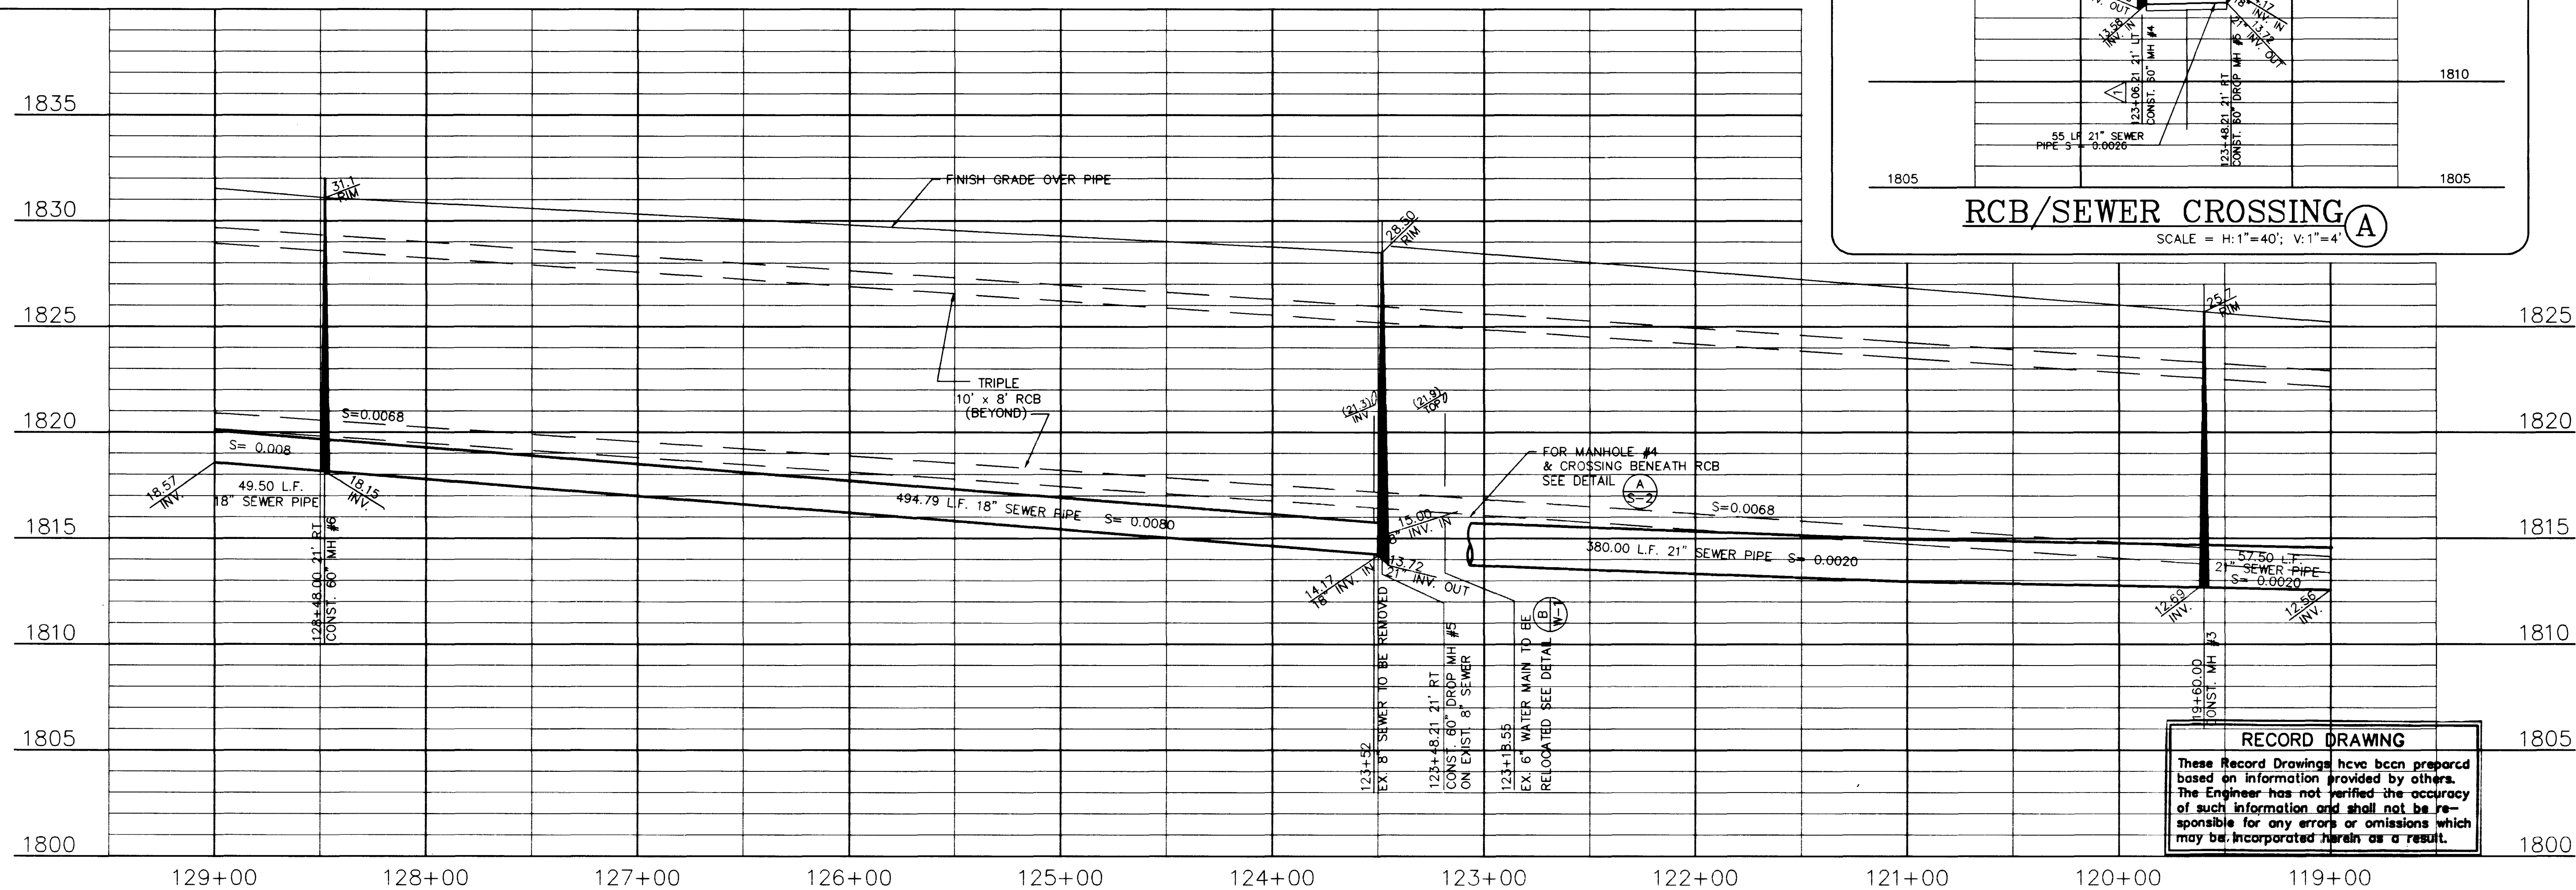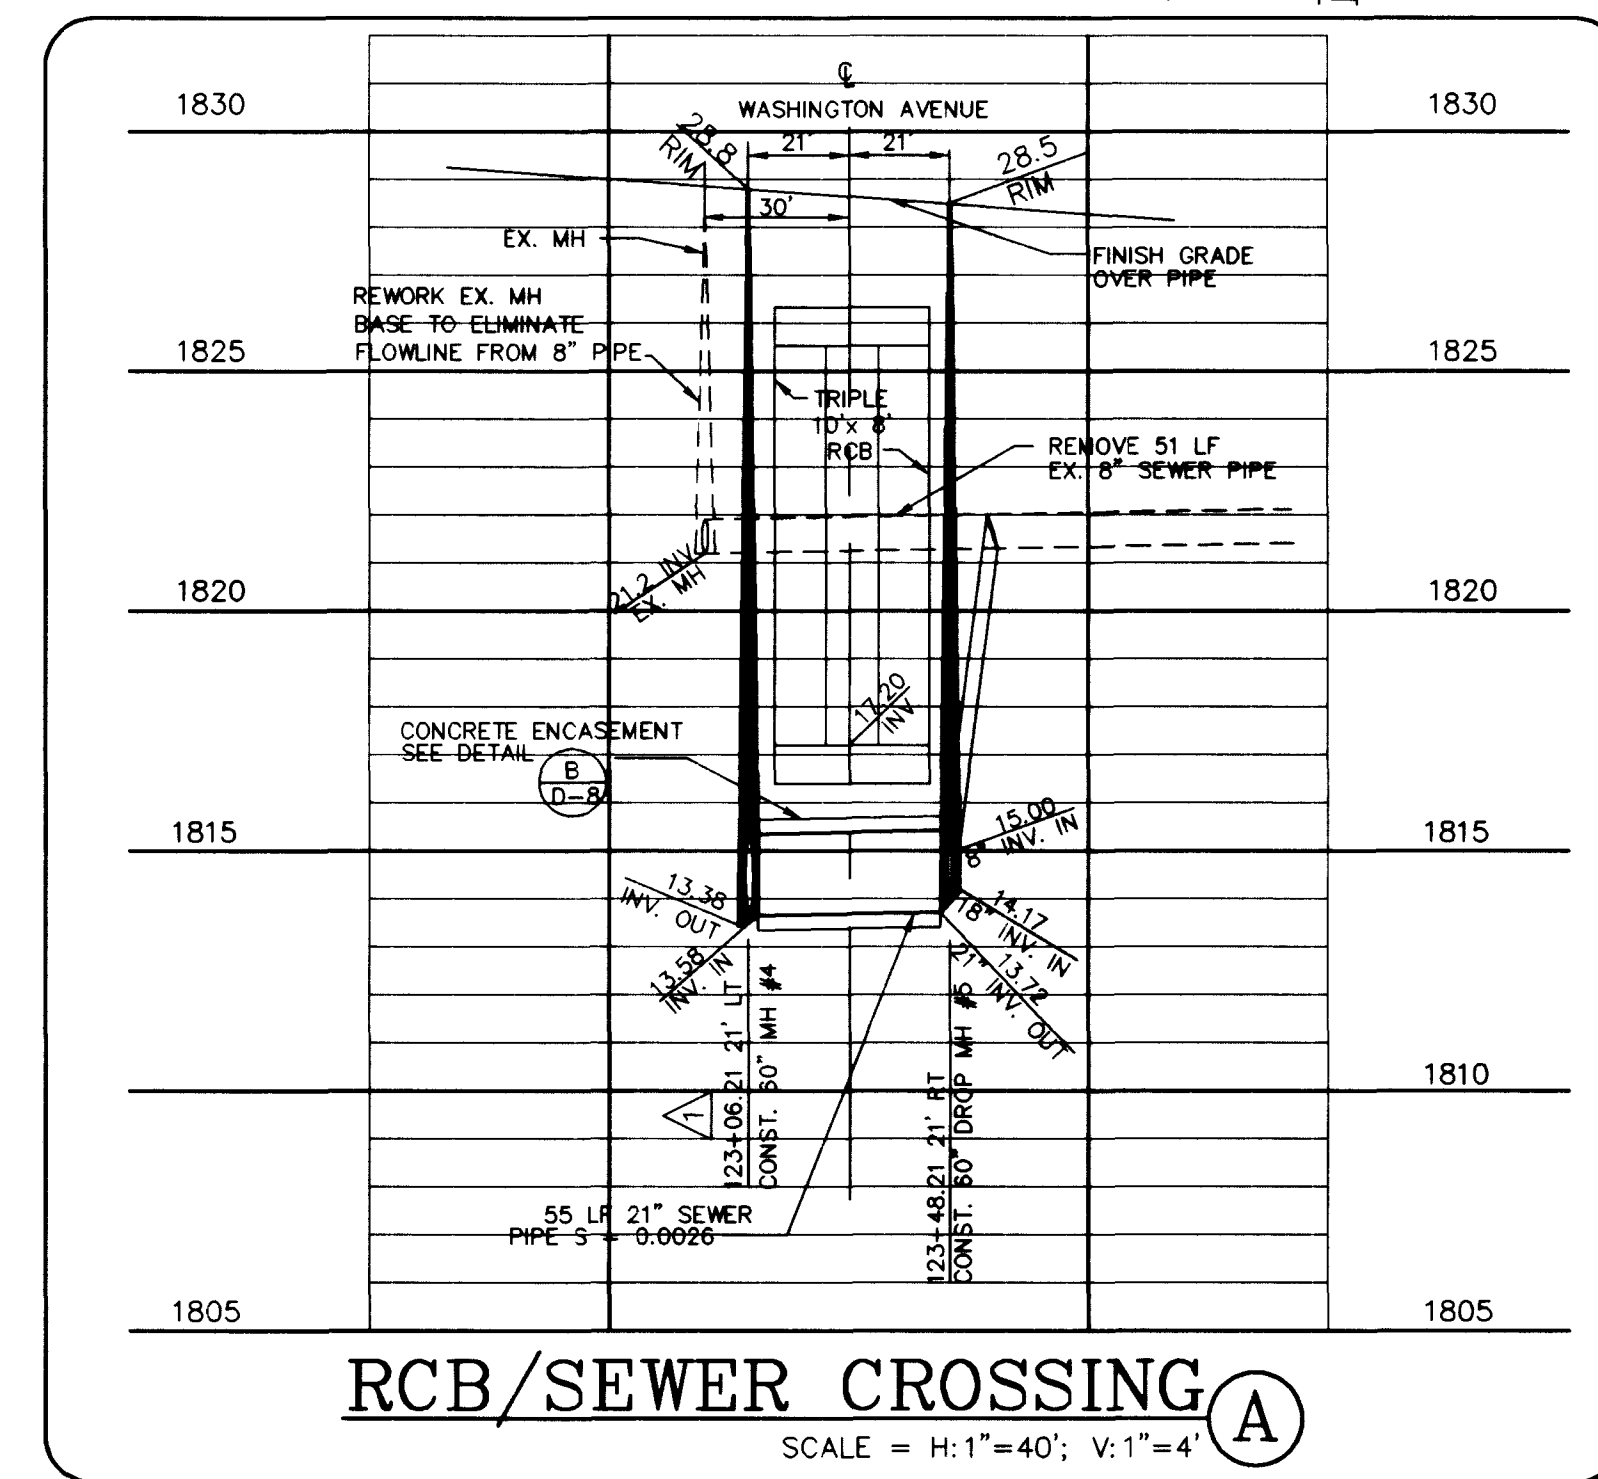

RECORD DRAWING
These Record Drawings have been prepared based on information provided by others. The Engineer has not verified the accuracy of such information and shall not be responsible for any errors or omissions which may be incorporated herein as a result.


PROJECT: CITY OF LAS VEGAS WASHINGTON AVENUE CONVEYANCE SYSTEM DESCRIPTION: SANITARY SEWER PLAN and PROFILE STA. 119+00 to 129+00		DESIGNED: <u>BB</u> DRAWN: <u>RB</u> CHECKED: <u>RB</u> JOB NO. <u>388-9-91</u> SCALE: <u>1" = 40'</u> HORIZ. <u>1" = 40'</u> VERT. <u>1" = 4'</u>  MECA CONSULTING ENGINEERS 1055 EAST TRIPICANA LAS VEGAS, NEVADA 89119 (702)798-1007		REVISIONS <table><thead><tr><th>No.</th><th>Date</th><th>CHND</th><th>APPD</th></tr></thead><tbody><tr><td>1</td><td>1/19/96</td><td></td><td></td></tr><tr><td></td><td></td><td></td><td></td></tr><tr><td></td><td></td><td></td><td></td></tr><tr><td></td><td></td><td></td><td></td></tr><tr><td></td><td></td><td></td><td></td></tr><tr><td></td><td></td><td></td><td></td></tr><tr><td></td><td></td><td></td><td></td></tr><tr><td></td><td></td><td></td><td></td></tr><tr><td></td><td></td><td></td><td></td></tr><tr><td></td><td></td><td></td><td></td></tr><tr><td></td><td></td><td></td><td></td></tr><tr><td></td><td></td><td></td><td></td></tr><tr><td></td><td></td><td></td><td></td></tr><tr><td></td><td></td><td></td><td></td></tr><tr><td></td><td></td><td></td><td></td></tr><tr><td></td><td></td><td></td><td></td></tr><tr><td></td><td></td><td></td><td></td></tr><tr><td></td><td></td><td></td><td></td></tr><tr><td></td><td></td><td></td><td></td></tr><tr><td></td><td></td><td></td><td></td></tr><tr><td></td><td></td><td></td><td></td></tr><tr><td></td><td></td><td></td><td></td></tr><tr><td></td><td></td><td></td><td></td></tr><tr><td></td><td></td><td></td><td></td></tr><tr><td></td><td></td><td></td><td></td></tr><tr><td></td><td></td><td></td><td></td></tr><tr><td></td><td></td><td></td><td></td></tr><tr><td></td><td></td><td></td><td></td></tr><tr><td></td><td></td><td></td><td></td></tr><tr><td></td><td></td><td></td><td></td></tr><tr><td></td><td></td><td></td><td></td></tr><tr><td></td><td></td><td></td><td></td></tr><tr><td></td><td></td><td></td><td></td></tr><tr><td></td></tr></tbody></table>		No.	Date	CHND	APPD	1	1/19/96																																																																																																																																																																																																																																																																																																																																																																																																																																																																																																																																																																																																																																																																																																																																																																																																																																																																																																																																																																																																																																																																			
No.	Date	CHND	APPD																																																																																																																																																																																																																																																																																																																																																																																																																																																																																																																																																																																																																																																																																																																																																																																																																																																																																																																																																																																																																																																																											
1	1/19/96																																																																																																																																																																																																																																																																																																																																																																																																																																																																																																																																																																																																																																																																																																																																																																																																																																																																																																																																																																																																																																																																													

DATE	10/1/80
BY	W. J. ...
CHECKED BY	...
APPROVED BY	...

NO.	DESCRIPTION	DATE
1	...	...
2	...	...
3	...	...
4	...	...
5	...	...




STATE OF ...
 PROFESSIONAL ENGINEER
 LICENSE NO. ...
 CITY OF ...
 PROJECT: ...
 SHEET: ... OF ...
 DATE: ...

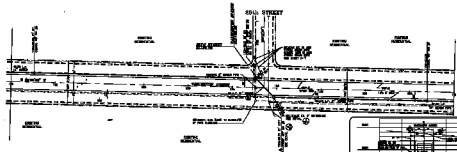

20th STREET
 100+00 TO 110+00

100+00 TO 110+00
 20th STREET

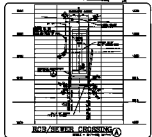

CROSSING

- NOTES:
1. ALL DIMENSIONS ARE IN FEET AND INCHES.
 2. ALL DIMENSIONS ARE TO THE CENTERLINE OF THE ROAD.
 3. ALL DIMENSIONS ARE TO THE CENTERLINE OF THE ROAD.
 4. ALL DIMENSIONS ARE TO THE CENTERLINE OF THE ROAD.

