



**REMOVAL OF EXISTING SERVICES NOTE:**


Existing service laterals that are to be disconnected from existing pipelines, shall have the corporation stops turned off at the pipeline. The existing service lateral that is to be disconnected shall be cut 6" downstream from the corporation stop and again cut 6" downstream so that a 6" piece of the existing service lateral is removed. If the corporation stop is damaged beyond repair or pulled from the existing pipeline, the pipeline shall be repaired at the Contractor's expense, in a manner approved by the Las Vegas Valley Water District. If the corporation stop is not water tight, the Contractor shall notify the Las Vegas Valley Water District.

The Contractor shall remove the existing service meter box and appurtenances, fill and grade any and all resulting voids and replace or restore, to original conditions or better, all landscaping, irrigation systems, concrete, concrete sidewalks, asphalt, or any other items damaged or removed during the removal of the existing service meter box.

**NOTE: ALL PIPES, MANHOLES, LATERALS, ETC. THAT ARE NOT A PART OF THE REVISED SYSTEM SHALL BE TOTALLY REMOVED FROM PRESENT UNDERGROUND LOCATIONS.**

**ABANDONED VALVE NOTE:**

The Contractor shall abandon all existing valves where shown on the drawings by removing a minimum of the top 12 inches of the valve box and then filling the remaining portion of the valve box with concrete having a compressive strength of at least 2,000 psi. All valves to be abandoned shall be abandoned in the closed position unless shown otherwise on the drawings. The Contractor shall then backfill and repave the area disturbed during abandonment of the valve in accordance with the most current draft or edition of Uniform Standard Specifications for Public Works Construction Offsite Improvements Clark County area.

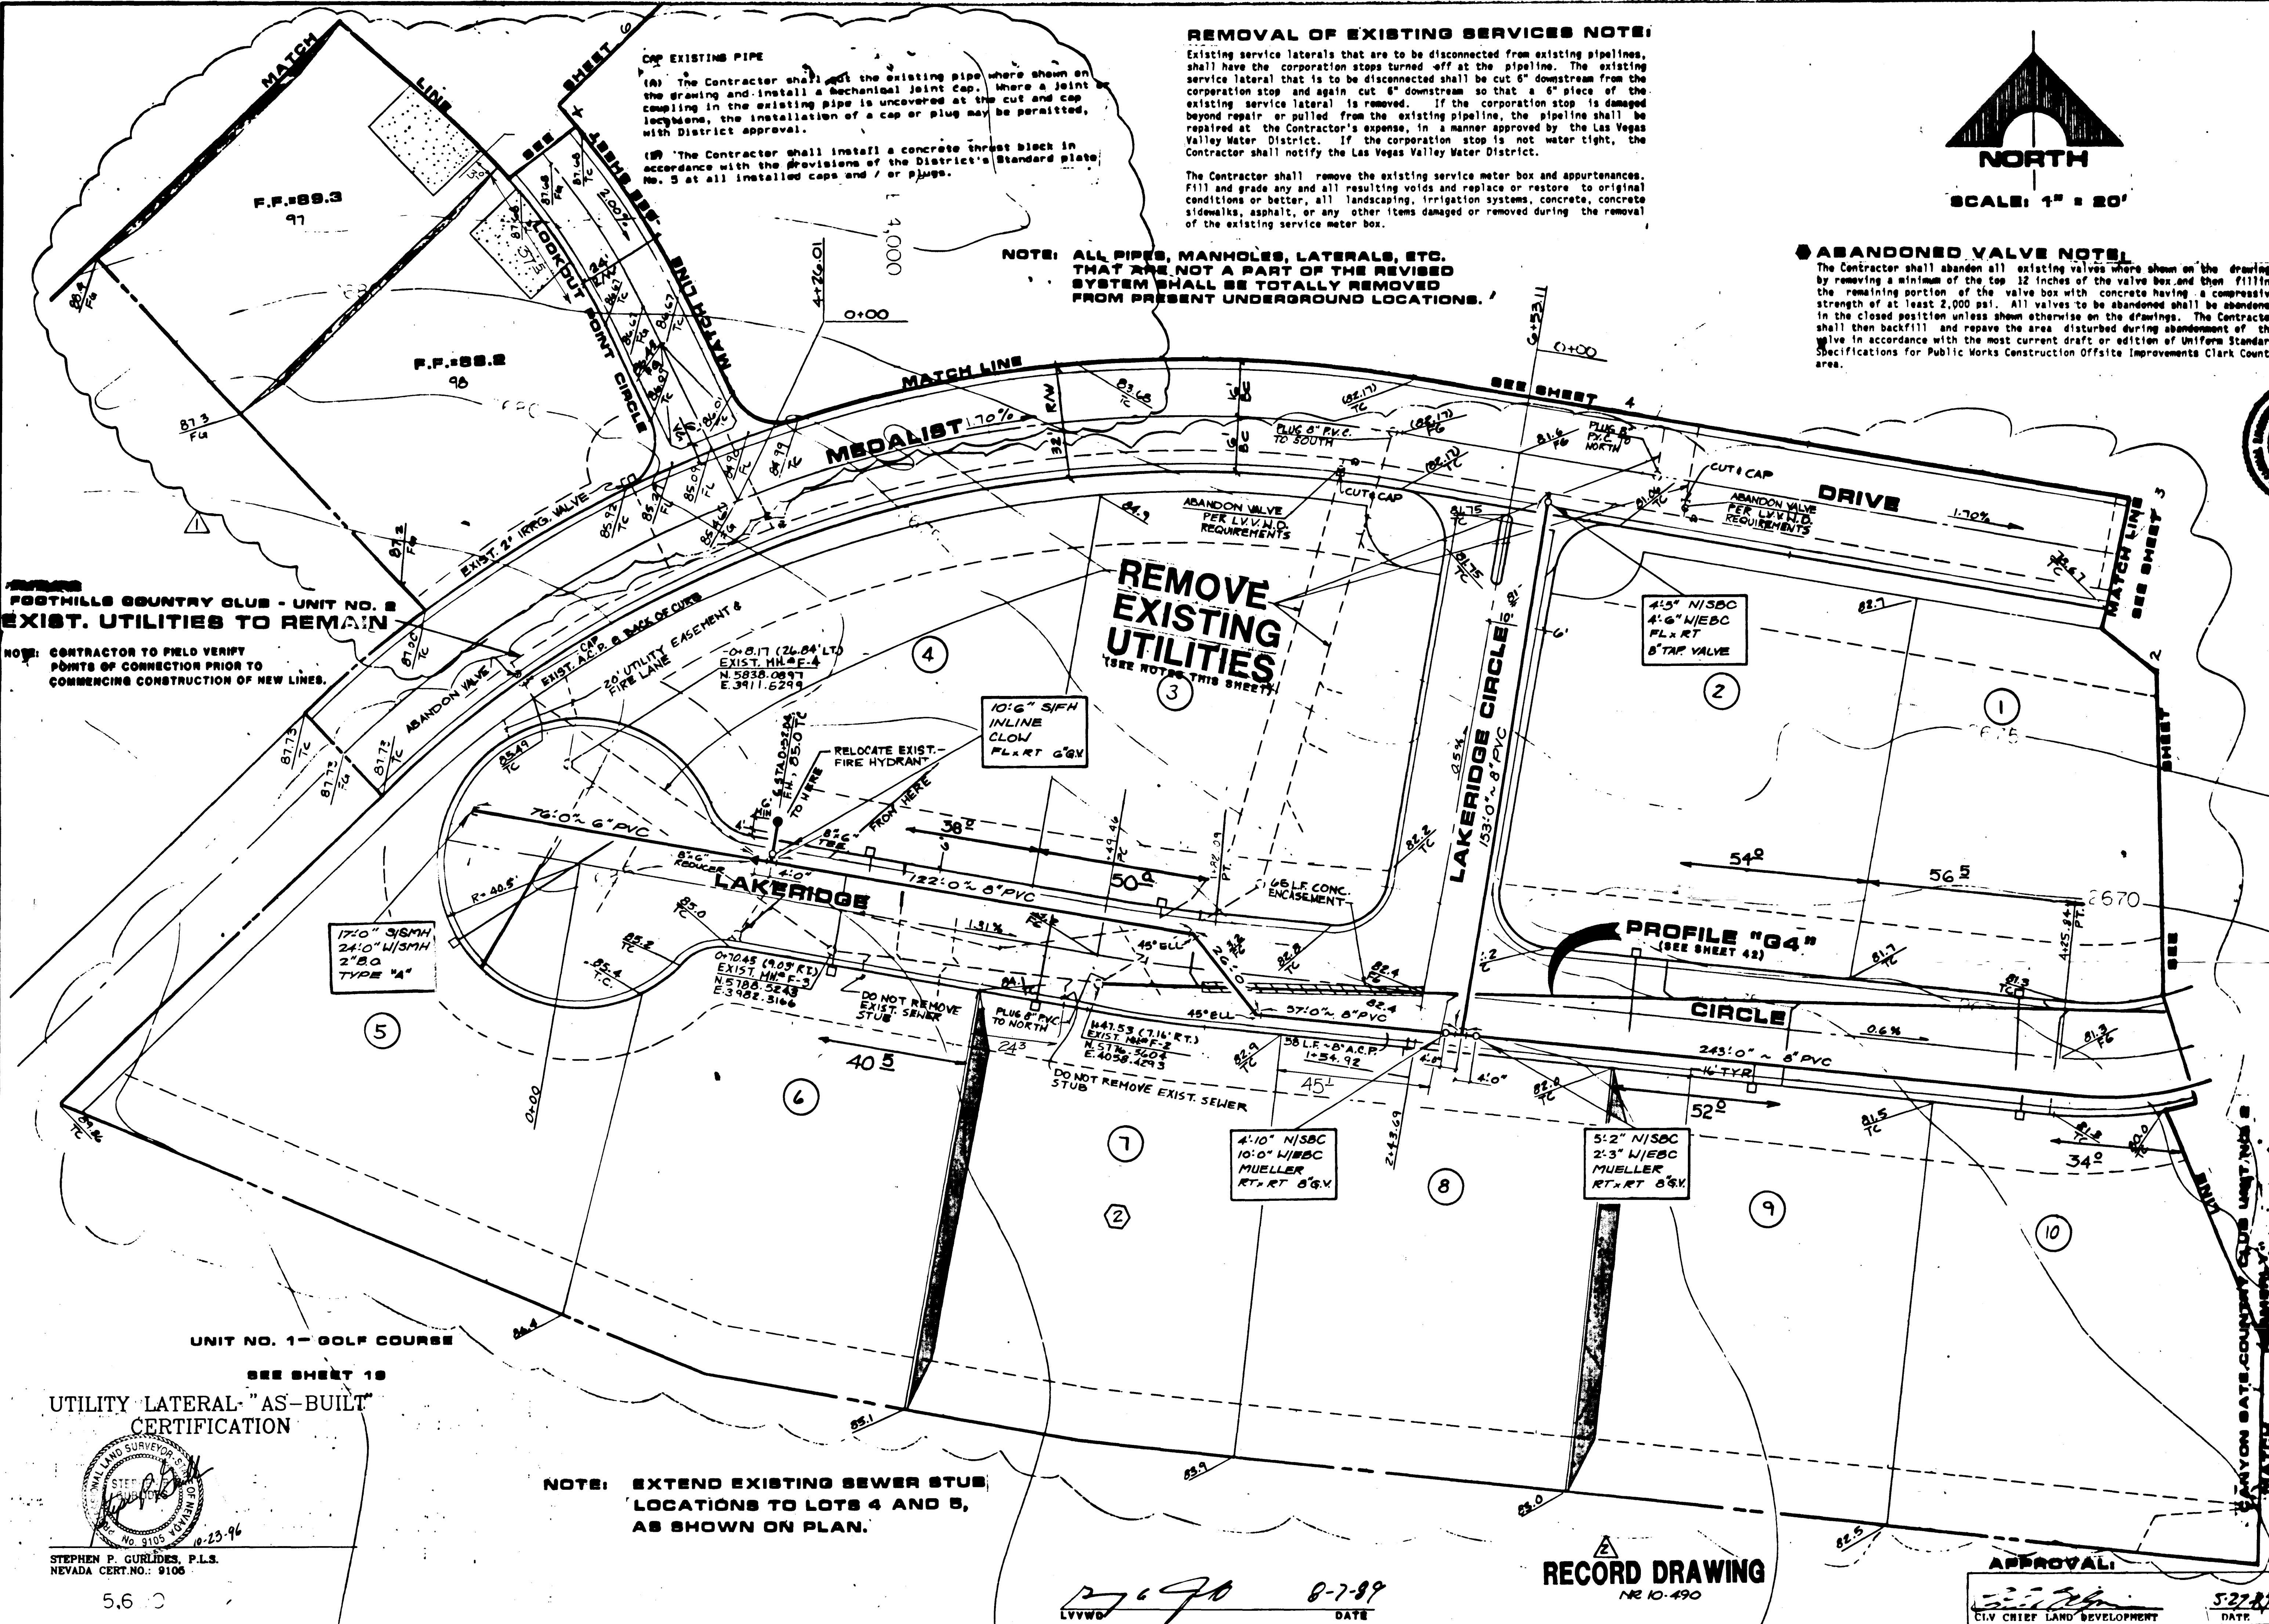

**FOOTHILLS COUNTRY CLUB - UNIT NO. 2 EXIST. UTILITIES TO REMAIN**


**NOTE: CONTRACTOR TO FIELD VERIFY POINTS OF CONNECTION PRIOR TO COMMENCING CONSTRUCTION OF NEW LINES.**

**REMOVE EXISTING UTILITIES**  
(SEE NOTES THIS SHEET)

UNIT NO. 1 - GOLF COURSE

SEE SHEET 19

UTILITY LATERAL "AS-BUILT" CERTIFICATION

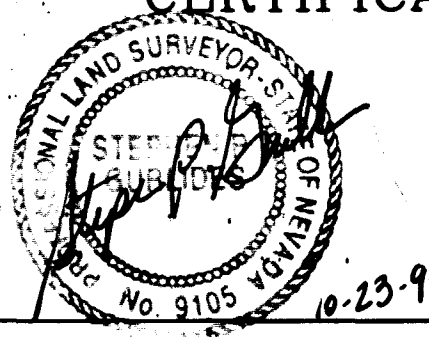

STEPHEN P. GURLIDES, P.L.S.  
NEVADA CERT. NO.: 9106

5.6


**NOTE: EXTEND EXISTING SEWER STUB LOCATIONS TO LOTS 4 AND 5, AS SHOWN ON PLAN.**

**RECORD DRAWING**  
NR 10-490

DATE: 8-7-89

APPROVAL:

DATE: 5-27-91

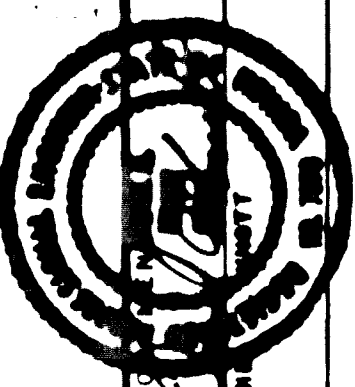

**G.C. WALLACE, INC.**  
Engineering/Architecture

FOOTHILLS COUNTRY CLUB UNIT NO. 1  
AT PECOLE RANCH  
SEWER AS-BUILT  
FAIRWAY ESTATES

SHEET


5

TO BE REMOVED FOR  
 THE REASON THAT THE  
 EXISTING UTILITIES ARE  
 LOCATED IN THE  
 AREA OF THE  
 PROPOSED  
 CONSTRUCTION.

REMOVAL OF EXISTING SERVICES NOTE  
 THE EXISTING UTILITIES ARE TO BE REMOVED  
 IN ACCORDANCE WITH THE  
 REQUIREMENTS OF THE  
 CITY OF LOS ANGELES  
 AND THE CALIFORNIA  
 PUBLIC UTILITIES  
 CODE.



REMARKS: THE EXISTING UTILITIES ARE TO BE REMOVED  
 IN ACCORDANCE WITH THE REQUIREMENTS OF THE  
 CITY OF LOS ANGELES AND THE CALIFORNIA  
 PUBLIC UTILITIES CODE.

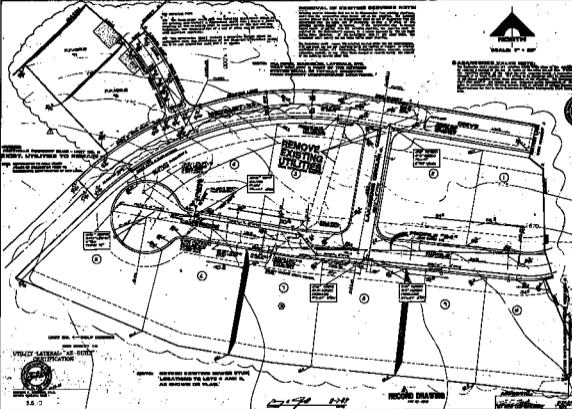

EXISTING UTILITIES TO BE REMOVED  
 IN ACCORDANCE WITH THE  
 REQUIREMENTS OF THE  
 CITY OF LOS ANGELES  
 AND THE CALIFORNIA  
 PUBLIC UTILITIES  
 CODE.

REMOVE  
 EXISTING  
 UTILITIES

RECORD DRAWING

REMARKS: REMOVE EXISTING SERVICES FROM  
 LOCATIONS TO LOTS 4 AND 5,  
 AS SHOWN ON PLAN.

UTILITY LATERAL AS SHOWN  
 ON THIS DRAWING



3.5.0