




\_\_\_\_\_

SHT 14 OF 26

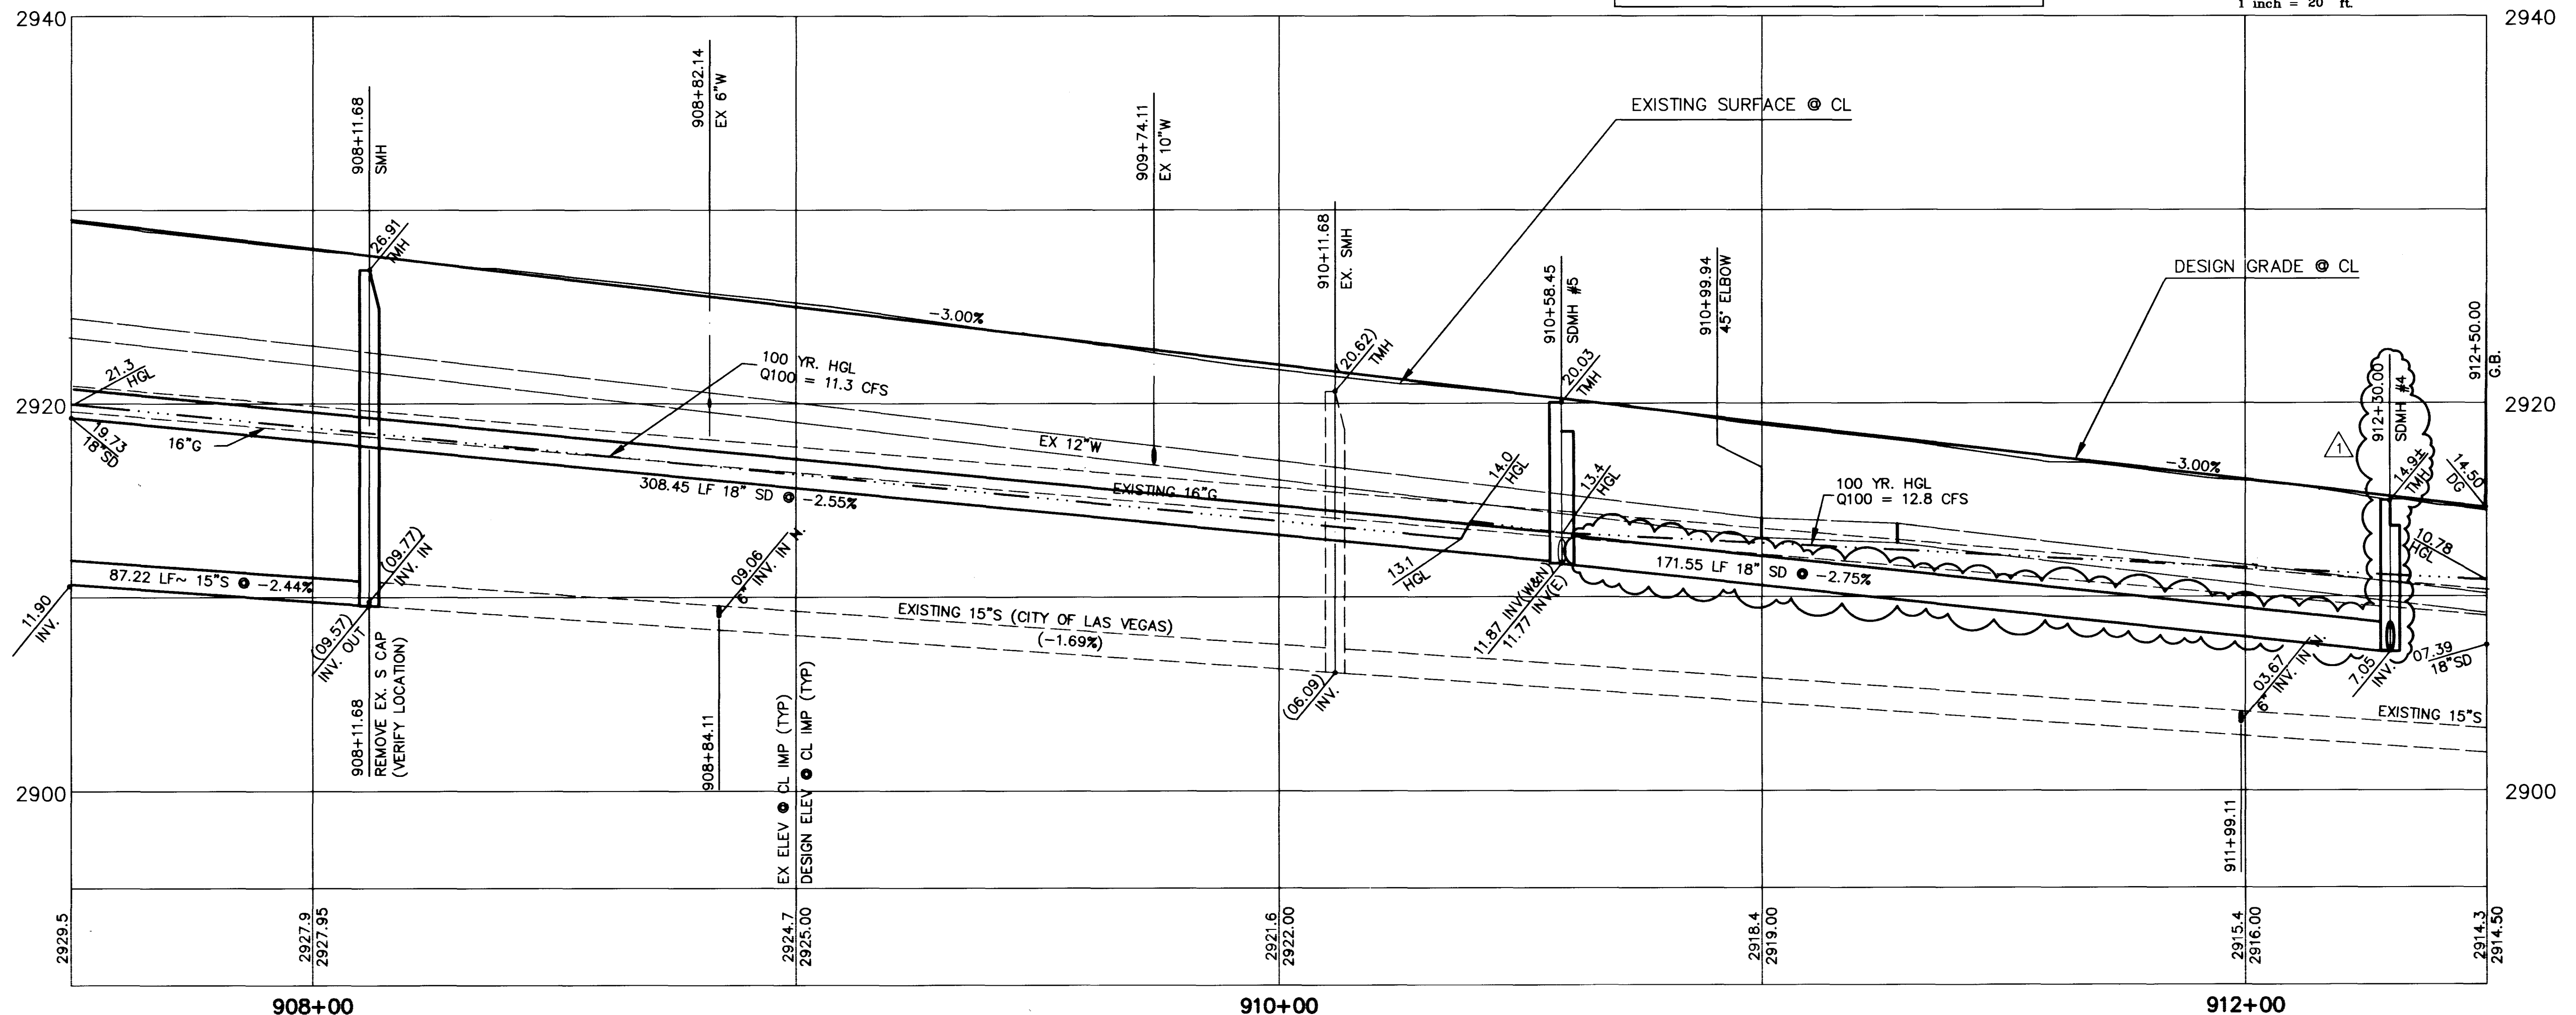