


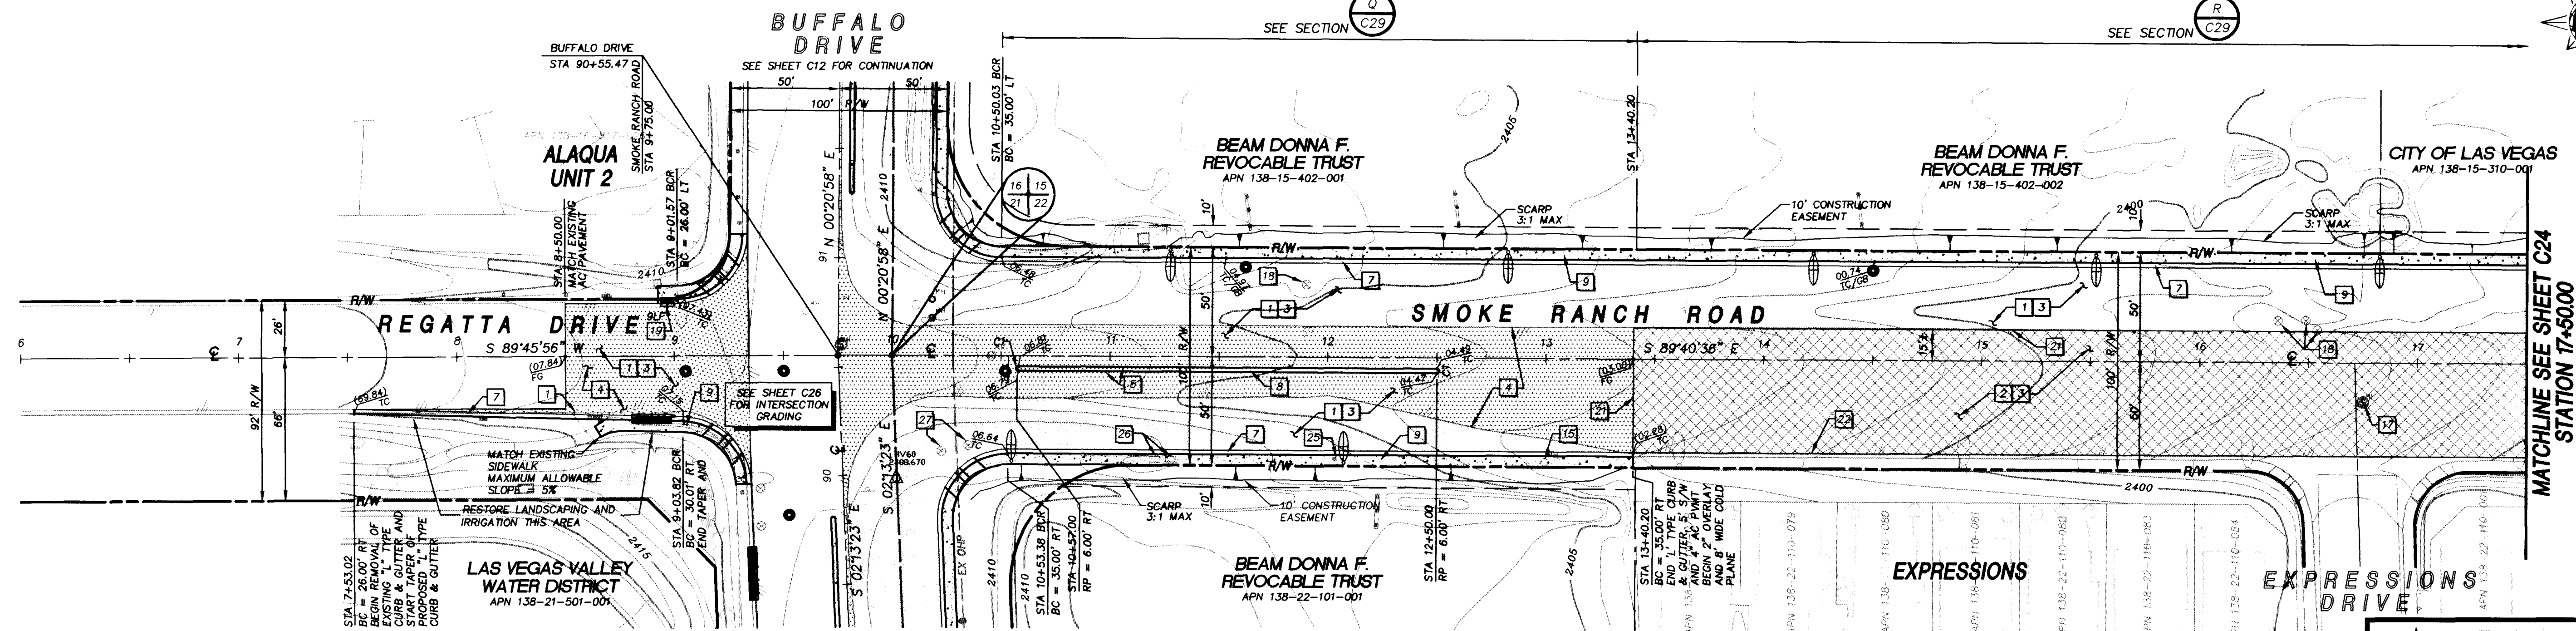



CONSTRUCTION ITEMS

- 1. CONSTRUCT 4" AC PAVEMENT
- 2. CONSTRUCT 2" AC OVERLAY
- 3. CONSTRUCT 3/4" OPEN GRADE
- 4. REMOVE EXISTING AC PAVEMENT
- 5. CONSTRUCT TYPE "A" TACK ON CURB PER STD DWG #220
- 7. CONSTRUCT "L" TYPE CURB AND GUTTER PER STD DWG #216
- 8. CONSTRUCT 4" MEDIAN SLAB PER STD DWG #218
- 9. CONSTRUCT 5' SIDEWALK PER STD DWG #234
- 15. ADJUST UTILITY MANHOLE TO PROPOSED FINISH GRADE
- 17. ADJUST SANITARY SEWER MANHOLE TO PROPOSED FINISH GRADE
- 18. ADJUST WATER VALVE TO PROPOSED FINISH GRADE
- 19. REMOVE LF OF EXISTING SIDEWALK CURB & GUTTER FOR DROP INLET CONSTRUCTION AND REPLACE S/W PER STD DWG #234
- 21. SAWCUT AND MATCH EXISTING AC PAVEMENT
- 22. COLD PLANE EDGE OF AC 8' WIDE - DEPTH VARIES 2" TO 0"
- 25. RELOCATE ANODE TEST STATION TO SIDEWALK GRADE PER LVWD STANDARDS
- 26. UTILITY VAULT TO BE ADJUSTED BY OTHERS
- 27. ADJUST GAS VALVE TO PROPOSED FINISH GRADE


CURVE TABLE

NO.	RADIUS	DELTA	LENGTH	TANGENT
C1	1.00	180°00'00"	3.14	


ALL MEDIAN CURBS ARE FACE OF CURB, ALL OTHER CURVES ARE BACK OF CURB, UNLESS OTHERWISE NOTED.

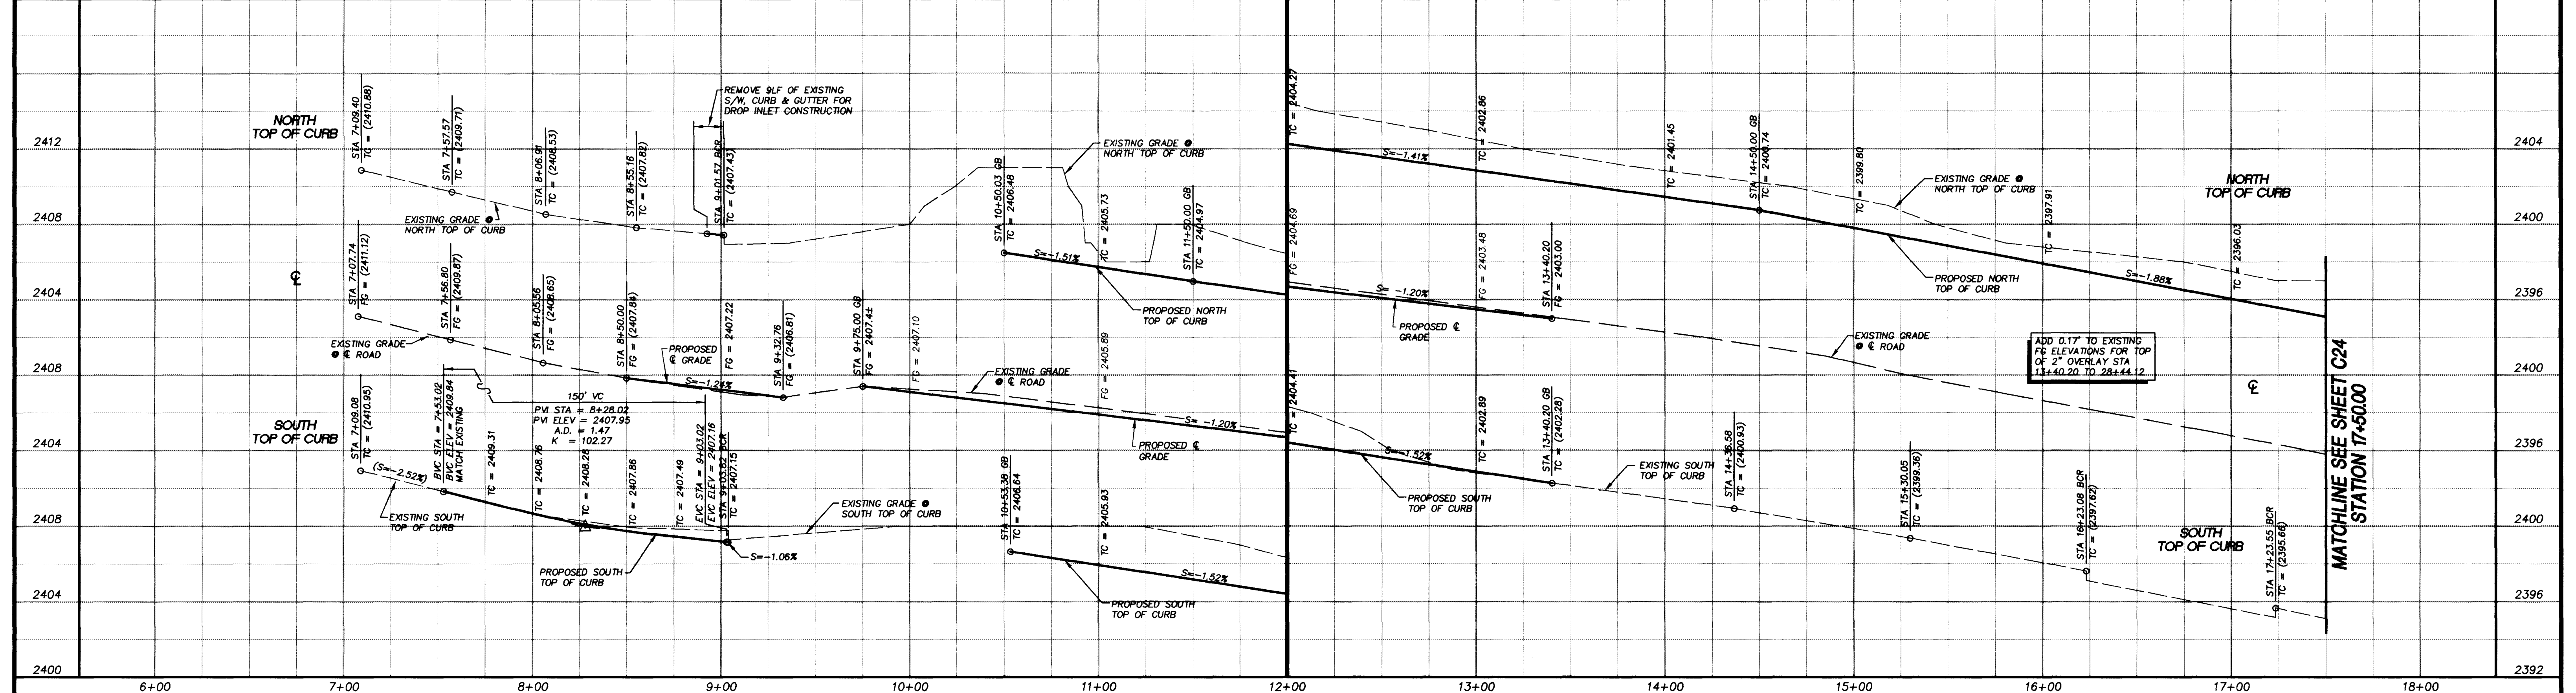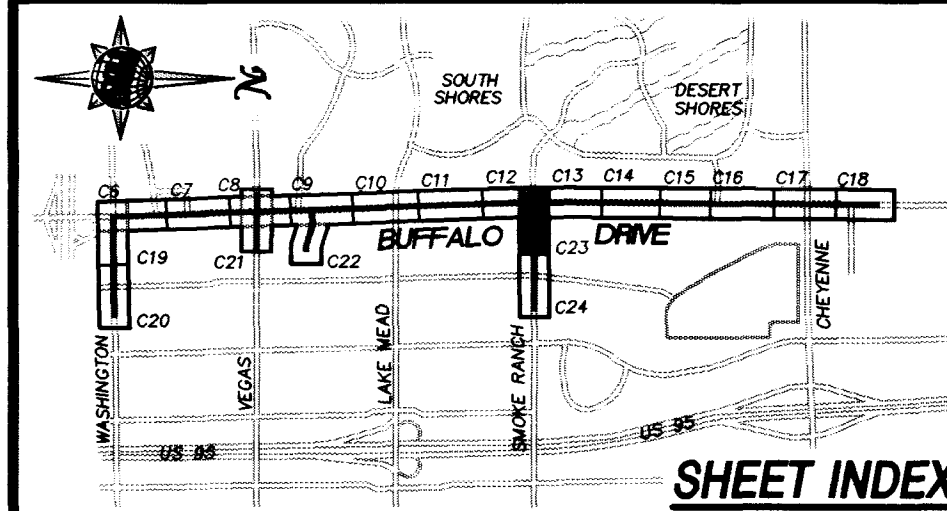

REVISIONS				
REV.	DESCRIPTION	BY	DATE	APPROVAL

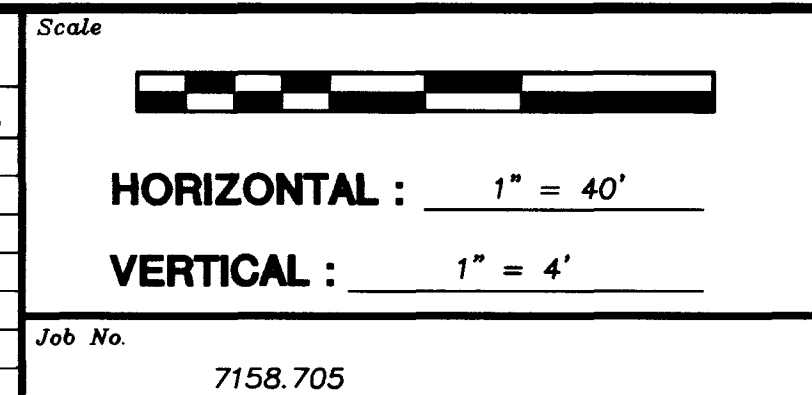

POST, BUCKLEY, SCHUH & JERNIGAN
901 North Green Valley Pkwy
Suite 100
Henderson, Nevada 89014
Telephone: 702/263-7275
Fax: 702/263-7200

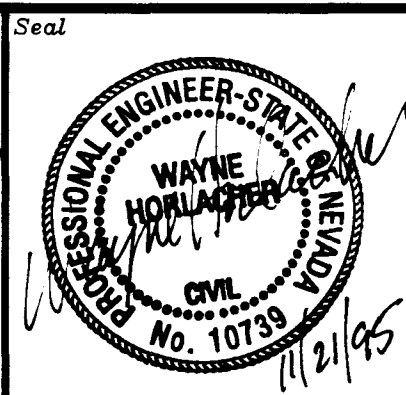

Designed by :	AAS	Date :	09/15/95
Drawn by :	AAS	Date :	09/15/95
Checked by :	WEH	Date :	09/15/95
File No. :	705IMP	Dwg No. :	705-C23

City of Las Vegas
BUFFALO DRIVE ROADWAY IMPROVEMENTS
BID No. 96.730.35
SMOKE RANCH
PLAN AND PROFILE STA 6+00 TO STA 17+50
CITY OF LAS VEGAS DRAWING No. 107-V2314
SHEET C23

AS BUILT

