




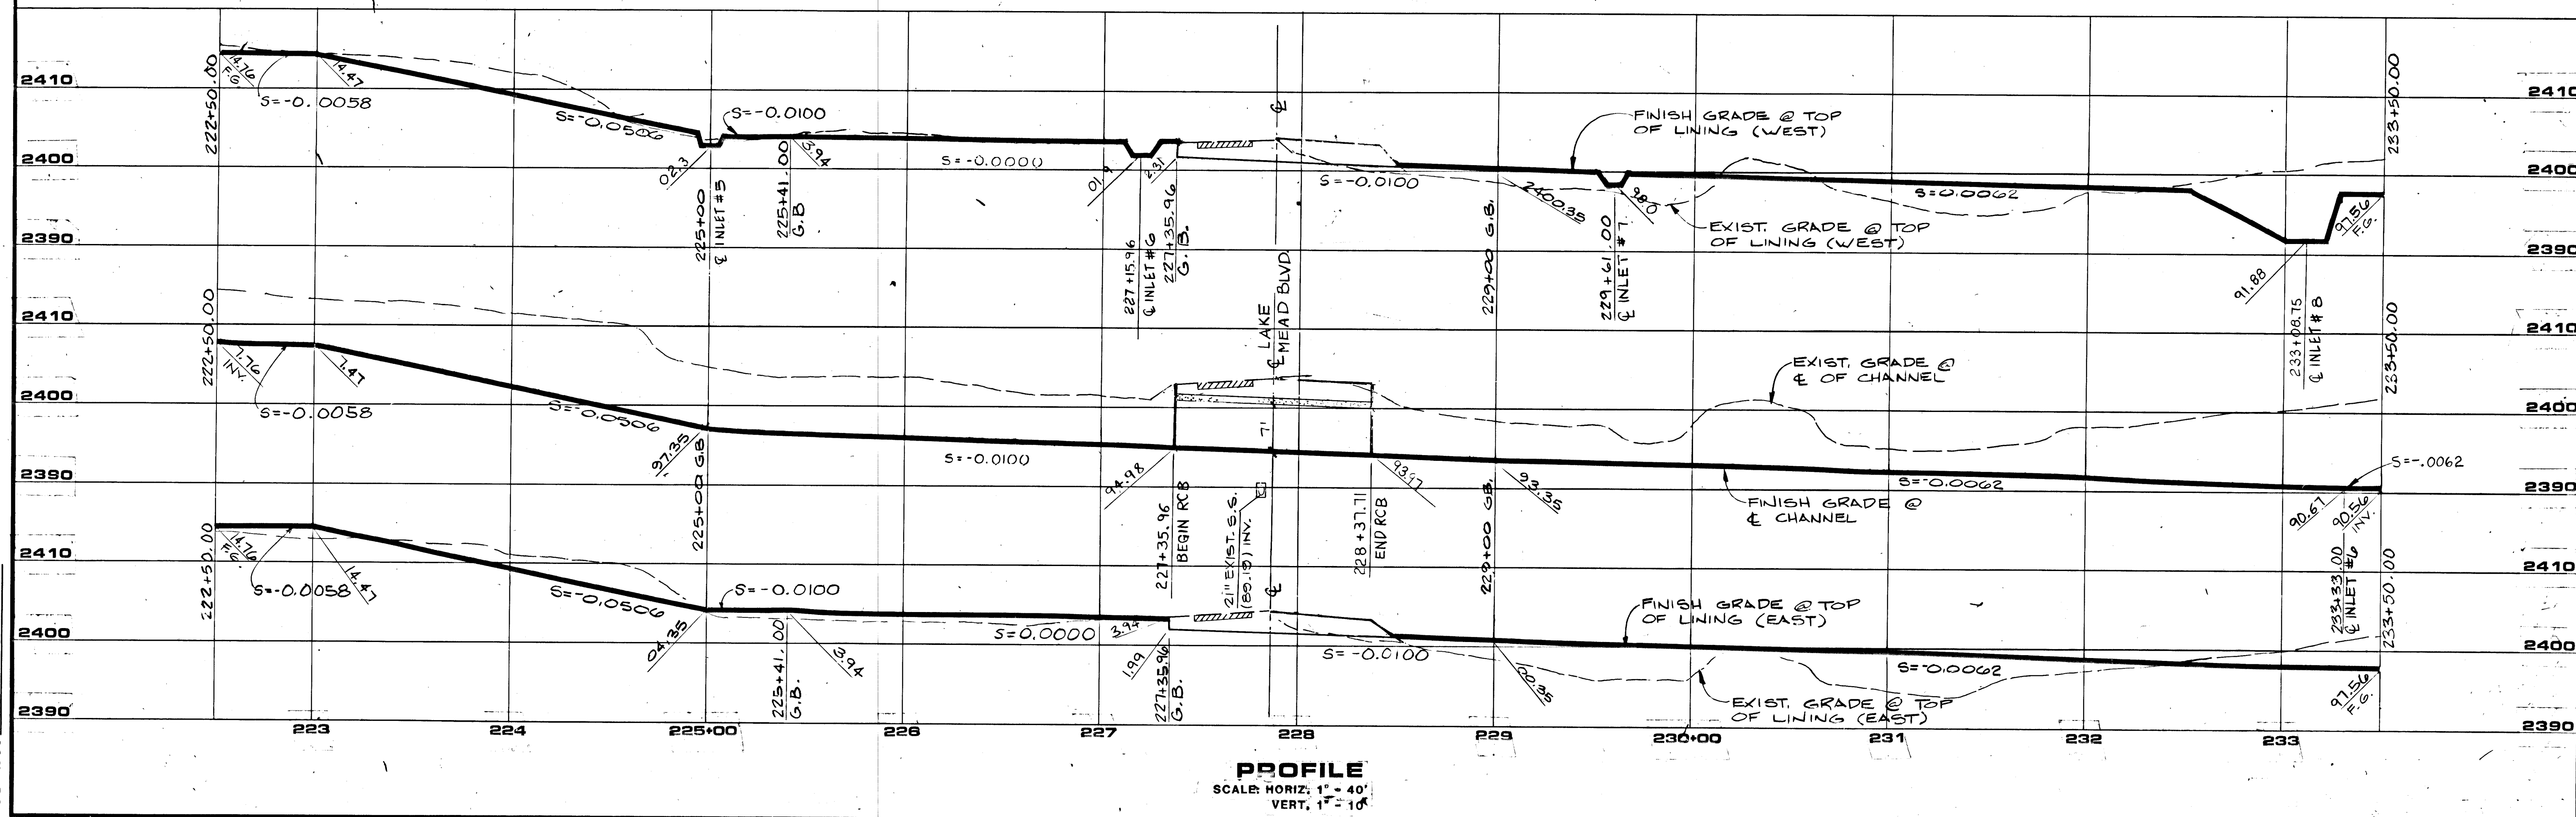

222+50 MATCH LINE - SEE SHT. 14

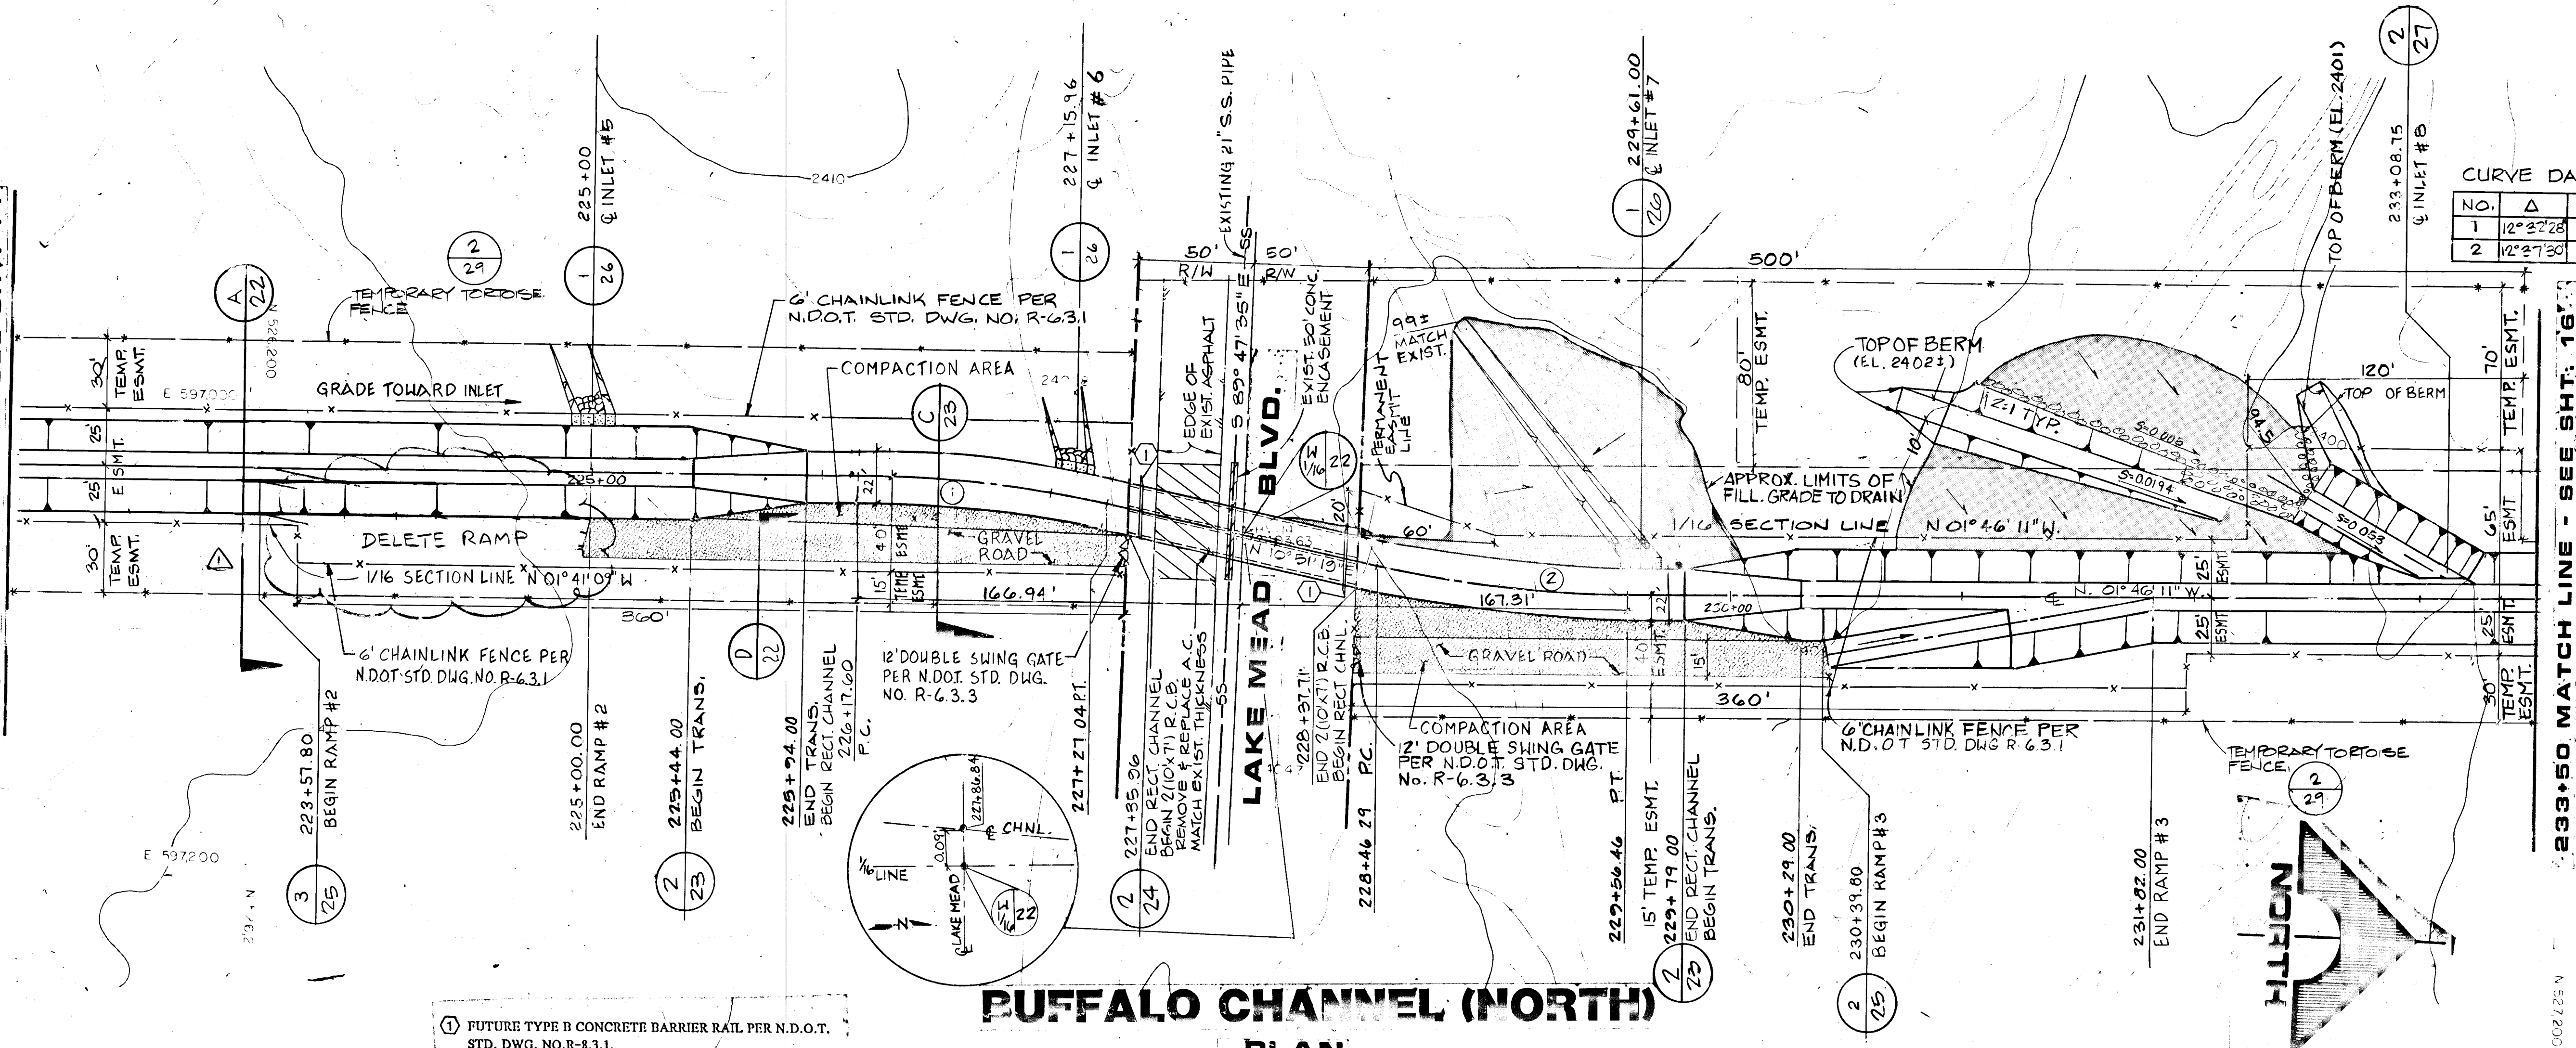

CURVE DATA				
NO.	Δ	R	L	T
1	12° 27' 28"	500'	103.44'	54.94'
2	12° 27' 30"	500'	110.17'	55.31'

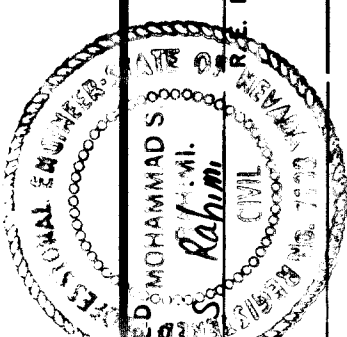

G.C. WALLACE, INC.
Engineering/Architecture
RECORD DRAWING - 13 MAY 92
1555 SOUTH RAINBOW BLVD., LAS VEGAS, NEVADA 89102

CITY OF LAS VEGAS
ANGEL PARK OUTLET AND OUTFALL
PLAN AND PROFILE
STATION 222+50 TO 233+50

SHEET
15
OF 31 SHEETS