
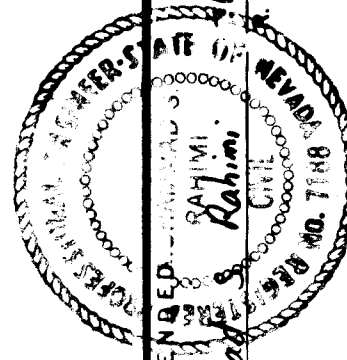
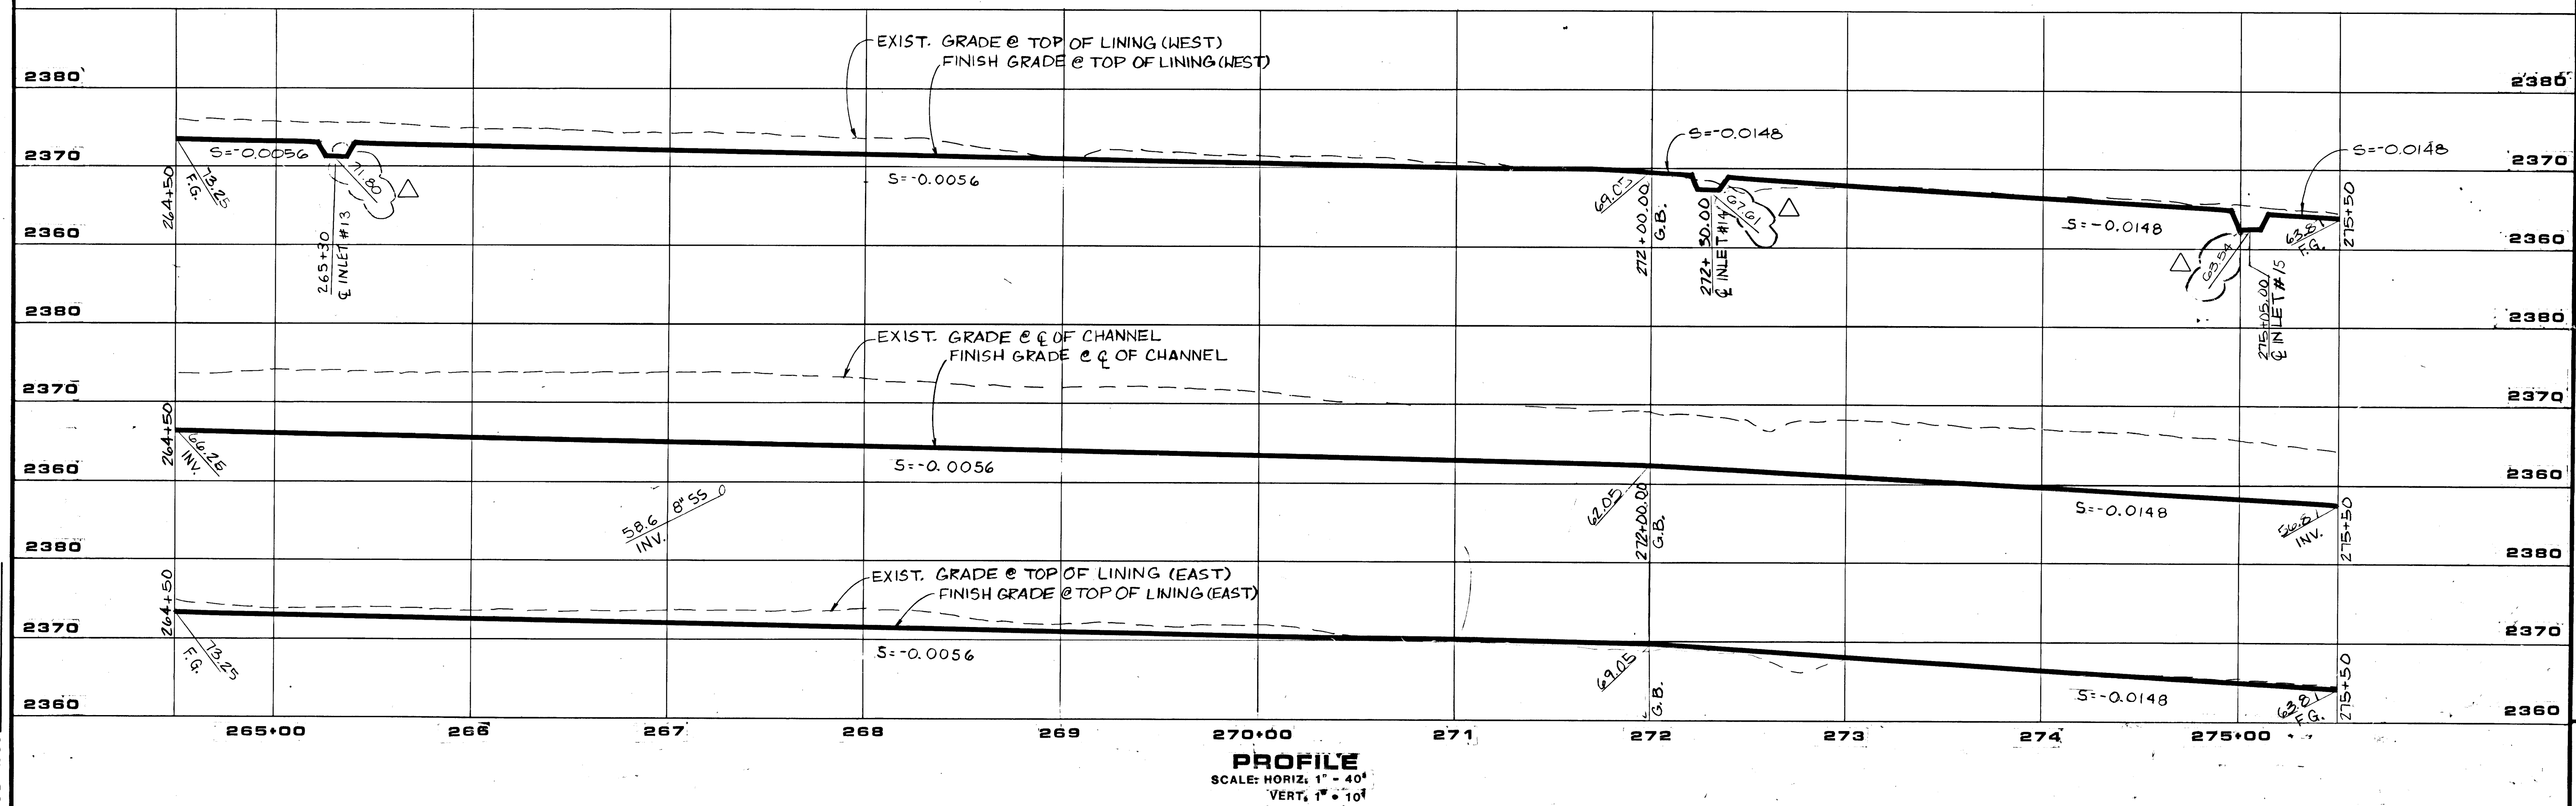


JOB NO. 412.330

BIM DIETERICH-POST 6328  
CAN 100888

264+50 MATCH LINE - SEE SHT. 18

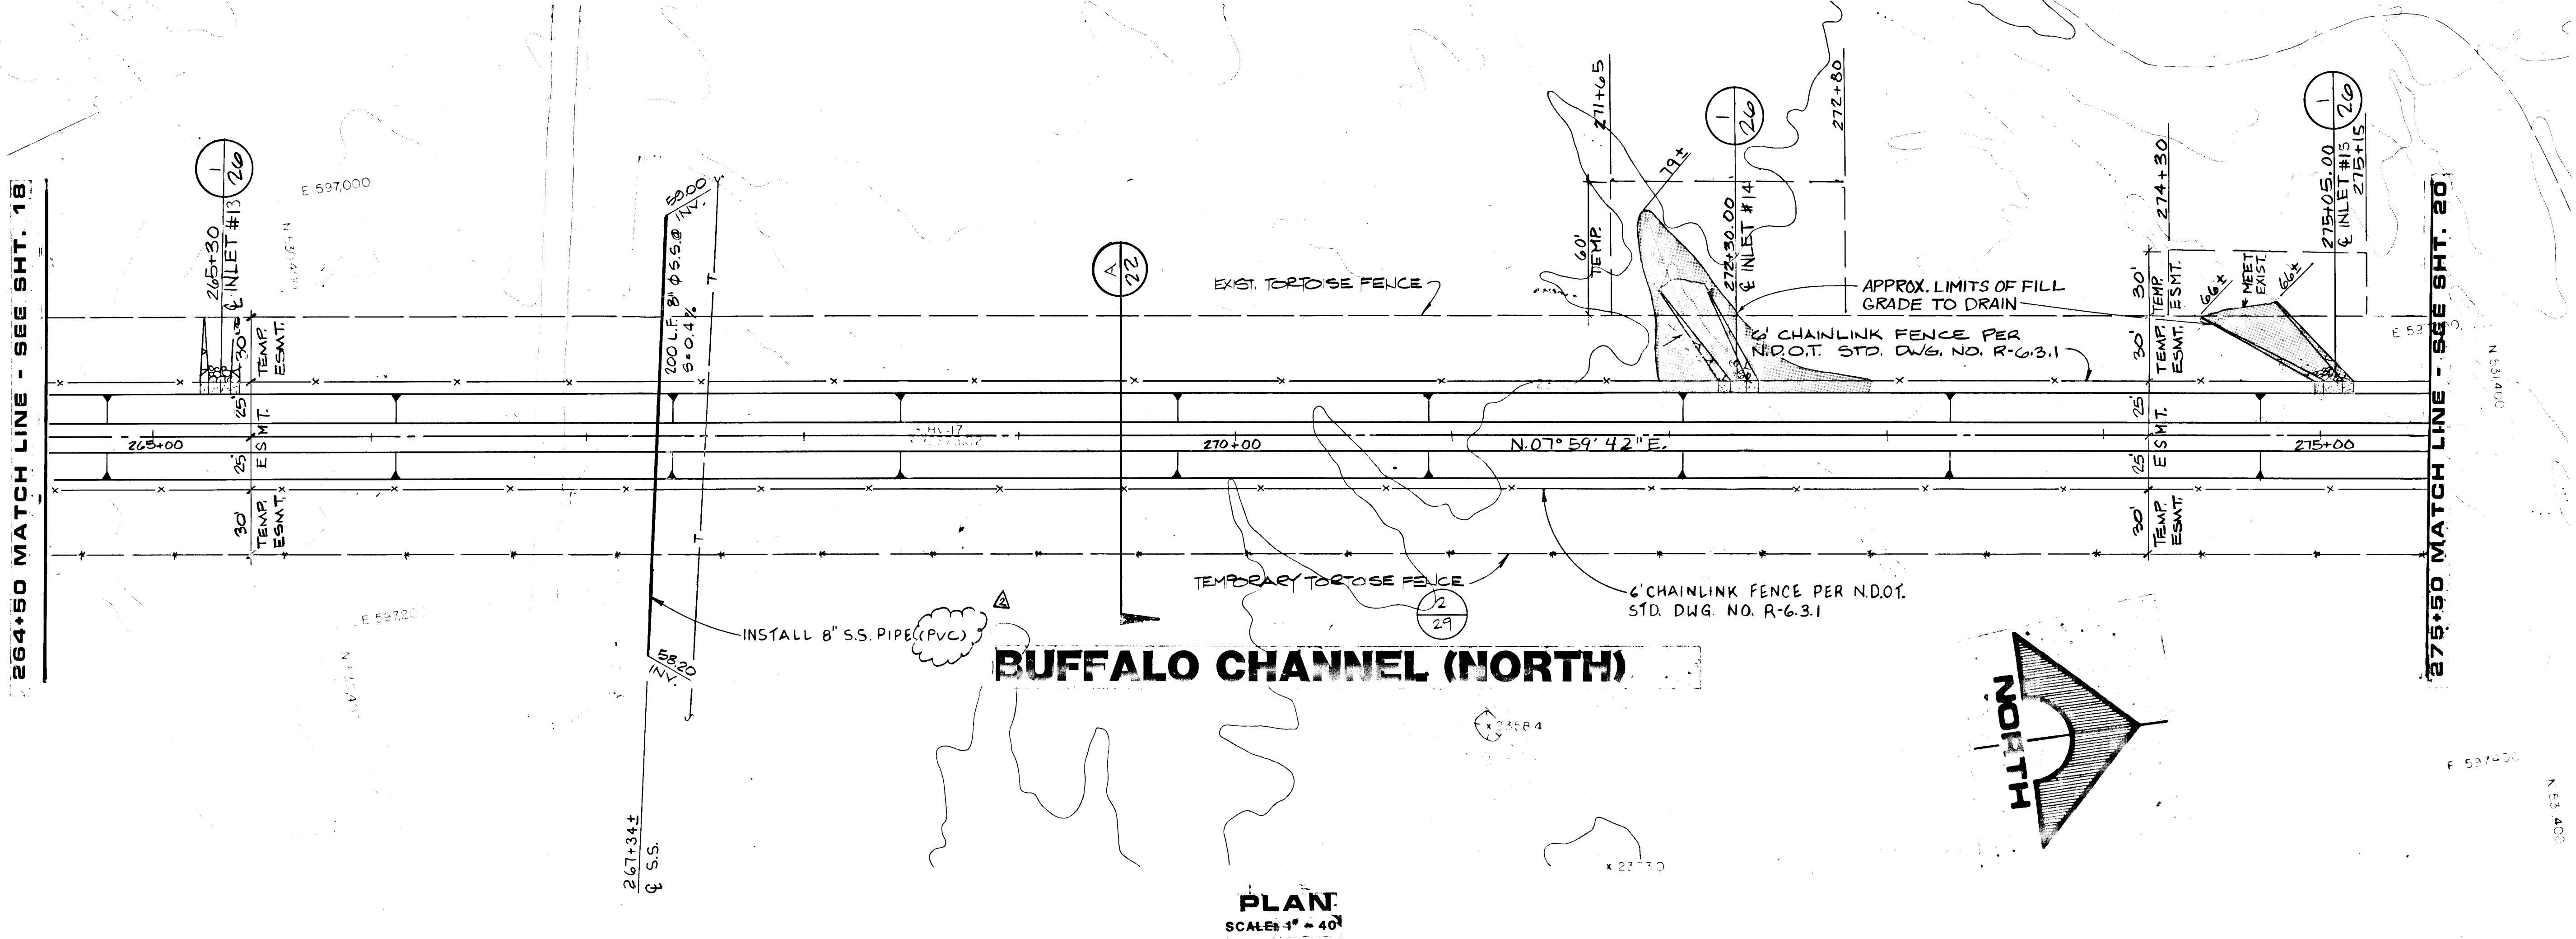

REV	DATE	DESCRIPTION
1	10/1/90	MISCELLANEOUS
2	10/30/92	AS-BUILT

RECOMMENDED BY: *[Signature]*  
 G.C. WALLACE, INC.  
 RECORD DRAWING 13 MAY 92  
 1535 SOUTH RAINBOW BLVD / LAS VEGAS, NEVADA 89102  
 Engineering/Architecture

CITY OF LAS VEGAS  
 ANGEL PARK OUTLET AND OUTFALL  
 PLAN AND PROFILE  
 STATION 264+50 TO 275+50

SHEET  
**19**  
 OF 31 SHEETS

3612

731-49