


KEYNOTES

- NEW BUILDING
- CANOPY
- DOWN LINE
- STRIPING
- LANDSCAPED AREA
- BOLLARDS AT TRANSFORMER
- FUEL ISLAND
- AC. PAVEMENT
- TRUCK WASH
- TRASH ENCLOSURE
- CONCRETE CURB
- NOT USED
- EXISTING FENCE TO BE RELOCATED TO TOP OF RETAINING WALL
- FUTURE NAT. GAS BLOW FILL STATION
- CONSTRUCTION FENCE
- EXISTING FENCE TO REMAIN
- METAL ROOFING SYS.
- H.M. DOOR -SEE DOOR SCHED.
- SEE A2.40 & CIVIL DWGS. FOR EXPANSION JOINTS
- CONCRETE APRON -SEE CIVIL
- SEE A6.01 FOR CMU COLORS SIM. PATTERN
- TRENCH DRAIN -SEE STRUCTURAL & PLUMBING
- SEE CIVIL FOR SLAB ELEVATIONS
- FOOTING BELOW
- DIRECTIONAL ARROWS - PAINT TO MATCH STRIPING
- SPRINT OFM SITE & TRANSFORMER TO REMAIN
- REMOVE & REPLACE EXIST. CHAIN LINK FENCE TO PLACE RIFRAP

709 Valle Verde Court
Henderson, Nevada 89014
Tel. 702 . 456 . 3000
Fax. 702 . 898 . 6209

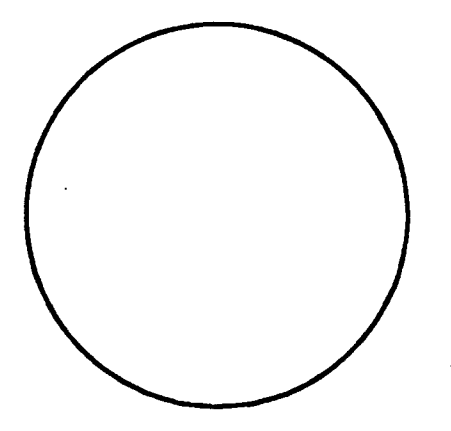

THIS DRAWING AND ALL INFORMATION HEREON IS THE PROPERTY OF THE ARCHITECT. IT IS TO BE USED ONLY FOR THE PROJECT AND SITE SPECIFICALLY IDENTIFIED HEREON. THE ARCHITECT ASSUMES NO LIABILITY FOR ANY DAMAGE TO PERSONS OR PROPERTY ARISING FROM THE USE OF THIS DRAWING. THE ARCHITECT'S LIABILITY IS LIMITED TO THE PROFESSIONAL SERVICES RENDERED AND SHALL NOT BE EXTENDED TO ANY OTHER MATTER. THE ARCHITECT'S LIABILITY SHALL NOT BE EXTENDED TO ANY OTHER MATTER.


Consultant

Sheet Title
SITE PLAN

Project
**CITY OF LAS VEGAS
WEST VEHICLE SERVICE CENTER**

ISSUED FOR CONTRACTOR'S PREPARATION OF RECORD DRAWINGS

Date: 02.05.96
Sheet No. 2
AS1.01

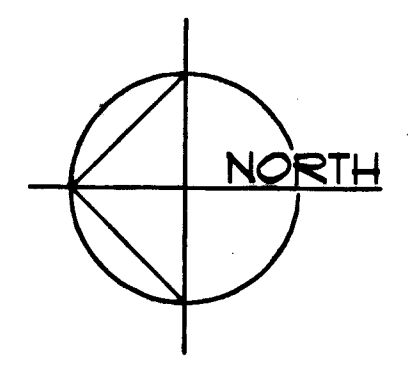

AS-BUILT 522-V61