


990713

01169



05-21-99 07:32:12
R:\051\770\008m\unit\cc-tie5.dwg
PLOTED: 3/9/94 CC-BLDG SW

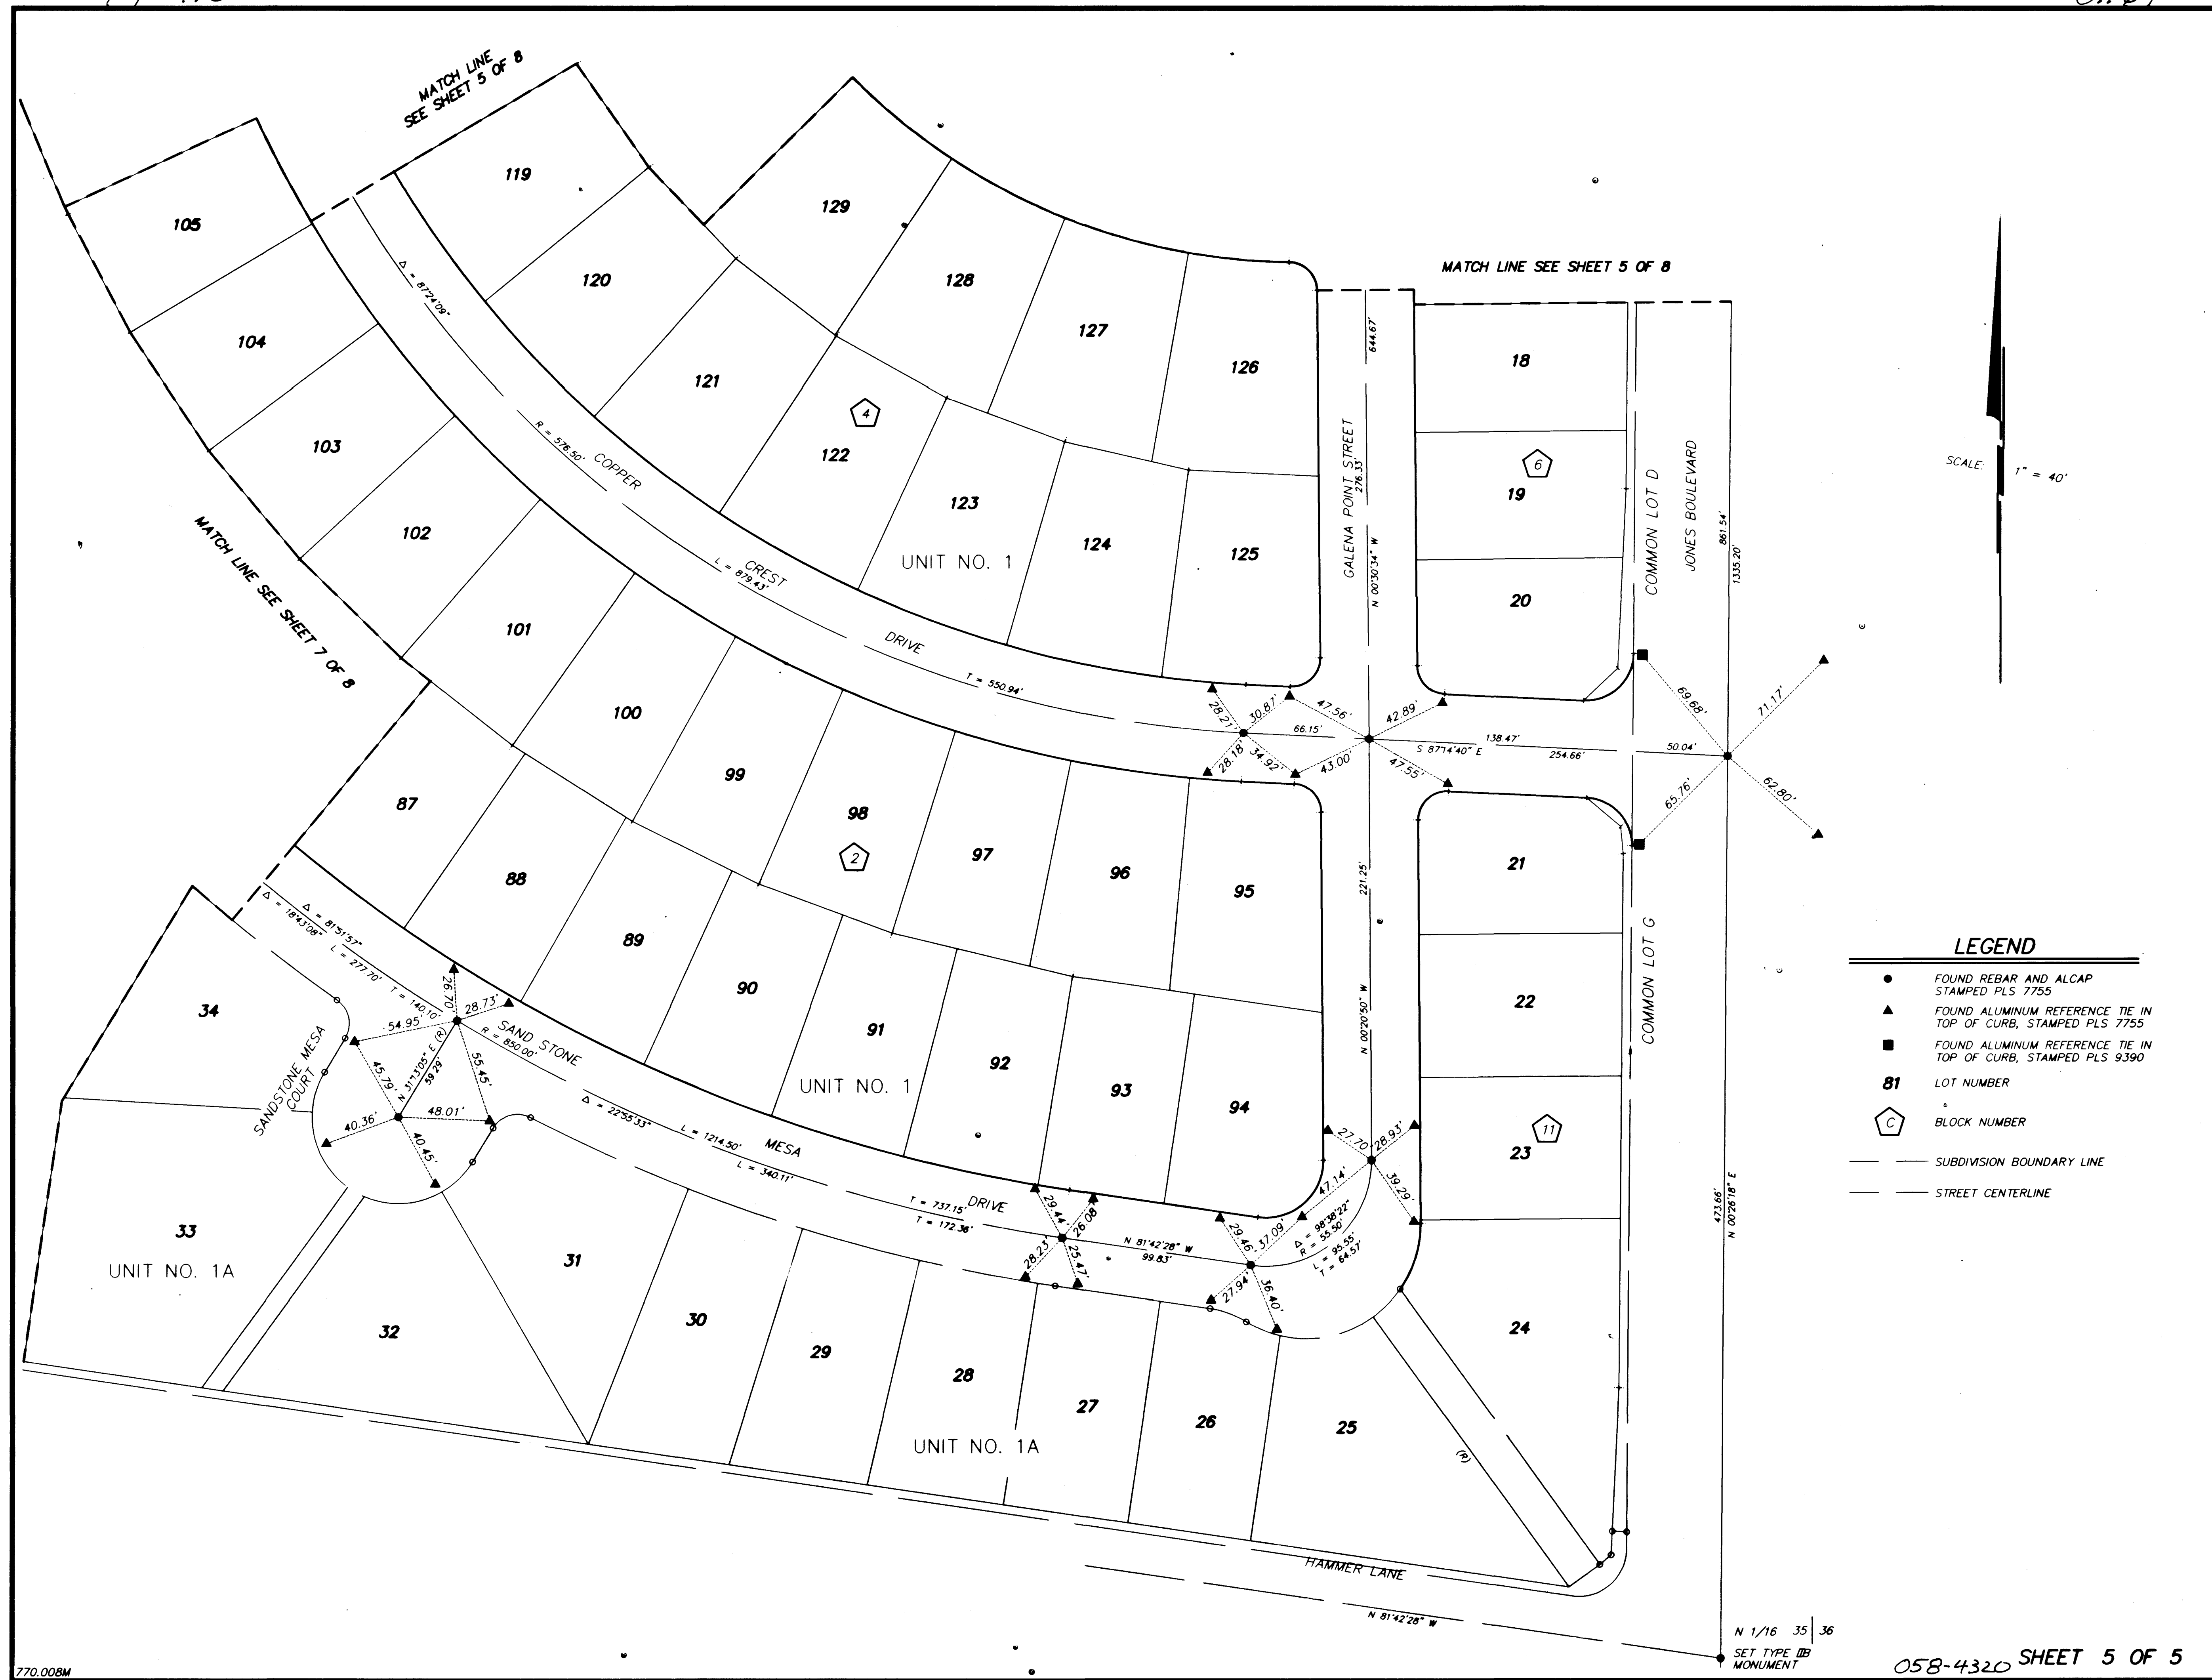