


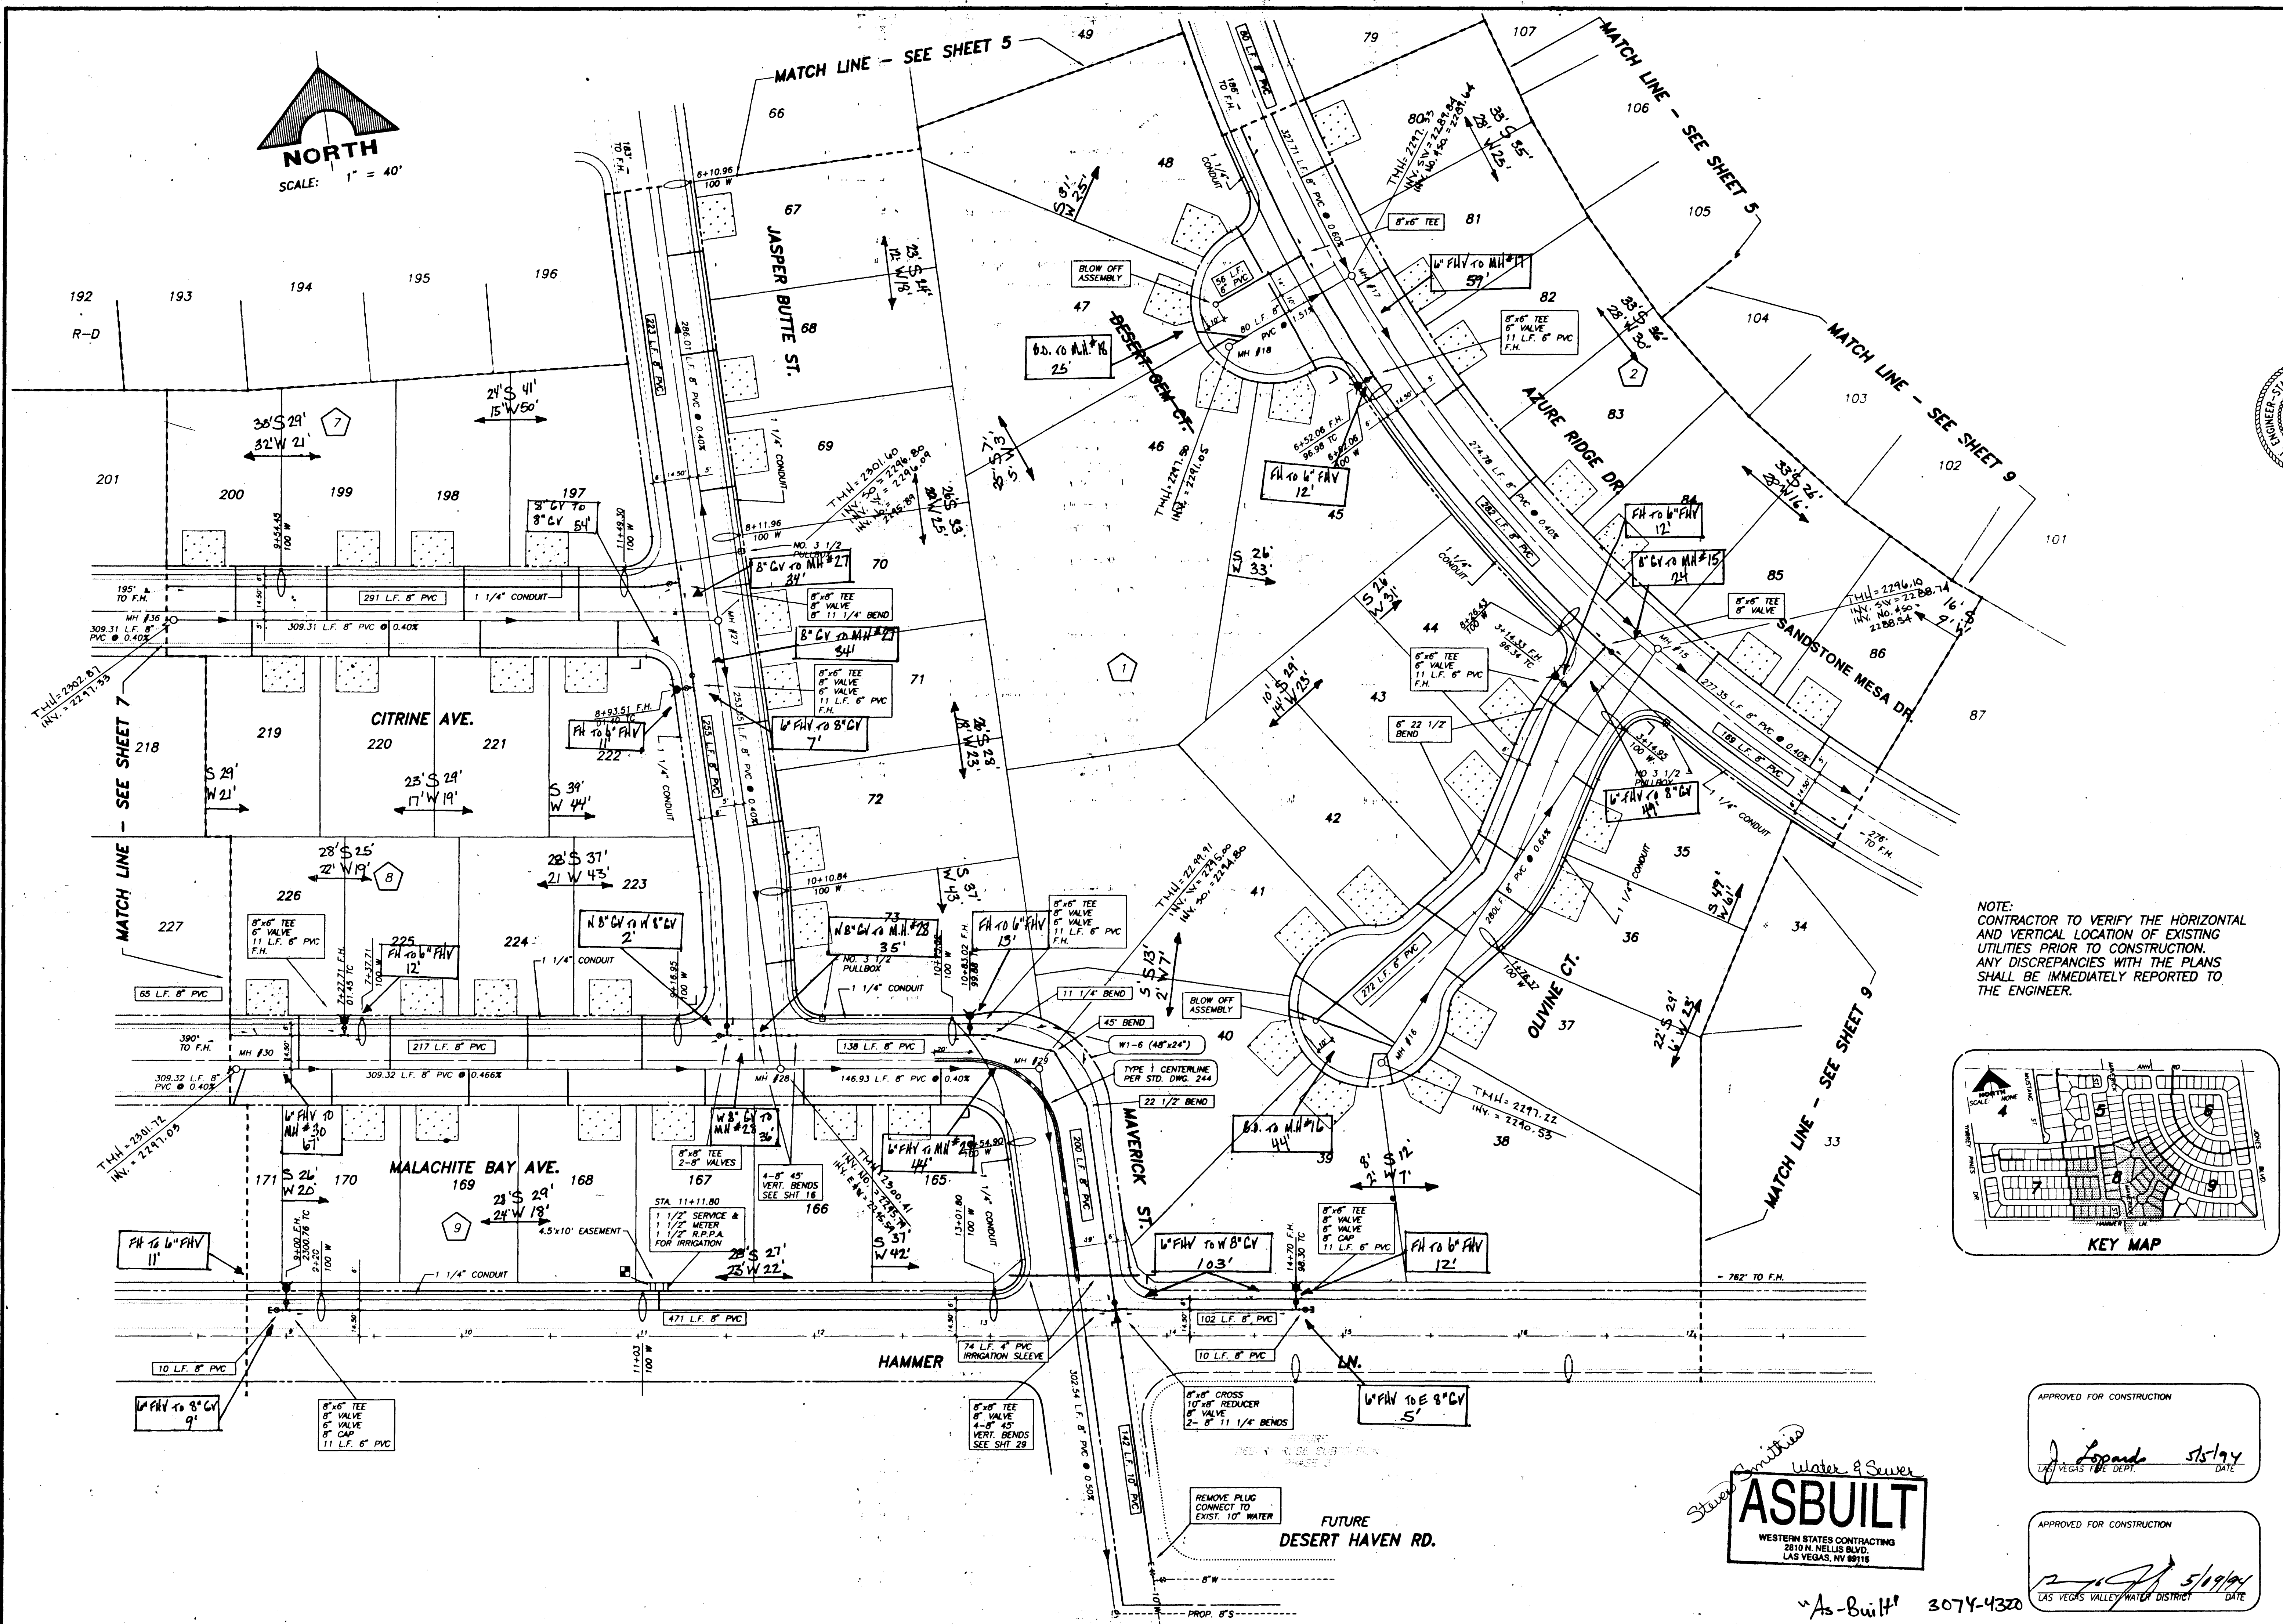

KEY MAP


APPROVED FOR CONSTRUCTION

[Signature] 5/19/94

LAS VEGAS VALLEY WATER DISTRICT DATE

"As-Built" 3074-4320

[illegible]

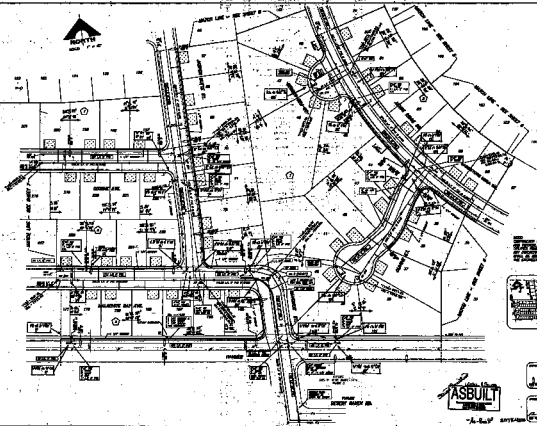

THIS
DRAWING IS NOT TO BE
USED FOR ANY OTHER
PURPOSE THAN THE
ONE FOR WHICH IT WAS
PREPARED.



ASBUILT
DRAWING

DATE OF REVISION
1-1-64

DATE OF REVISION
1-1-64

1-1-64