


MATCH LINE - SEE SHEET 5

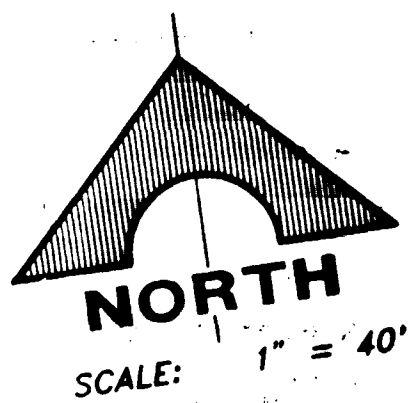


MATCH LINE - SEE SHEET 6

MATCH LINE - SEE SHEET 8

Water & Sewer
ASBUILT
WESTERN STATES CONTRACTING
2810 N. HELLER BLVD.
LAS VEGAS, NV 89116

NOTE:
CONTRACTOR TO VERIFY THE HORIZONTAL
AND VERTICAL LOCATION OF EXISTING
UTILITIES PRIOR TO CONSTRUCTION.
ANY DISCREPANCIES WITH THE PLANS
SHALL BE IMMEDIATELY REPORTED TO
THE ENGINEER.

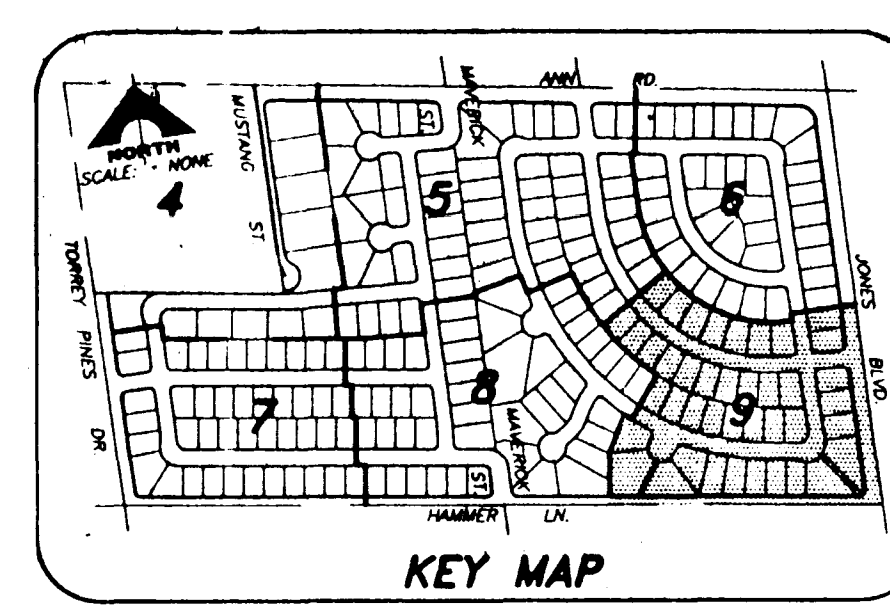

APPROVED FOR CONSTRUCTION
[Signature] 5/5/94
LAS VEGAS FIRE DEPT.

APPROVED FOR CONSTRUCTION
[Signature] 5/5/94
LAS VEGAS VALLEY WATER DISTRICT

DEL WEBB OF NEVADA, INC.

WALLACE, INC.
Engineering/Architecture

COPPER CREST
UTILITY PLAN VI

SHEET
9

As-Built 307Y-4320

JOB NO. 770.006 PLOTTED 05/01/94 3:44 pm DRAWING: C:\COPPER\UTILITY\CO-9 BY: sgc

17545

