


GENERAL NOTES

1. ALL STATIONING IS ALONG THE HORIZONTAL CENTERLINE OF THE NEW PIPELINE.
2. ALL PIPELINE ELEVATIONS ARE INVERT ELEVATIONS UNLESS SHOWN OTHERWISE.
3. PIPELINE SLOPES ARE CALCULATED FROM MANHOLE CENTERLINE. MANHOLE CHANNEL INVERTS SHALL BE TRANSITIONED TO MATCH.
4. UTILITY INVERTS SHOWN HAVE BEEN CALCULATED FROM CLOSEST MANHOLE AND SHALL BE VERIFIED BEFORE CONSTRUCTION.
5. ALL UNDERGROUND UTILITIES SHALL BE SUPPORTED IN ACCORDANCE WITH DETAIL C229/GC-3

SHEET NOTES

- ① CONTRACTOR SHALL KEEP EXISTING 8-INCH SANITARY SEWER AND ALL LATERALS AS WELL AS FREEDOM PARK IRRIGATION SYSTEM IN SERVICE DURING REPLACEMENT WITH 12-INCH SANITARY SEWER
- ② CONTRACTOR SHALL REPLACE ALL EXISTING MANHOLES WITH NEW 48" MANHOLES PER STANDARD DRAWING SD-1 (STANDARD ECCENTRIC MANHOLE)
- ③ PROVIDE INNER MANHOLE LID SOUTHWESTERN PACKING "RAINSTOPPER" INSERT OR EQUAL (TYPICAL MH NO.2 THROUGH MH NO. 6 MANHOLES IN PARK)

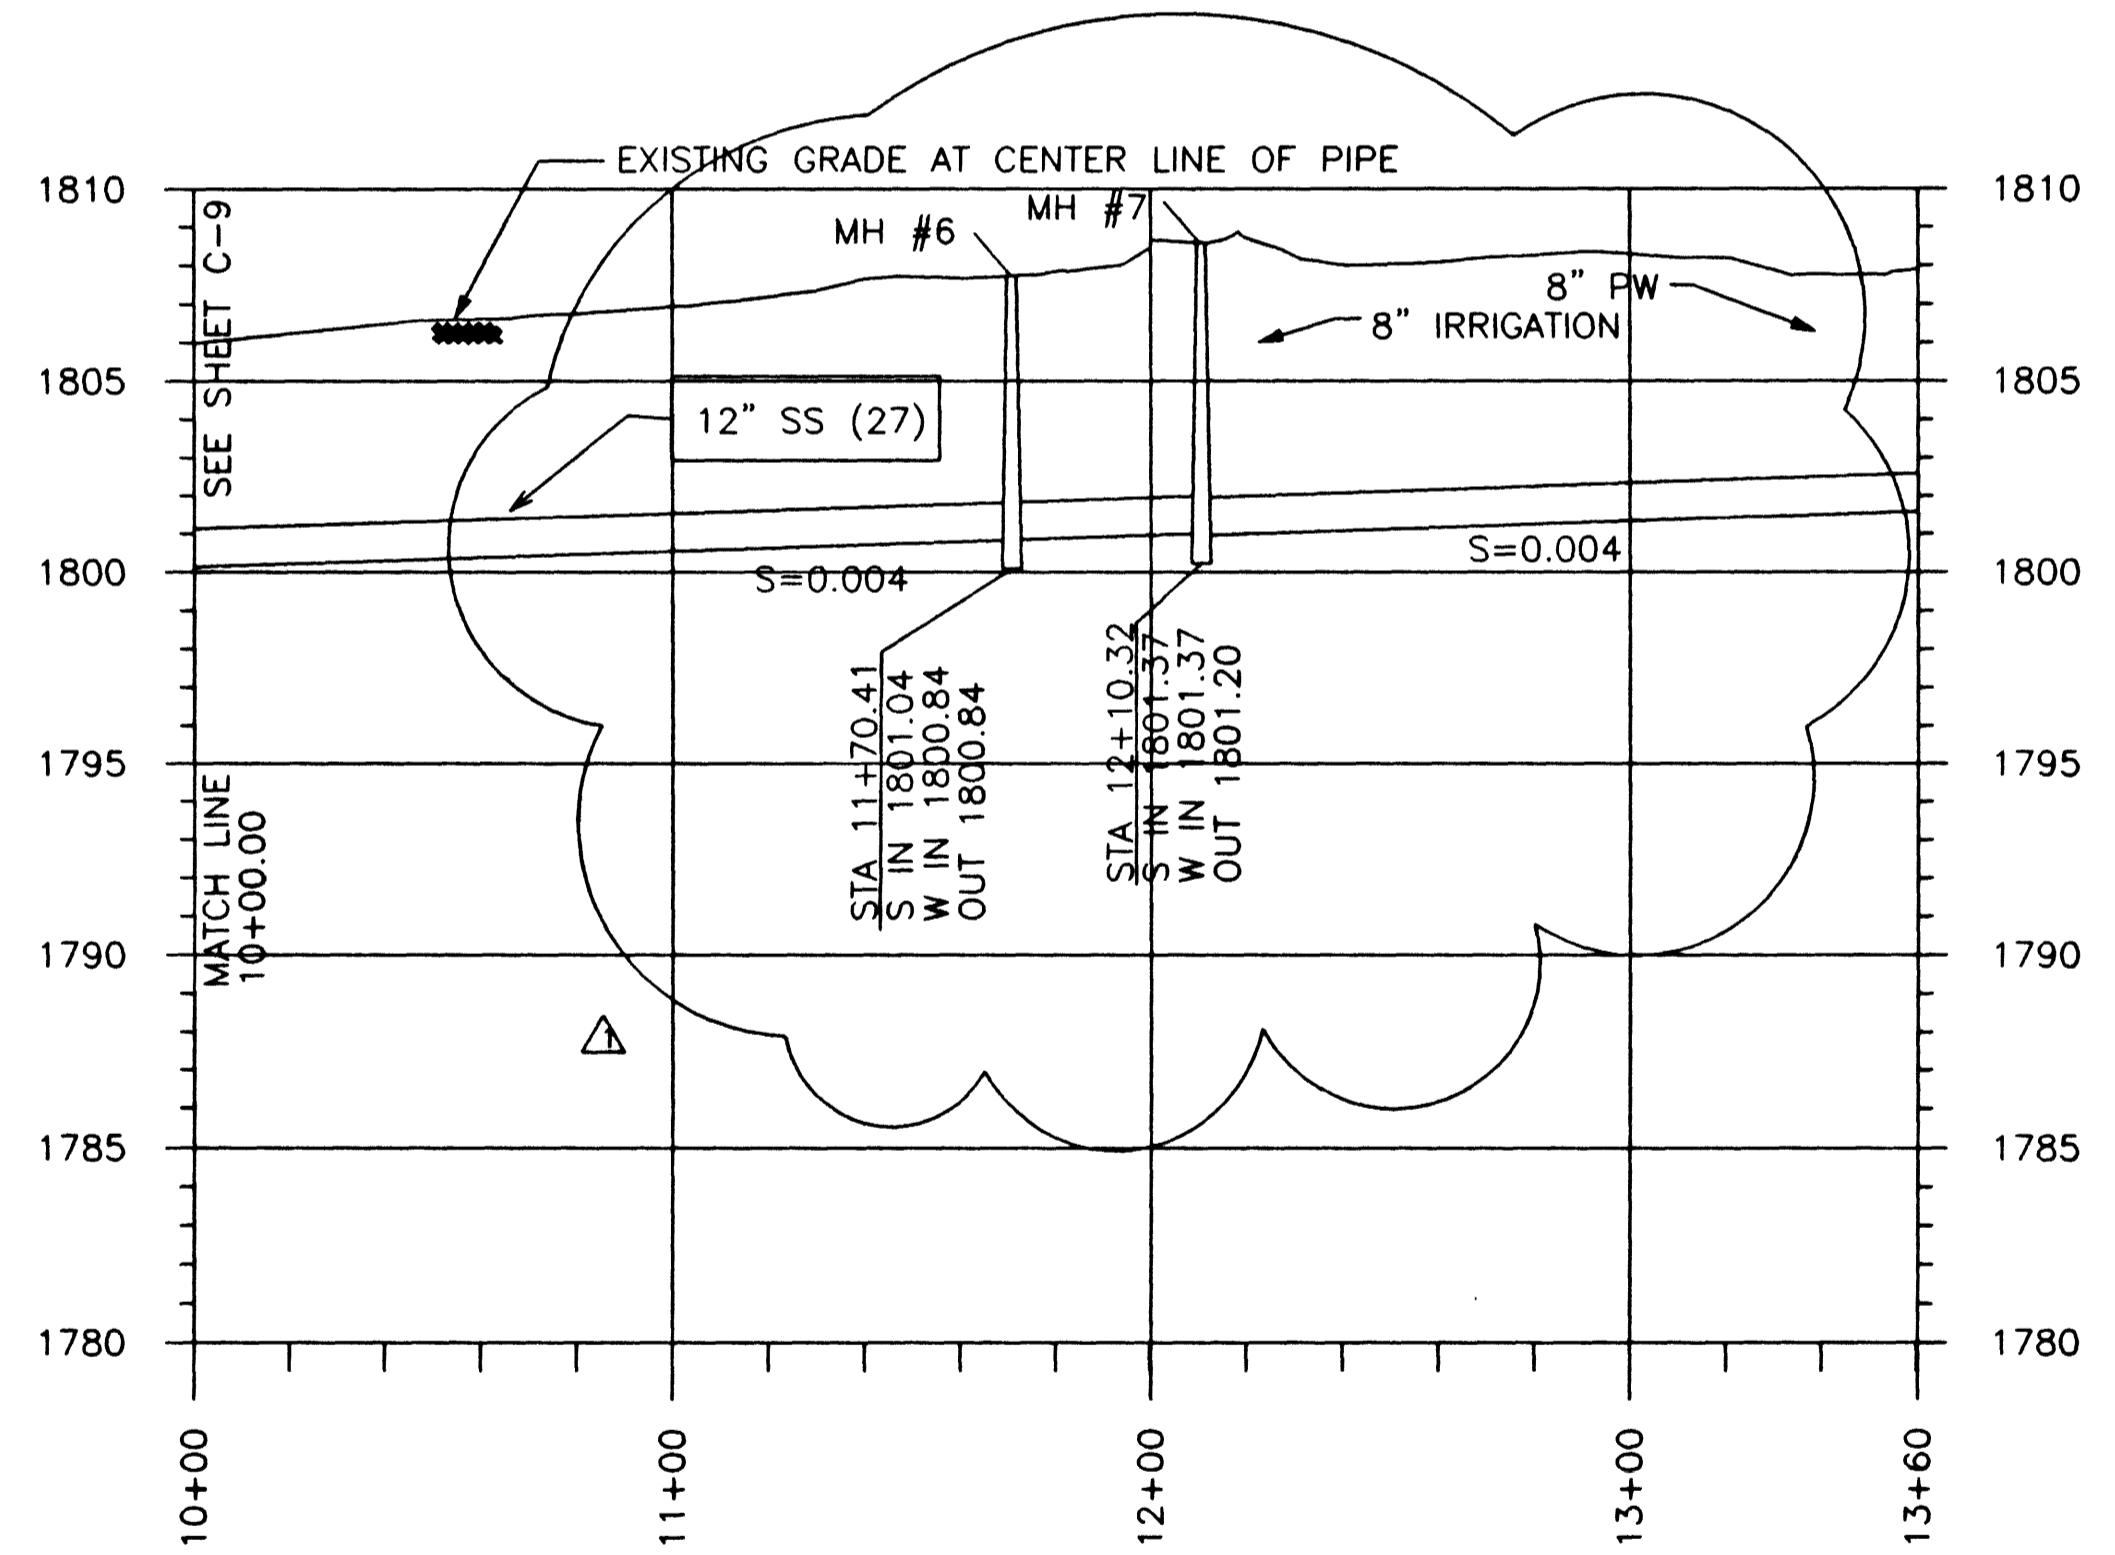

DATE/TIME 11/9/98 10:00 AM

FILE No. 1540_0131

AS BUILT
DATE
9 APR 99

Call before you Dig
1-800-227-2600

THE ORIGINAL CONTRACT DOCUMENT WAS SEALED AND SIGNED BY BEN EMERSON

SCALE: HORIZ: 1"=40' VERT: 1"=5' WARNING: IF THIS BAR DOES NOT MEASURE 1" THEN DRAWING IS NOT TO SCALE.		DESIGNED: S. McCLELLAND DRAWN: S. McCLELLAND CHECKED: B. EMERSON	SUBMITTED THE ORIGINAL CONTRACT DOCUMENT WAS SIGNED BY BEN EMERSON PROJECT ENGINEER: R. C. E. NO. DATE RECOMMENDED THE ORIGINAL CONTRACT DOCUMENT WAS SIGNED BY VICKI J. SCARNHORST MONTGOMERY WATSON R. C. E. NO. DATE	MONTGOMERY WATSON Las Vegas, Nevada	MONTGOMERY WATSON 3014 WEST CHARLESTON BLVD LAS VEGAS, NV. 89102-1944 (702) 878-8010	CITY OF LAS VEGAS BONANZA/MOJAVE WATER RESOURCE CENTER	DWG. C-10 24
REV 11/98 DATE BY DESCRIPTION	FREEDOM PARK SEWER OUTFALL STA 10+00 TO STA 13+60.32 513-64						

26269 26268