
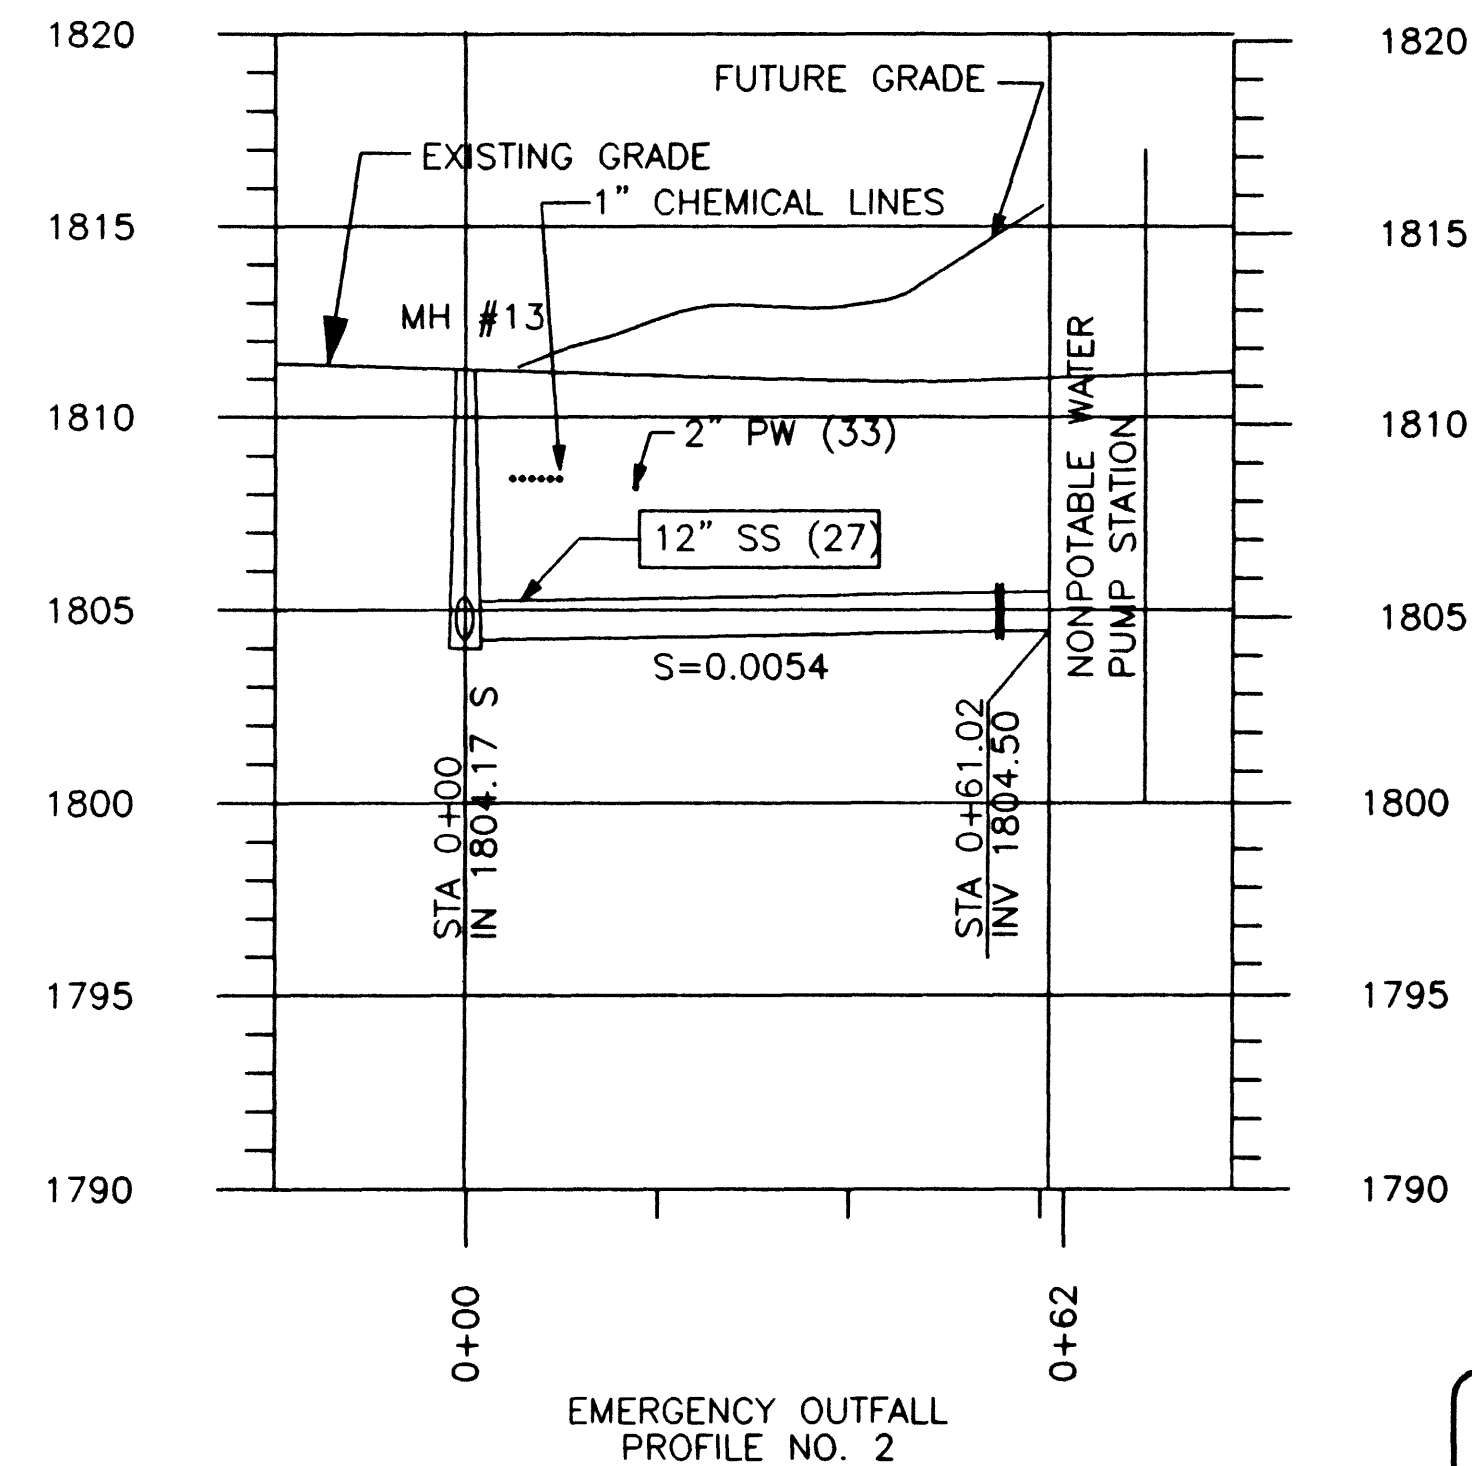
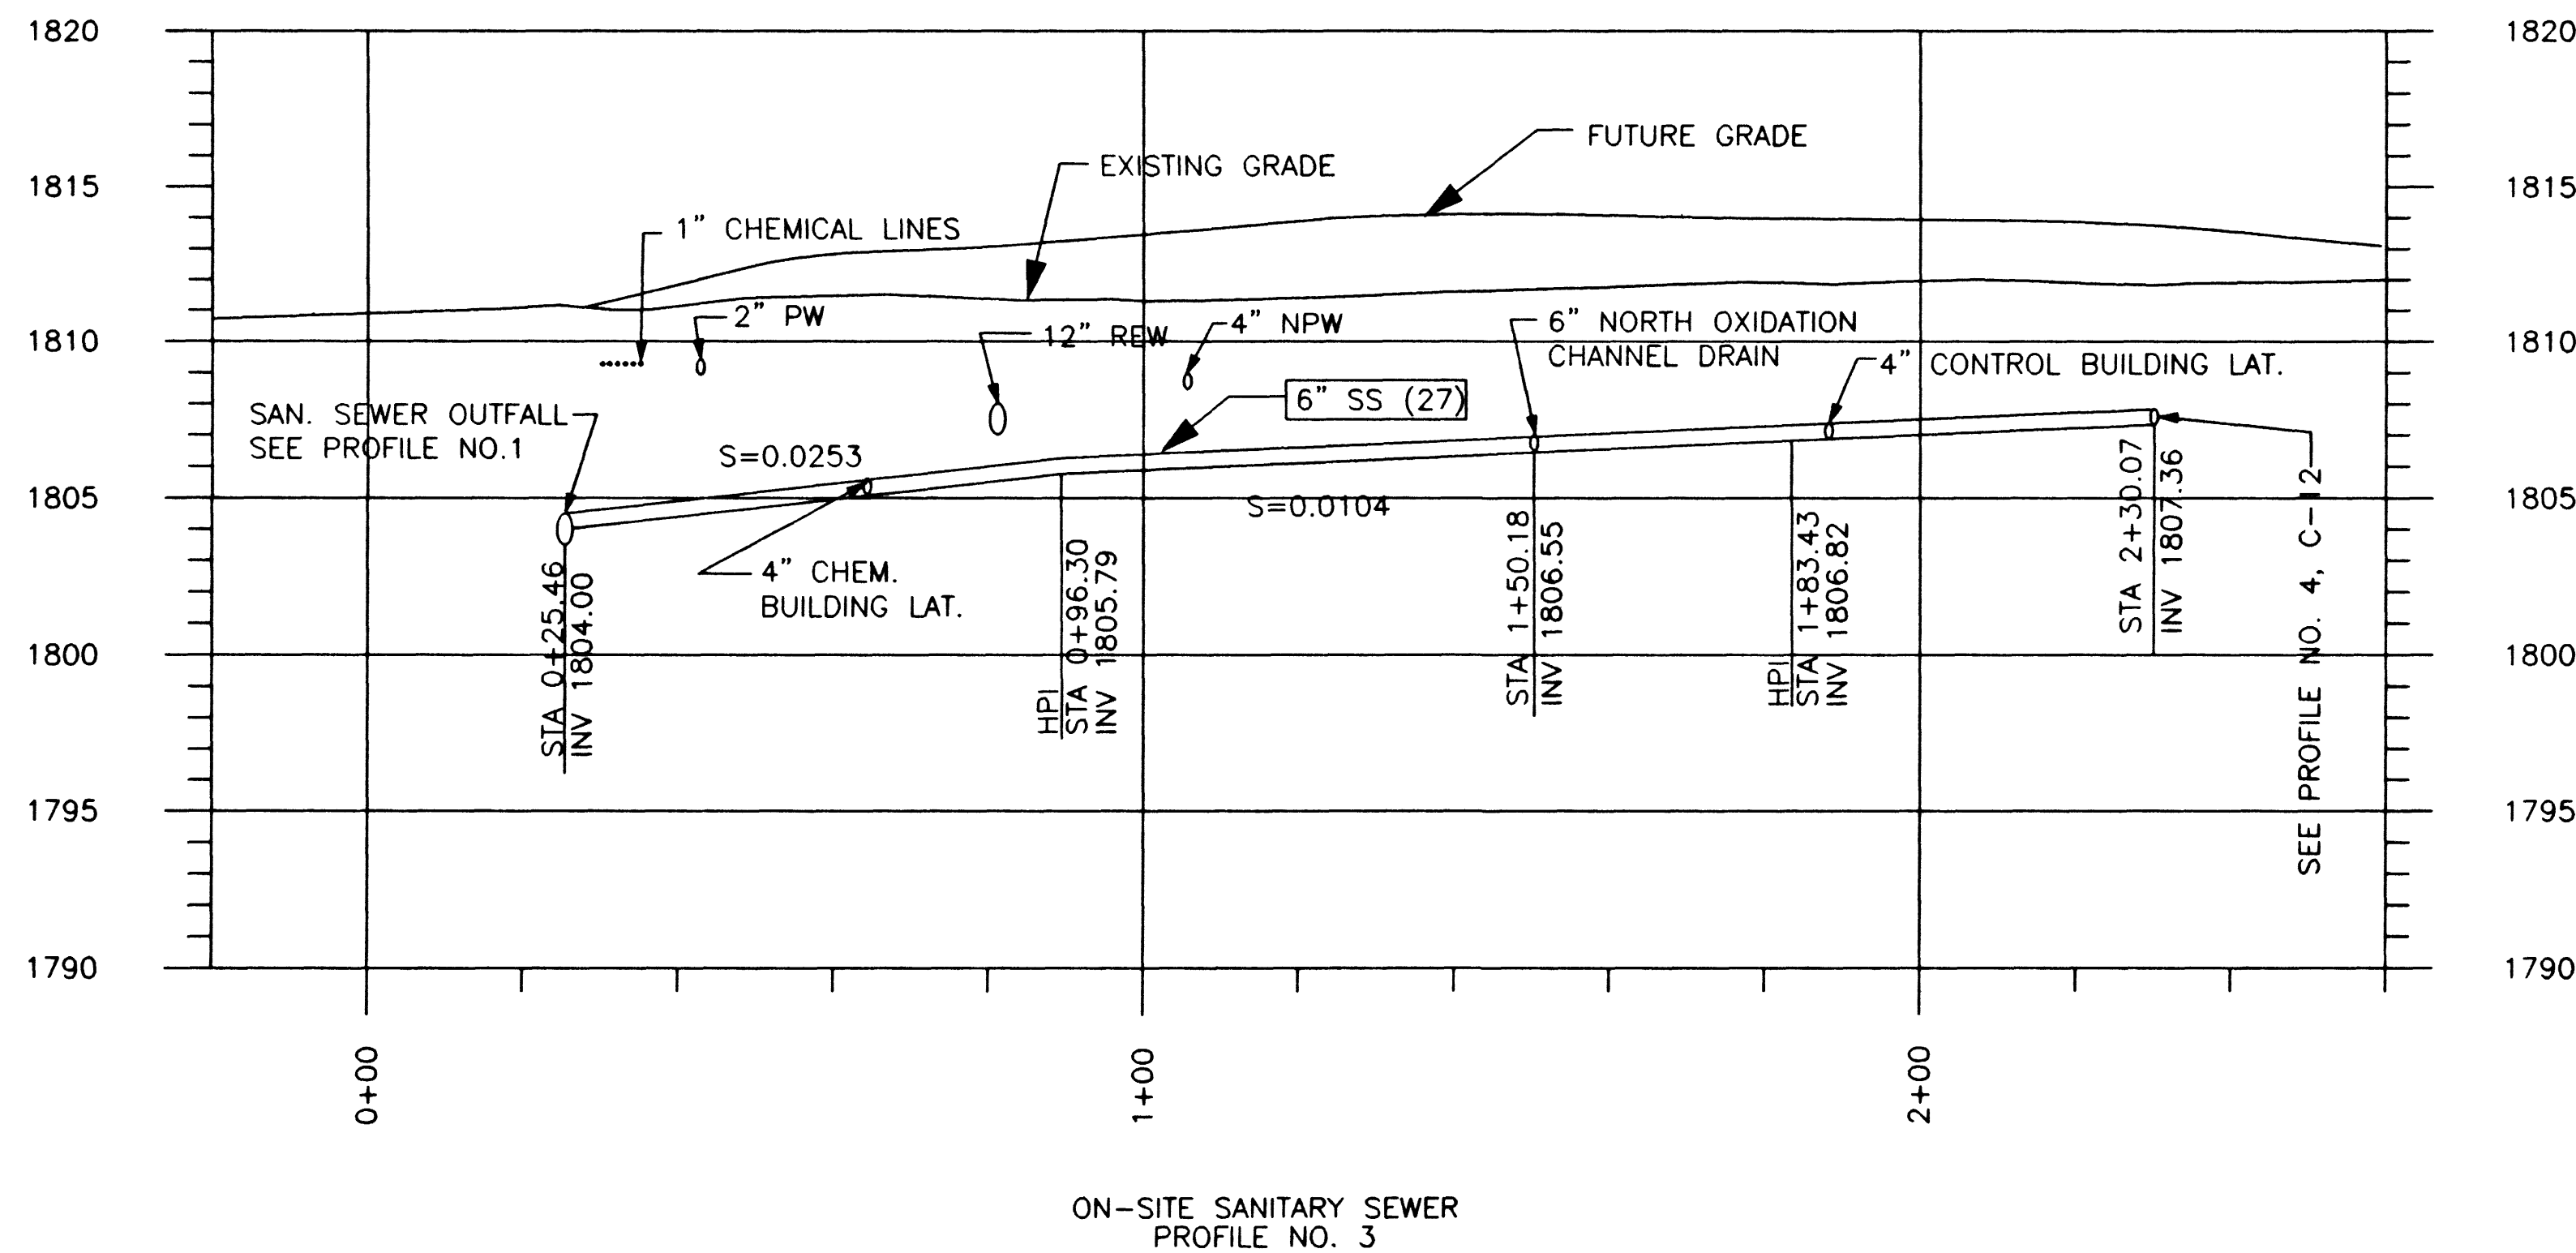


DATE/TIME 11/11/99 11:11:11

JOB No. 1540.0131 FILE No. 11/11/99 11:11:11

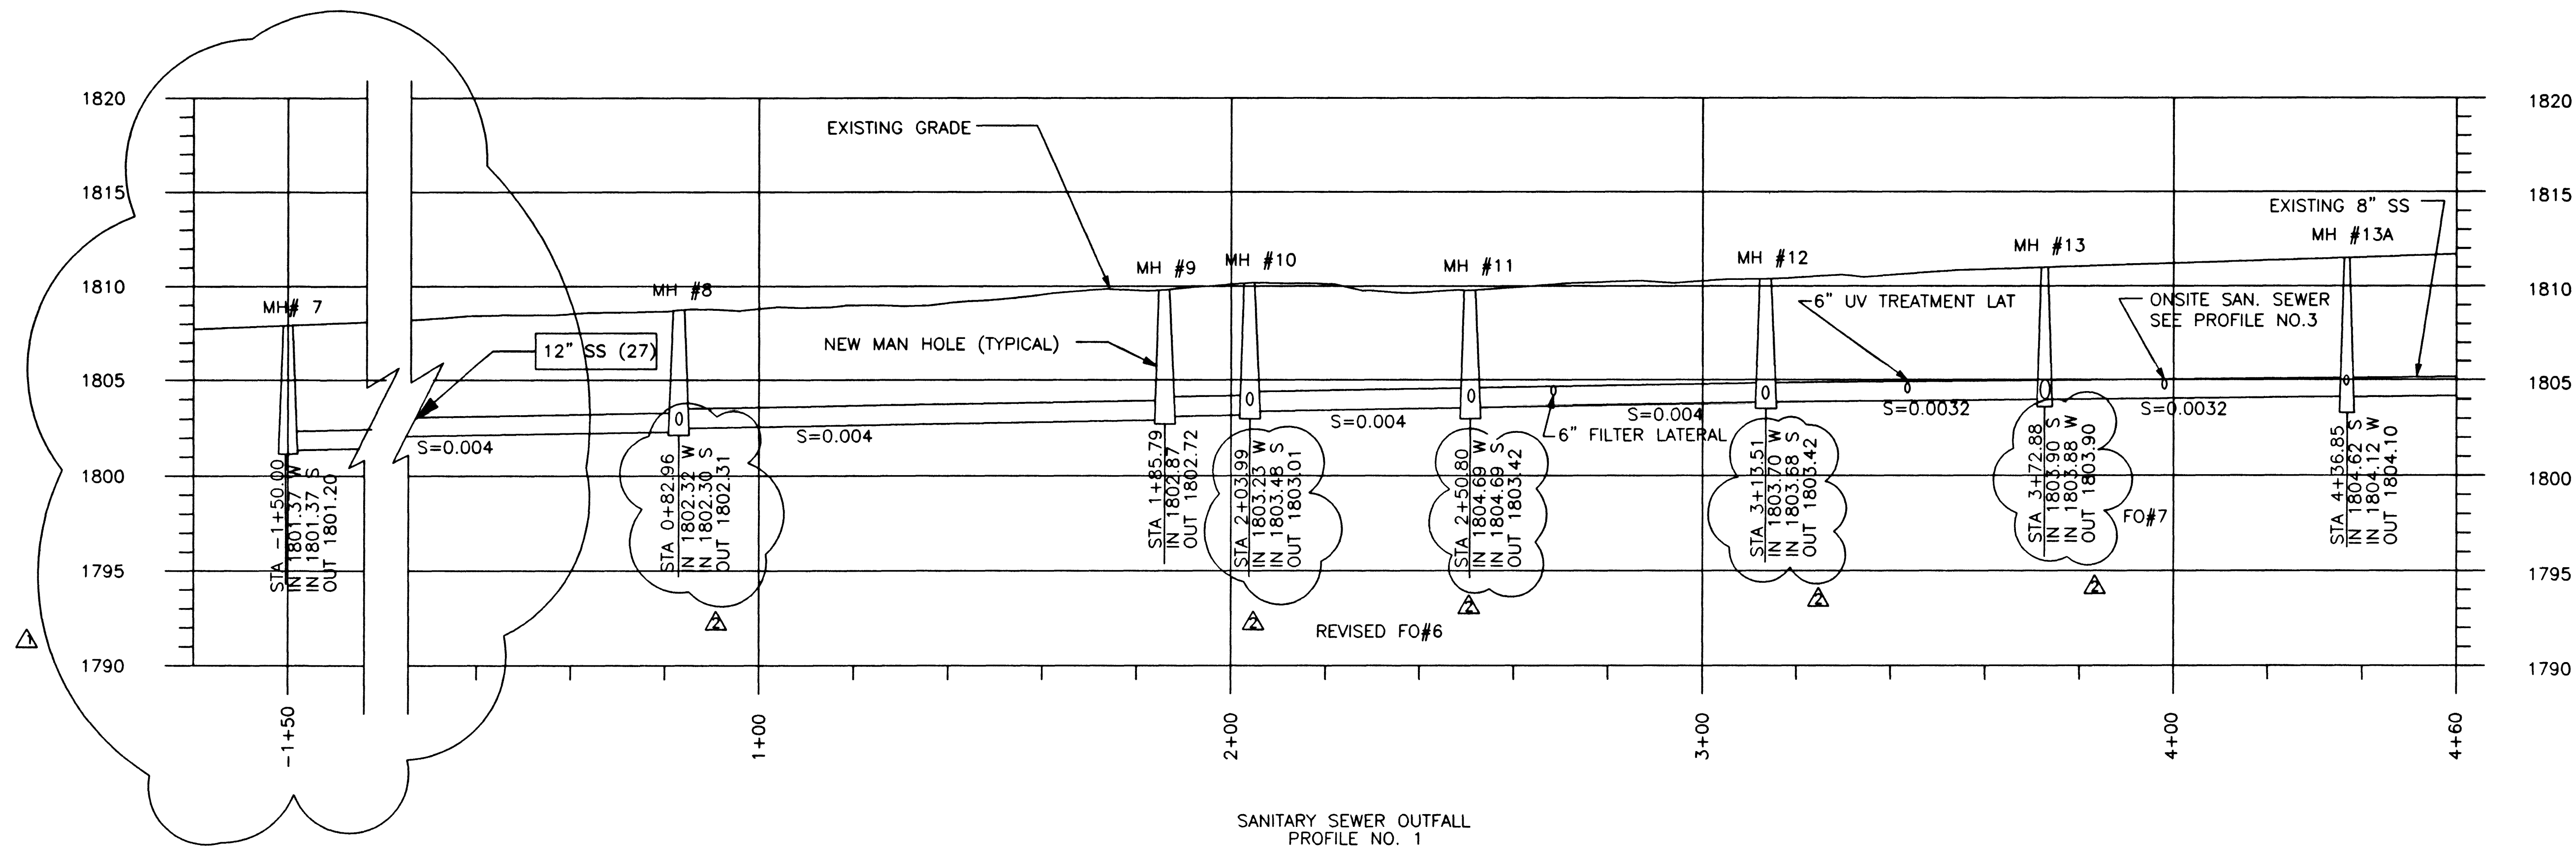


| REV      | DATE | BY   | DESCRIPTION       |
|----------|------|------|-------------------|
| 11/11/99 |      | SBWM | REVISED ALIGNMENT |

SCALE:  
HORIZ 1"=20'  
VERT 1"=5'

WARNING  
0 1/2 1  
IF THIS BAR DOES NOT MEASURE 1" THEN DRAWING IS NOT TO SCALE.

DESIGNED S. McCLELLAND  
DRAWN S. McCLELLAND  
CHECKED B. EMERSON

SUBMITTED  
THE ORIGINAL CONTRACT DOCUMENT WAS SIGNED BY BEN EMERSON  
PROJECT ENGINEER R. C. E. NO. DATE  
RECOMMENDED  
THE ORIGINAL CONTRACT DOCUMENT WAS SIGNED BY VICKI J. SCARNHORST  
MONTGOMERY WATSON R. C. E. NO. DATE

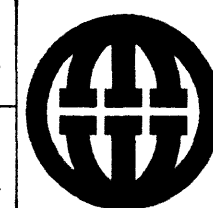

**MONTGOMERY WATSON**  
Las Vegas, Nevada

MONTGOMERY WATSON  
3014 WEST CHARLESTON BLVD  
LAS VEGAS, NV. 89102-1944  
(702) 878-8010  
COPYRIGHT © 1997 BY MONTGOMERY WATSON  
ALL RIGHTS RESERVED

CITY OF LAS VEGAS  
BONANZA/MOJAVE WATER RESOURCE CENTER  
YARD PIPING PROFILES - 1

AS BUILT  
DATE 9 APR 99

ABREGO

Call before you Dig  
1-800-227-2600

PROFESSIONAL ENGINEER  
BEN EMERSON  
CIVIL  
No. 9422

DWG. C-11  
513-64