



DATE/TIME \$\$\$date\$\$\$time\$\$\$


JOB No. 1540.0131 FILE No. \$\$\$filename\$\$\$

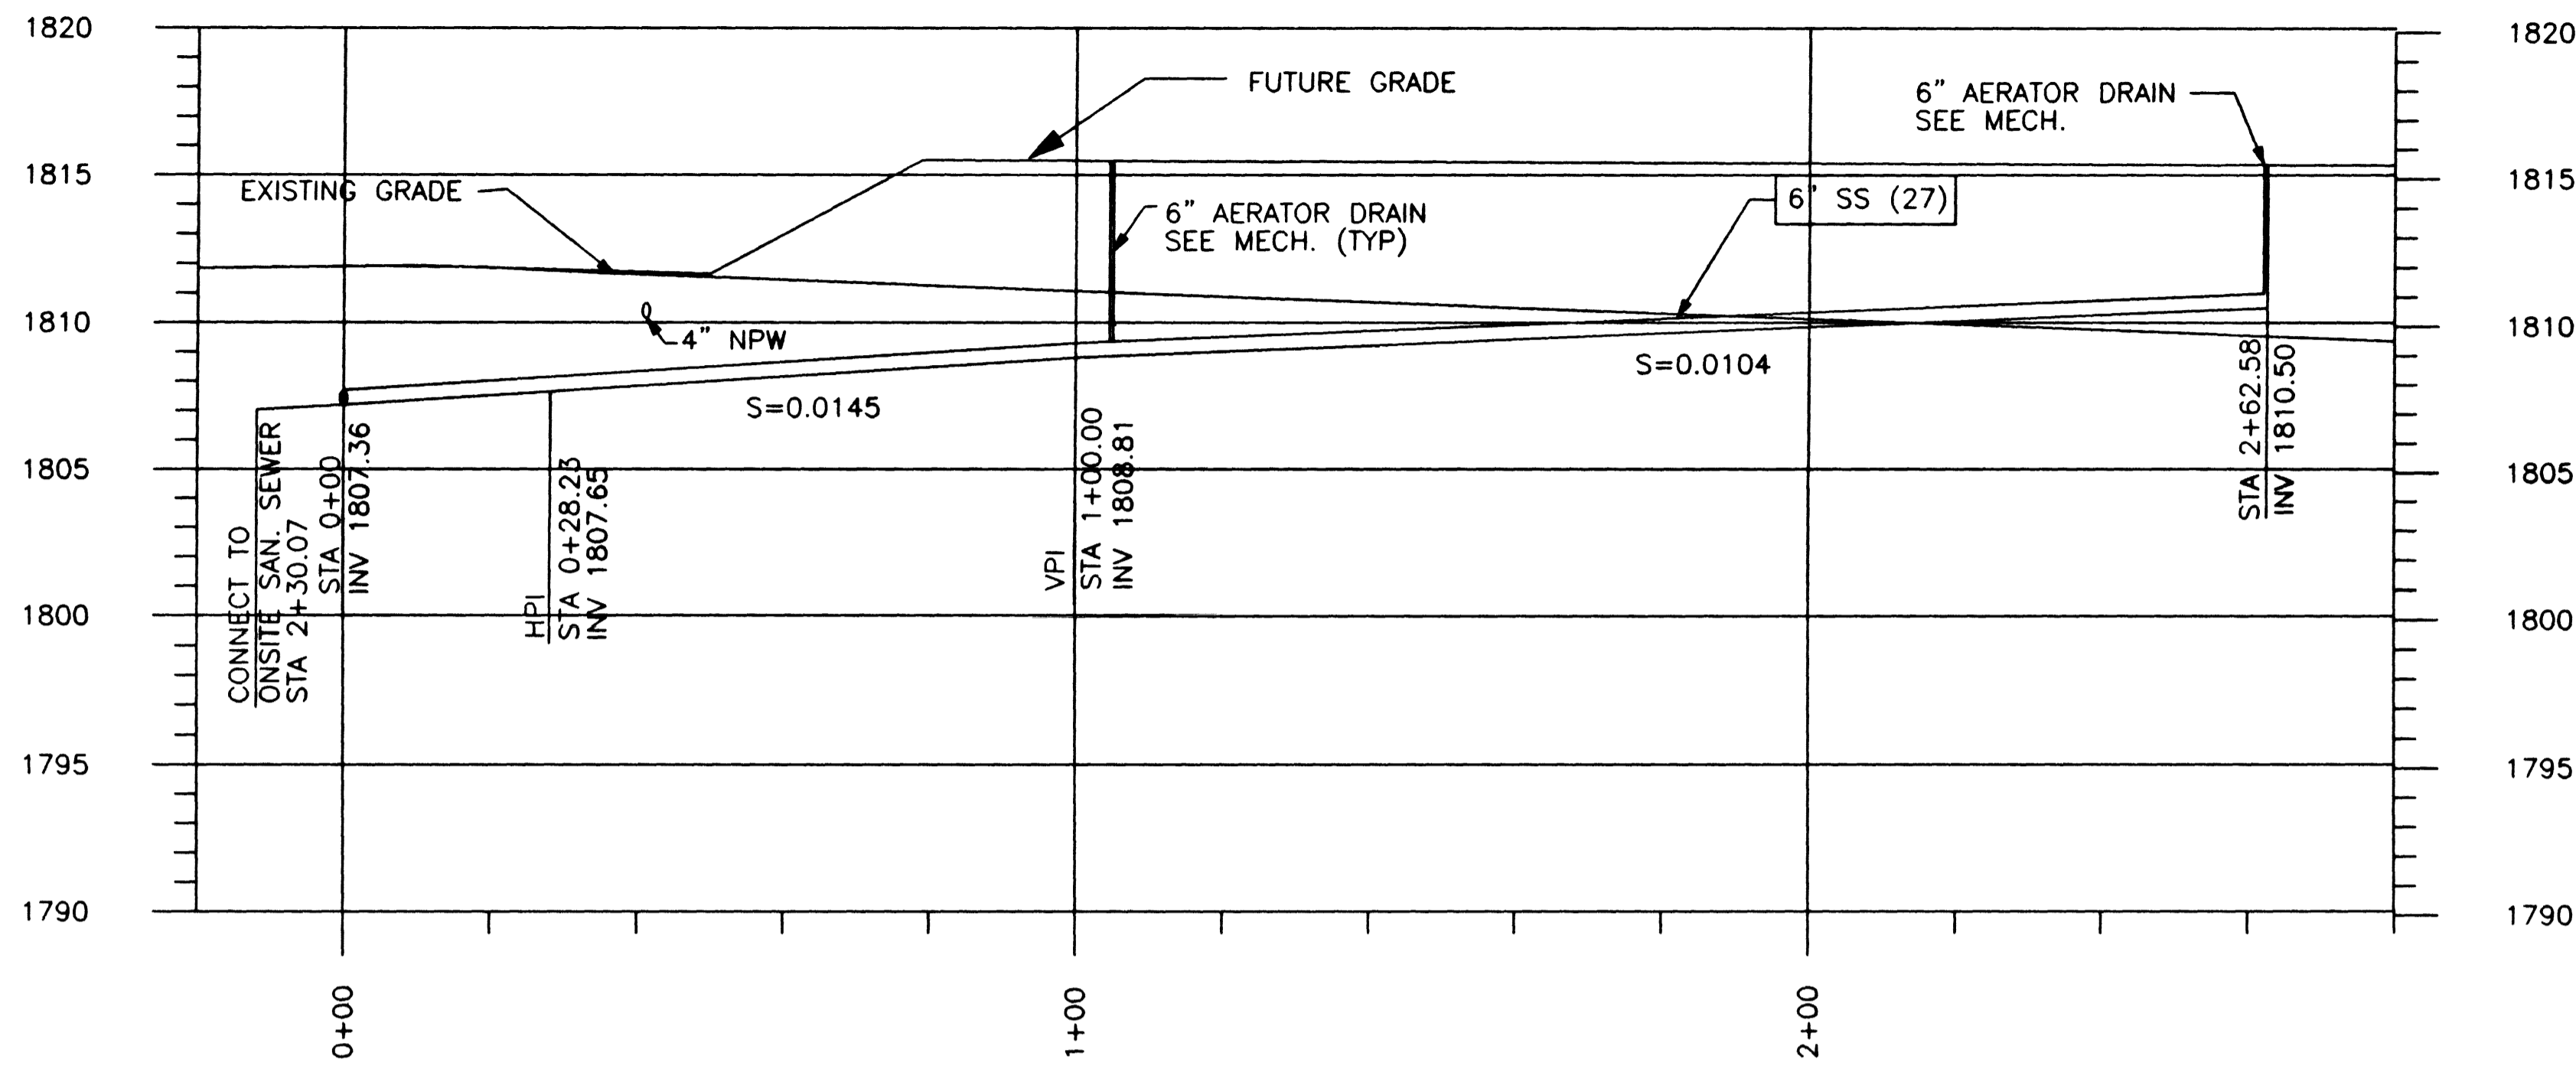


OXIDATION CHANNEL DRAIN SOUTH
PROFILE NO. 4

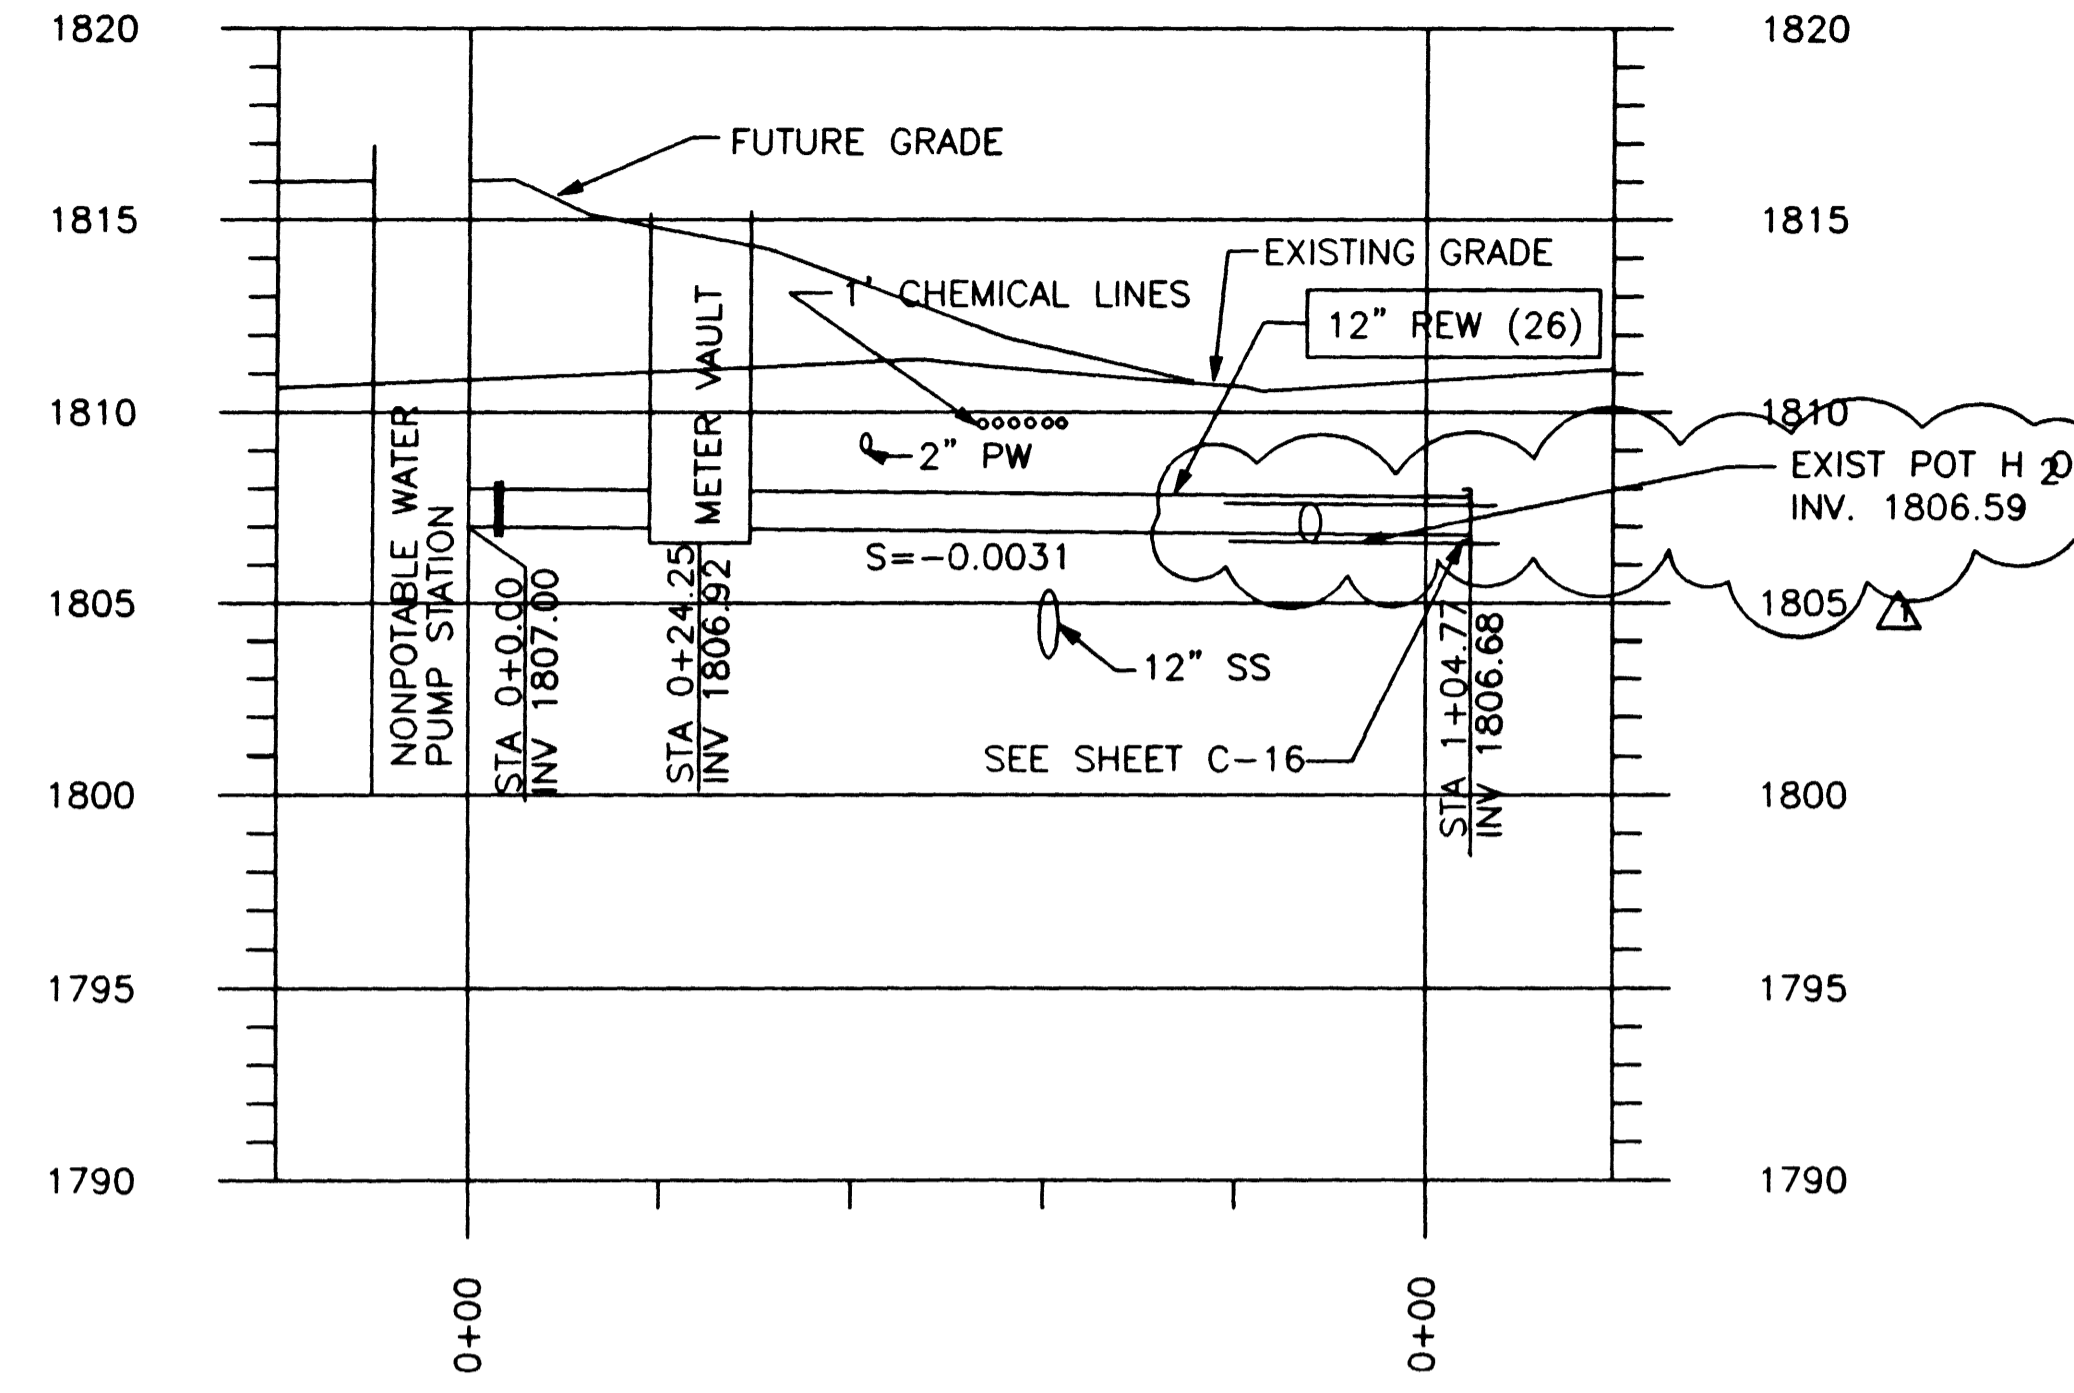


FREEDOM PARK RECLAIMED WATER LINE
PROFILE NO. 8

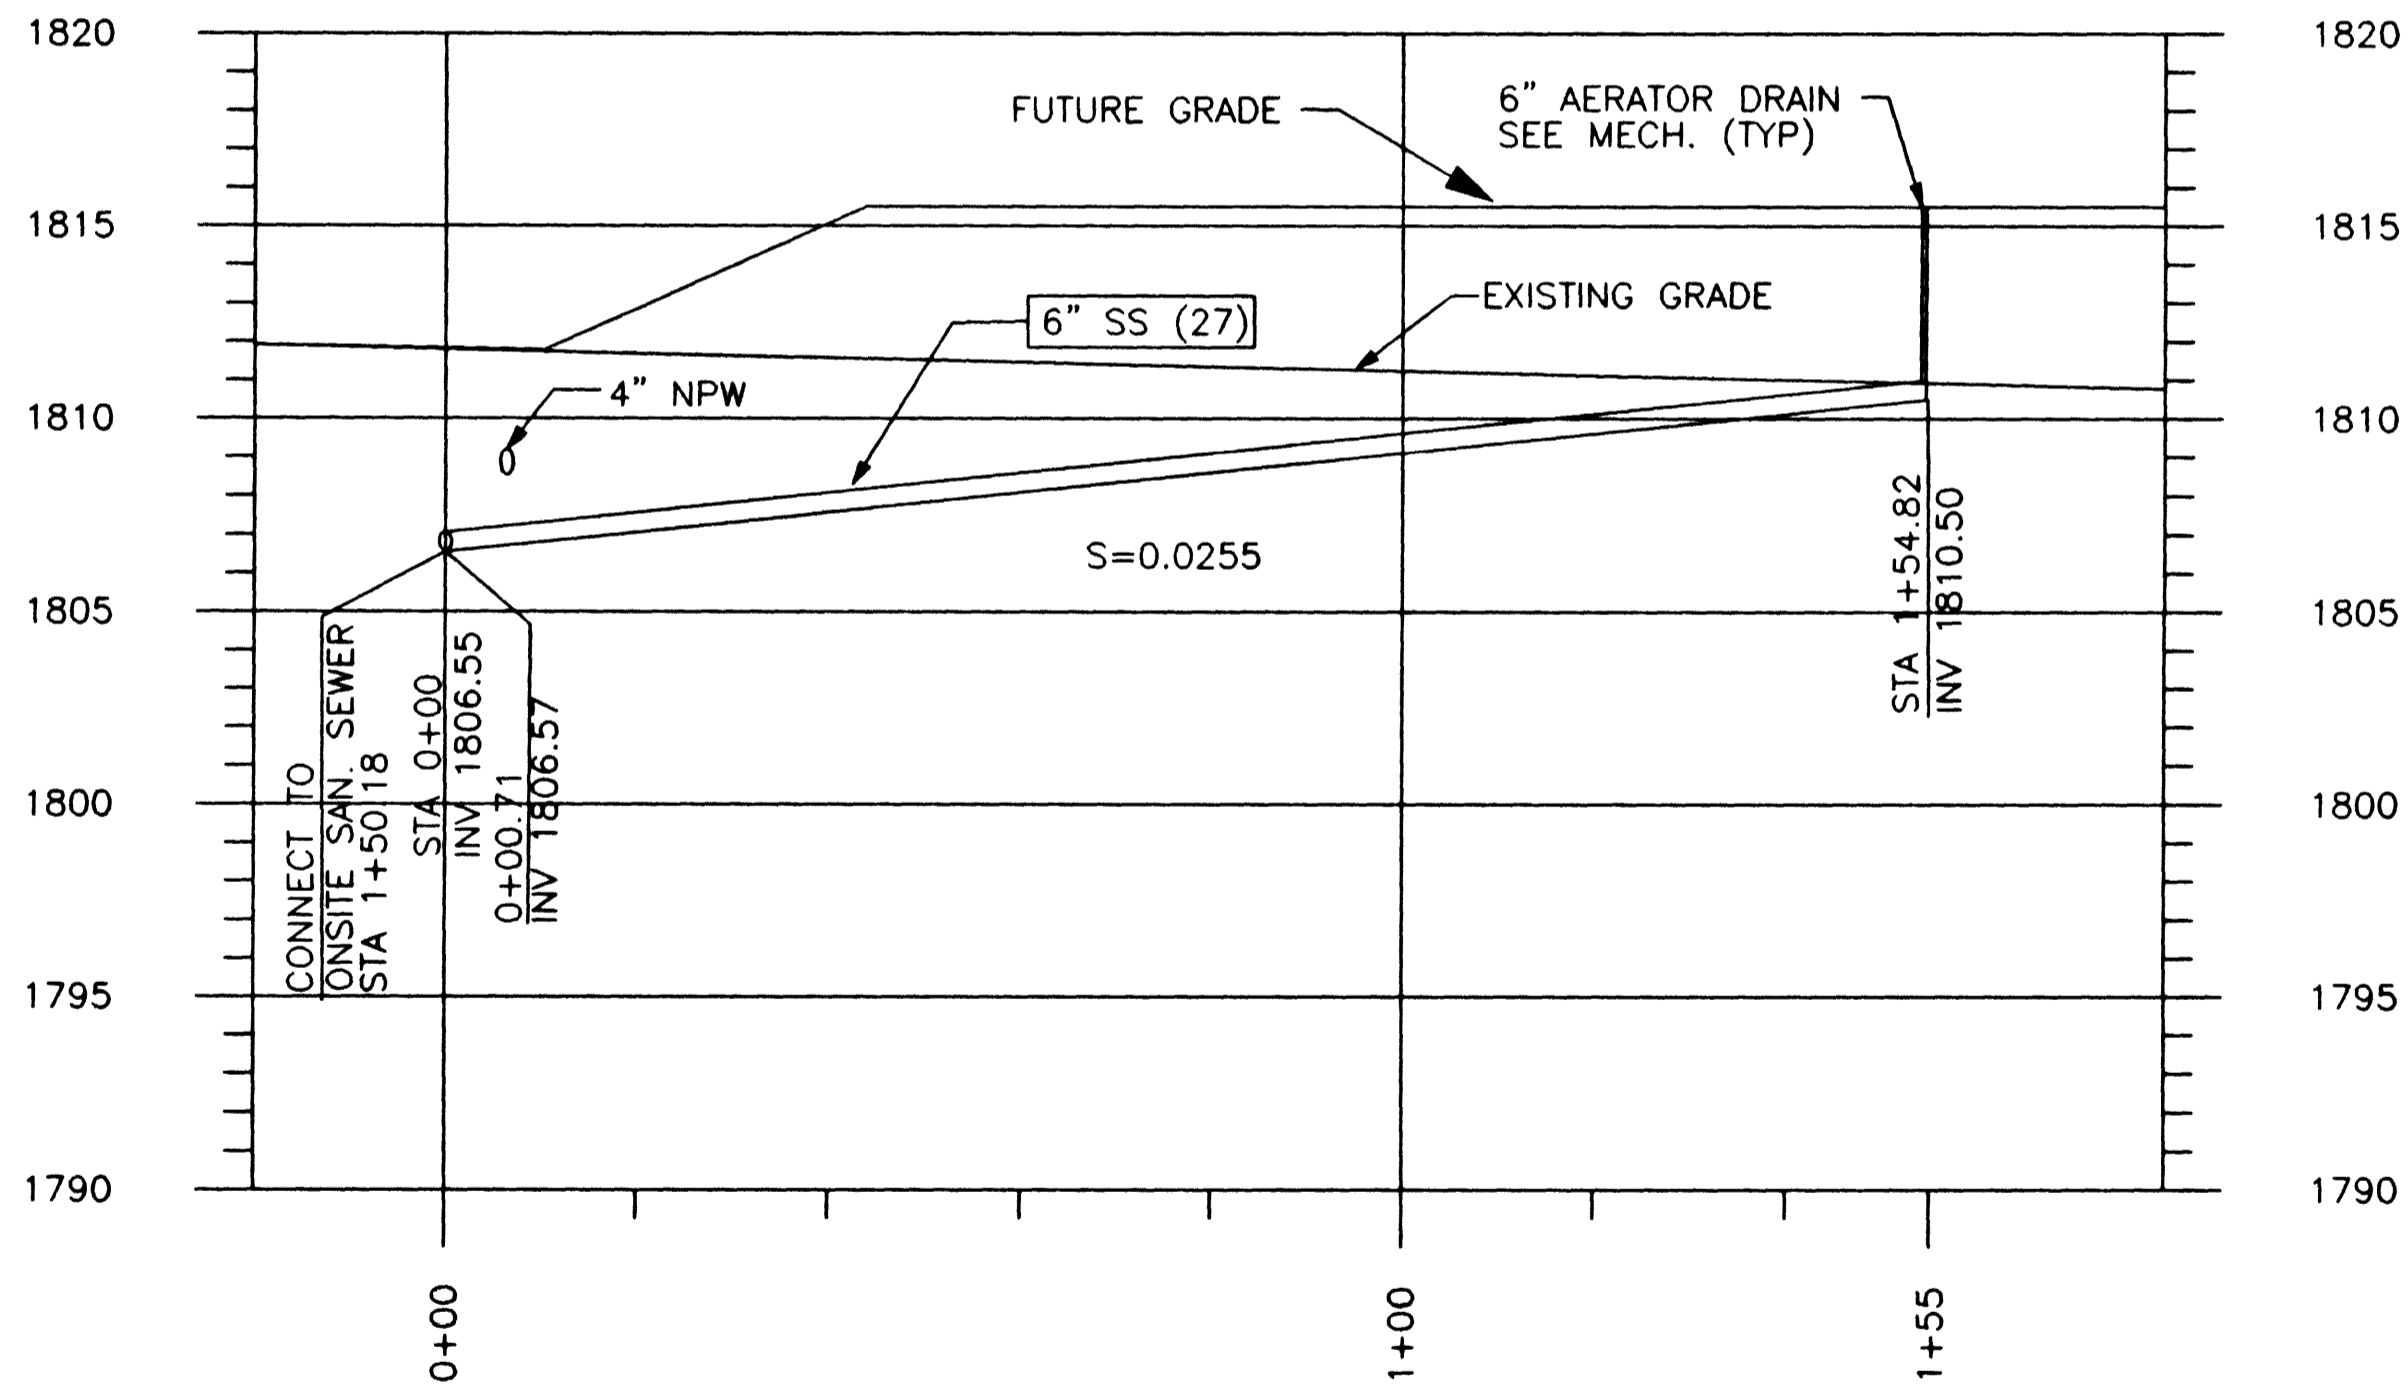

OXIDATION CHANNEL DRAIN NORTH
PROFILE NO. 6

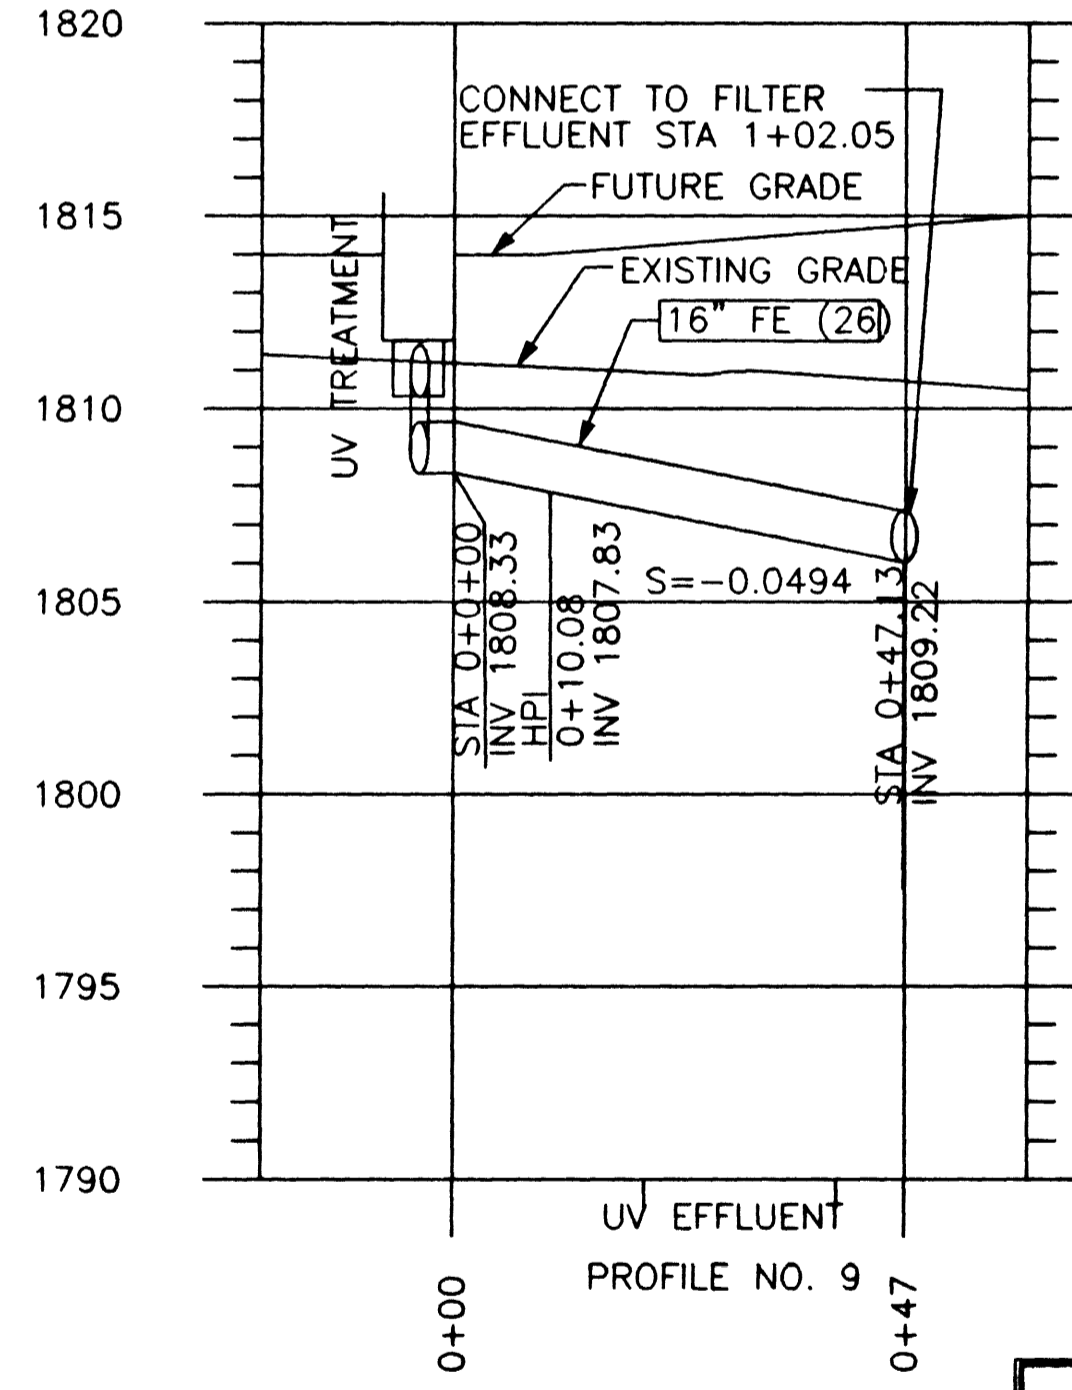

UV EFFLUENT
PROFILE NO. 9

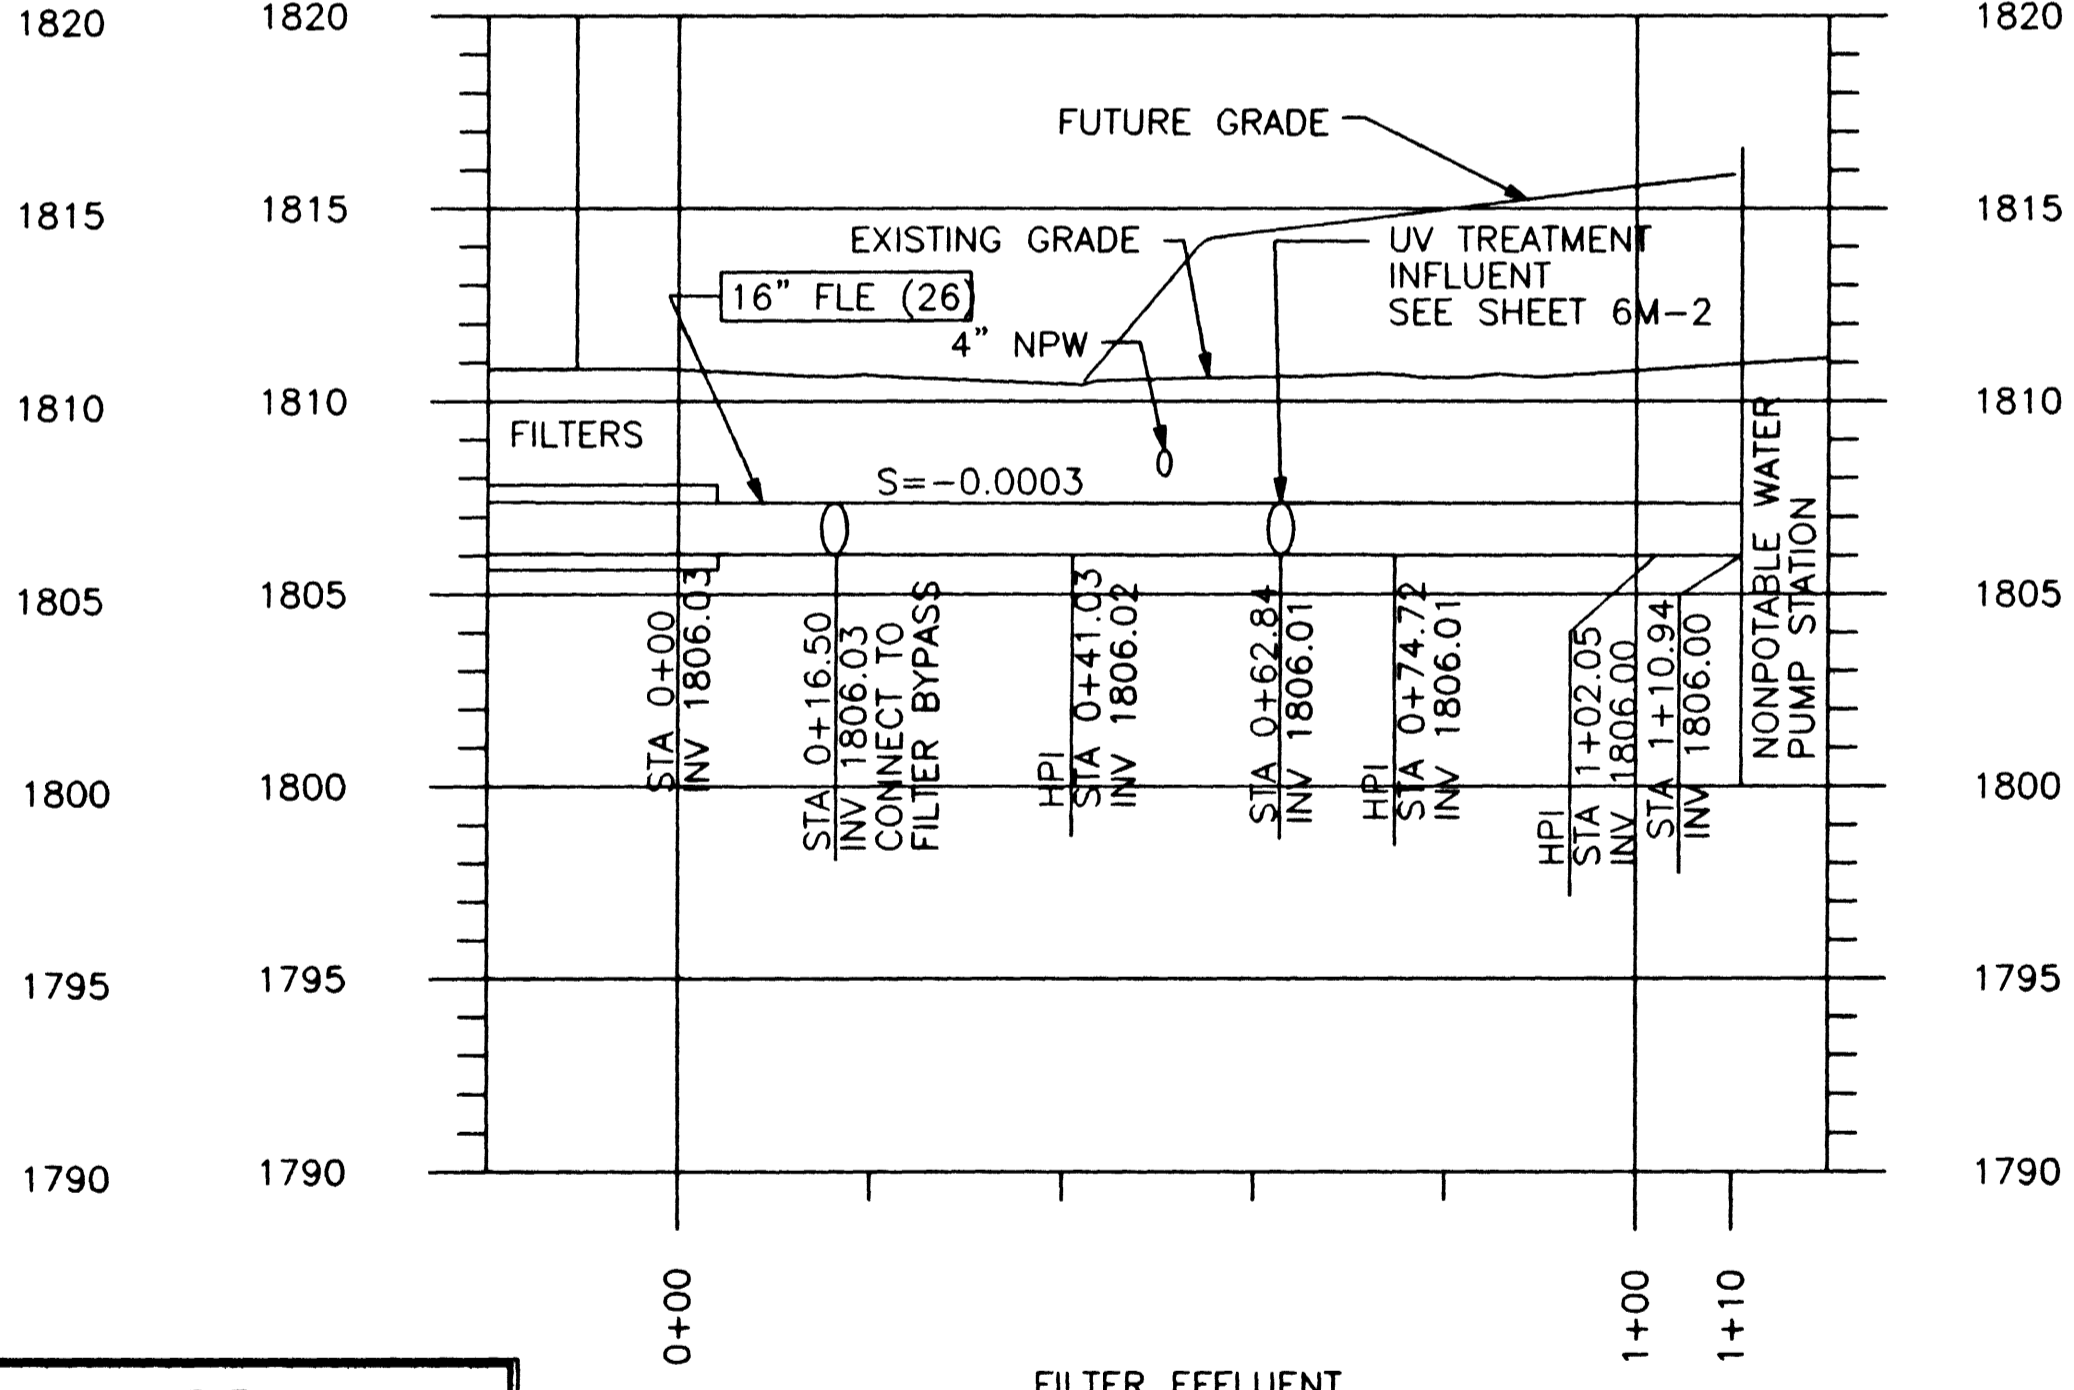


FILTER EFFLUENT
PROFILE NO. 10

AS BUILT
DATE
9 APR 99

THE ORIGINAL CONTRACT DOCUMENT WAS
SEALED AND SIGNED BY BEN EMERSON

Call before you Dig.
1-800-227-2600

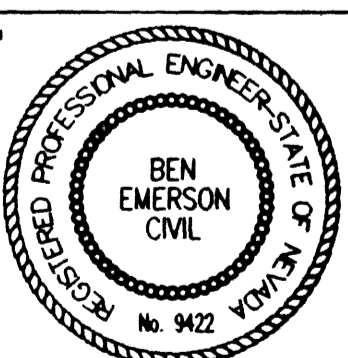

REV	DATE	BY	DESCRIPTION

SCALE:
HORZ 1"=20'
VERT 1"=5'

WARNING
IF THIS BAR DOES NOT MEASURE 1" THEN DRAWING IS NOT TO SCALE.

DESIGNED S. McCLELLAND
DRAWN S. McCLELLAND
CHECKED B. EMERSON

SUBMITTED THE ORIGINAL CONTRACT DOCUMENT WAS SIGNED BY BEN EMERSON
PROJECT ENGINEER R. C. E. NO. DATE
RECOMMENDED THE ORIGINAL CONTRACT DOCUMENT WAS SIGNED BY VICKI J. SCARPHORST
MONTGOMERY WATSON R. C. E. NO. DATE



MONTGOMERY WATSON
Las Vegas, Nevada

MONTGOMERY WATSON
3014 WEST CHARLESTON BLVD
LAS VEGAS, NV 89102-1944
(702) 878-8010
COPYRIGHT © 1997 BY MONTGOMERY WATSON
ALL RIGHTS RESERVED

CITY OF LAS VEGAS
BONANZA/MOJAVE WATER RESOURCE CENTER
YARD PIPING PROFILES - 2

DWG. C-12
513-64

2026 20270