



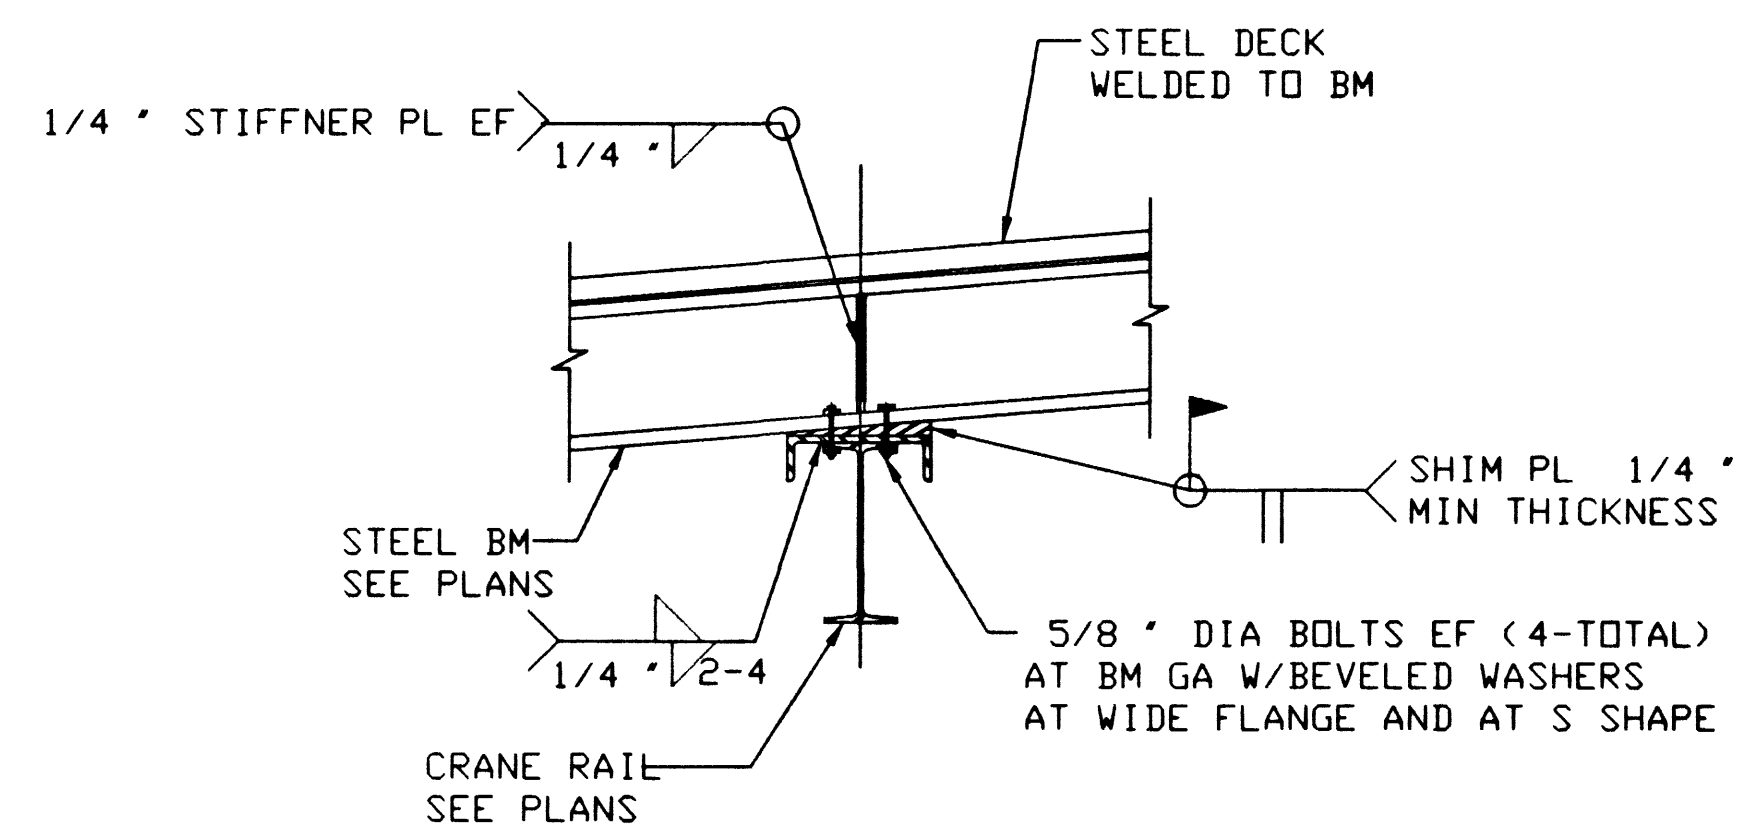

JOB No. _____ FILE No: \proj\lvwrf\str\bm0*sw.dgn

				SCALE:	WARNING 01/21	DESIGNED	SUBMITTED THE ORIGINAL CONTRACT DOCUMENT WAS SIGNED BY SAM MOUAWAD		 MONTGOMERY WATSON Las Vegas, Nevada	MONTGOMERY WATSON 3014 WEST CHARLESTON BLVD LAS VEGAS, NV. 89102-1944 (702) 878-8010	CITY OF LAS VEGAS BONANZA/MOJAVE WATER RESOURCE CENTER	DWG. 63
				IF THIS BAR DOES NOT MEASURE 1" THEN DRAWING IS NOT TO SCALE.	DRAWN	PROJECT ENGINEER R. C. E. NO. DATE		RECOMMENDED THE ORIGINAL CONTRACT DOCUMENT WAS SIGNED BY VICKI J. SCHARNHORST		COPYRIGHT © 1996 BY MONTGOMERY WATSON ALL RIGHTS RESERVED	CONTROL BUILDING SECTION AND DETAILS	8S-3
REV	DATE	BY	DESCRIPTION	CHECKED C. LEE			MONTGOMERY WATSON R. C. E. NO. DATE					513-64

THE ORIGINAL CONTRACT DOCUMENT WAS
SEALED AND SIGNED BY SAM MOUAWAD

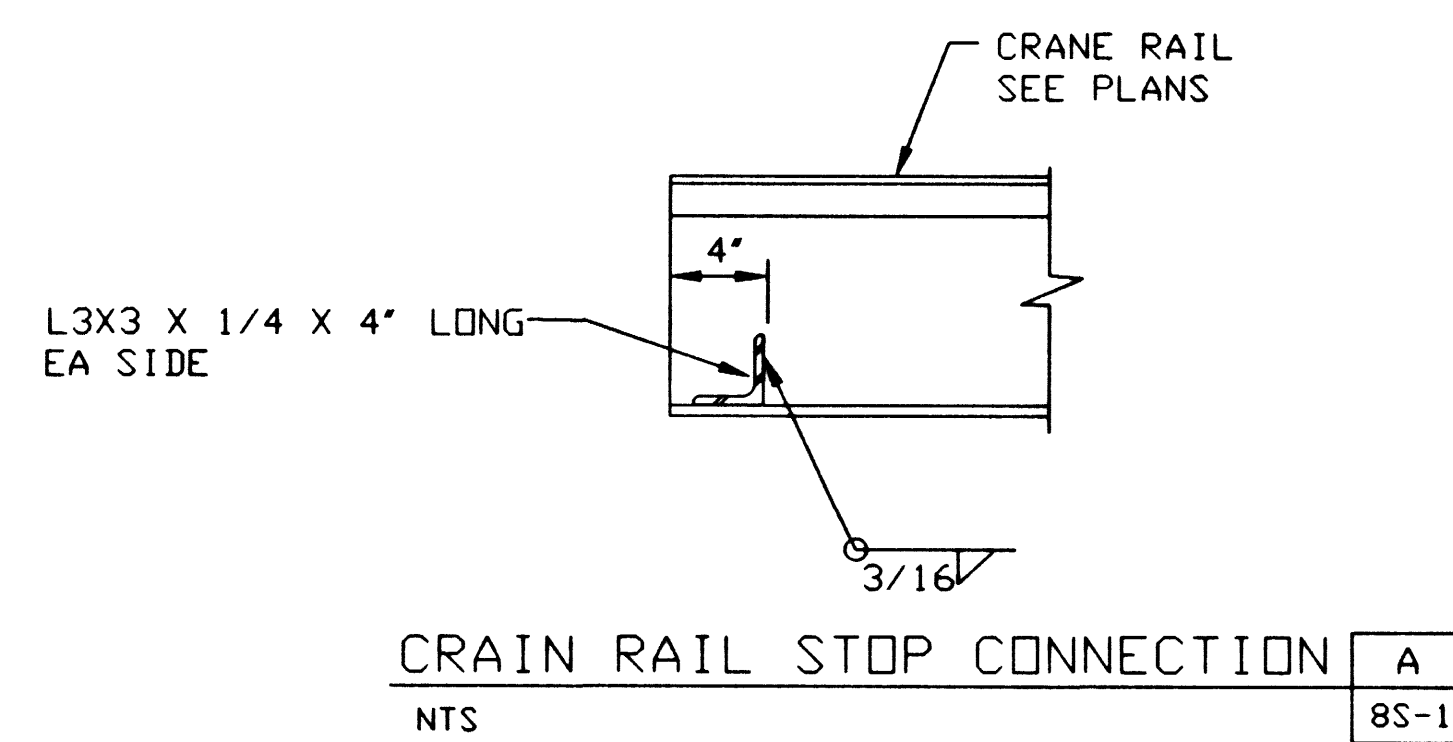


AS BUILT
DATE

10 APR 99

WG. 69

3S-3

13-64

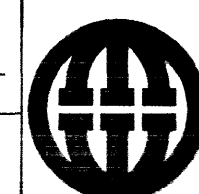

MONTGOMERY WATSON
Las Vegas, Nevada

MONTGOMERY WATSON
3014 WEST CHARLESTON BLVD
LAS VEGAS, NV. 89102-1944
(702) 878-8010

COPYRIGHT © 1996 BY MONTGOMERY WATSON
ALL RIGHTS RESERVED