


NOTE: DO NOT SCALE DRAWING. FOLLOW DIMENSIONS. THIS DRAWING AND DESIGN CONCEPTS SHOWN THEREIN ARE THE SOLE PROPERTY OF WESTAR ARCHITECTURAL GROUP / NEVADA, INCORPORATED. THE REPRODUCTION, COPY, OR USE OF THIS DRAWING WITHOUT THEIR PRIOR WRITTEN CONSENT IS PROHIBITED, AND ANY INFRINGEMENT WILL BE SUBJECT TO LEGAL ACTION.

SWIMMING POOL DATA

| | | |
|---------------|---|-----------------|
| SURFACE AREA | = | 3,800 SQ. FT. |
| PERIMETER | = | 260 FT. |
| DEPTHS | = | 3'-6" TO 12'-0" |
| VOLUME | = | 191,600 GAL. |
| 6 HR TURNOVER | = | 532 GPM |

LEGEND

| | | | | | | | | | | | |
|----|---|------------------|--|--------|---|------------------------|--|-----|---|----------------------|--|
| MD | = | MAIN DRAIN | | NR, ND | = | NO RUNNING, NO DIVING | | MGC | = | MOVEABLE GUARD CHAIR | |
| GR | = | GRABRAIL | | DM | = | DEPTH MARKER | | BS | = | BACKSTROKE STANCHION | |
| DL | = | DISABLED LIFT | | M | = | ONE METER DIVING STAND | | | | | |
| UL | = | UNDERWATER LIGHT | | SS | = | SURFACE SKIMMER | | | | | |
| RA | = | ROPE ANCHOR | | HR | = | HANDRAIL | | | | | |

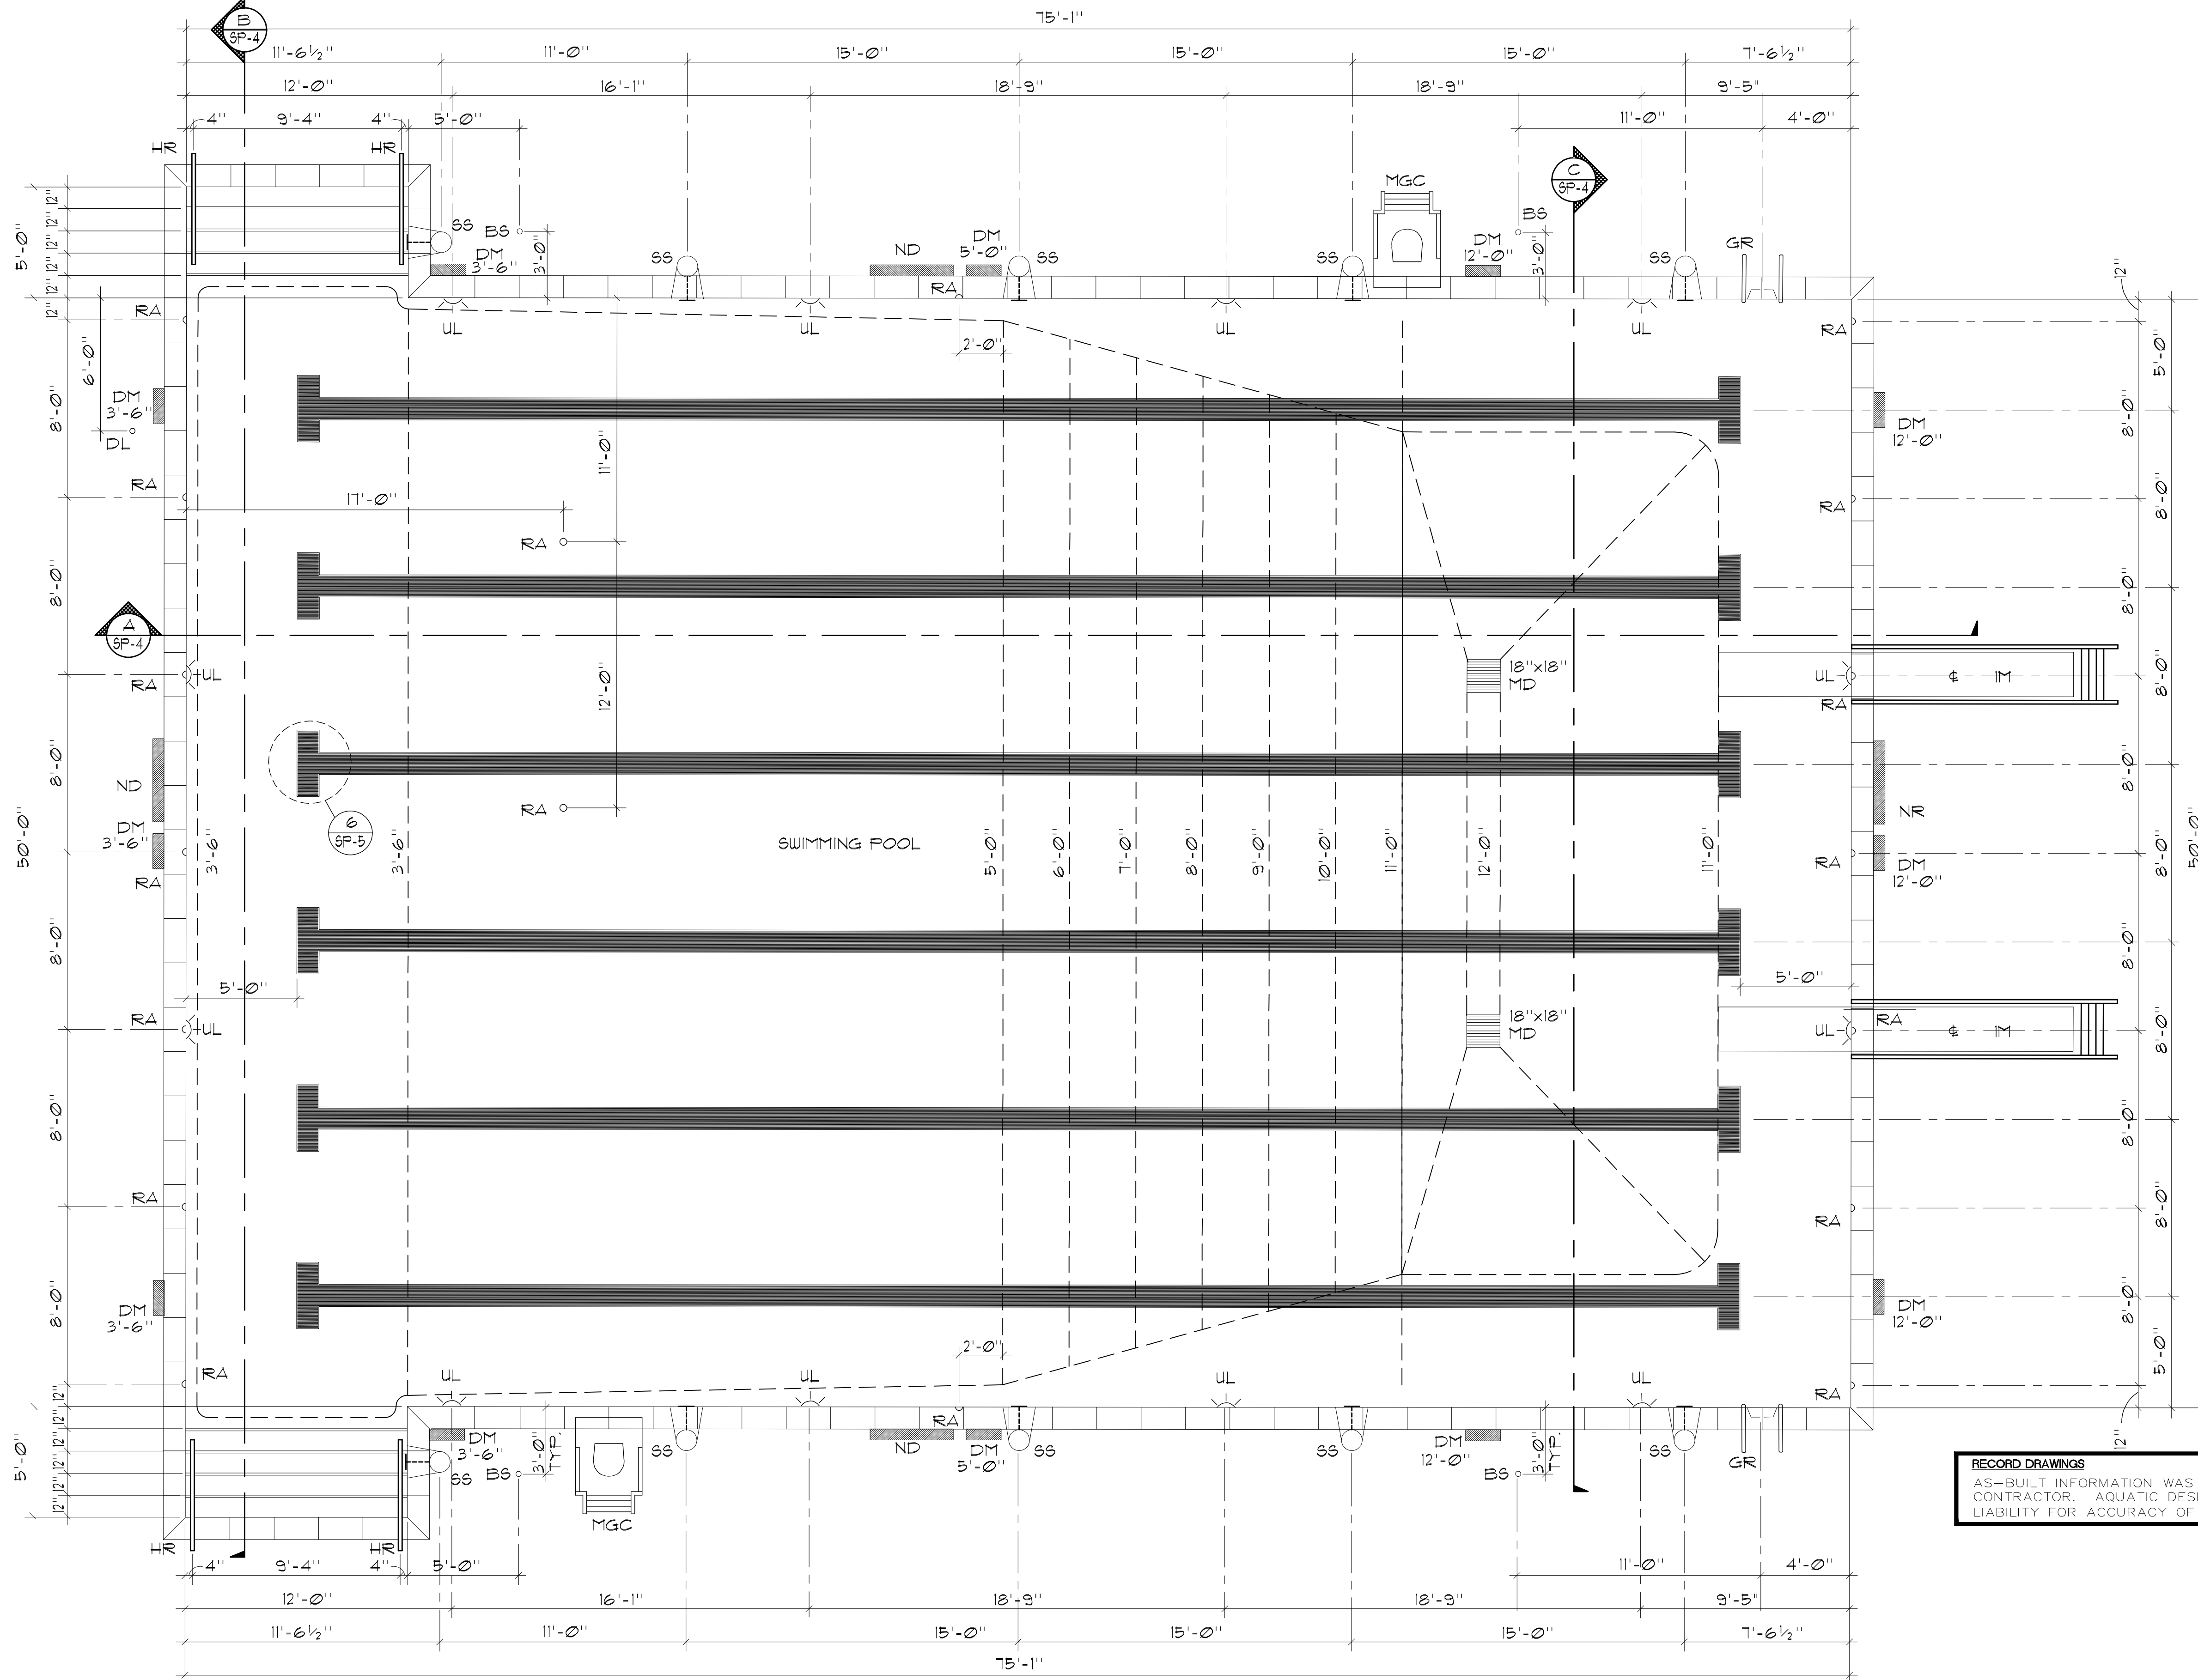

RECORD DRAWINGS
 AS-BUILT INFORMATION WAS PROVIDED BY THE CONTRACTOR. AQUATIC DESIGN GROUP ASSUMES NO LIABILITY FOR ACCURACY OF IT'S CONTENTS.



AQUATIC DESIGN GROUP
 850 KELLOGG AVE.
 CARLSBAD, CALIFORNIA
 92008
 (760) 438-8400


SWIMMING POOL LAYOUT PLAN

1/4" = 1'-0"

REVISIONS



WESTAR
 ARCHITECTURAL GROUP / NEVADA INC.
 LAS VEGAS * PHOENIX
 ARCHITECTURE * PLANNING * PROJECT MANAGEMENT
 3900 MEADOWS LANE SUITE 220 LAS VEGAS, NEVADA 89107
 TELEPHONE: (702) 878-0000 FAX: (702) 878-8450

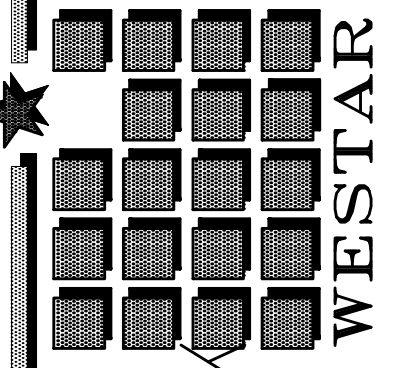

MASTERPLAN REDESIGN FOR:
CITY OF LAS VEGAS - BAKER PARK
 1020 E. ST. LOUIS AVE.
 LAS VEGAS, NEVADA

DRAWN BY: GMK
 REVIEWED BY: SIF
 PROJECT NUMBER: 99110
 ISSUE DATE: 12-1-00

021999SE 9802SP11/8
SP-3
 SWIMMING POOL LAYOUT PLAN