


THE REPRODUCTION, COPY, OR USE OF THIS DRAWING WITHOUT THEIR PRIOR WRITTEN CONSENT IS PROHIBITED, AND ANY INFRINGEMENT WILL BE SUBJECT TO LEGAL ACTION.


NOTE: DO NOT SCALE DRAWING. FOLLOW DIMENSIONS. THIS DRAWING AND DESIGN CONCEPTS SHOWN THEREON ARE THE SOLE PROPERTY OF WESTAR ARCHITECTURAL GROUP / NEVADA, INCORPORATED

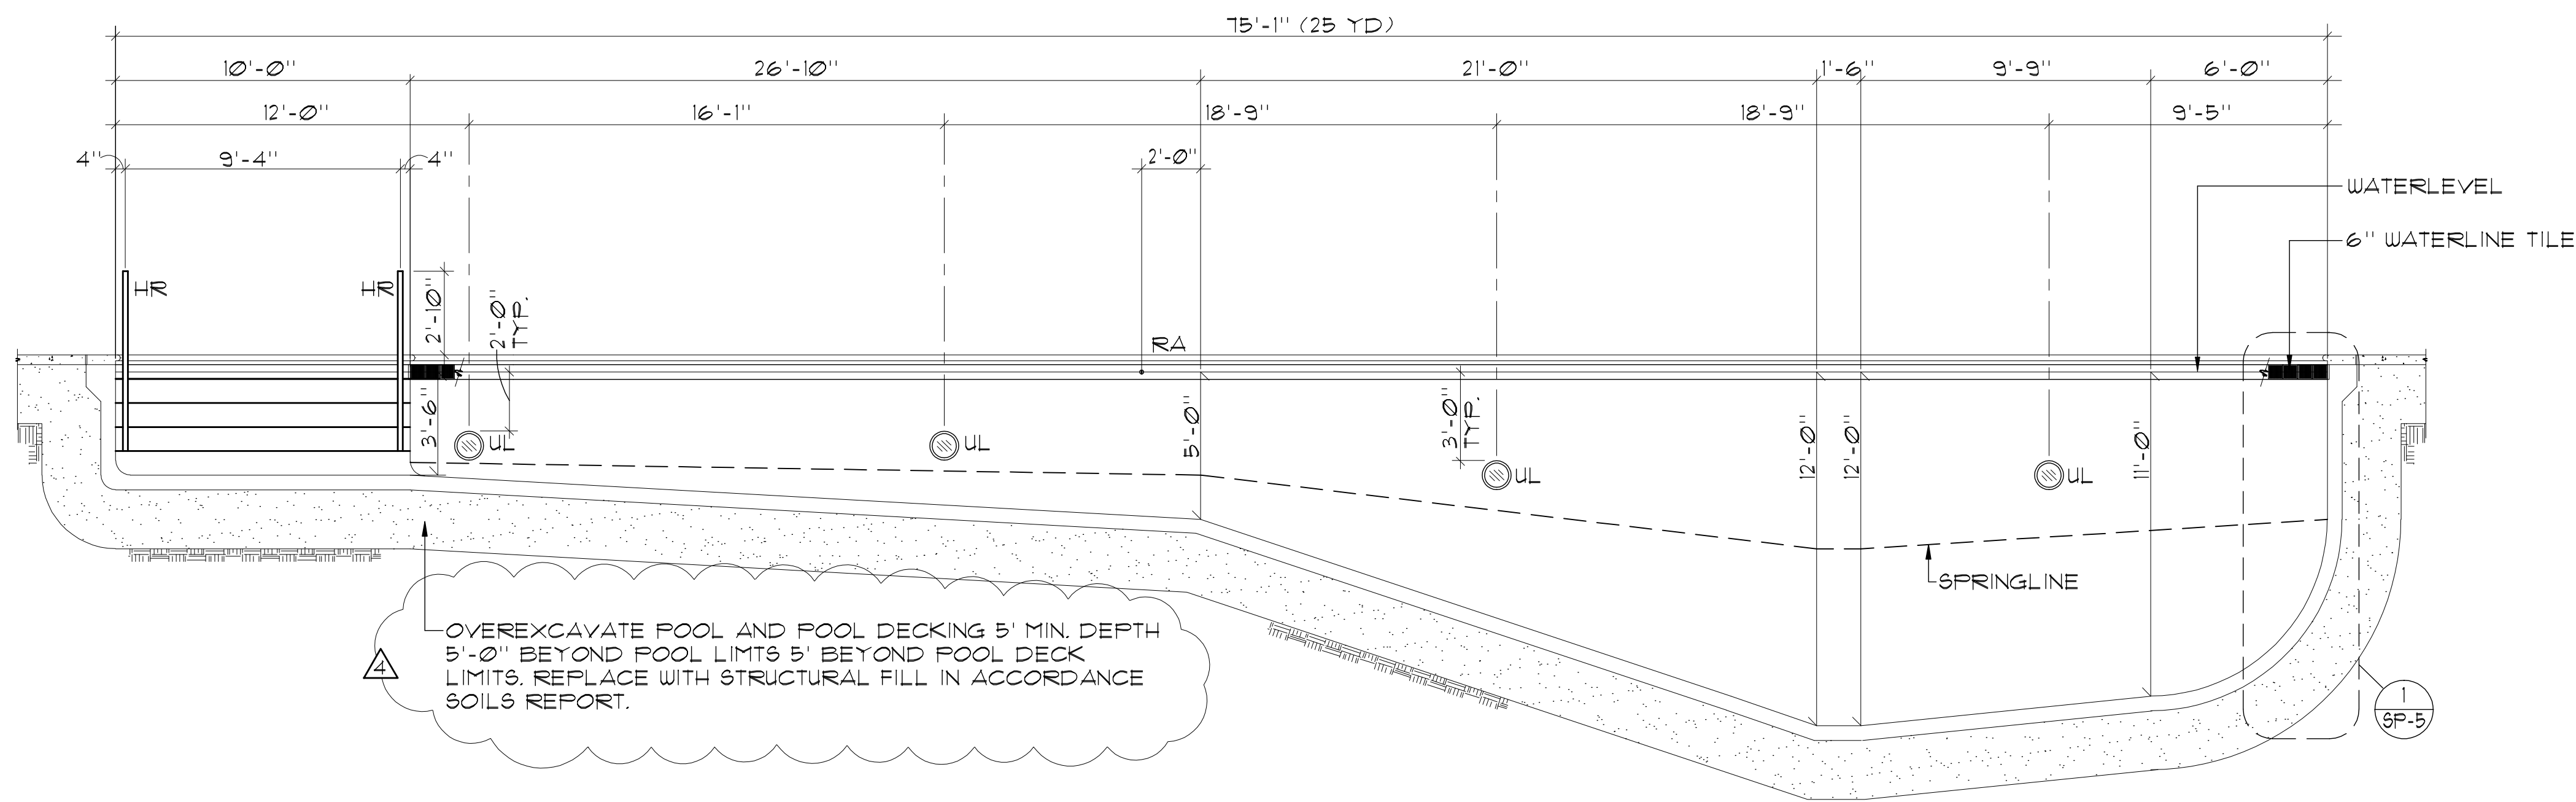

OVEREXCAVATE POOL AND POOL DECKING 5' MIN. DEPTH 5'-0" BEYOND POOL LIMITS 5' BEYOND POOL DECK LIMITS. REPLACE WITH STRUCTURAL FILL IN ACCORDANCE SOILS REPORT.

SWIMMING POOL SECTION


1/4" = 1'-0"

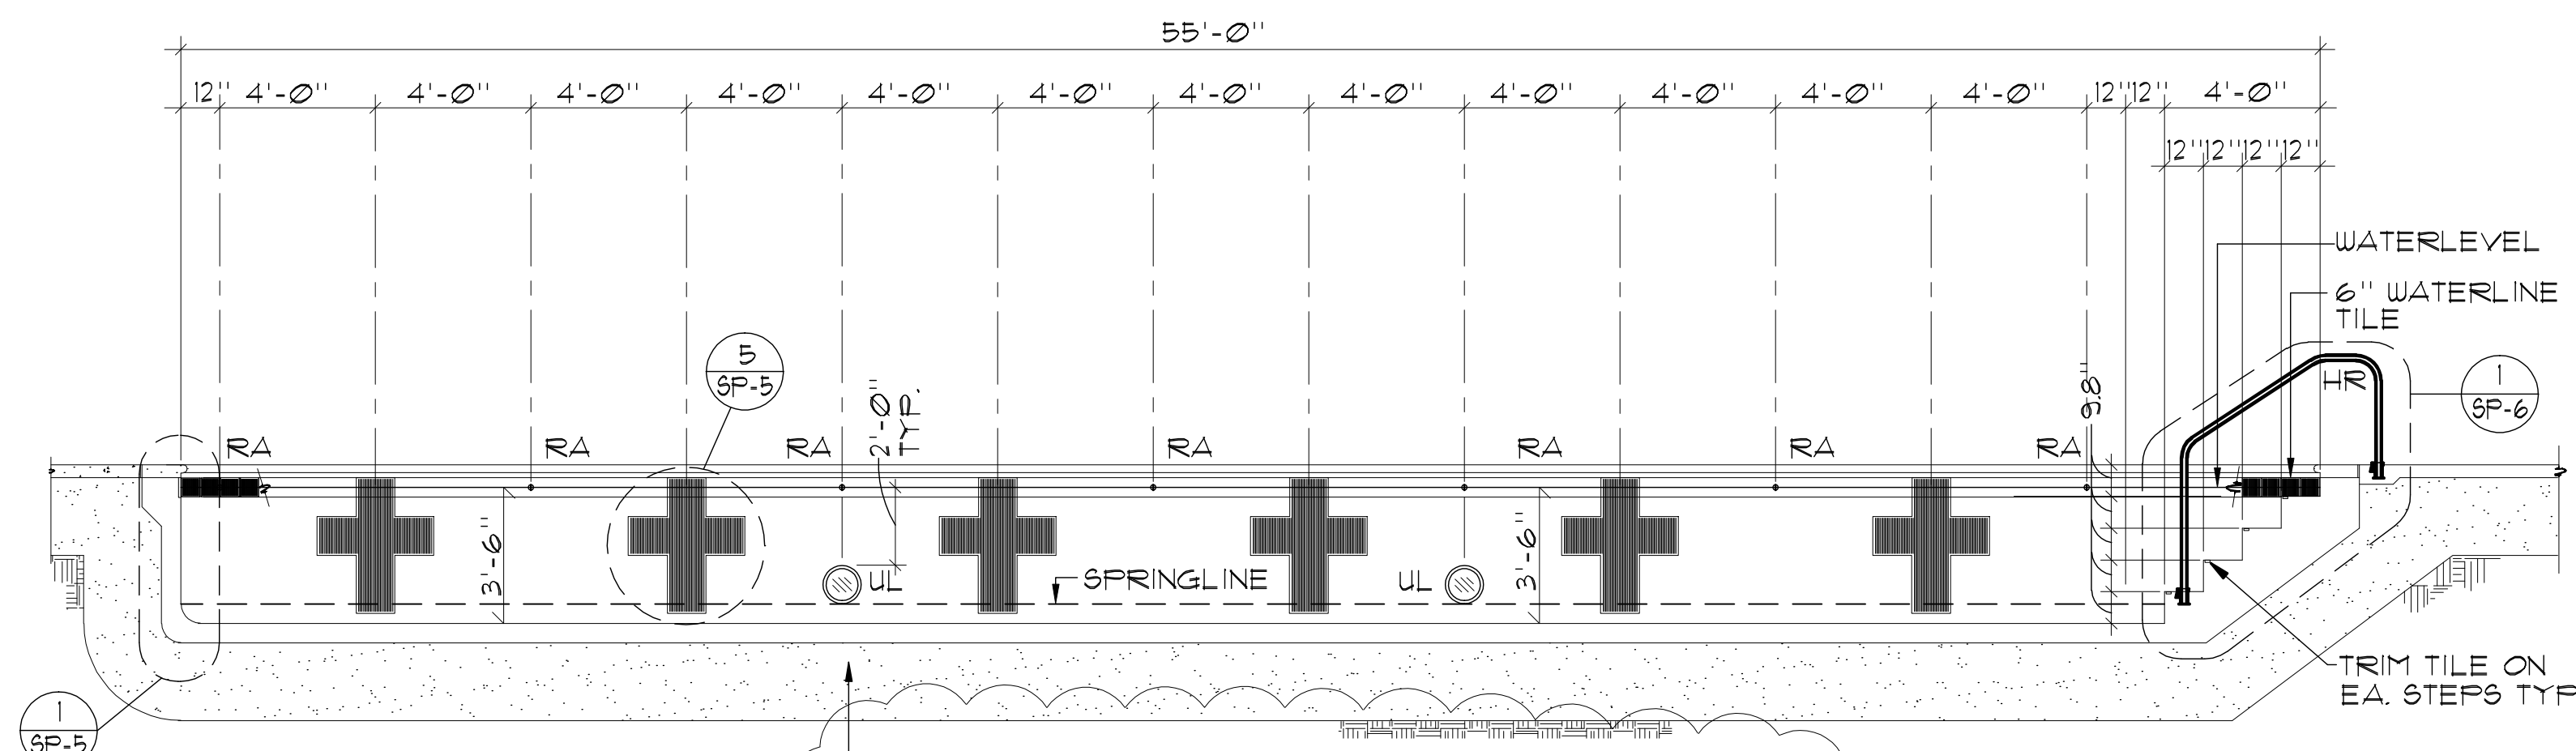

OVEREXCAVATE POOL AND POOL DECKING 5' MIN. DEPTH 5'-0" BEYOND POOL LIMITS 5' BEYOND POOL DECK LIMITS. REPLACE WITH STRUCTURAL FILL IN ACCORDANCE SOILS REPORT.

SWIMMING POOL SECTION

1/4" = 1'-0"

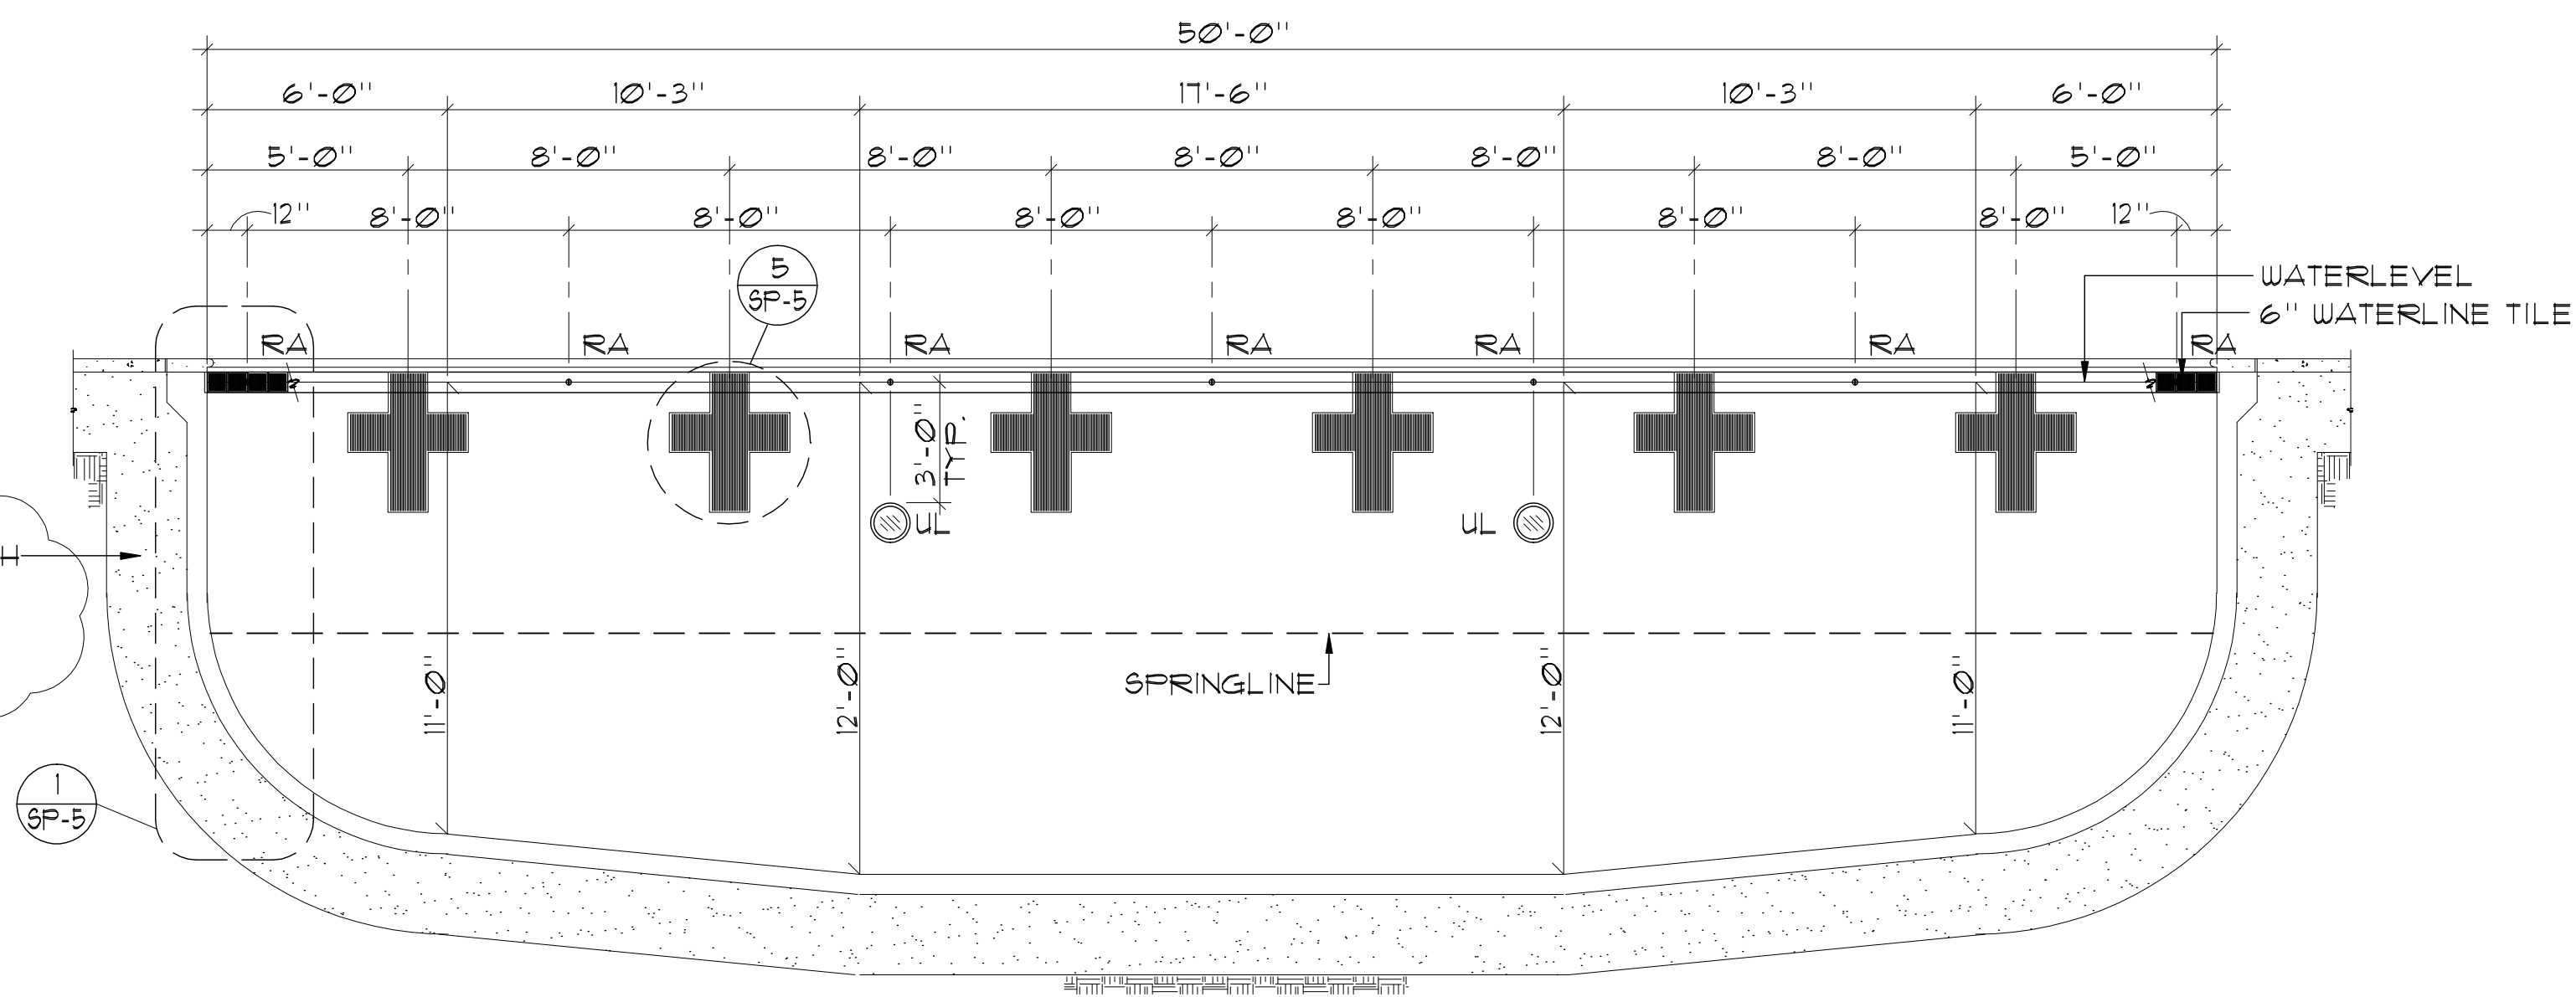

OVEREXCAVATE POOL AND POOL DECKING 5' MIN. DEPTH 5'-0" BEYOND POOL LIMITS 5' BEYOND POOL DECK LIMITS. REPLACE WITH STRUCTURAL FILL IN ACCORDANCE SOILS REPORT.

SWIMMING POOL SECTION


1/4" = 1'-0"

RECORD DRAWINGS
AS-BUILT INFORMATION WAS PROVIDED BY THE CONTRACTOR. AQUATIC DESIGN GROUP ASSUMES NO LIABILITY FOR ACCURACY OF ITS CONTENTS.

AQUATIC DESIGN GROUP
850 KELLOGG AVE.
CARLSBAD, CALIFORNIA 92008
(760) 438-9400

REVISIONS
AS BUILT CHANGES 06/24/03

WESTAR
ARCHITECTURAL GROUP / NEVADA INC.
LAS VEGAS * PHOENIX
ARCHITECTURE * PLANNING * PROJECT MANAGEMENT
3900 MEADOWS LANE SUITE 220 LAS VEGAS, NEVADA 89107
TELEPHONE: (702) 878-0000 FAX: (702) 878-8430

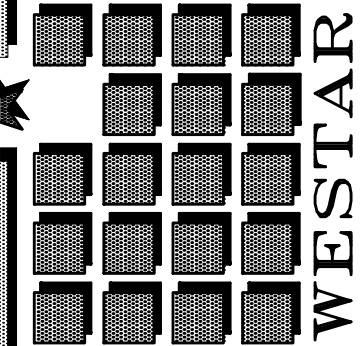

MASTERPLAN REDESIGN FOR:
CITY OF LAS VEGAS - BAKER PARK
1020 E. ST. LOUIS AVE.
LAS VEGAS, NEVADA

DRAWN BY: GMK
REVIEWED BY: S/JF
PROJECT NUMBER: 99110
ISSUE DATE: 12-1-00

021899SE 98025SP11/8
SP-4
SWIMMING POOL SECTIONS