

**NOTE:**  
 1. FINAL A.C. PAVEMENT SURFACE SHALL BE 1/2" ABOVE LIP OF GUTTER.  
 2. NATIVE SOILS ARE TO BE USED IN LIEU OF TYPE II AGGREGATE BASE PER SOILS REPORT.


**APPLE DRIVE - TYPICAL 80' PRIVATE DRIVE SECTION (FULL STREET)**  
 (NOT TO SCALE)

**CLV FIRE DEPT. NOTES**


- All work shall be done in strict accordance with the City of Las Vegas Fire Department "Hydrant Specifications," "Hydrant Installation Specifications" and Ordinance #3844.
- Authorized hydrants for this project are:  
 A. Kennedy Guardian  
 B. Mueller A-423 Centurian  
 C. Flow model 2548 Modellan
- On any new home or building installation, accessible fire hydrants shall be installed before combustible construction commences and said fire hydrants shall be in good working order with an adequate water supply.
- Contractor shall place a blue reflective marker at center line of street adjacent to fire hydrant as required in Ordinance #3844 to identify the fire hydrant location.
- Call the Las Vegas Fire Department at 228-2071 for underground inspection, pressure and flush verification of all fire hydrants and fire lines before covering.
- Painting of the curbs and hydrants and any work necessary for protection of hydrants from physical damage per Ordinance #3844 shall be completed before approval by the City of Las Vegas Fire Department.
- A permit is required from the Fire Department for on-site water line and fire hydrant. The Permit and contractor's material and test certificate for underground piping form shall be obtained from the Fire Protection Engineer prior to any work beginning.
- Private fire hydrants shall be painted red.
- A flow test must be witnessed by the Fire Department prior to occupancy for verification of required on-site water supply.
- All on-site fire main materials must be U.L. listed and A.R.W.A. approved.
- Fire hydrant spacing:  
 Residential - 500 feet unsprinklered; 1,000 feet sprinklered.  
 Commercial, including multi-family - 300 feet unsprinklered; 600 feet sprinklered.
- Where new water mains are extended along streets, where hydrants are not needed for protection of structures, fire hydrants shall be spaced at maximum 1,000 feet spacing to provide for transportation hazards.
- No fire hydrant shall be located within the required radius of a cul-de-sac or within 20 feet of the perimeter of the radius of the cul-de-sac.
- No fire hydrant shall be located within 6 feet of any curb return, driveway, power pole, street light or any other obstruction.
- Two sources of supply are required whenever there are 4 or more fire hydrants installed on a single system.
- Not more than 2 hydrants can be out of service due to a single main break.
- Fire apparatus access roads shall have an unobstructed width of not less than 20 feet provided no parking is allowed, not less than 28 feet if parallel parking is allowed on one side, and not less than 36 feet if parallel parking is allowed on both sides. Vertical clearance shall be not less than 13 feet 6 inches.
- The turning radius for any fire apparatus access road and/or fire lane, public or private shall be not less than 45 feet outside radius and 22 feet inside radius.
- A fire apparatus road shall be required when any portion of an exterior wall of the first story is located more than 150 feet from a fire department vehicle access. (See exceptions in UPC 94, Section 902.2)
- All dead end fire apparatus access roads and/or fire lanes, public or private, in excess of 150 feet in length shall be provided with an approved turnaround area. (See exceptions in UPC 94, Section 902.2)
- Access roads shall be marked by placing approved signs at the start of the designated fire lane, one sign at the end of the fire lane and with signs at intervals of 100 feet along all designated fire lanes. Signs to be placed on both sides of an access roadway if needed to prevent parking on either side. Signs to be installed no higher than 10 feet or less than 6 feet from roadway level. The curbs along or on the pavement or cement if curbs are not present, shall be painted with a red weather resistant paint in addition to the signs.
- Electrically controlled access gates shall be provided with an approved emergency vehicle detector/receiver system. Solid system shall be installed in accordance with the City of Las Vegas guidelines for Automatic Emergency Vehicle Access Gates.

Avoid cutting underground utility lines. It's costly.  
**Call before you Dig**  
 1-800-227-2600  
COMMERCIAL SERVICE ONLY


PROFILE SCALE:  
 HORIZ: 1"=40'  
 VERT: 1"=4'

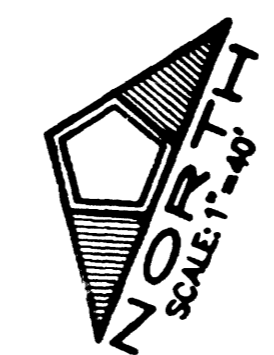

**AS-BUILT**  
 THIS PLAN SUBMITTED BY AMEC INFRASTRUCTURE, INC. DATED 10-10-02 IS FOR SEWER AS-BUILTS ONLY.  
 AS-BUILT INFORMATION SHOWN IS COMPILED FROM CONSTRUCTION NOTES AND FIELD OBSERVATIONS.

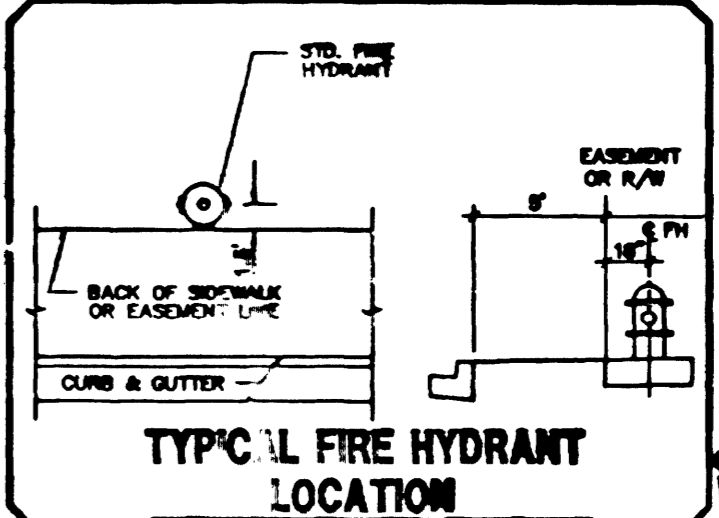

**APPLE DRIVE (PRIVATE DRIVE)**

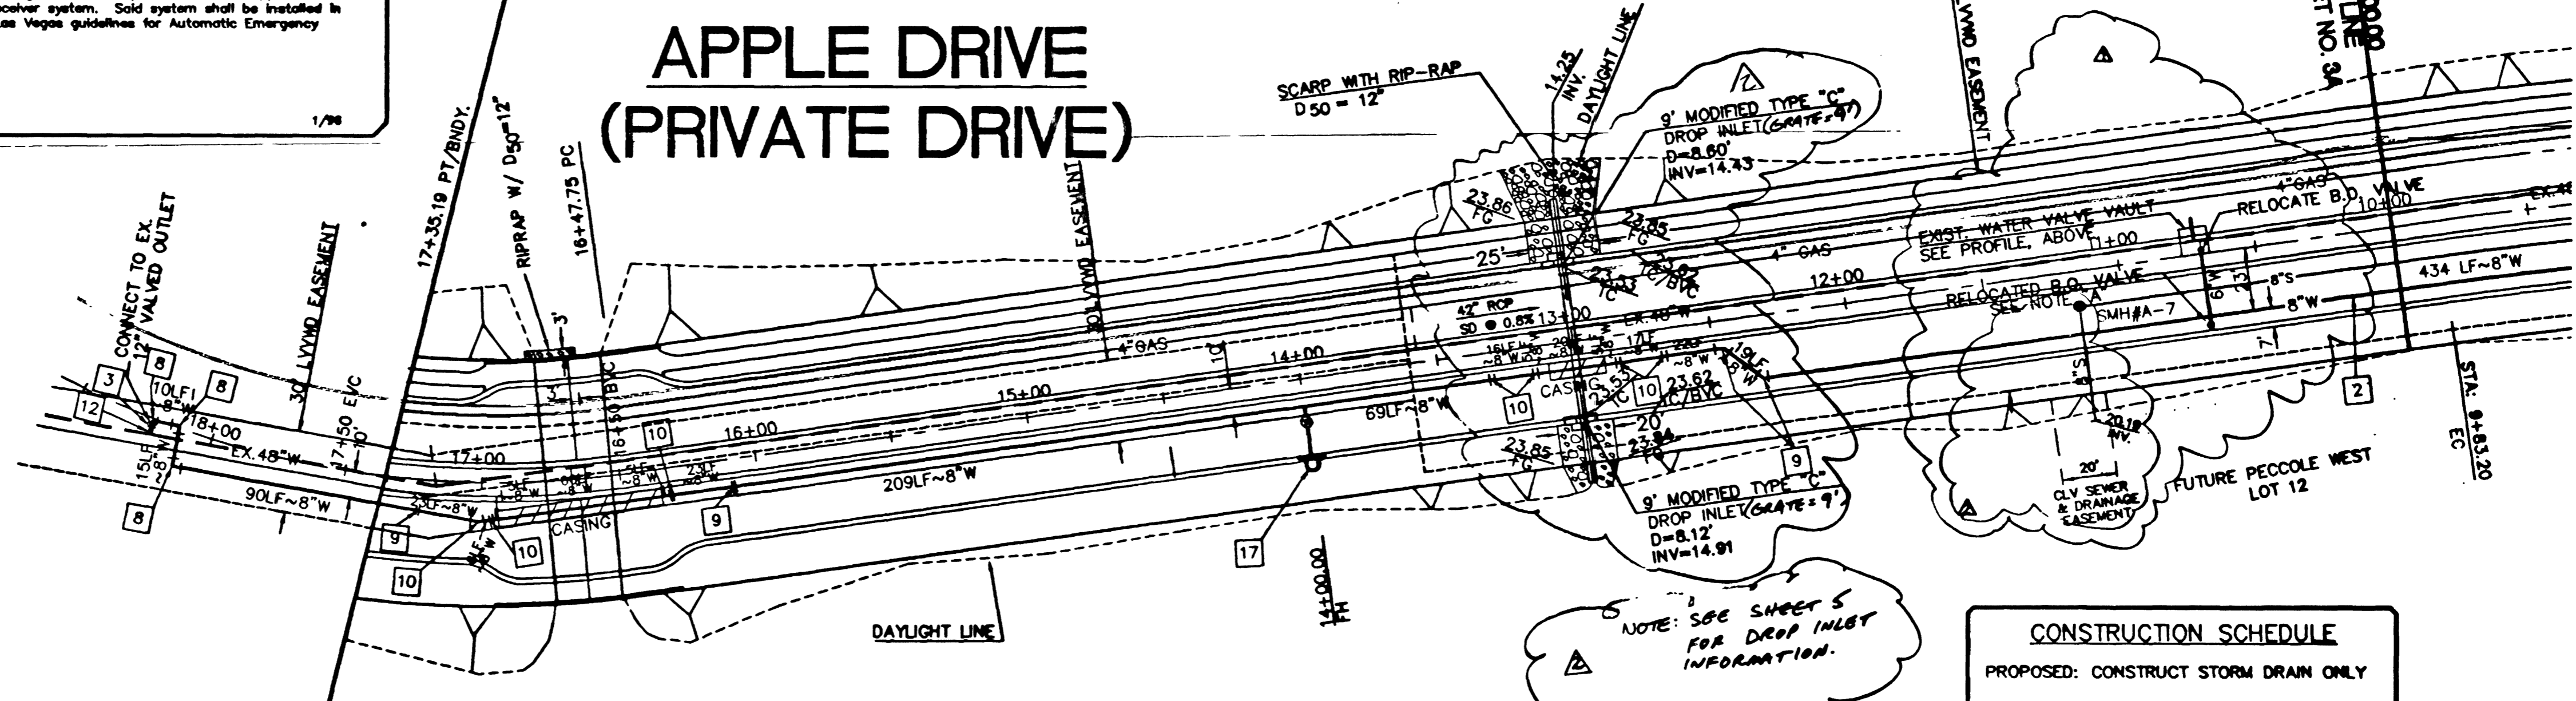


**CONSTRUCTION SCHEDULE**  
 PROPOSED: CONSTRUCT STORM DRAIN ONLY  
 FUTURE: SAWCUT STORM DRAIN AND INSTALL DROP INLETS.

NOTE: SEE SHEET 5 FOR DROP INLET INFORMATION.

*[Signature]* (107-111-1-12-96) 4/10/96  
 LAS VEGAS VALLEY WATER DISTRICT DATE

REVISION	DATE	BY	DESCRIPTION
1	10/10/02	AMEC	ISSUE
2	10/10/02	AMEC	ISSUE
3	10/10/02	AMEC	ISSUE
4	10/10/02	AMEC	ISSUE
5	10/10/02	AMEC	ISSUE

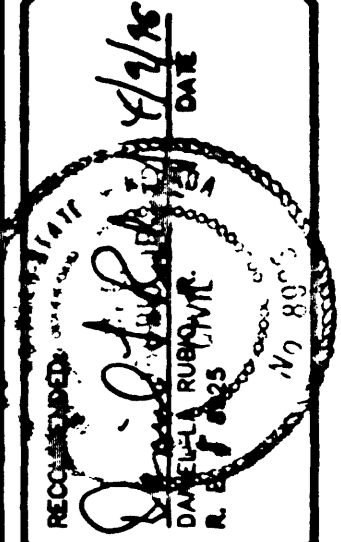

DATE: 1/12/98  
 DRAWN BY:  
 CHECKED BY:  
 JOB NO.: 145,0016  
 SCALE: 1"=40'

**PENTACORE**  
 Engineering, Inc.  
 6763 West Charleston Boulevard  
 Las Vegas, Nevada 89102

PECCOLE NEVADA CORP.  
 APPLE DRIVE IMPROVEMENTS  
 UTILITY PLAN AND PROFILE

AS BUILT 27-2-30 REVISED 107-V2448