


PLAN  
 DATE  
 BY  
 CHECKED  
 NO.

PROFILE  
 DATE  
 BY  
 CHECKED  
 NO.

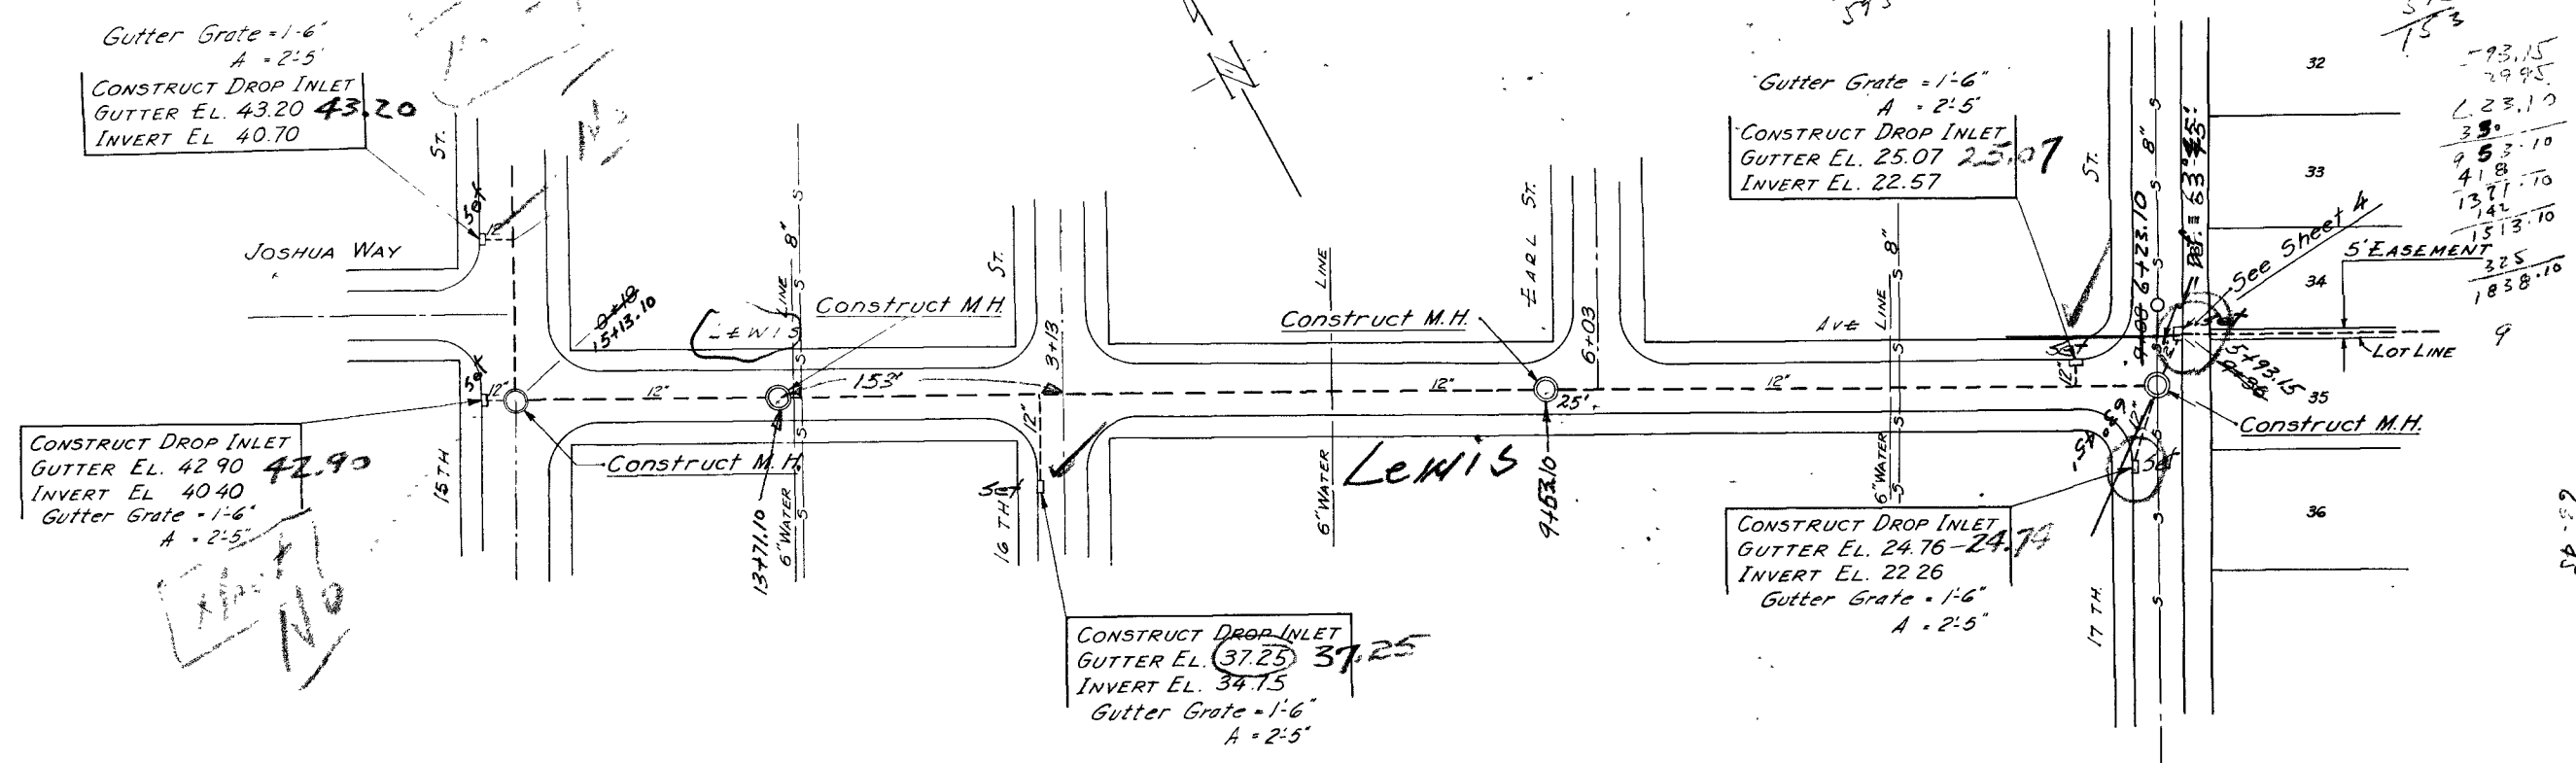


140  
 140  
 25  
 100  
 90  
 595

578  
 160  
 418

538  
 578  
 330  
 418  
 748  
 595  
 153

93.15  
 299.5  
 223.10  
 330  
 253.10  
 418  
 1371.70  
 142  
 1513.10  
 325  
 1838.10

179  
 60  
 50  
 9

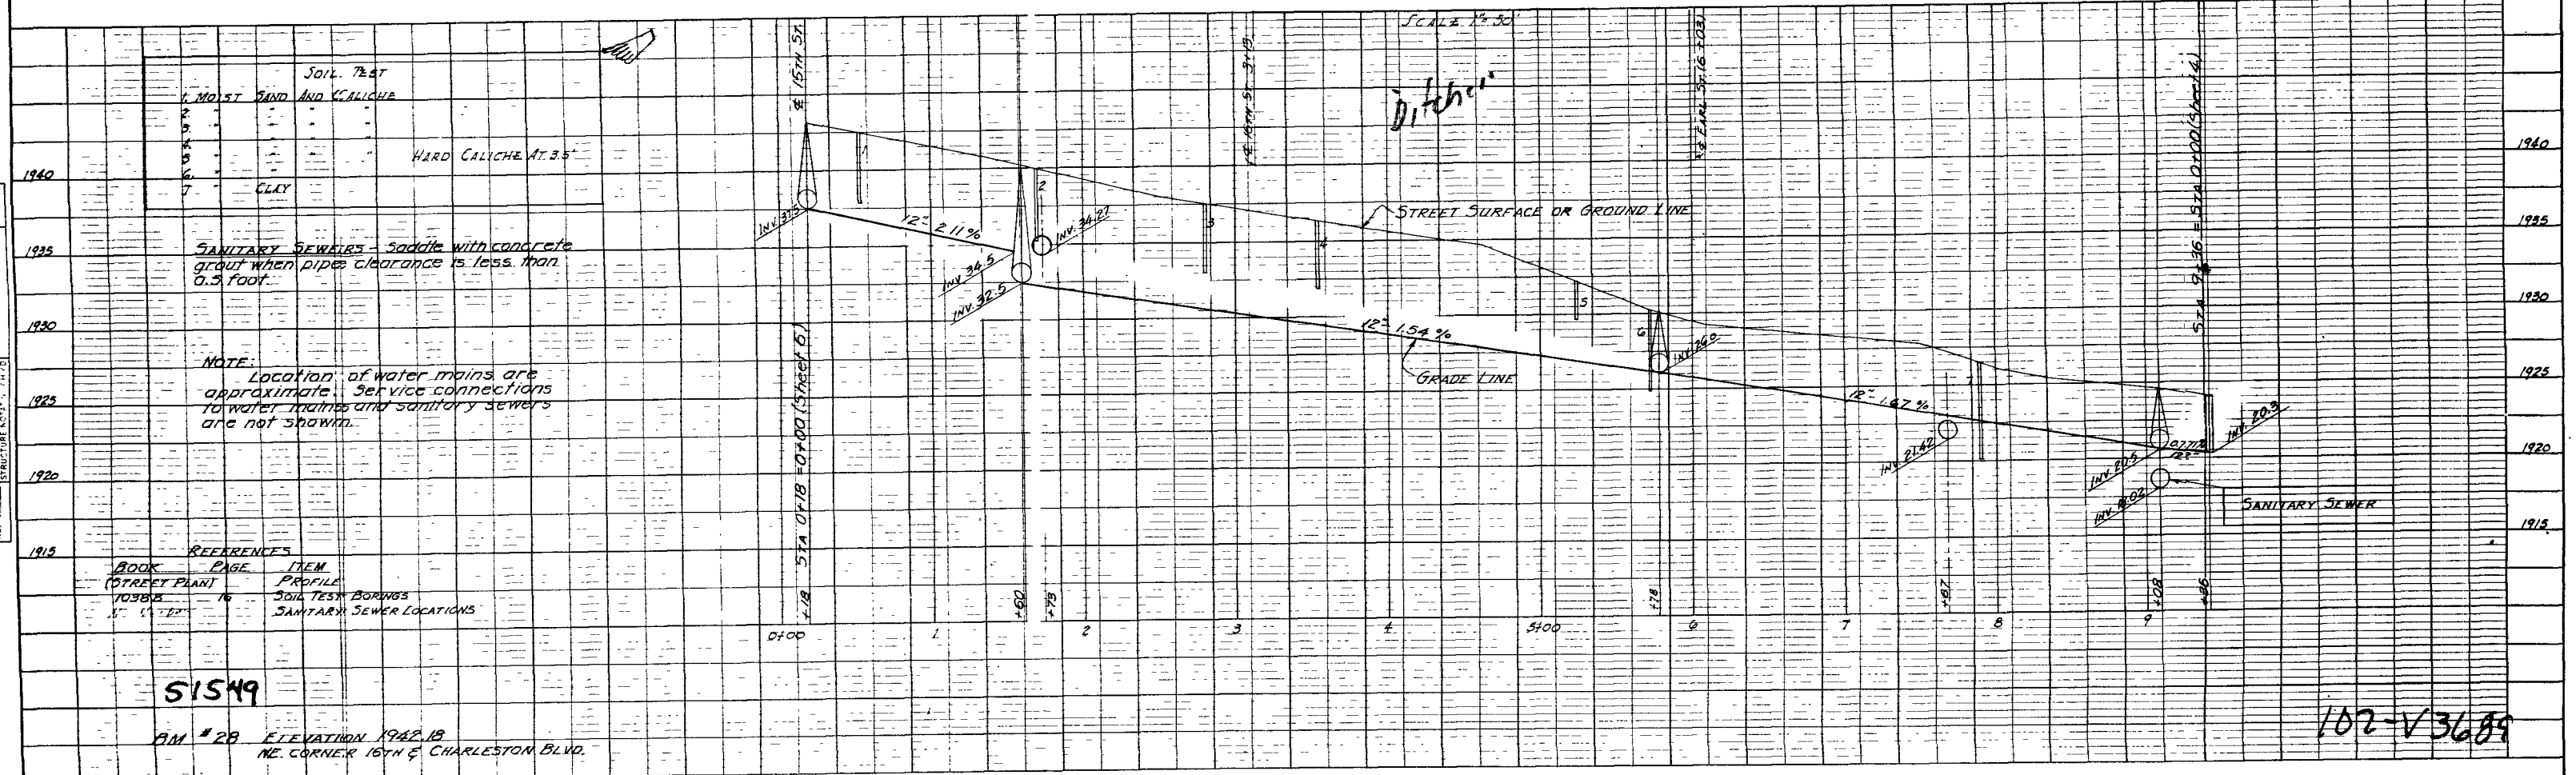

REFERENCES

BOOK	PAGE	ITEM
(STREET PLAN)	1038B	SOIL TEST BORINGS
" "	" "	SANITARY SEWER LOCATIONS

S1549

3M # 28 ELEVATION 1962-18  
 NE CORNER 16TH & CHARLESTON BLVD.

102-V3689