


2.45
 07.27
 9.86
 98.02
 2.84
 00.86
 1.58
 92.28
 2.32
 77.50
 9.51
 87.11

00.54
 2.32
 92.37
 95.54
 97.11
 088.05
 21.62
 055.43

Line Staked 1-18-49
 5' offset West & North
 except @ M.H. 3478.40 which is east & south
 State B.M. # 14 - N.I. in P.P. 2:17 Rt. Sta. 139+92
 on CLV Datum = 2005.5'2

111

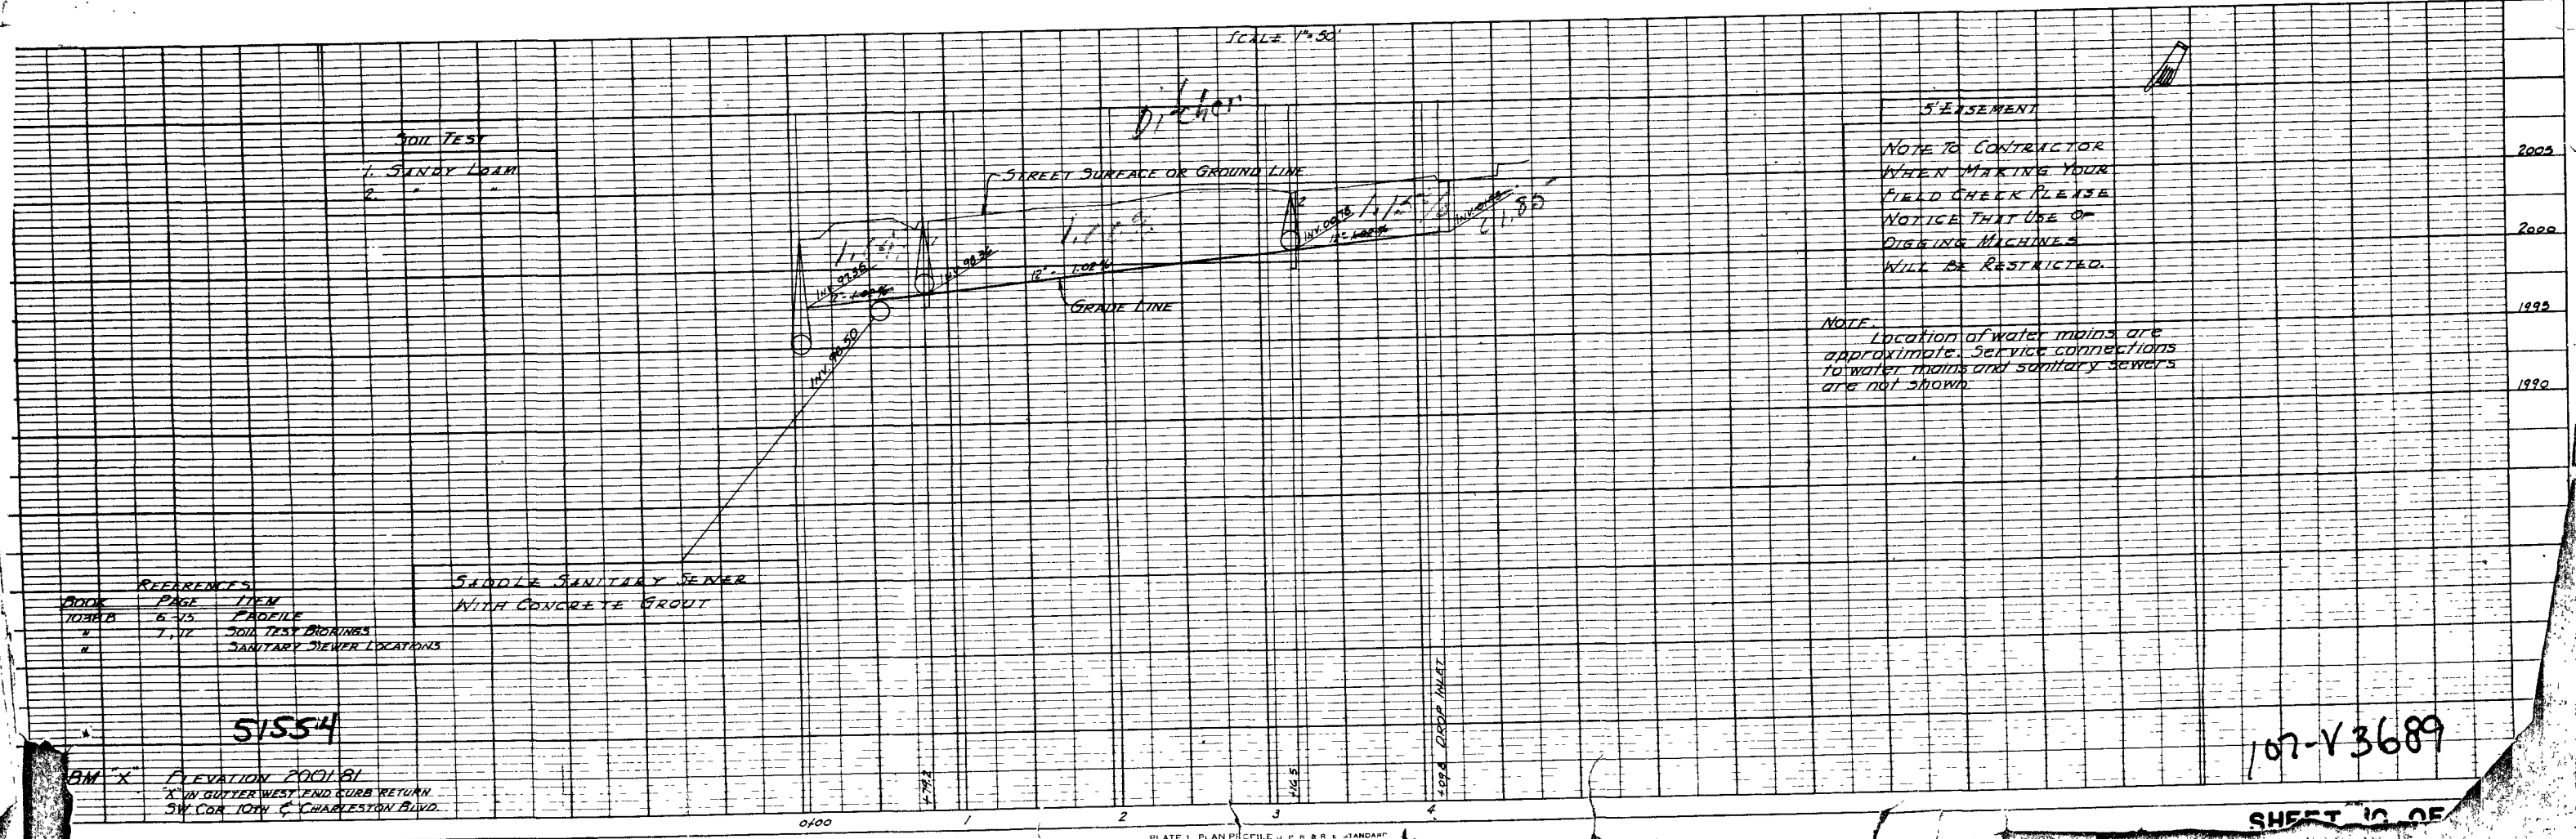

Soil Test
 1. SANDY LOAM
 2. " "

5' EASEMENT
 NOTE TO CONTRACTOR
 WHEN MAKING YOUR
 FIELD CHECK PLEASE
 NOTICE THAT USE OF
 DIGGING MACHINES
 WILL BE RESTRICTED.

NOTE: Location of water mains are
 approximate. Service connections
 to water mains and sanitary sewers
 are not shown.

BOOK	PAGE	ITEM
1038B	6-15	PROFILE
"	7-17	SOIL TEST BORINGS
"	"	SANITARY SEWER LOCATIONS

SINGLE SANITARY SEWER
 WITH CONCRETE GROUT

51554

BM "X" ELEVATION 2001.81
 2' IN GUTTER WEST END CURB RETURN
 SW COR 10TH & CHARLESTON BLVD.

107-V3689

SHEET 10 OF