


SUMMERLIN

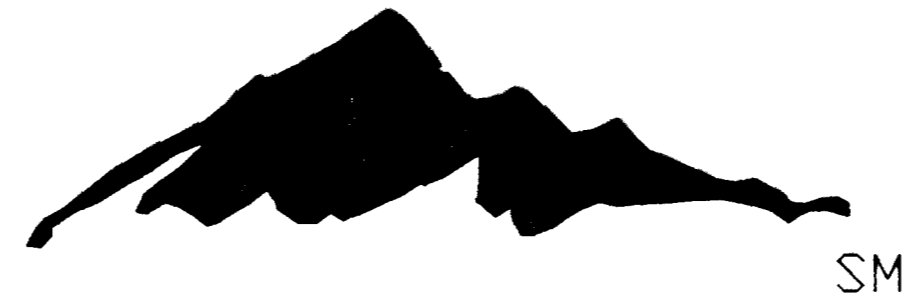

VILLAGE 20 UNIT 1 REGIONAL DRAINAGE IMPROVEMENTS

2000

SEWER
AS-BUILTS
BY
Contra Constr

DEVELOPER

The Howard Hughes Corporation

An Affiliate of THE ROUSE COMPANY

HOWARD HUGHES PROPERTIES, INC.
a Nevada corporation

**10000 W. CHARLESTON, SUITE 200
LAS VEGAS, NEVADA 89135**
OFFICE PHONE NO. (702) 791-4300
OFFICE FAX NO. (702) 791-4450

ENGINEER



G.C. WALLACE, INC.
Engineers/Planners/Surveyors

1555 SOUTH RAINBOW BLVD./LAS VEGAS, NEVADA 89146
OFFICE: (702) 804-2000, FAX: (702) 804-2299
SUMMERLIN OFFICE 10000 CHARLESTON BLVD., STE. 130
OFFICE: (702) 804-2160, FAX: (702) 804-2295

APPROVALS

DRAINAGE CERTIFICATION

I CERTIFY THAT THE GRADING PLAN IS IN CONFORMANCE WITH THE APPROVED DRAINAGE STUDY ON FILE AT THE CITY OF LAS VEGAS FOR THIS PROJECT.

Bert A. Hughes 2/9/01
Bert A. Hughes 12/1/00
BERT A. HUGHES R.P.E. 10259 DATE

*APPROVAL OF THESE PLANS IS LIMITED TO THOSE IMPROVEMENTS CONSTRUCTED IN THE DEDICATED RIGHTS-OF-WAY AND / OR DEDICATED EASEMENTS. THIS APPROVAL DOES NOT AUTHORIZE THE CONSTRUCTION OF ANY IMPROVEMENTS THAT DEVIATE FROM ADOPTED STANDARDS AND / OR SPECIFICATIONS, EXCEPT THOSE SPECIFICALLY LISTED UNDER DEVIATIONS FROM STANDARD. THE ENGINEER SHALL RESOLVE ANY DEVIATION OTHER THAN THOSE LISTED IN DEVIATIONS FROM STANDARDS IN FAVOR OF THE UNIFORM STANDARD DRAWINGS AND SPECIFICATIONS CLARK COUNTY AREA NEVADA.

Charles Karkowski, Jr. 3-16-2001
CHARLES KARKOWSKI, JR.: PE #4784
CITY ENGINEER
CITY OF LAS VEGAS, NEVADA DATE

THE HOWARD HUGHES CORPORATION,
a Delaware corporation

By: *John T. Potts* 12-11-00
JOHN T. POTTS
Title: SENIOR VICE PRESIDENT, DEVELOPMENT

ACKNOWLEDGEMENTS

NEVADA POWER COMPANY DISCLAIMER

NOTE:
EXISTING UTILITY LOCATIONS SHOWN HEREON ARE APPROXIMATE ONLY. IT SHALL BE THE CONTRACTOR'S RESPONSIBILITY TO DETERMINE THE EXACT VERTICAL AND HORIZONTAL LOCATION OF ALL EXISTING UNDERGROUND UTILITIES PRIOR TO COMMENCING CONSTRUCTION. NO REPRESENTATION IS MADE THAT ALL EXISTING UTILITIES ARE SHOWN HEREON. THE ENGINEER ASSUMES NO RESPONSIBILITY FOR UTILITIES NOT SHOWN OR UTILITIES NOT SHOWN IN THEIR PROPER LOCATIONS.

CALL BEFORE YOU DIG: 1(800)227-2600

NEVADA POWER Co. *Steve J. Delahate* 12/1/00
REVIEWED BY DATE


Richard M. Hood 3/10/01
LAS VEGAS VALLEY WATER DISTRICT DATE
SPRINT
Richard M. Hood 12-11-00
DATE
Craig S. Sisco 12-11-00
SOUTHWEST GAS CORP. - Craig S. Sisco DATE

MARCH 29, 2001 ISSUE FOR CONSTRUCTION

G. C. WALLACE, INC.
Engineering/Architecture
1555 SOUTH RAINBOW BLVD./LAS VEGAS, NEVADA 89146
TELEPHONE: (702) 804-2000 • FAX: (702) 804-2299
F:\200\unit1-rc3\veg\maps\rc3b000.dwg

SUMMERLIN
VILLAGE 20 UNIT 1 REGIONAL DRAINAGE IMPROVEMENTS
COVER SHEET

SHEET
1 OF 18 SHEETS

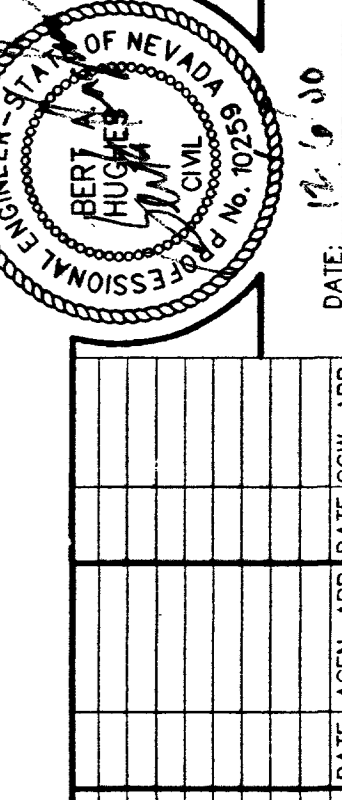

54715