

CIVIL SHEET INDEX

SHEET #	SHEET	DESCRIPTION
1	C1.01	COVER SHEET
2	C1.02	VICINITY MAP
3	C1.03	GENERAL NOTES SHEET
4	C3.01	HORIZONTAL CONTROL PLAN
5	C3.02	HORIZONTAL CONTROL PLAN
6	C3.03	HORIZONTAL CONTROL PLAN
7	C4.01	GRADING PLAN
8	C4.02	GRADING PLAN
9	C4.03	GRADING PLAN
10	C4.04	PLAN & PROFILE - SANDHILL ROAD
11	C4.05	PLAN & PROFILE - SANDHILL ROAD
12	C5.01	UTILITY PLAN
13	C5.02	UTILITY PLAN
14	C5.03	UTILITY PLAN
15	C6.01	STREETLIGHTS/SIGNAGE & STRIPING PLAN
16	C8.01	DETAIL SHEET
17	C8.02	DETAIL SHEET
18	C8.03	DETAIL SHEET
19	C8.04	DETAIL SHEET
20	C8.05	STORM DRAIN DROP INLET DETAILS
21	C8.06	STORM DRAIN PLAN & PROFILE

APPROVED FOR CONSTRUCTION

LAS VEGAS VALLEY WATER DISTRICT (SHEETS 2,3,10,12-14) DATE

AS BUILTS

66555



REVISIONS

CONSULTANT


MARTIN & MARTIN

MARTIN & MARTIN
Civil Engineers
2101 South Jones Blvd.
Suite 120
Las Vegas, Nevada 89146
Phone (702)248-8000
Fax (702)248-8070
E-MAIL MARTMART@VCM.COM

DEPARTMENT OF PUBLIC WORKS

BONANZA - SANDHILL PARK

VICINITY MAP

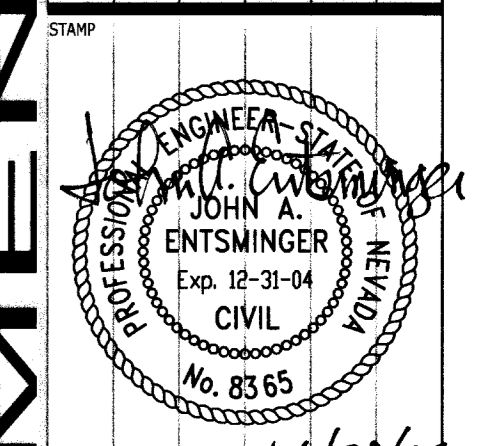

OWNER: CITY OF LAS VEGAS
DEPARTMENT OF PUBLIC WORKS
ARCHITECTURAL SERVICES

400 EAST STEWART AVENUE
LAS VEGAS, NEVADA 89103
PHONE: (702) 229-6535
FAX: (702) 382-9232
TDD: (702) 386-9108

DRAWN: V.J.W. / J.B.J.
FILE: 1925COVER.DWG
DATE: 8-23-02
SCALE: 1"=20'
BID NO: 02.15341.07
CIV. DWG NO: 650.69

SHEET NO. **C1.02**
SHEET 2 OF 21

DRAWINGS AND INSTRUMENTS OF SERVICE ARE THE PROPERTY OF THE DESIGN PROFESSIONAL. THESE DRAWINGS AND INSTRUMENTS OF SERVICE ARE TO BE USED ONLY FOR THE PROJECT AND NOT FOR THE CONSTRUCTION OF ANY OTHER PROJECT. H.A.C. 623.760