




PLAN SYMBOLS	
	-INDICATES TYPICAL SECTION CUT
	-INDICATE CMU LINTEL SEE SCHEDULE

**BOND BEAM**  
 TYPICAL BOND BEAM AT ROOF LEVEL AND TOP OF WALL - USE 8" DEPTH BOND BEAM WITH (2) #5 CONTINUOUS AT 8" CMU - GROUT SOLID.

- ROOF FRAMING NOTES**
- METAL DECKING: VEROO TYPE N 18 GAUGE DECK MINIMUM UNLESS NOTED OTHERWISE ON PLANS. SEE DETAIL 15/SD1
  - SEE 16/SD1 FOR TYPICAL METAL ROOF DECK ATTACHMENT.
  - FOR TOP OF STEEL ELEVATION SEE 1/AS

LINTEL SCHEDULE					
MARK	DEPTH	WIDTH	HORIZ. STEEL TOP AND BOT.	VERT. STEEL	DETAIL
L1	FULL HT.	8"	2-#5 TOP & BOTTOM - EXTEND 24" PAST JAMB MIN. USE TYP. HORIZ. WALL STEEL.	#4 @ 18" O.C.	(9) SD1

**NOTES:**  
 1. ALL LITELS SHOWN SHADED.

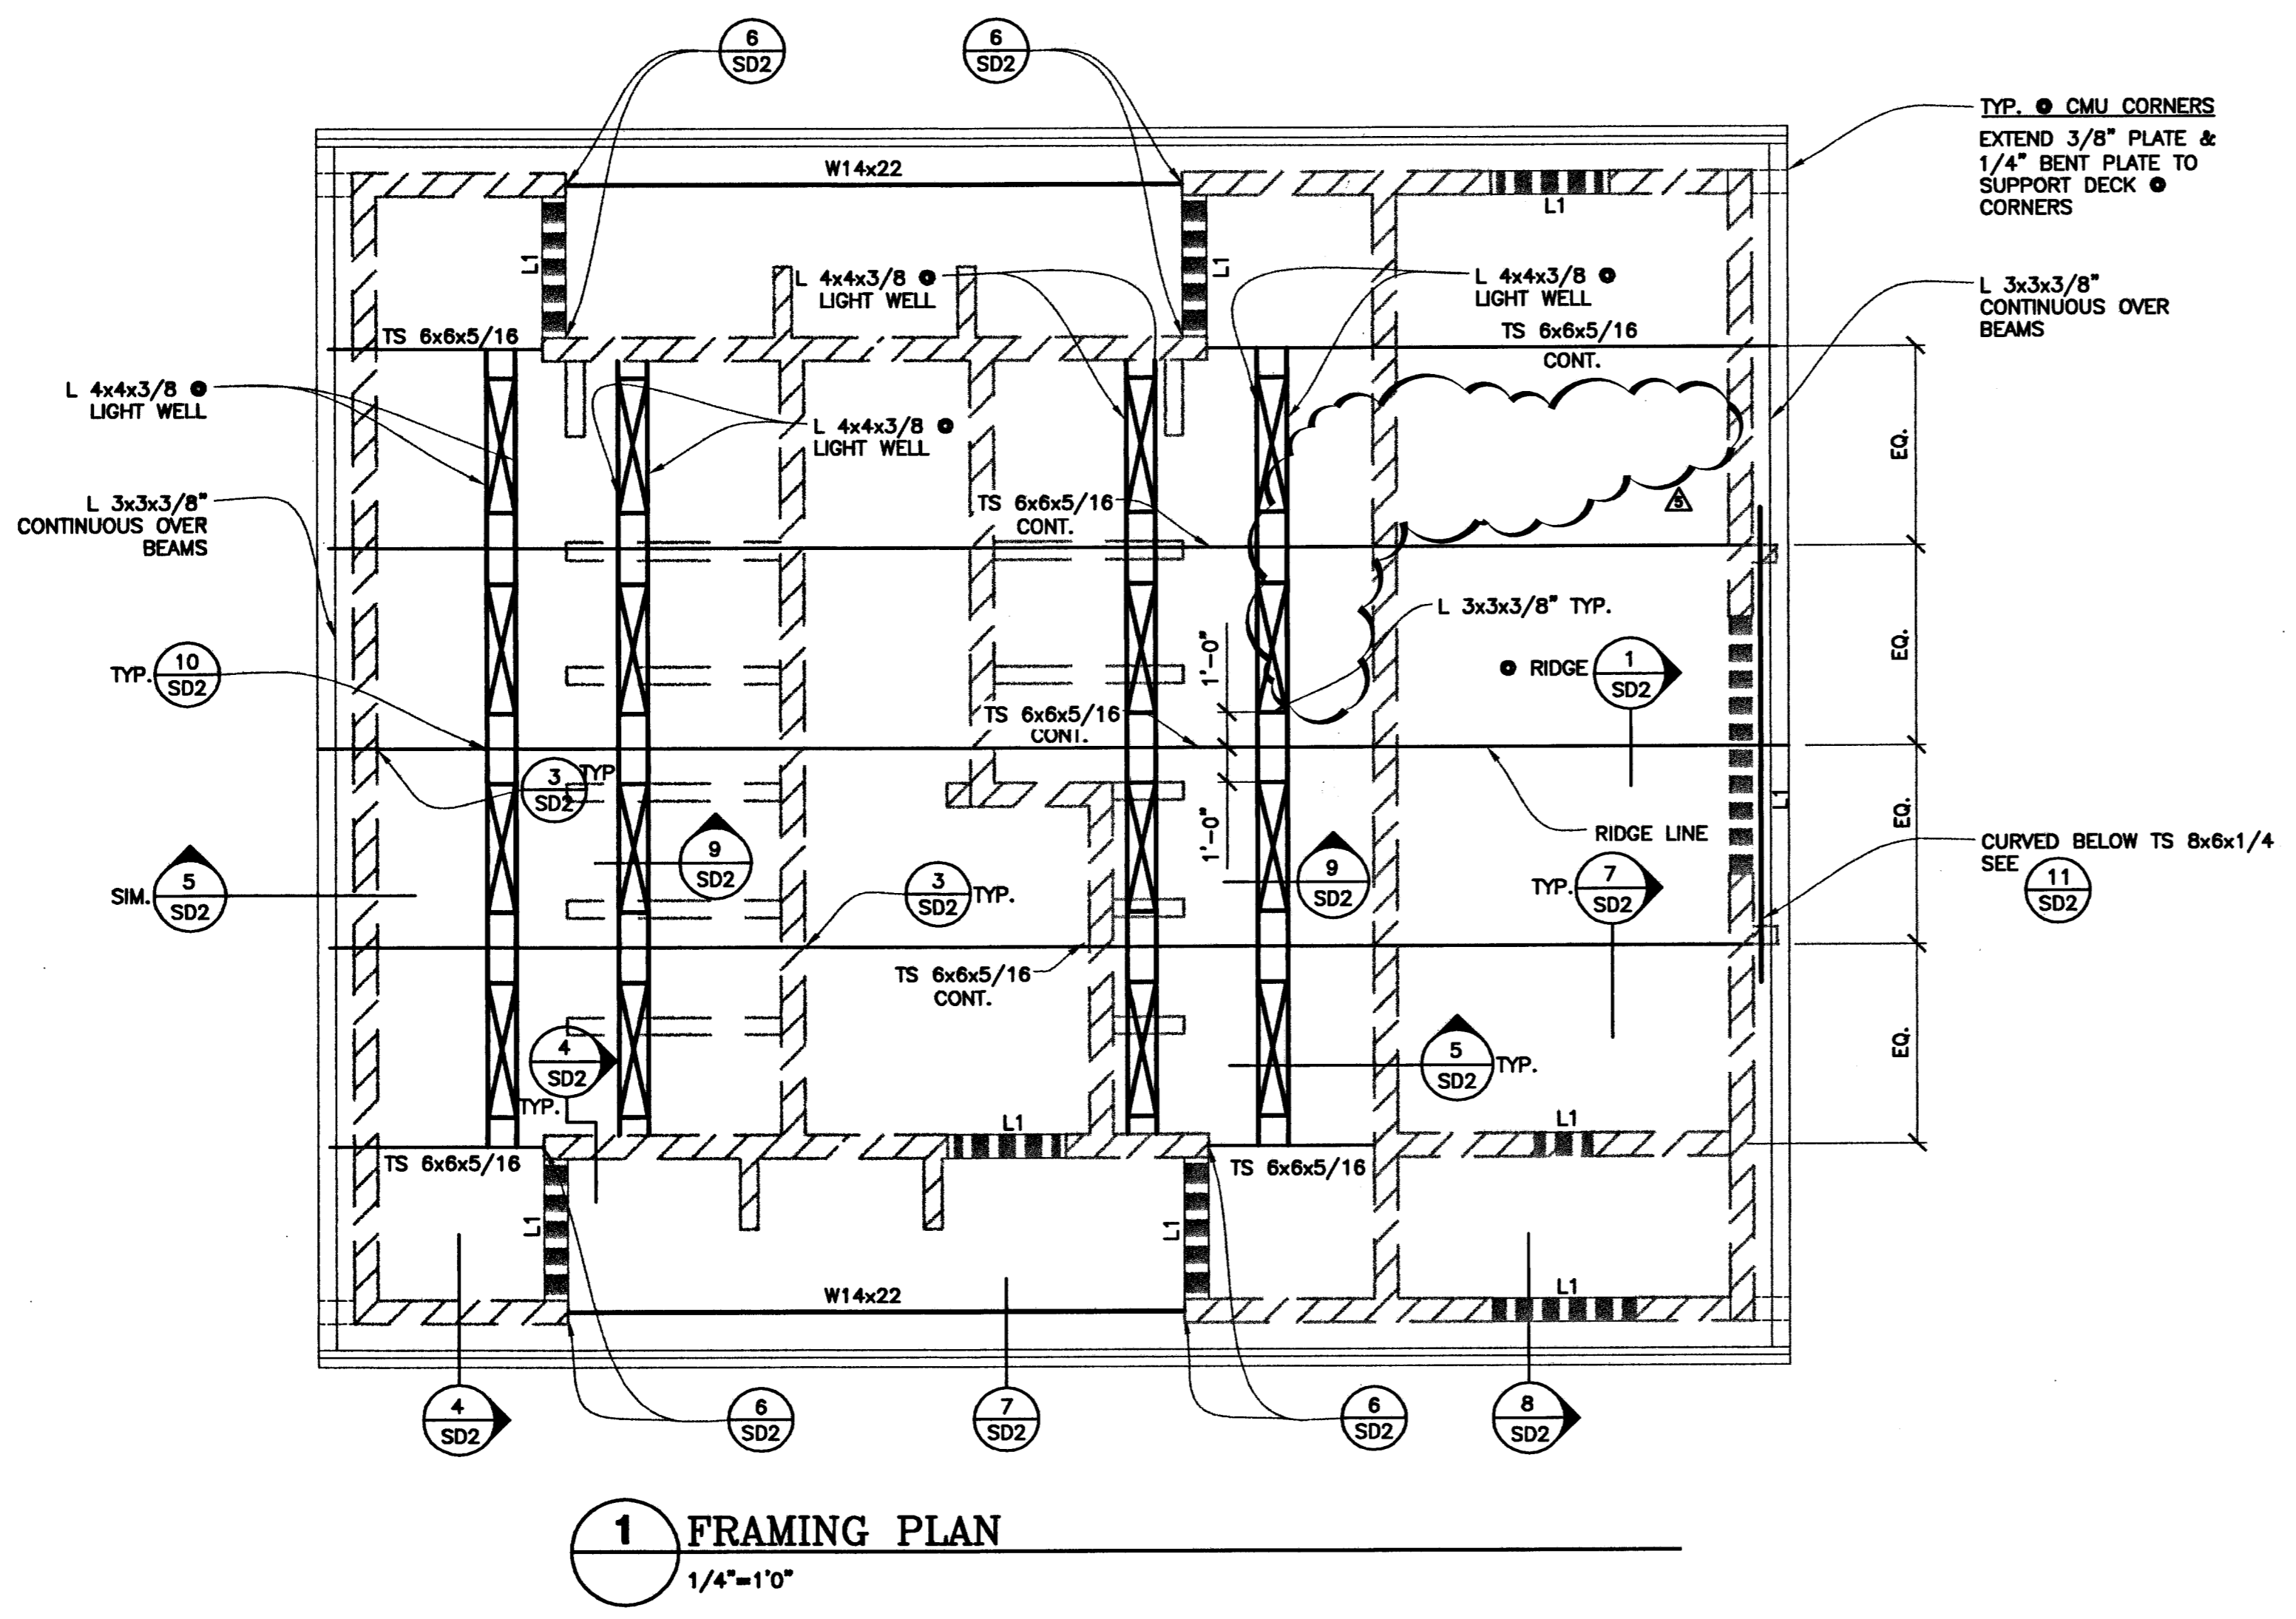

REVISIONS

7/25/08 AS BUILT CONDITIONS

CONSULTANT

**DEUC INC.**  
 2800 SO. RANCHO RD.  
 LAS VEGAS, NEVADA 89102  
 (702) 971-5154  
 (702) 971-0814

**BONANZA-SANDHILL PARK**  
 Concession Building

**ROOF FRAMING PLAN**

STAMP

OWNER: CITY OF LAS VEGAS  
 DEPARTMENT OF PUBLIC WORKS  
 ARCHITECTURAL SERVICES

400 EAST STEWART AVENUE  
 LAS VEGAS, NEVADA 89101  
 PHONE: (702) 229-5535  
 FAX: (702) 882-8232  
 TDD: (702) 886-9108

DRAWN: ALM  
 FILE:  
 DATE: 3-5-08  
 SCALE: NONE  
 BID NO: 2235407  
 ELEVATION: 25000  
 54

**RCB-S3.0**

66607