

REVISIONS	7/REV. 2
	1-20-00 DIMED REVISIONS
	7/REV. 3 AS BUILT CONDITIONS

DEC INC.

2800 SO. RANCHO RD.
LAS VEGAS, NEVADA 89102
(702) 871-6164
FAX#-898116

BONANZA-SANDHILL PARK
Concession Building

FOUNDATION DETAILS SHEET

STAMP

OWNER: CITY OF LAS VEGAS
DEPARTMENT OF PUBLIC WORKS
ARCHITECTURAL SERVICES

400 EAST STEWART AVENUE
LAS VEGAS, NEVADA 89103
PHONE: (702) 226-5533
FAX: (702) 382-8333
TDD: (702) 386-9108

DRAWN: ALM

FILE

DATE: 3-16-02

SCALE: NONE

REV: 01

REV: 02

REV: 03

REV: 04

REV: 05

REV: 06

REV: 07

REV: 08

REV: 09

REV: 10

REV: 11

REV: 12









REV: 13

REV: 14

REV: 15

REV: 16

REV: 17

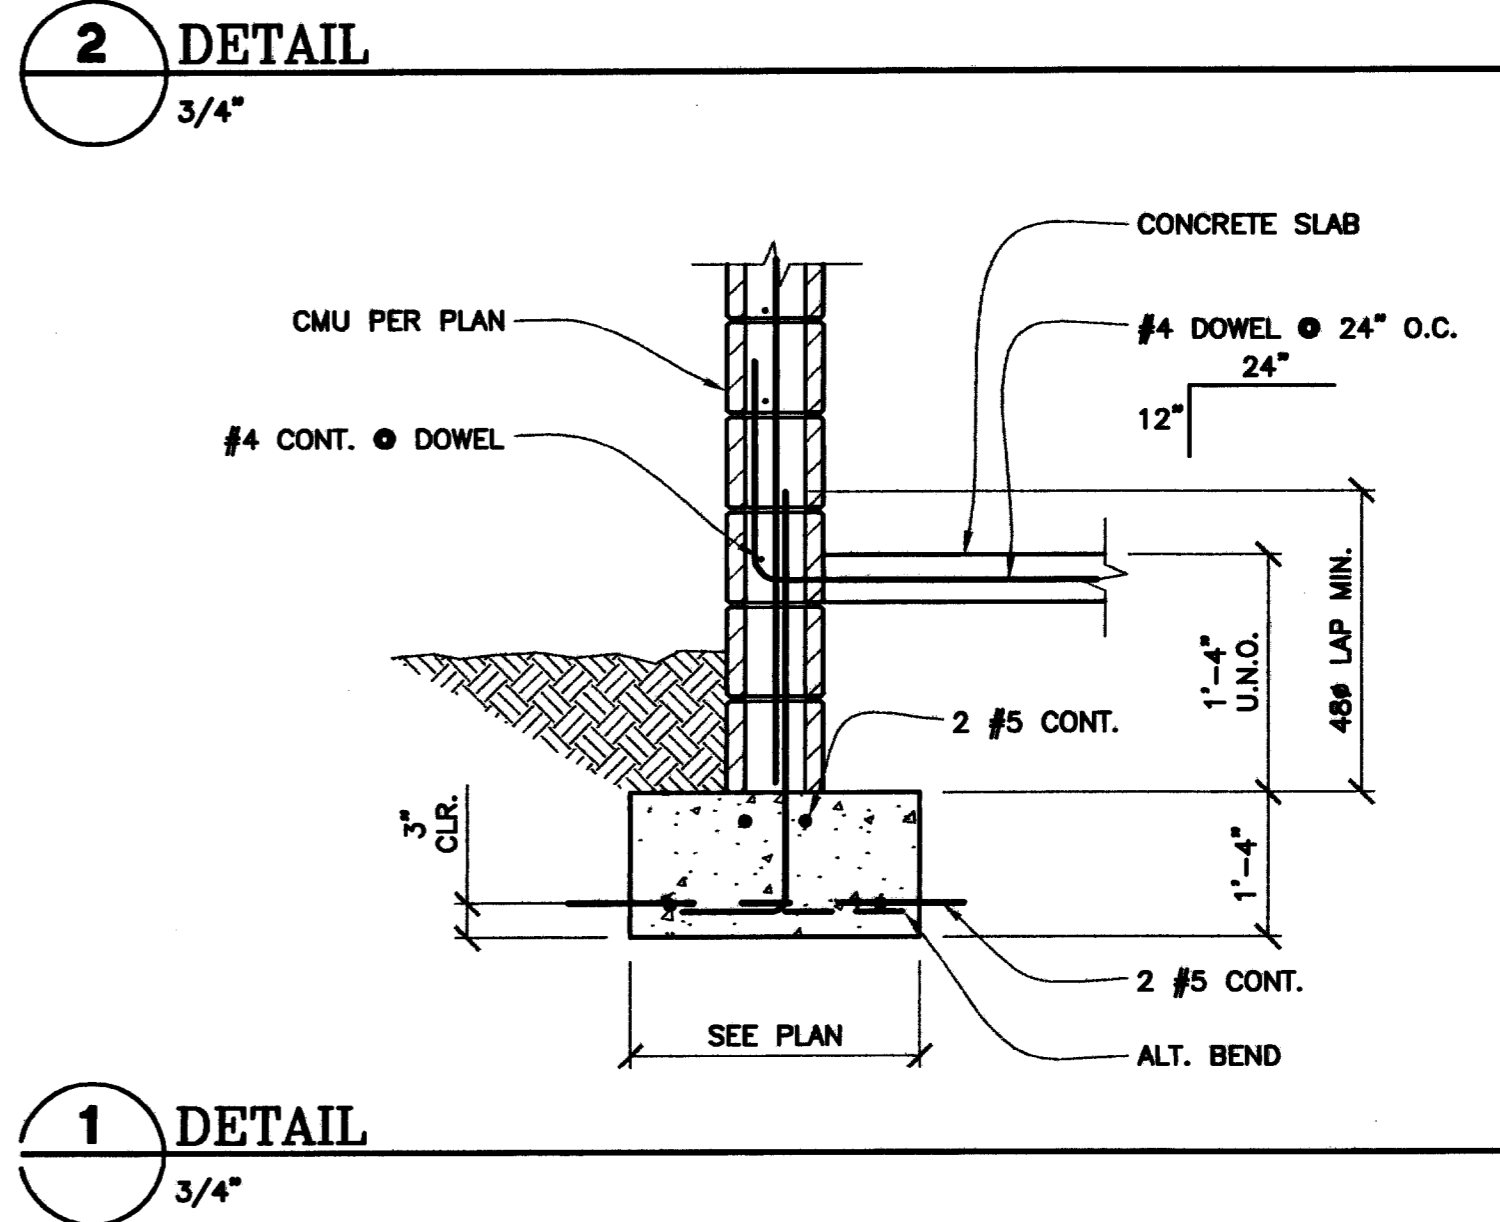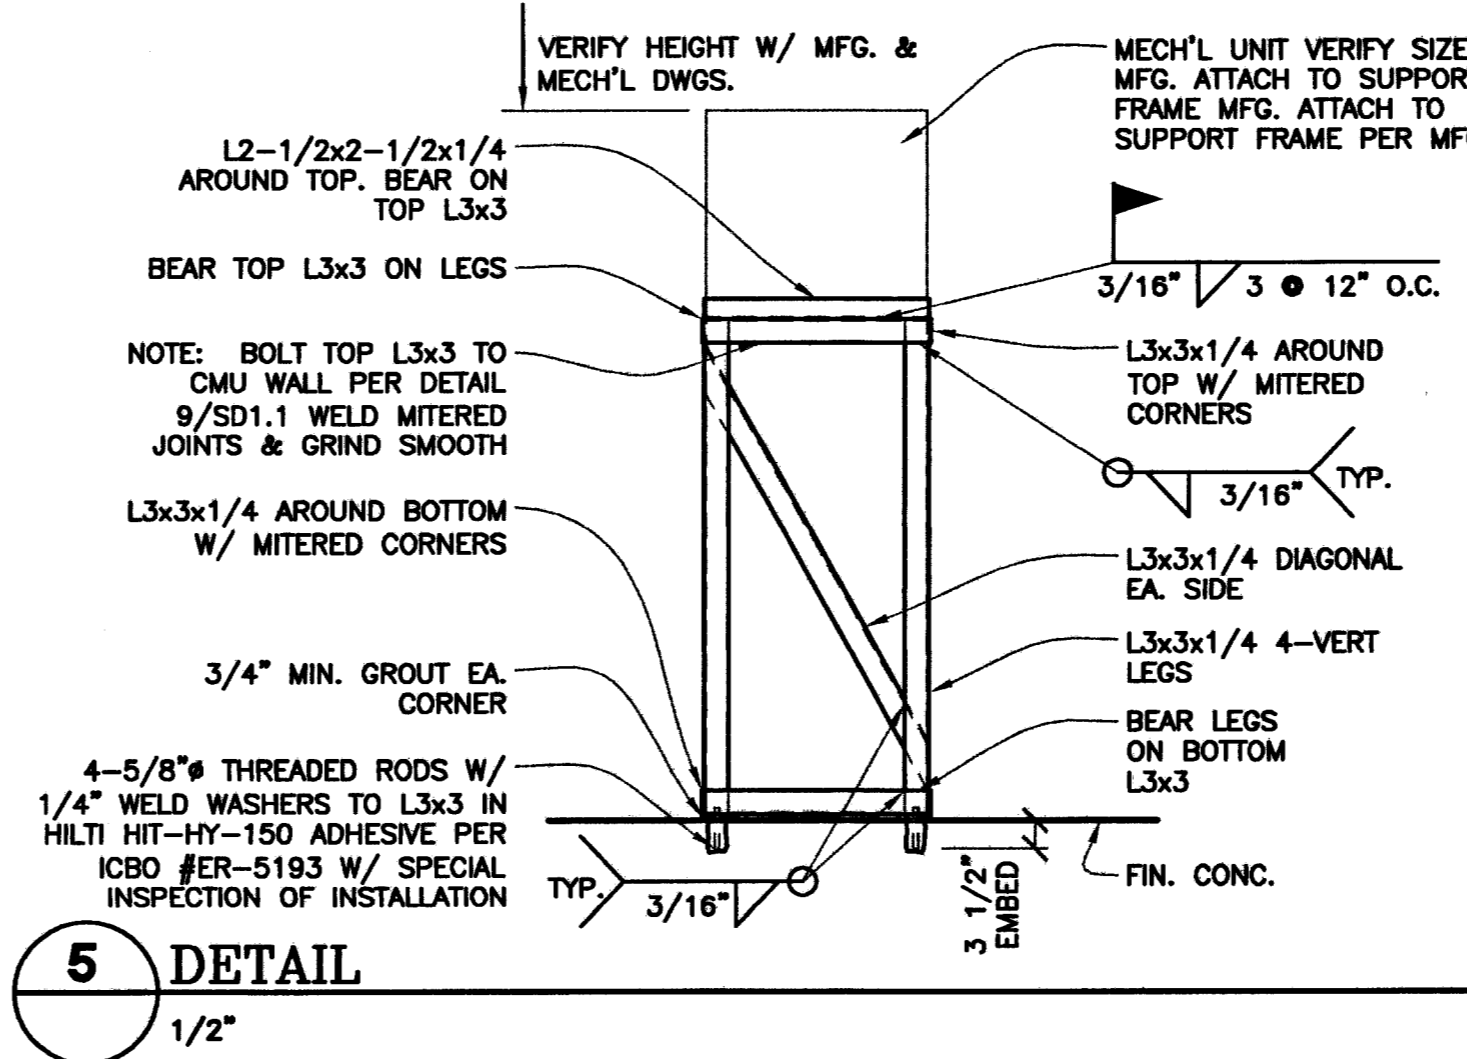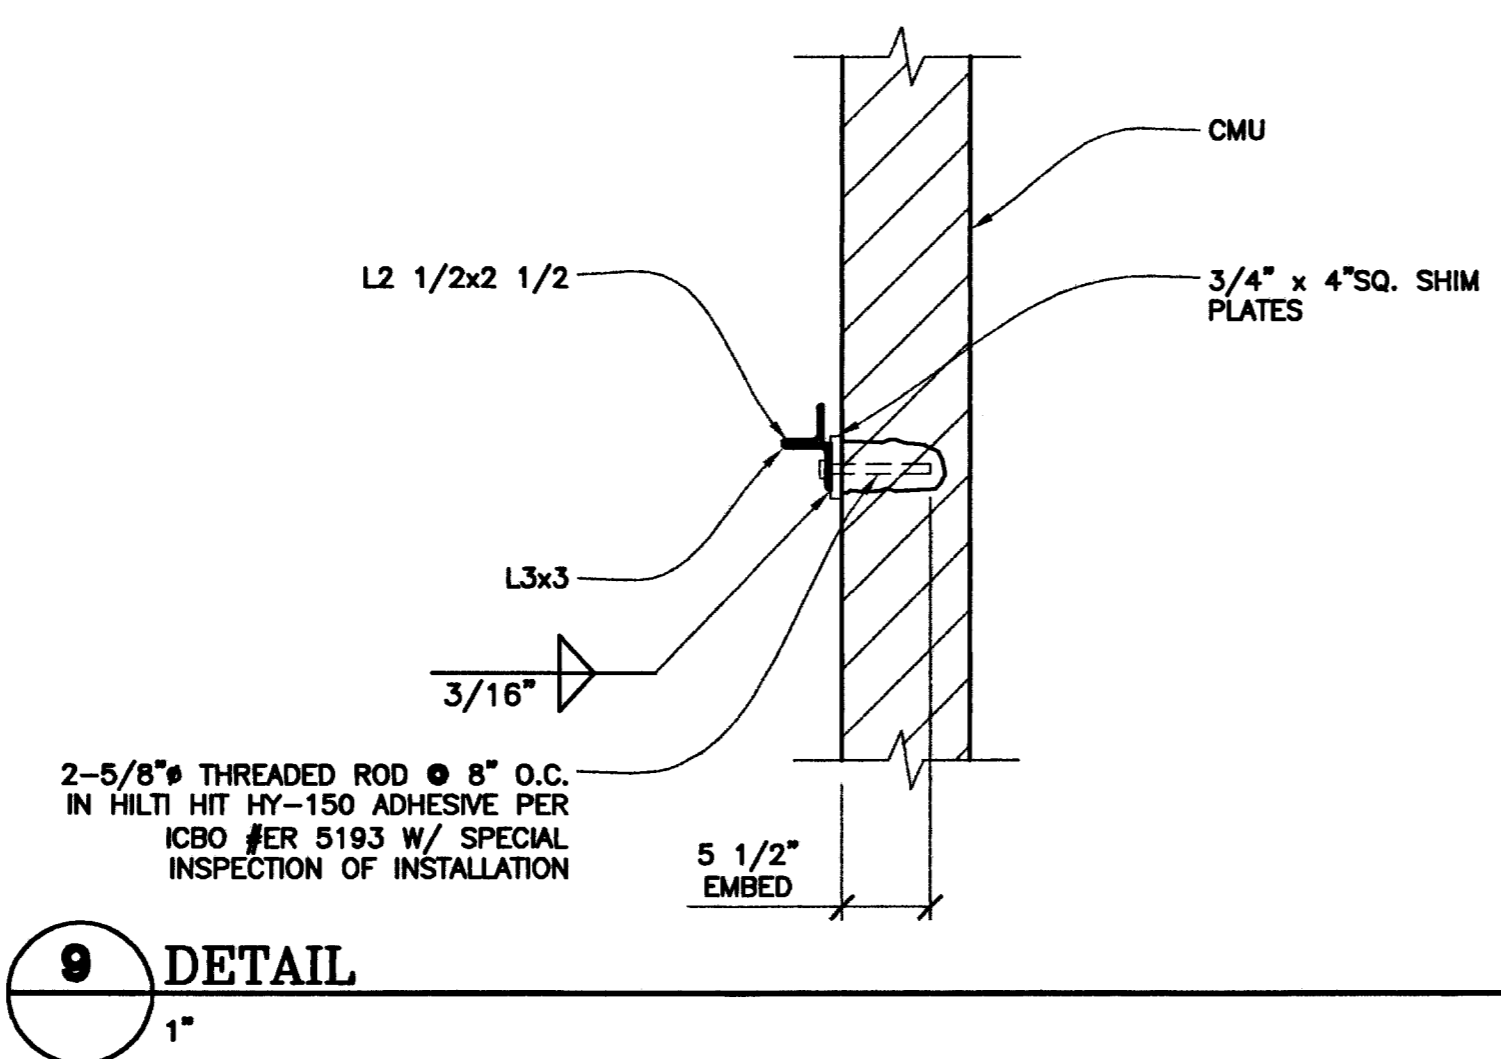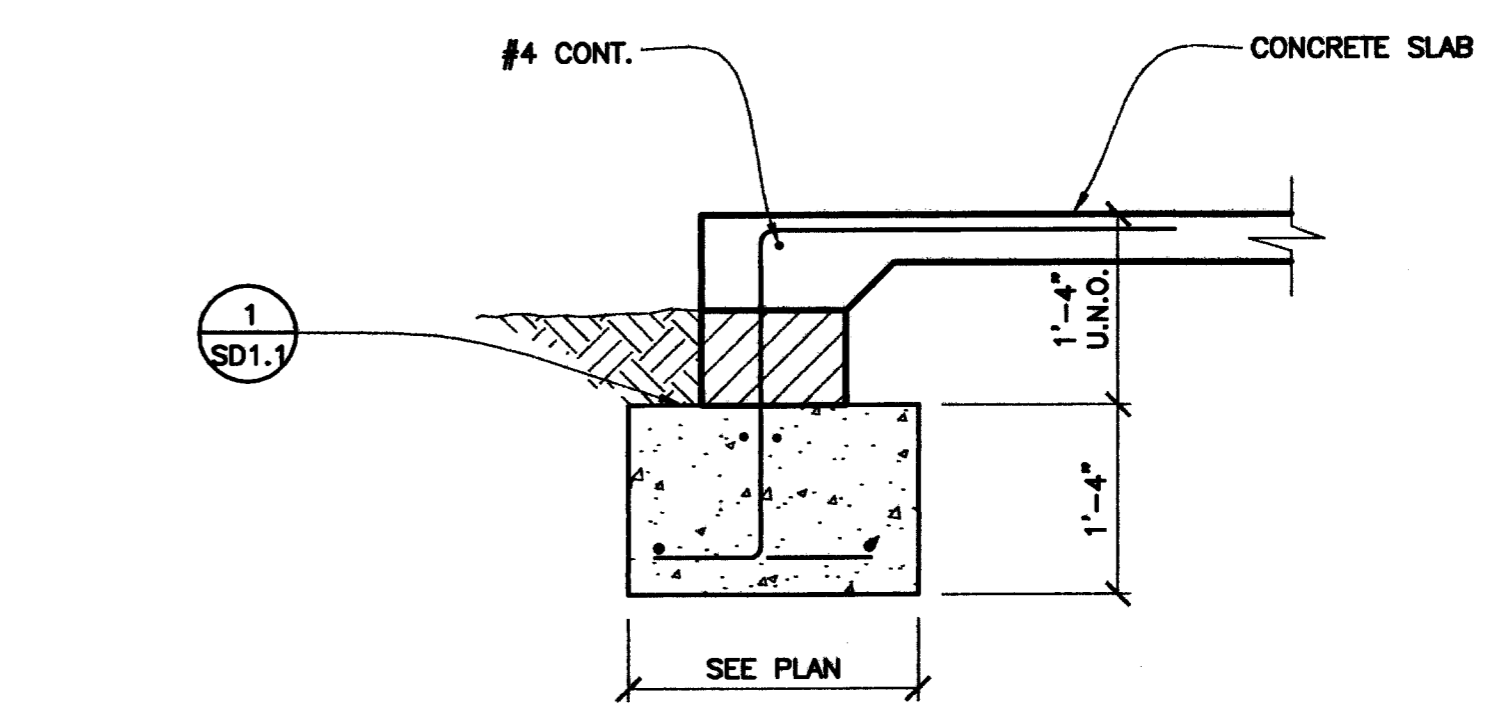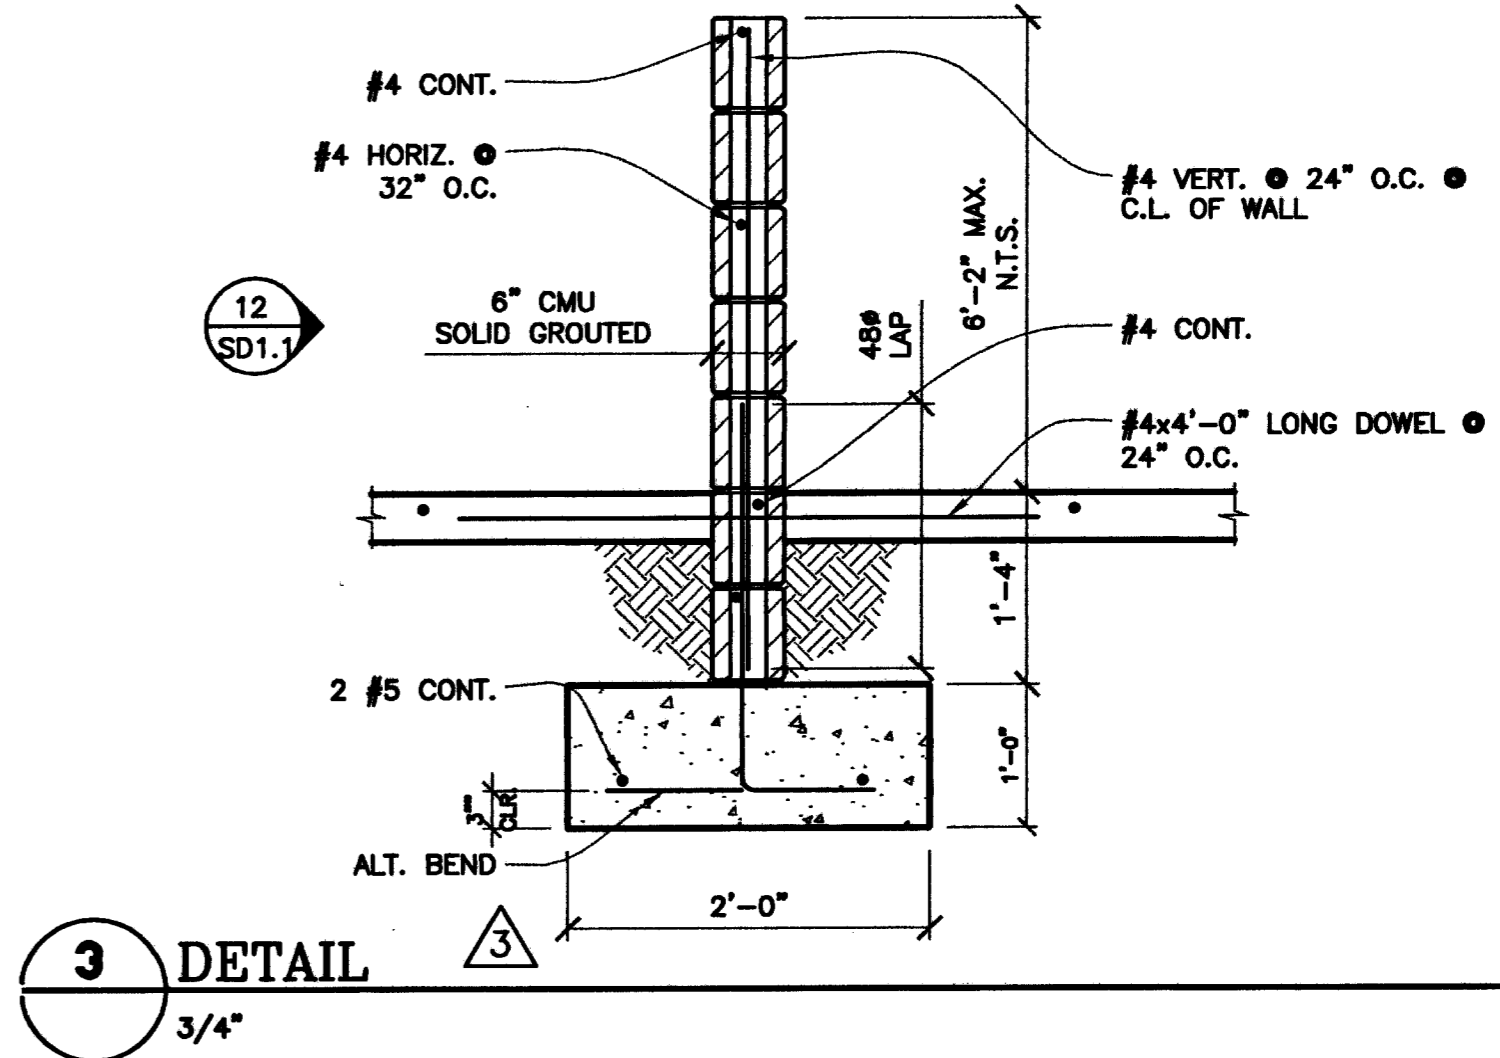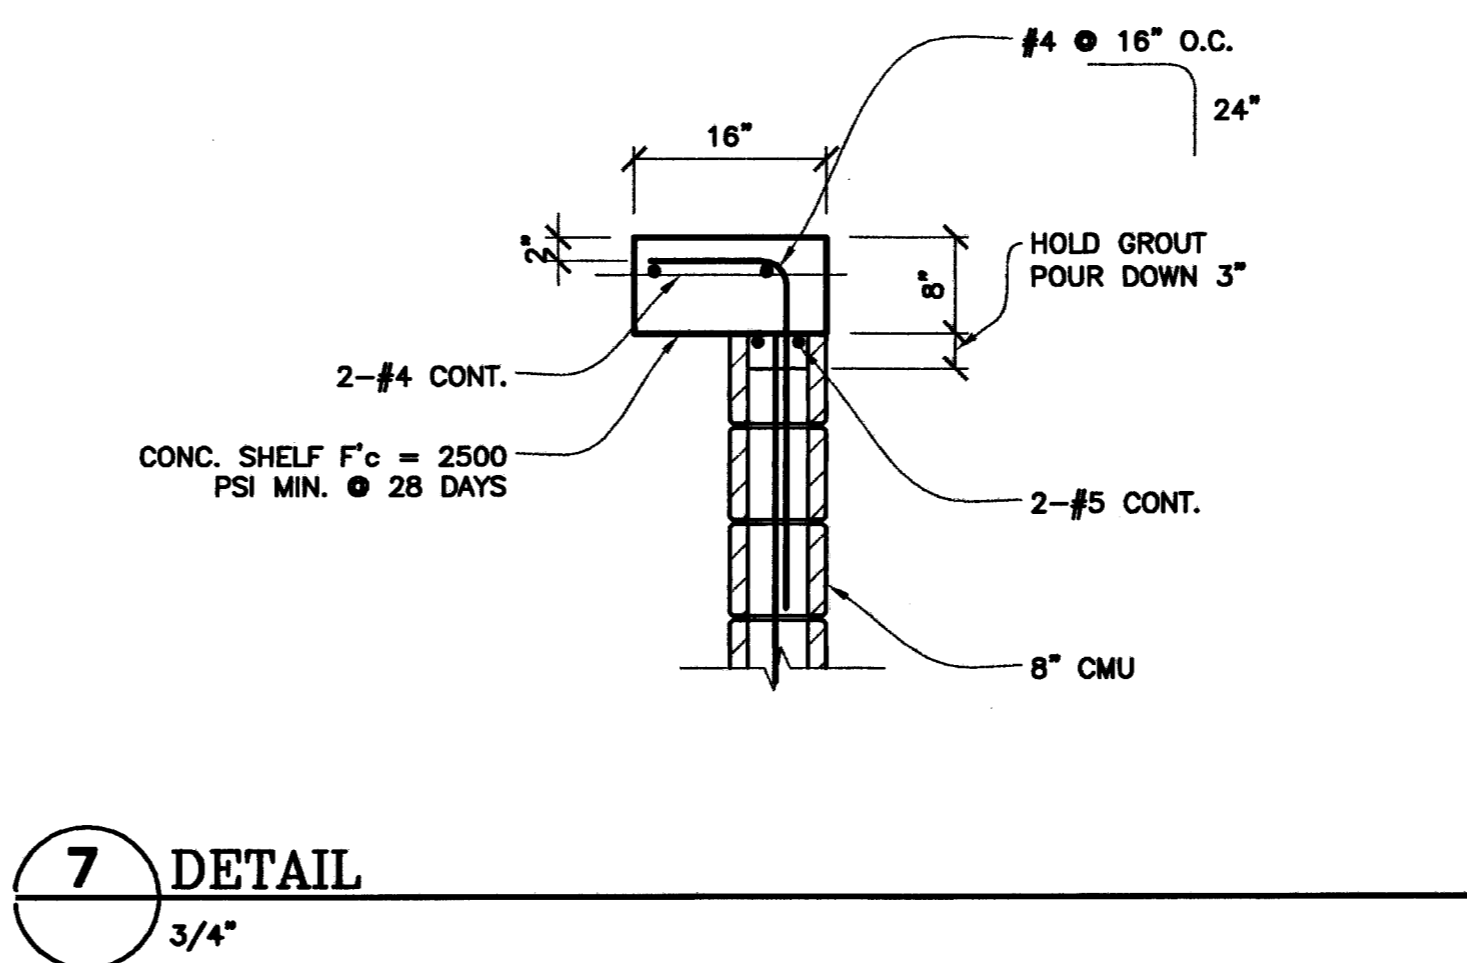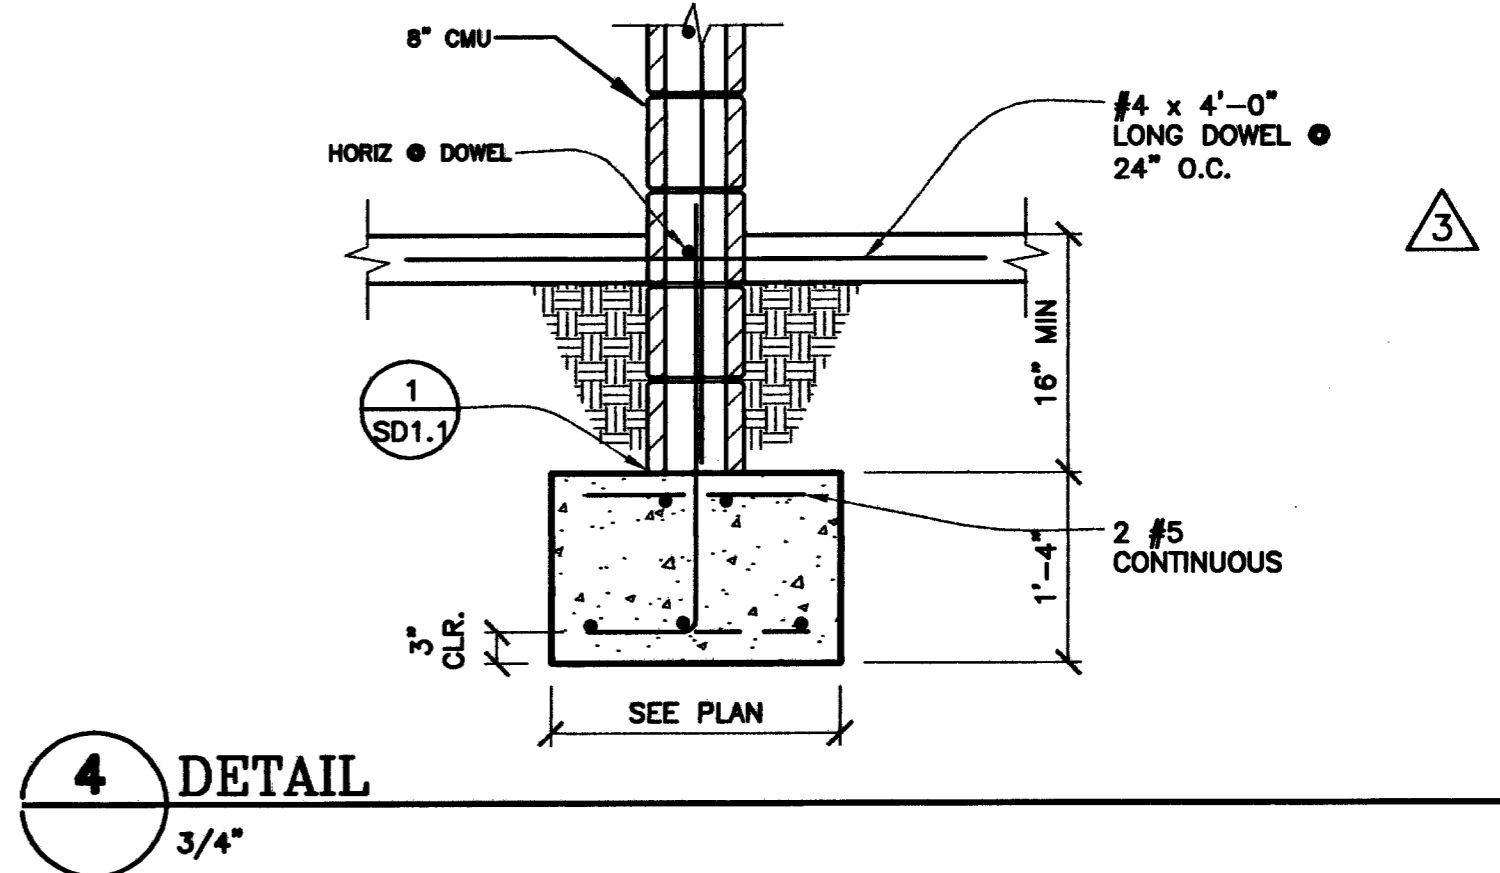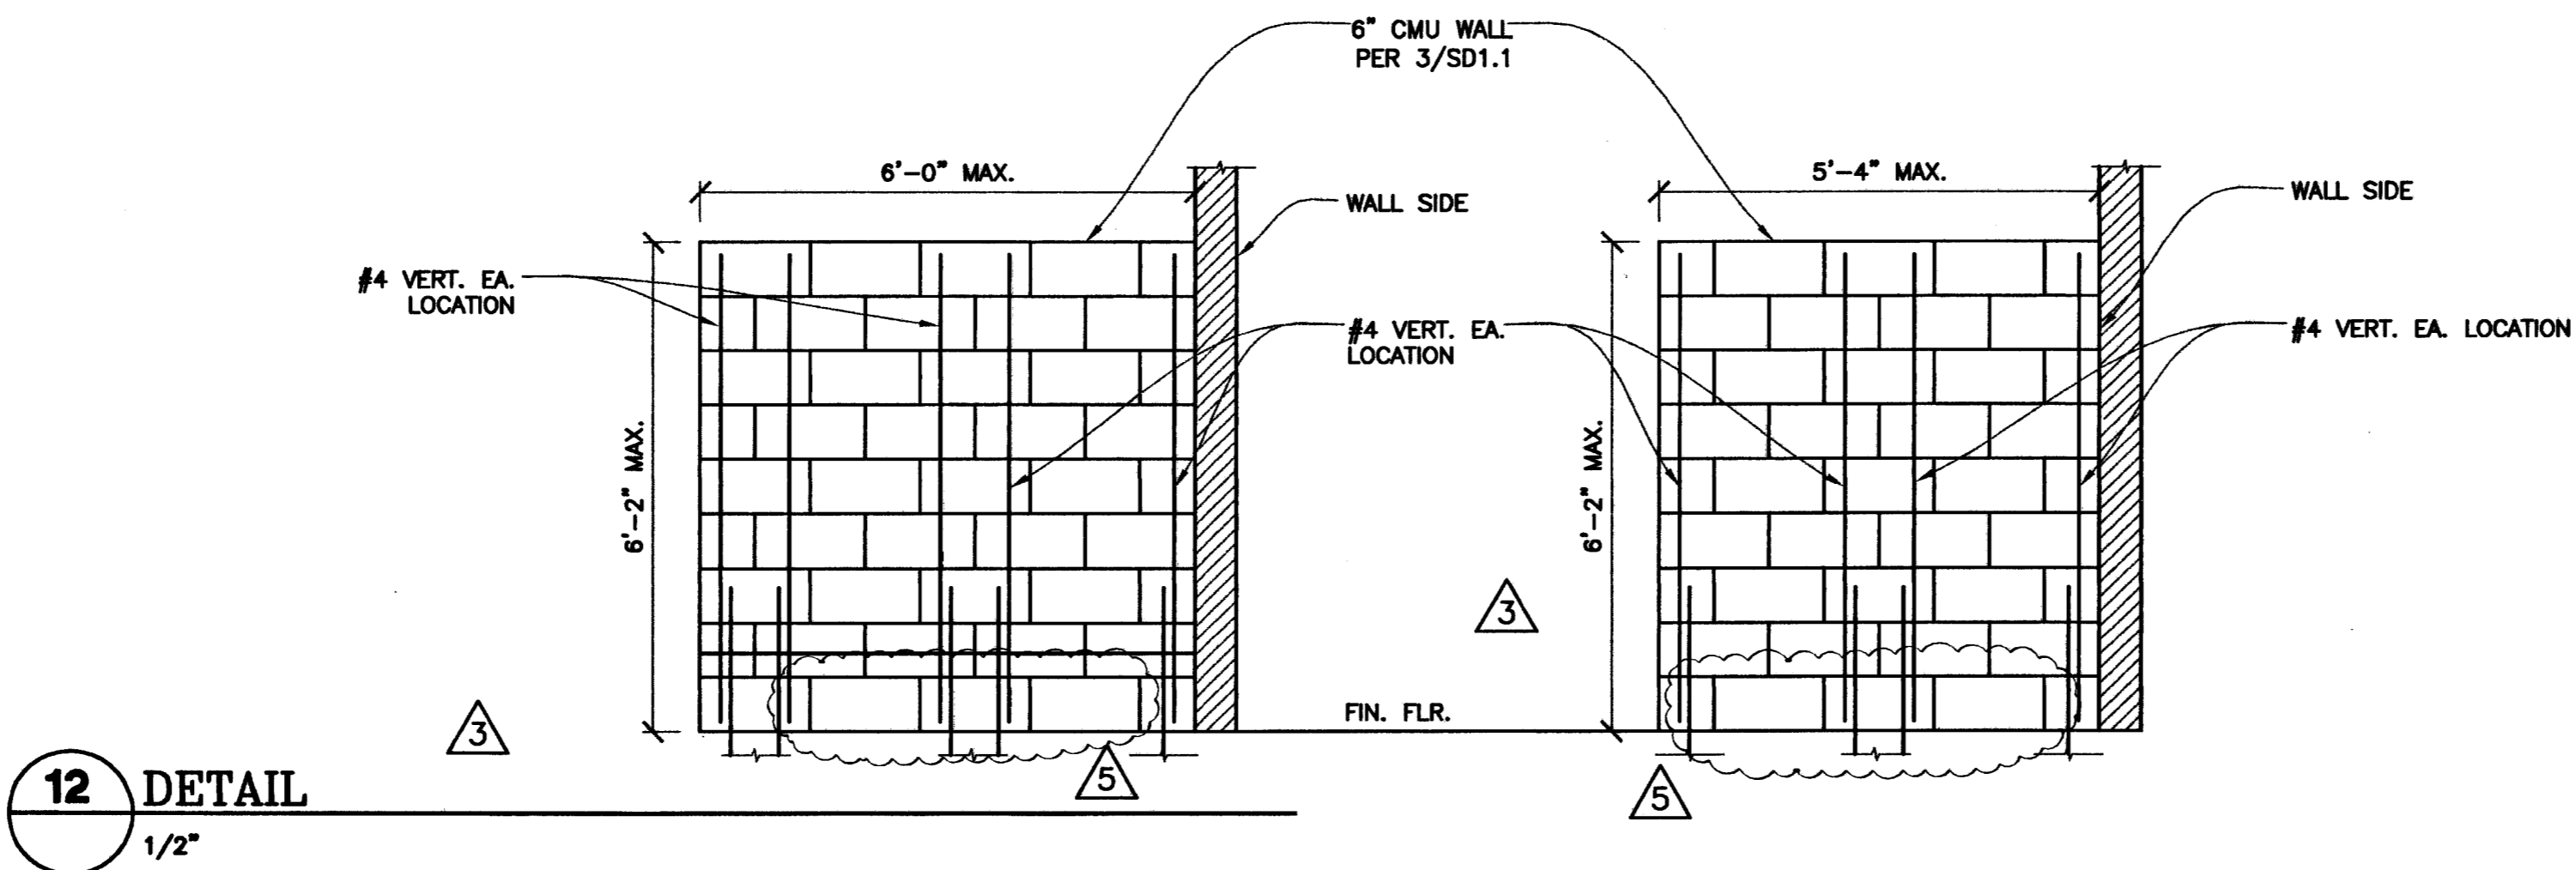

66609