



REVISIONS
 1/2/16
 4-08-09 CONTRACTOR RFTS
 7/25/10 AS BUILT CONDITIONS

CONSULTANT
DEUC INC.
 2800 SO. RANCHO RD.
 LAS VEGAS, NEVADA 89102
 (702) 871-5154
 JOB#- 080116


BONANZA-SANDHILL PARK
 Concession Building
 ROOF DETAILS

OWNER: CITY OF LAS VEGAS
 DEPARTMENT OF PUBLIC WORKS
 ARCHITECTURAL SERVICES


400 EAST STEWART AVENUE
 LAS VEGAS, NEVADA 89101
 PHONE: (702) 229-8538
 FAX: (702) 882-8232
 TDD: (702) 386-8108

DRAWN	ALH
FILE	
DATE	8-18-07
SCALE	NONE
REV NO	02,03,04,01
CLV DWG NO	00000
REV NO	57


RCB-SD2

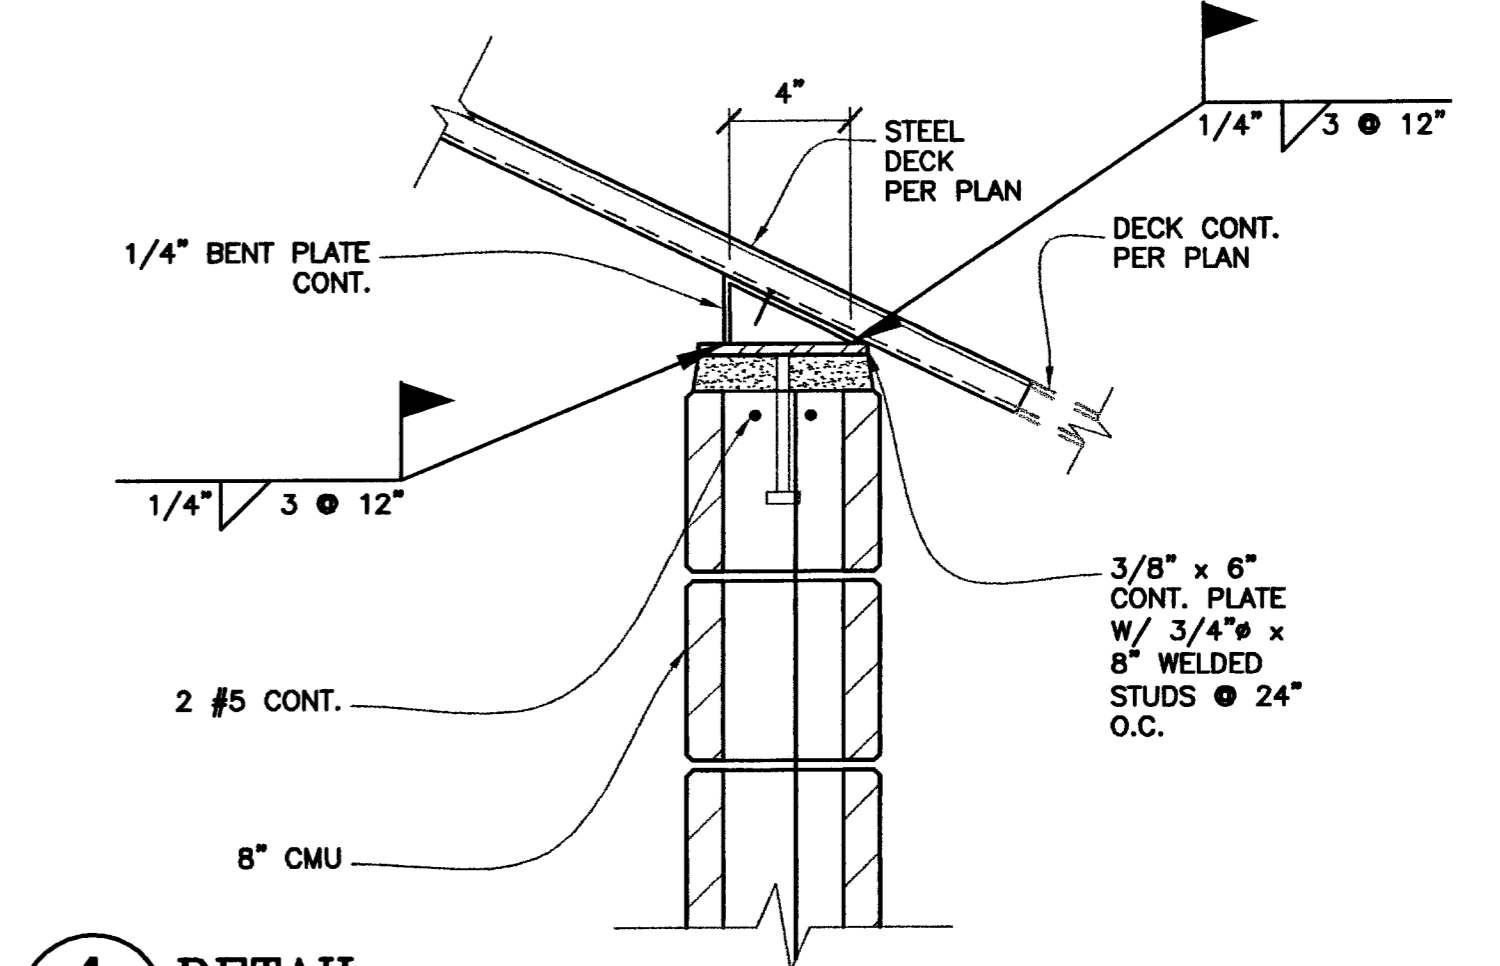


4 DETAIL
 1 1/2"

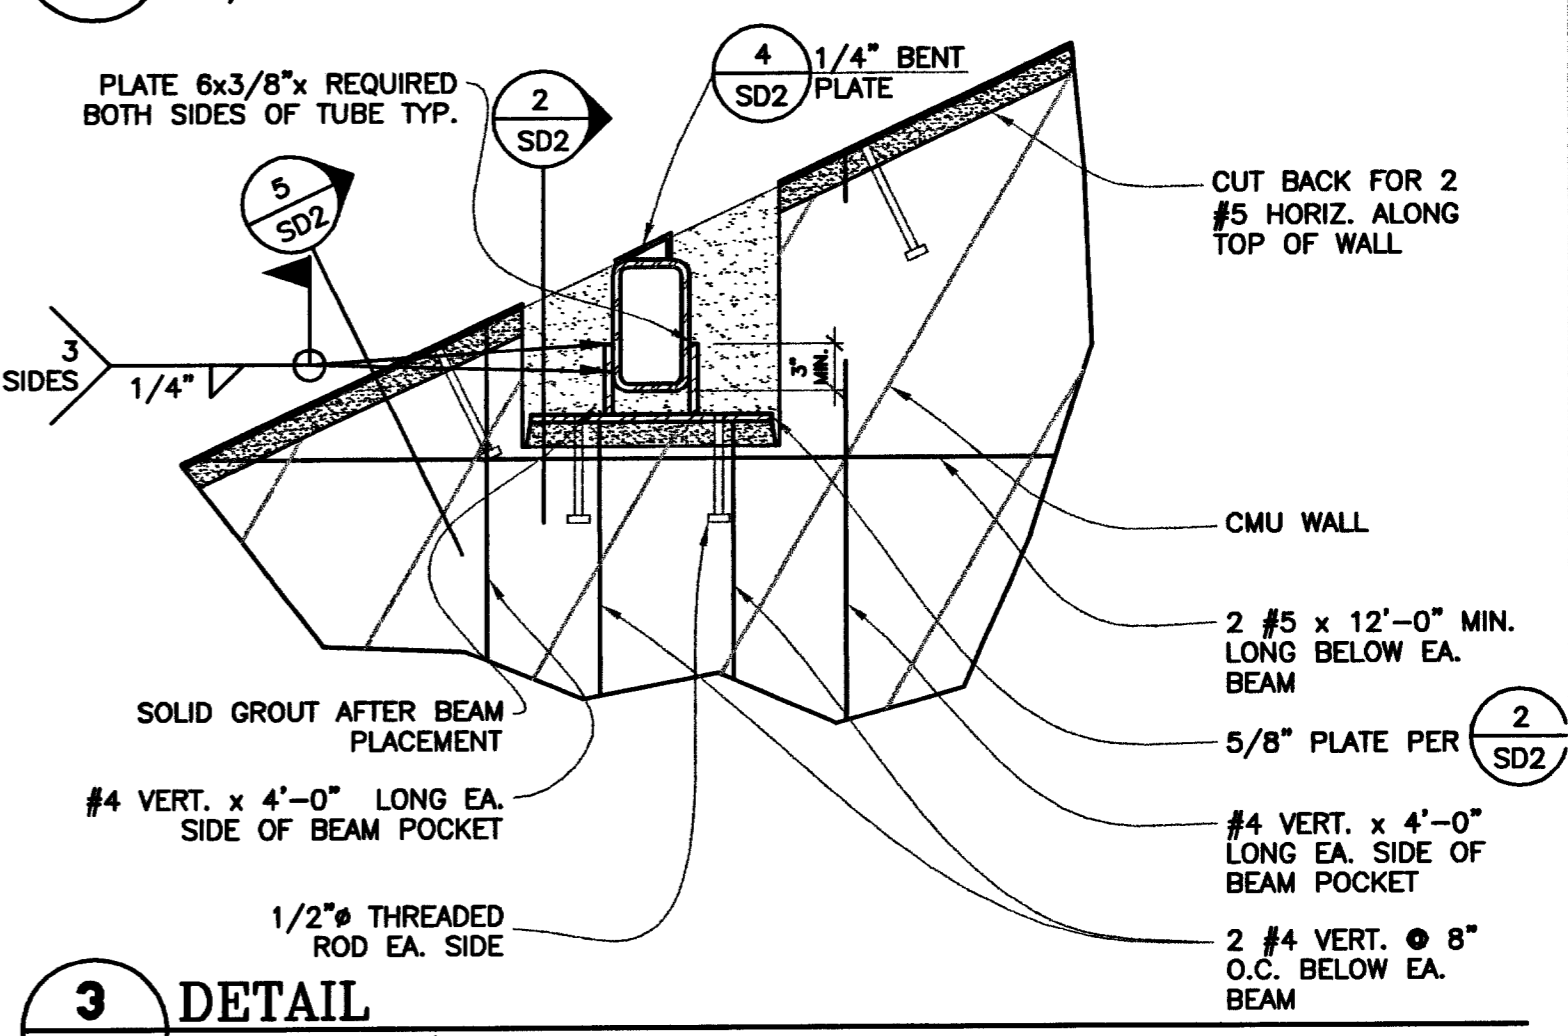


3 DETAIL
 1"

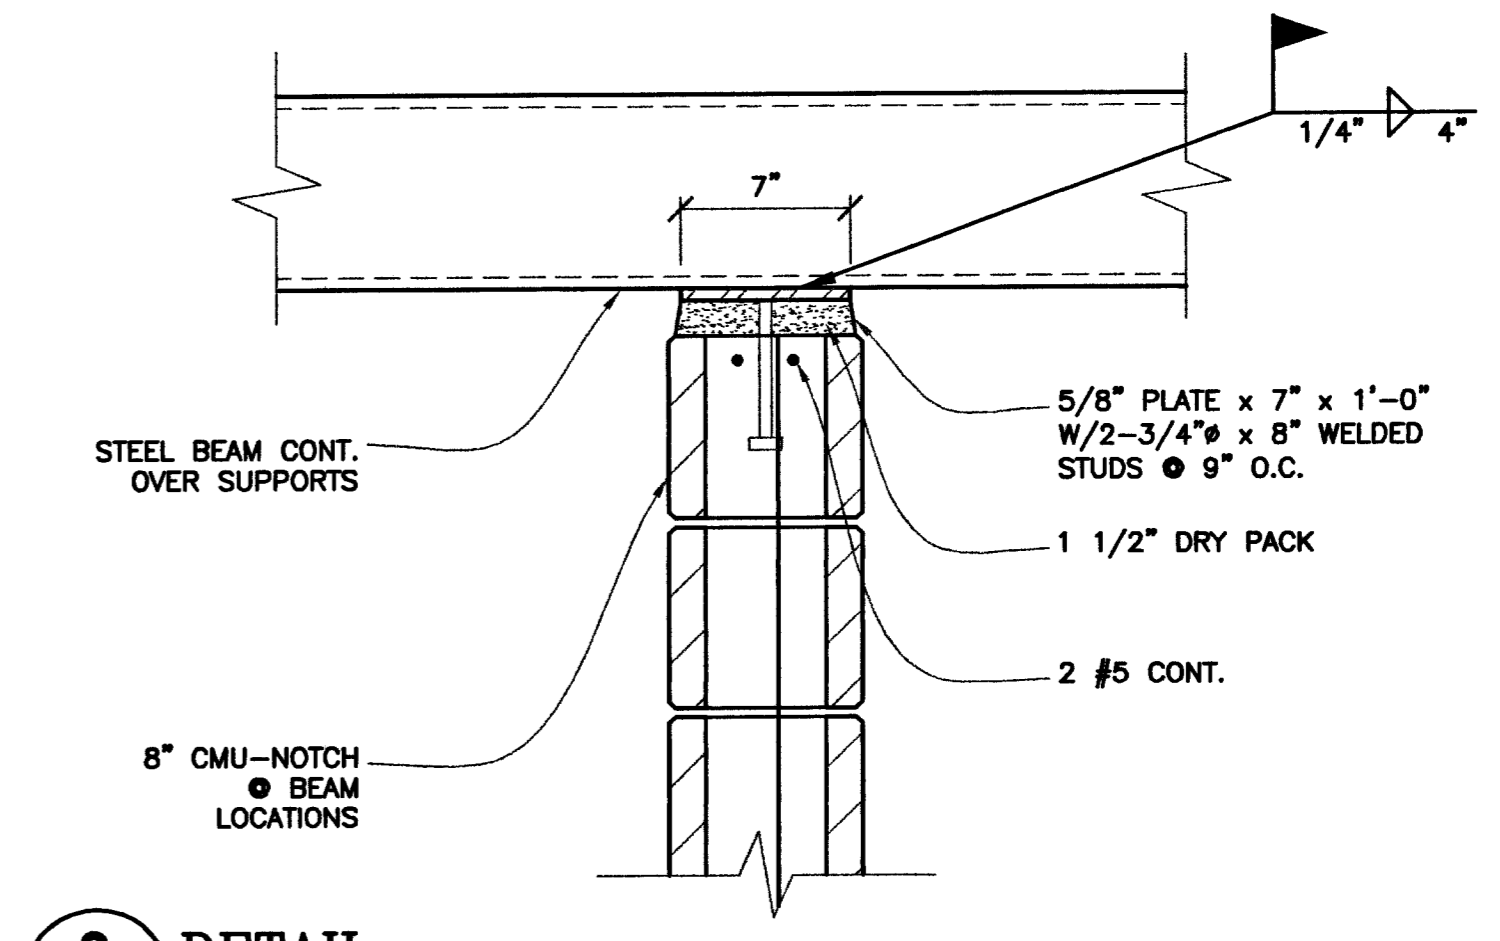


2 DETAIL
 1 1/2"

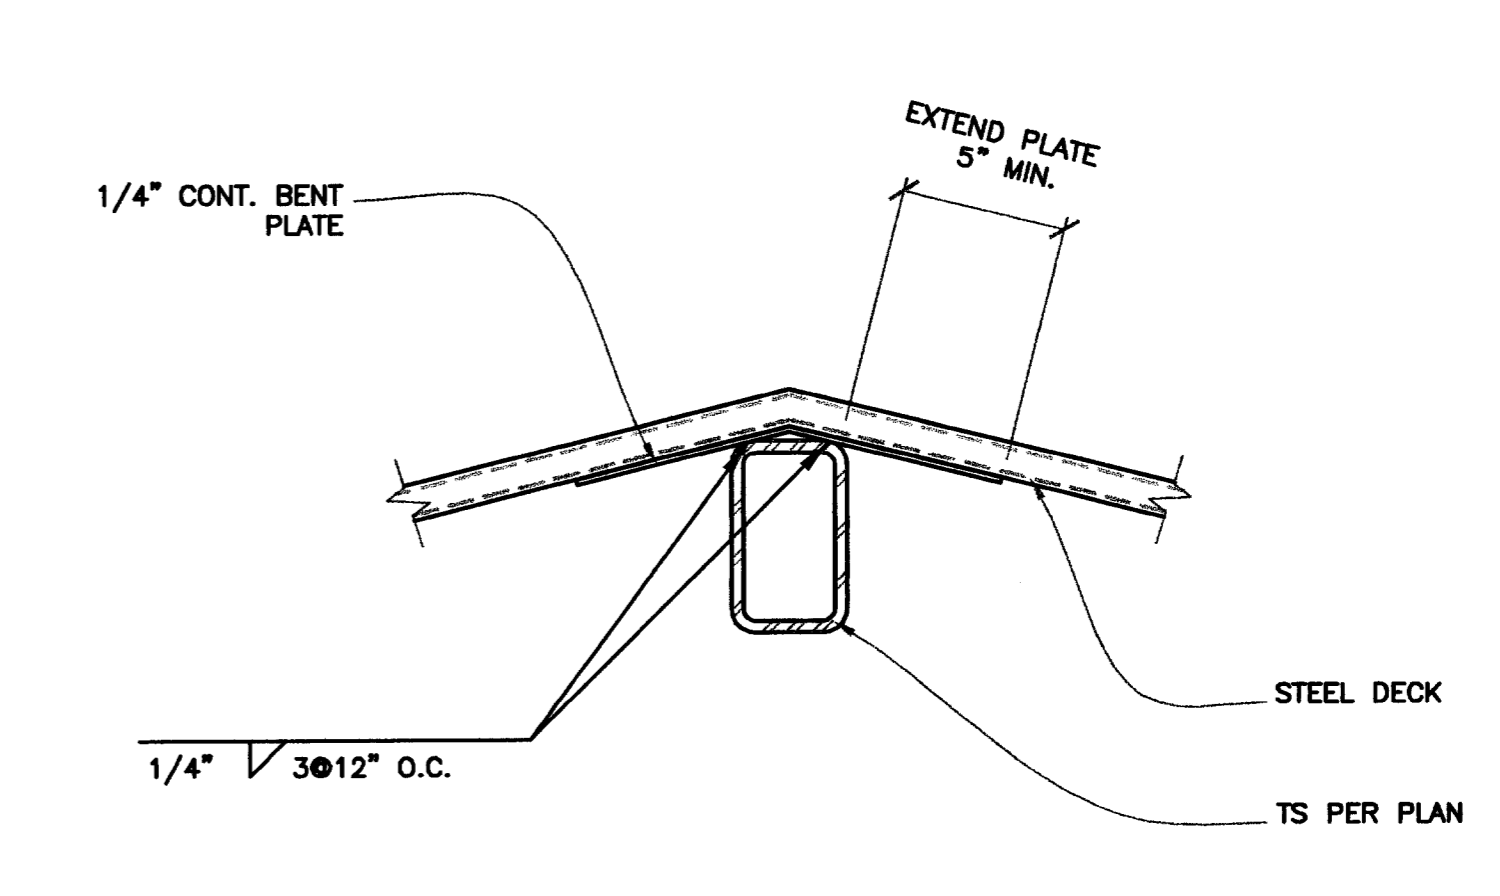


1 DETAIL
 1 1/2"

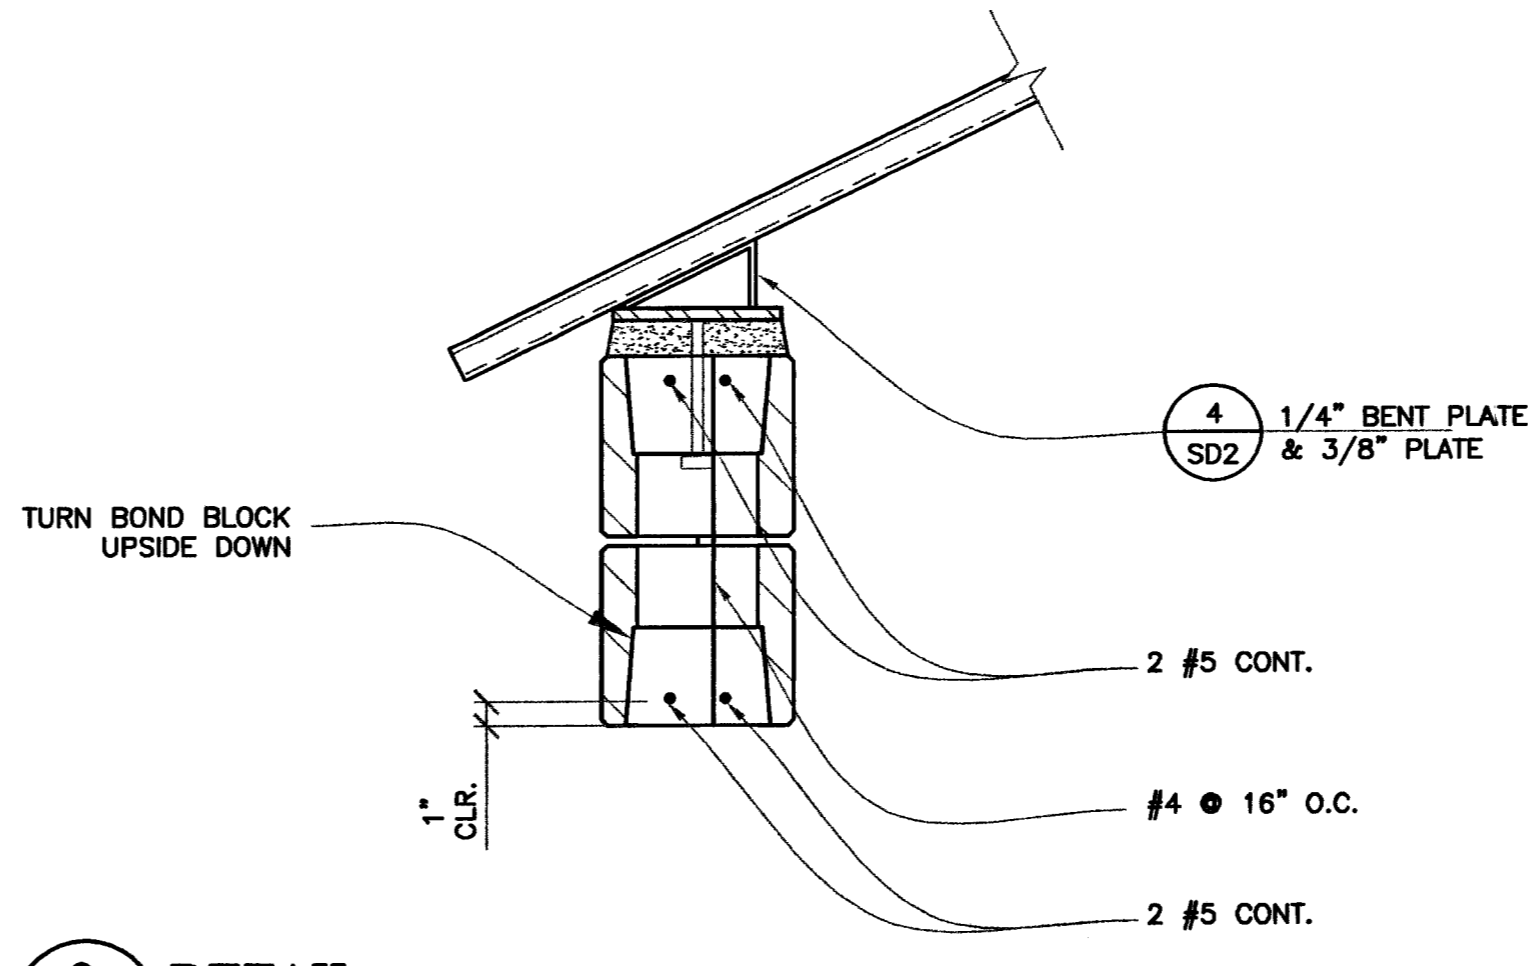


8 DETAIL
 1 1/2"

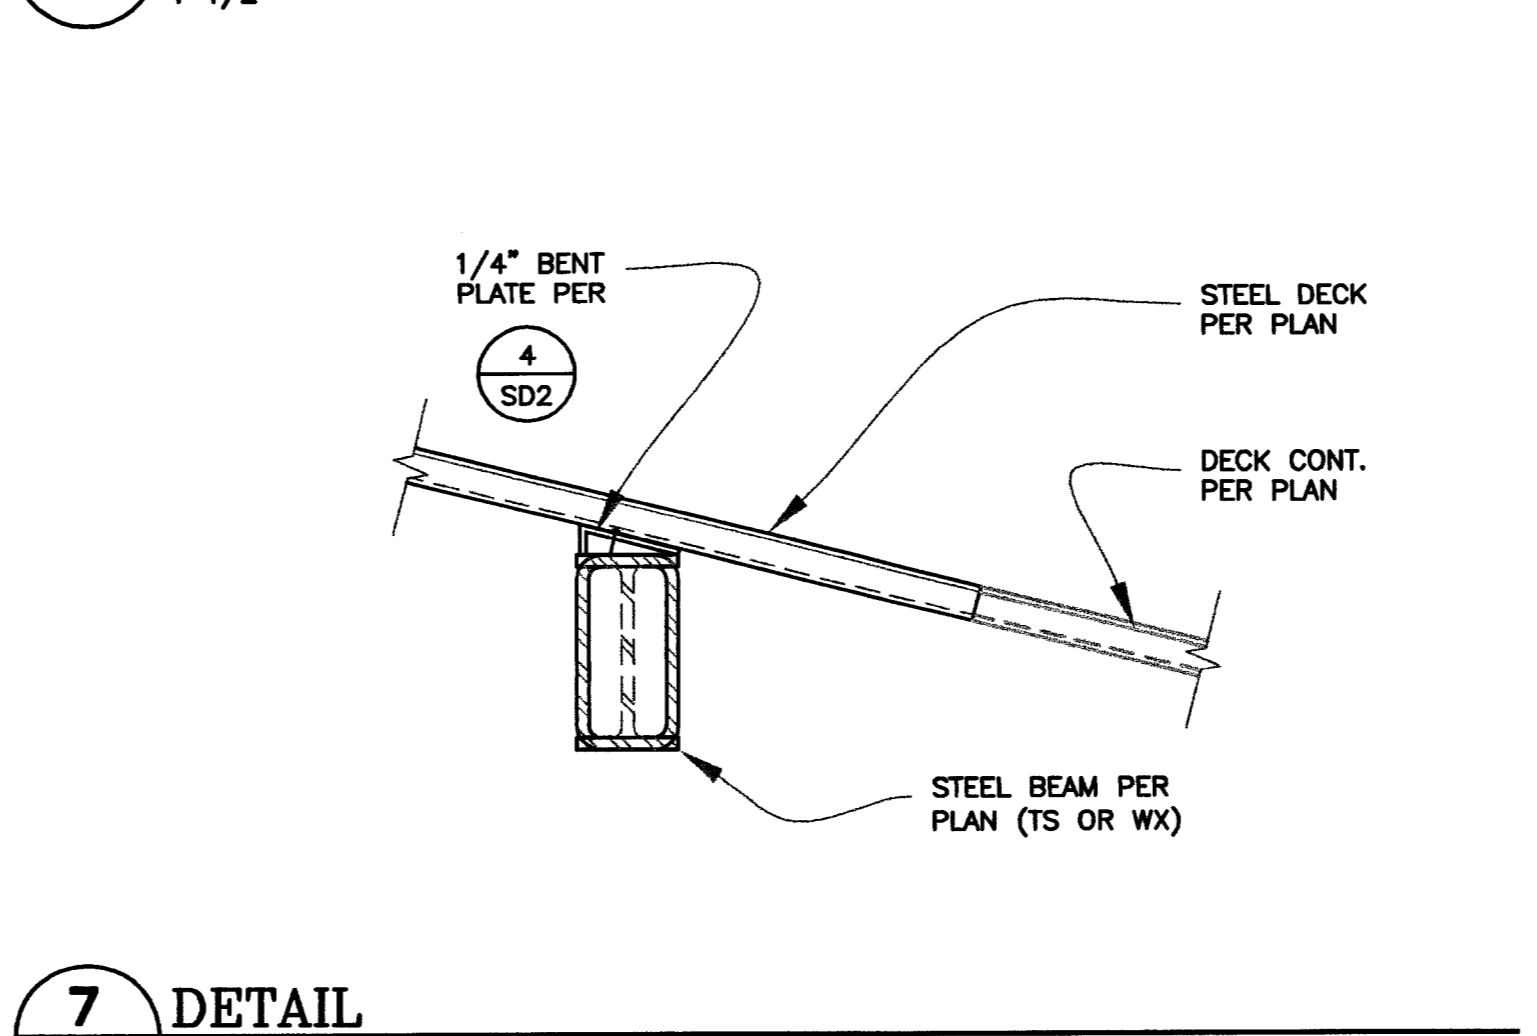


7 DETAIL
 1 1/2"

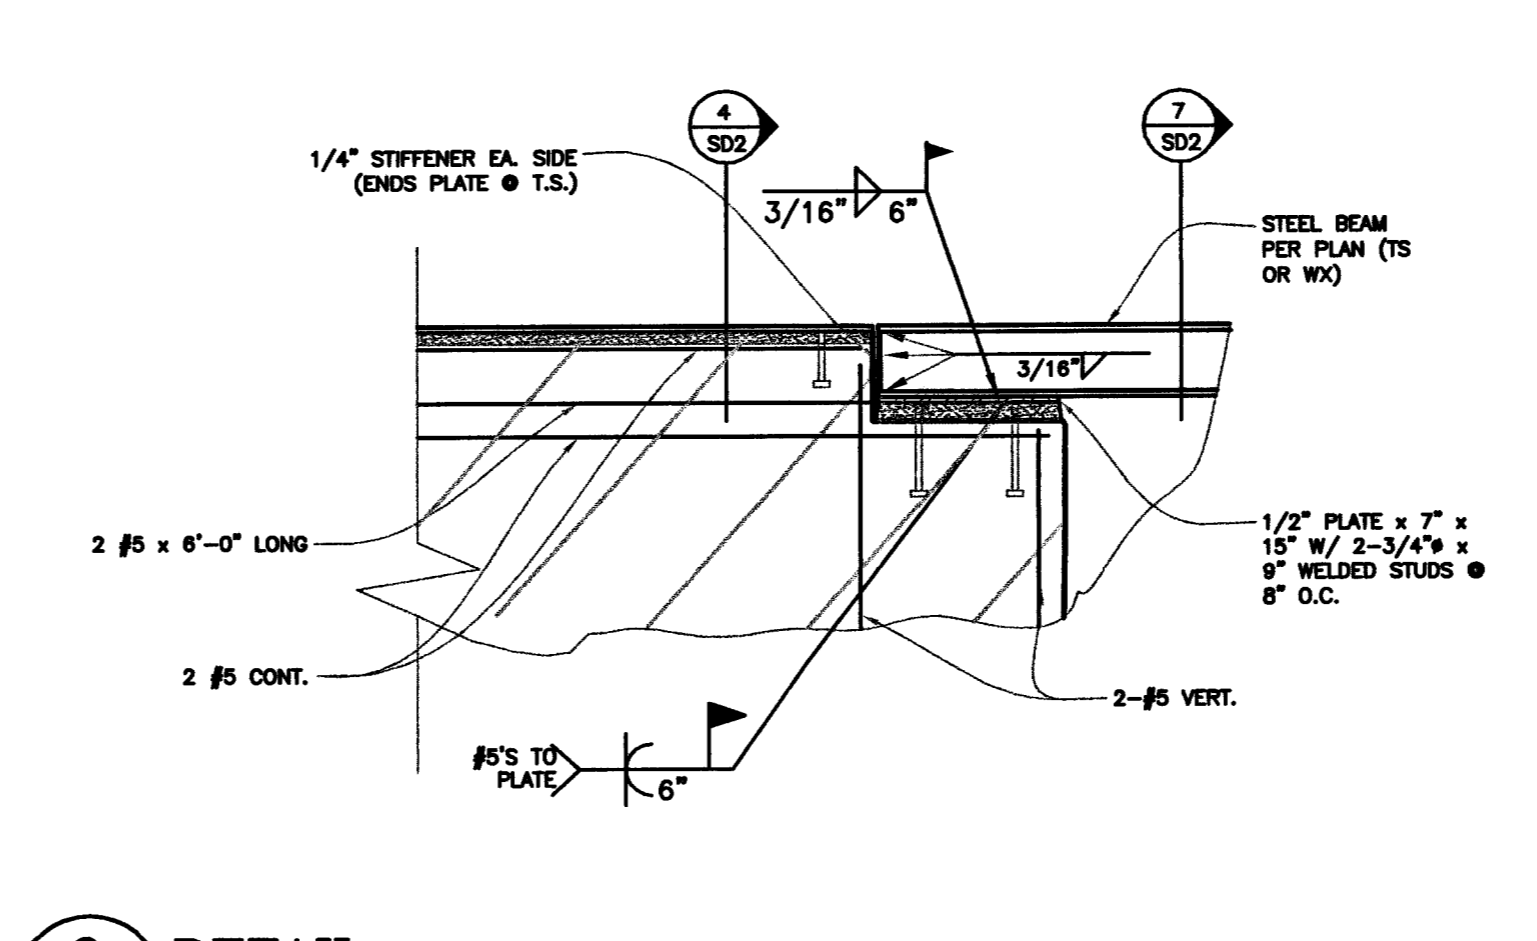


6 DETAIL
 1"

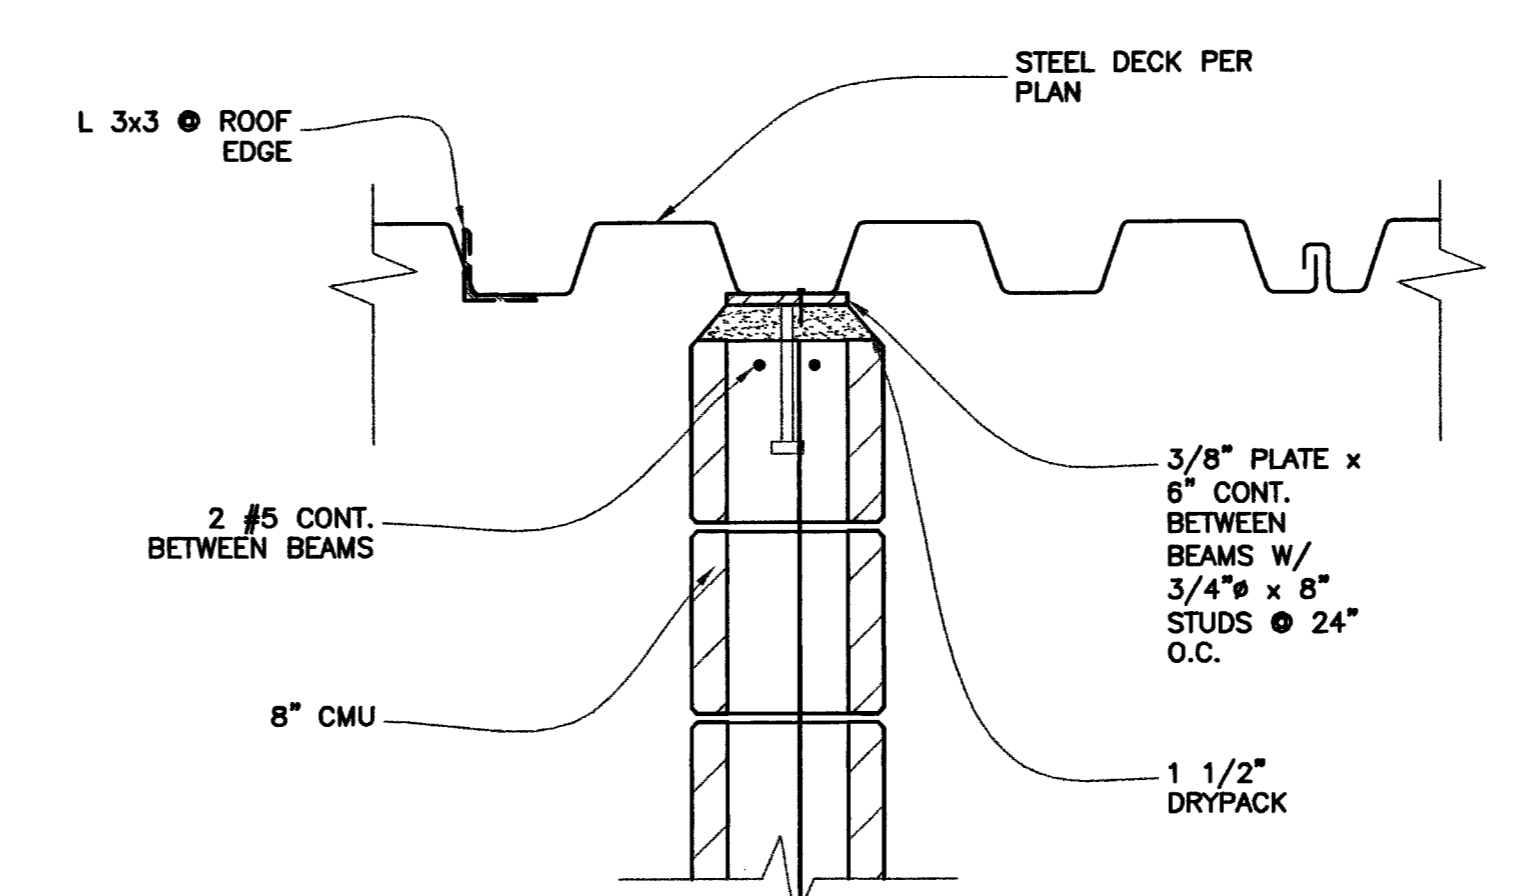


5 DETAIL
 1"

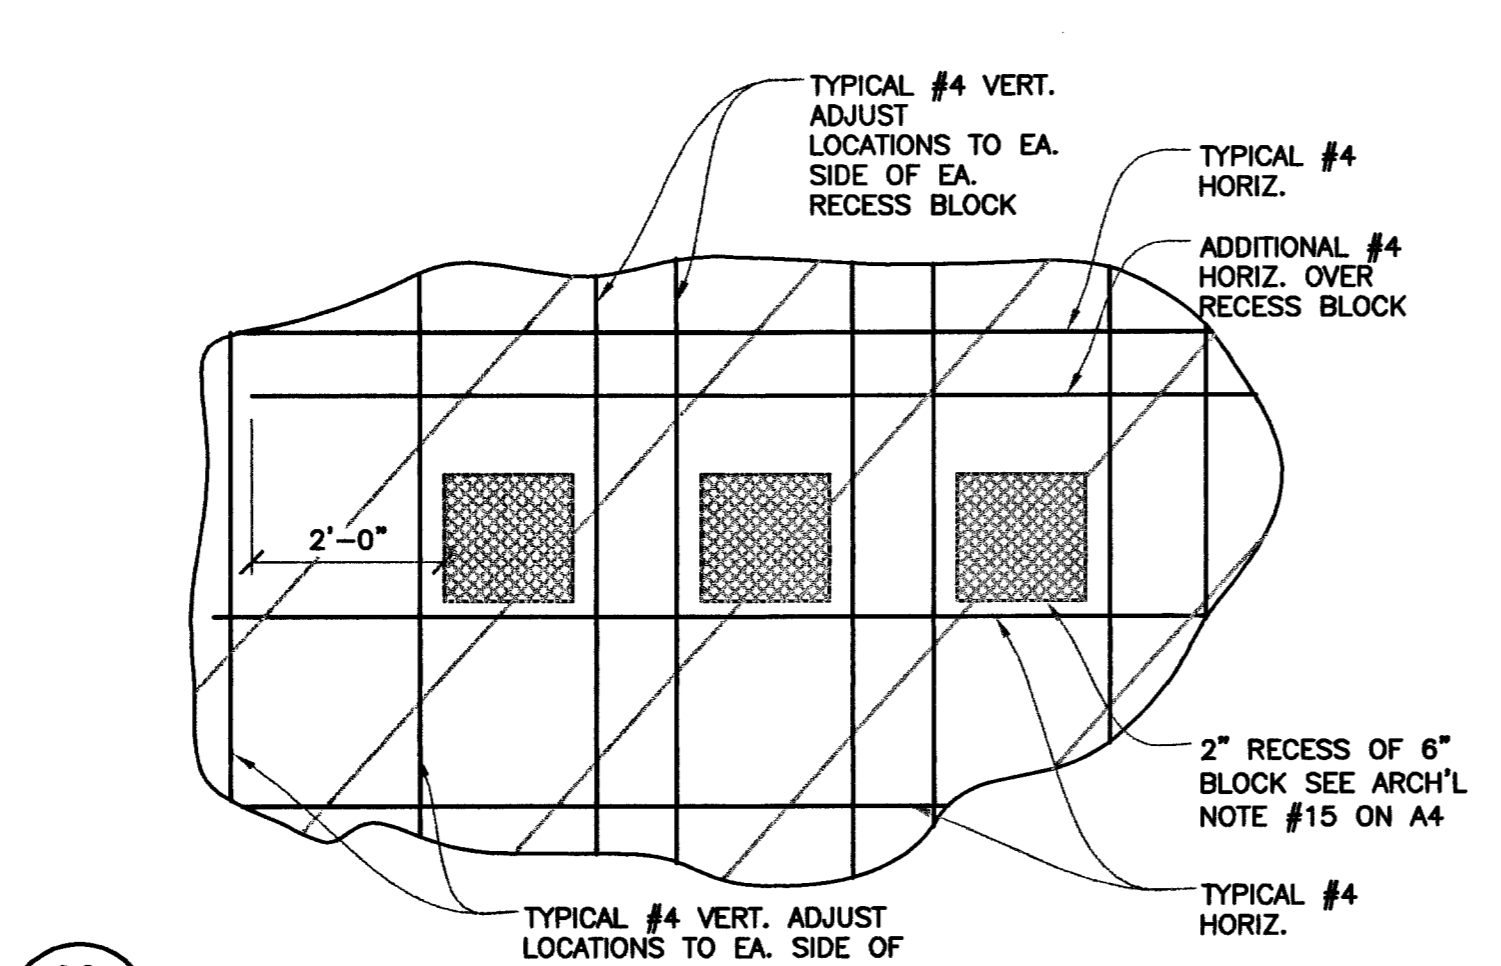


12 DETAIL
 1/2"

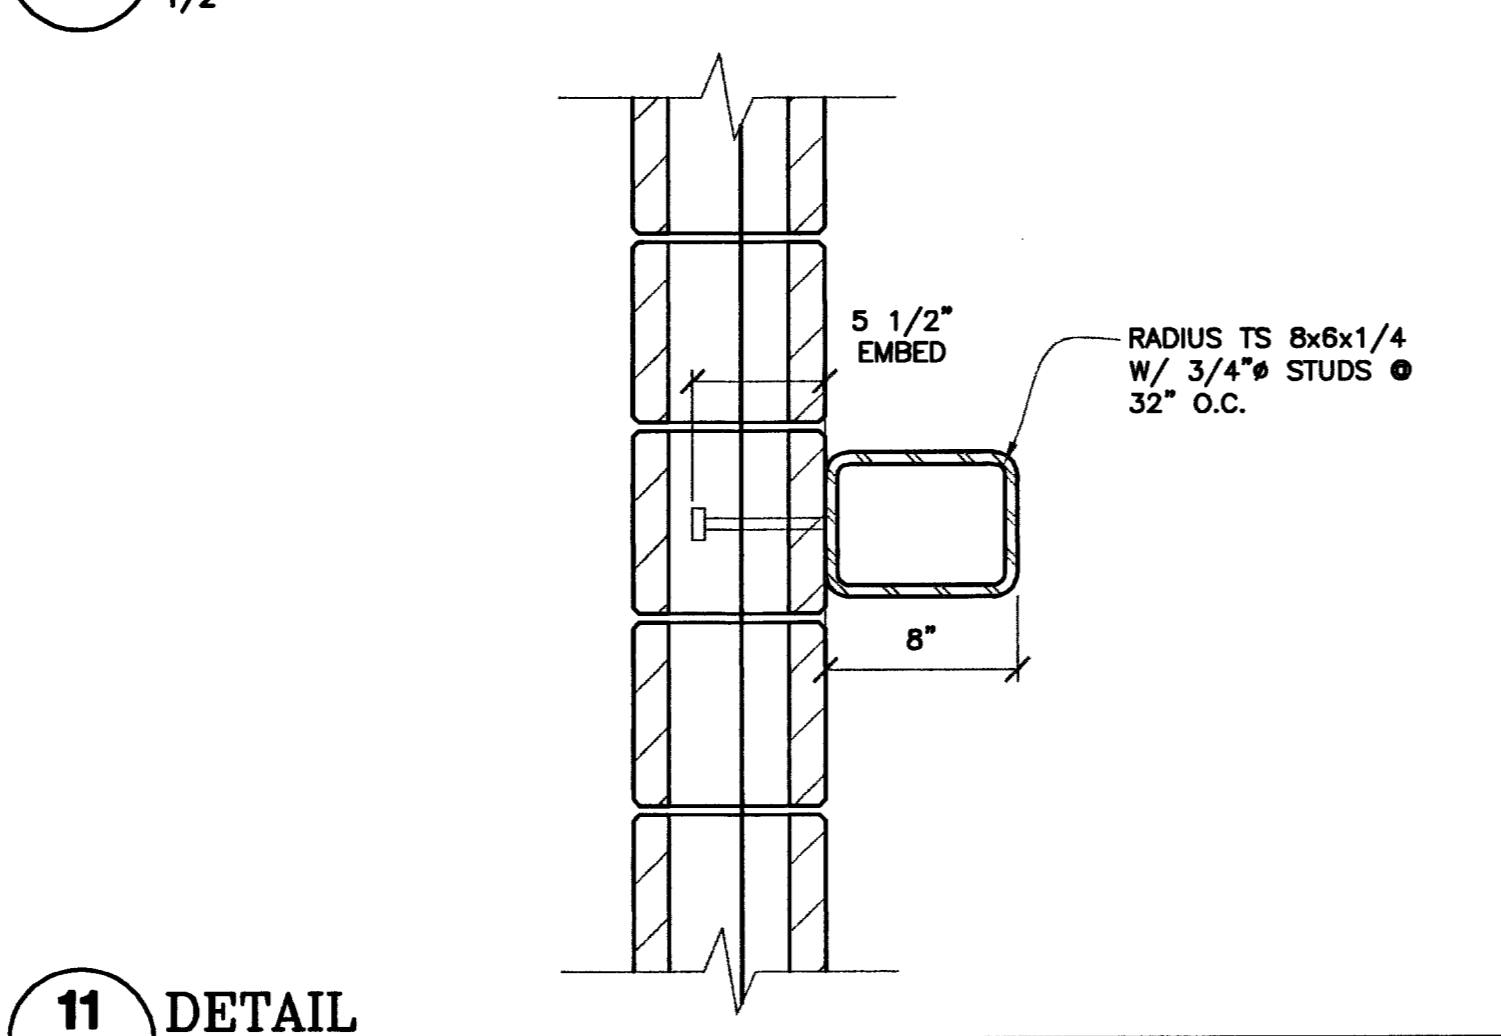

11 DETAIL
 1 1/2"

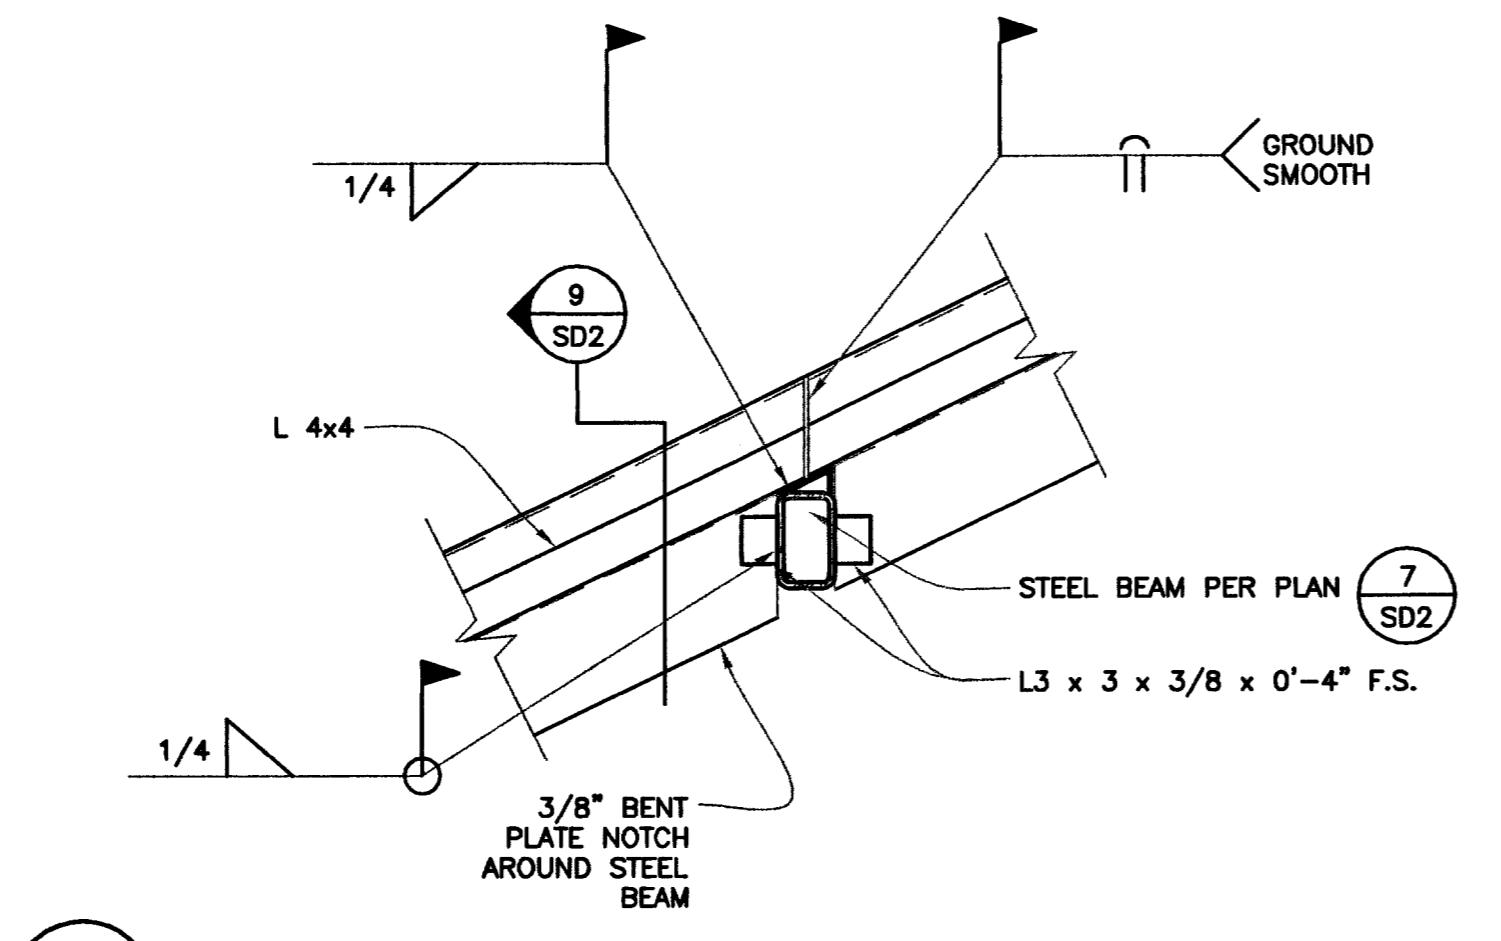

10 DETAIL
 3/4"

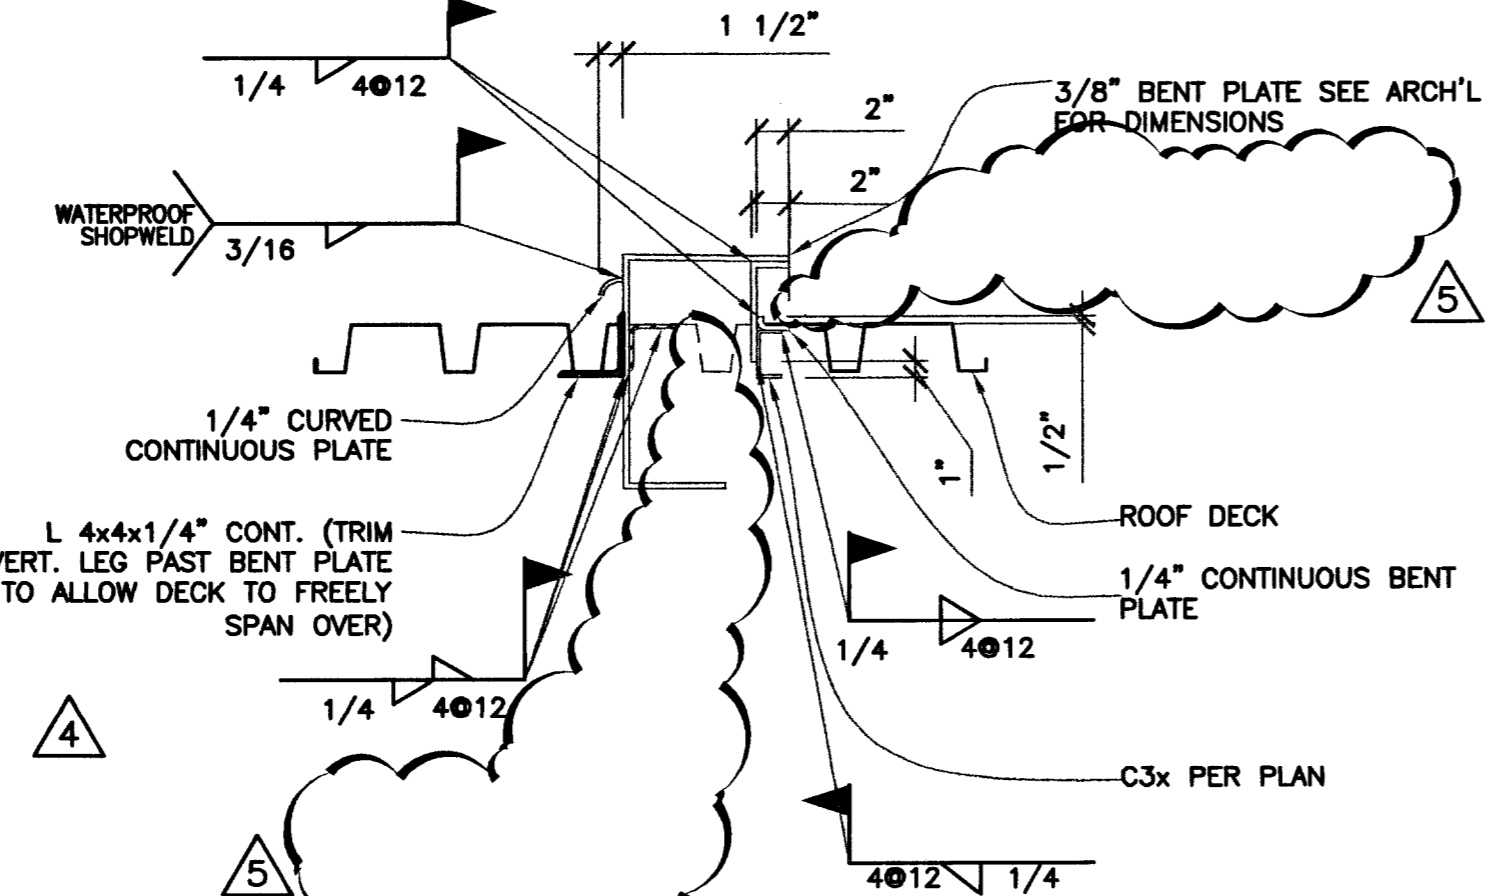

9 DETAIL
 1"

6666