


SAFETY ALERT

**Call
before you
Overhead**

593-6111

OVERHEAD SERVICE ALERT

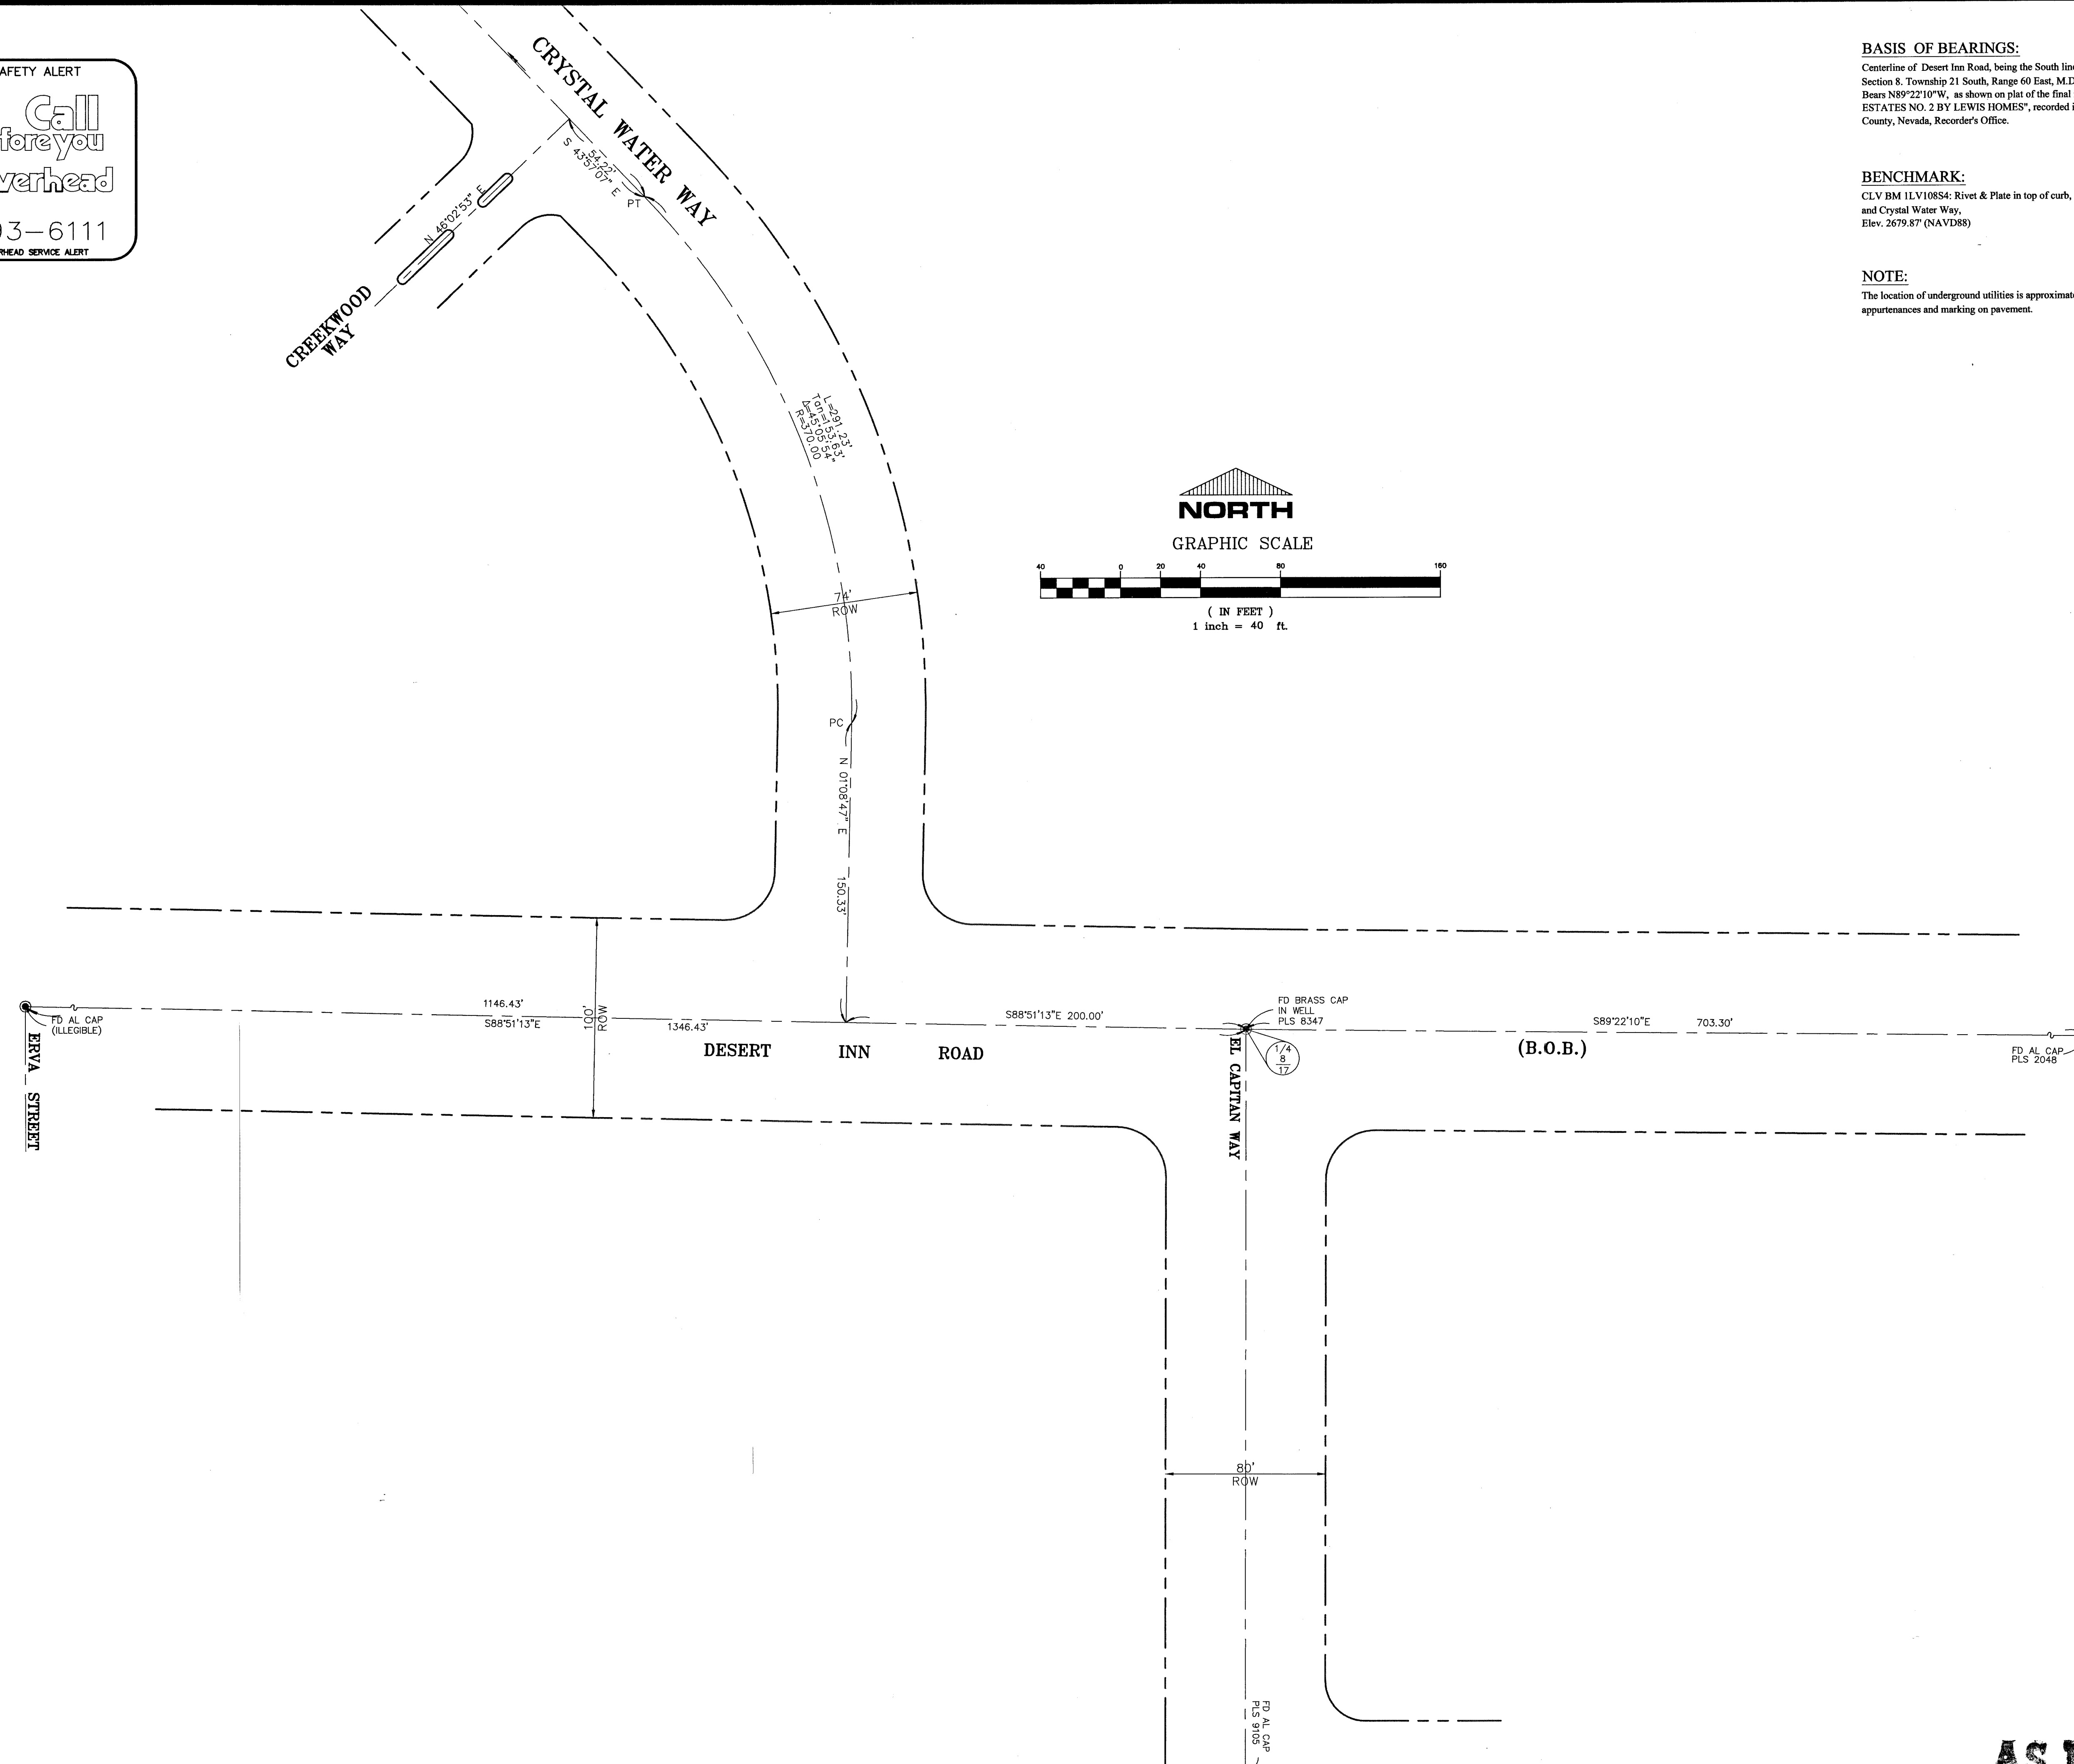

The location of underground utilities is approximate and located by above ground appurtenances and marking on pavement.

REVISIONS					
	NO.	DATE:	DESCRIPTION	APP'D	

TITLE: _____

SHEET: _____



Sheet
H-2
4 of 10
DRAWING NO.
327-V119

AS BUILT