

Avoid cutting underground utility lines. It's costly.

Call before you Dig.

1-800-227-2600

UNDERGROUND SERVICE ALERT (USA)

SAFETY ALERT

Call before you Overhead

593-6111

OVERHEAD SERVICE ALERT

HATCH LEGEND

- AC REMOVAL AND REPLACEMENT
- X-GUTTER REMOVAL AND REPLACEMENT
- S/W REMOVAL AND REPLACEMENT
- Median Removal and Replacement. MATCH EXISTING MEDIAN COLOR, TEXTURE AND PAINT MARKINGS.
- LANDSCAPE/IRRIGATION SYSTEM RELOCATION/RECONSTRUCTION

52053 73443

BASIS OF BEARINGS



Centerline of Desert Inn Road, being the South line of Southeast quarter of Section 3, Township 21 South, Range 40 East, M.D.M. Clark County Nevada, Bears N89°22'10"W, as shown on plat of the final map of "LAKE SHORE ESTATES NO.2 BY LEWIS HOMES", recorded in Book 35, Page 30 of Clark County, Nevada, Recorder's Office.

UTILITY NOTE

UTILITY LOCATIONS SHOWN HEREON ARE APPROXIMATE ONLY. IT SHALL BE THE CONTRACTOR'S RESPONSIBILITY TO DETERMINE THE EXACT VERTICAL AND HORIZONTAL LOCATION OF ALL EXISTING UNDERGROUND UTILITIES PRIOR TO COMMENCING CONSTRUCTION. NO REPRESENTATION IS MADE THAT ALL EXISTING UTILITIES ARE SHOWN HEREON. THE ENGINEER ASSUMES NO RESPONSIBILITY FOR UTILITIES NOT SHOWN OR UTILITIES NOT SHOWN IN THEIR PROPER LOCATION.

BENCHMARK

CLV BM 1LV10854: Rivet & Plate in top of curb, N.W. return of Desert Inn Road and Crystal Water Way. Elev. 2679.87' (NAVD83)

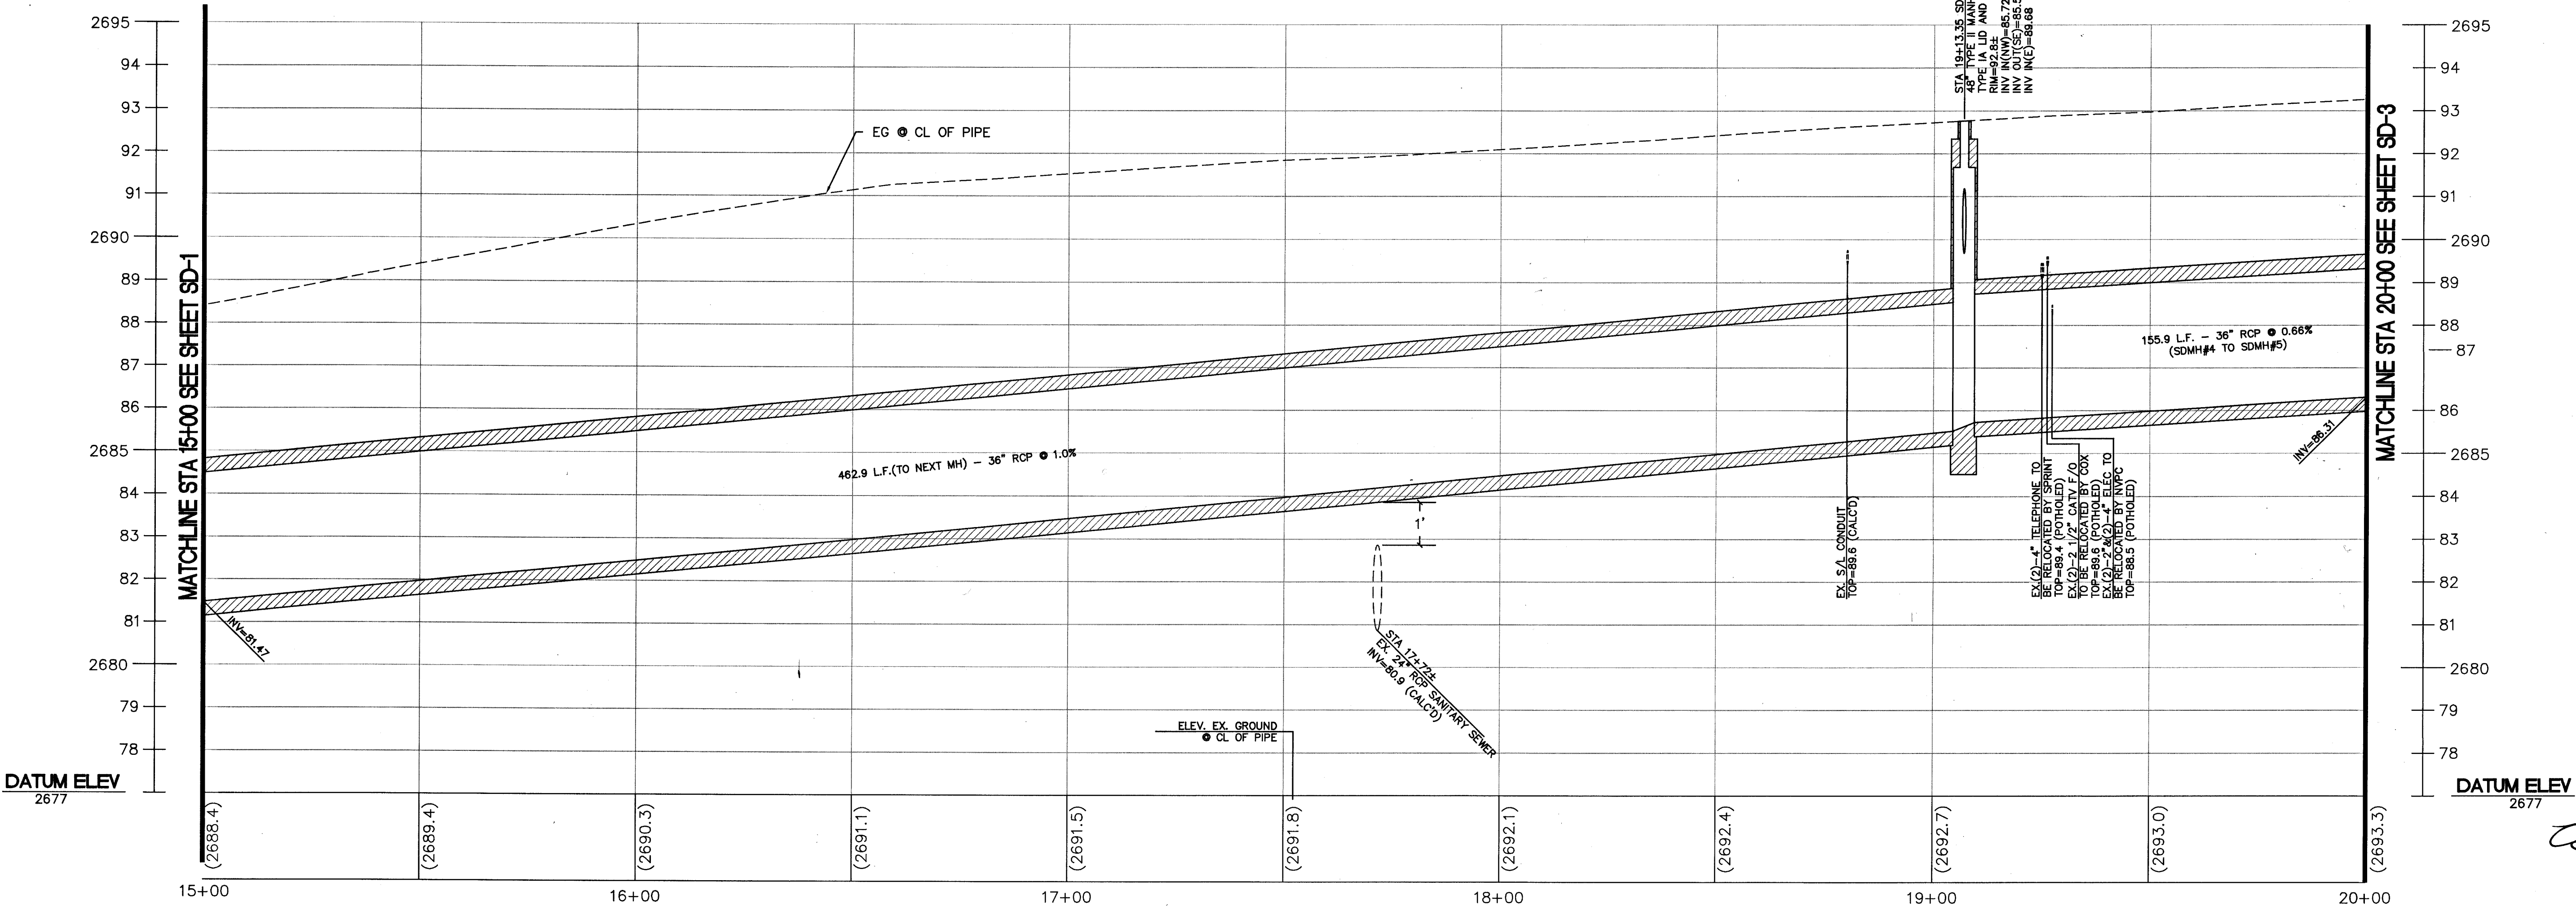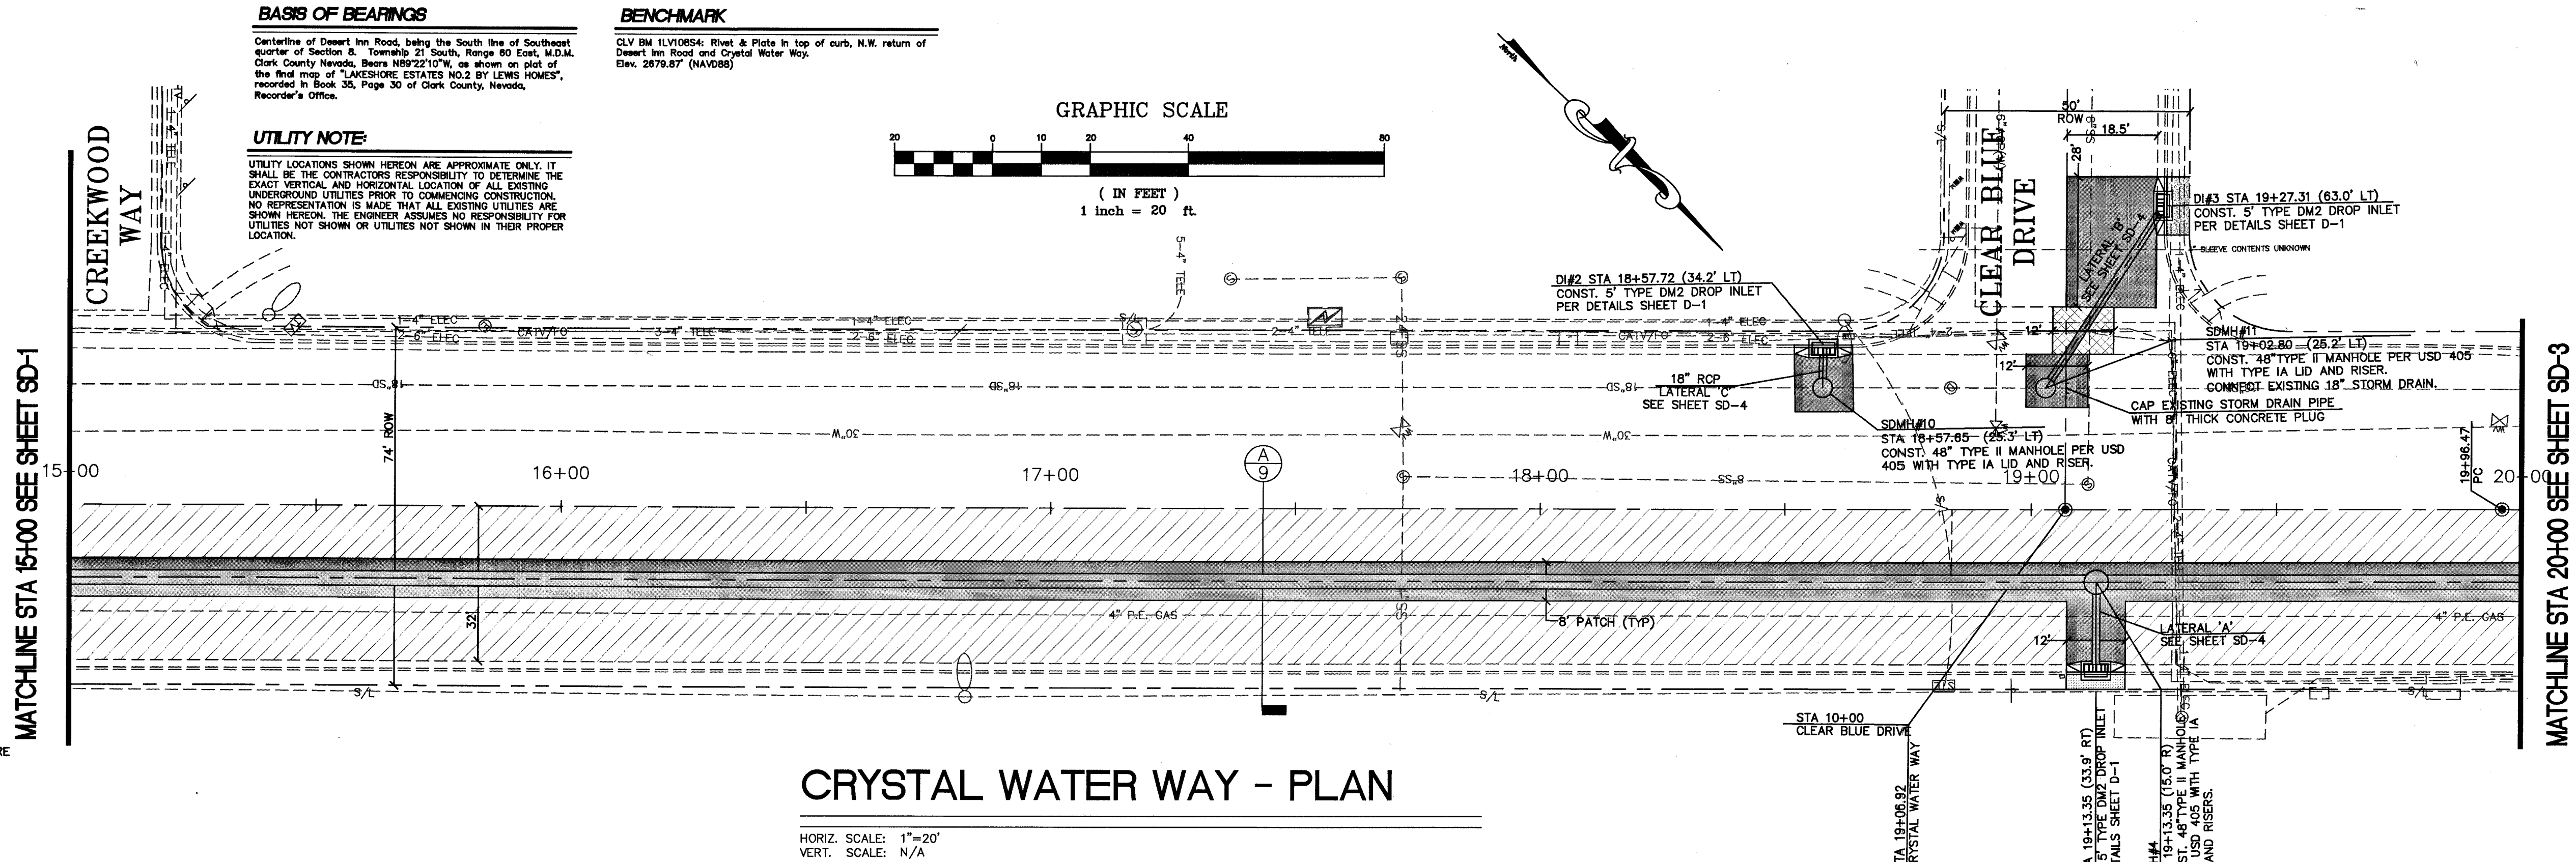

CRYSTAL WATER WAY - PROFILE

HORIZ. SCALE: 1"=20'
VERT. SCALE: 1"=2'

AS BUILT

DATE: 4/21/03

DEPARTMENT OF PUBLIC WORKS ENGINEERING DESIGN SECTION CITY ENGINEER: CHARLES KAKOWSKI JR., P.E. PROGRAM MANAGER: TOM HAYES, P.E. DESIGNED BY: WAS DRAWN BY: WAS CHECKED BY: EGN		REVISIONS NO. DATE DESCRIPTION 5/1/03 REVISIONS BY C.L.V. APP'D
CRYSTAL WATER WAY NOMINAL STORM DRAIN PLAN AND PROFILE STA 15+00 TO 20+00		TITLE: SHEET: SD-2 6 of 10 DRAWING NO. 327-V119