
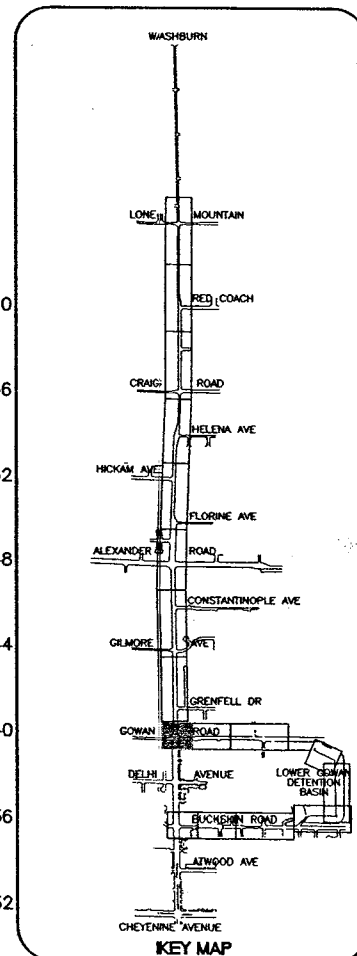
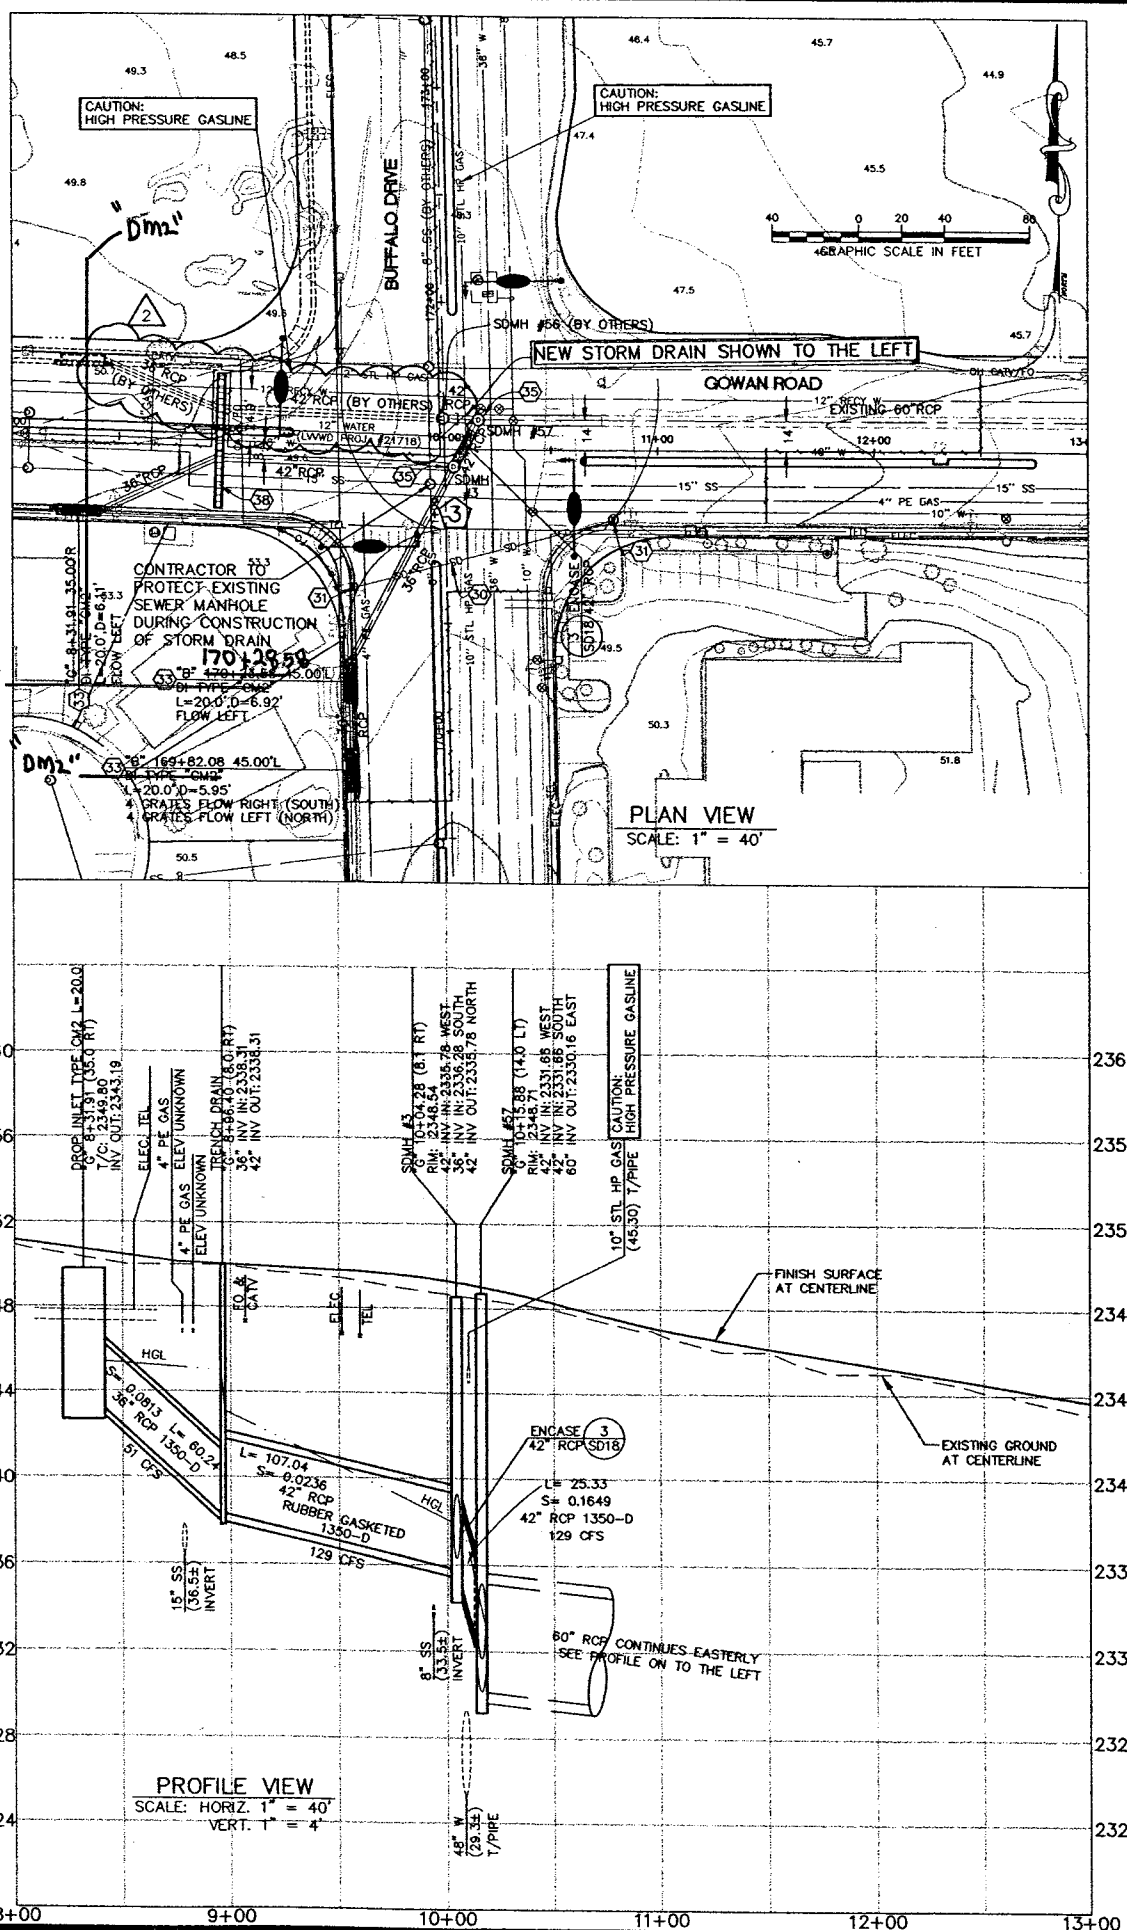


RECEIVED
OCT 30 2003

GCW PROJ # 412.405

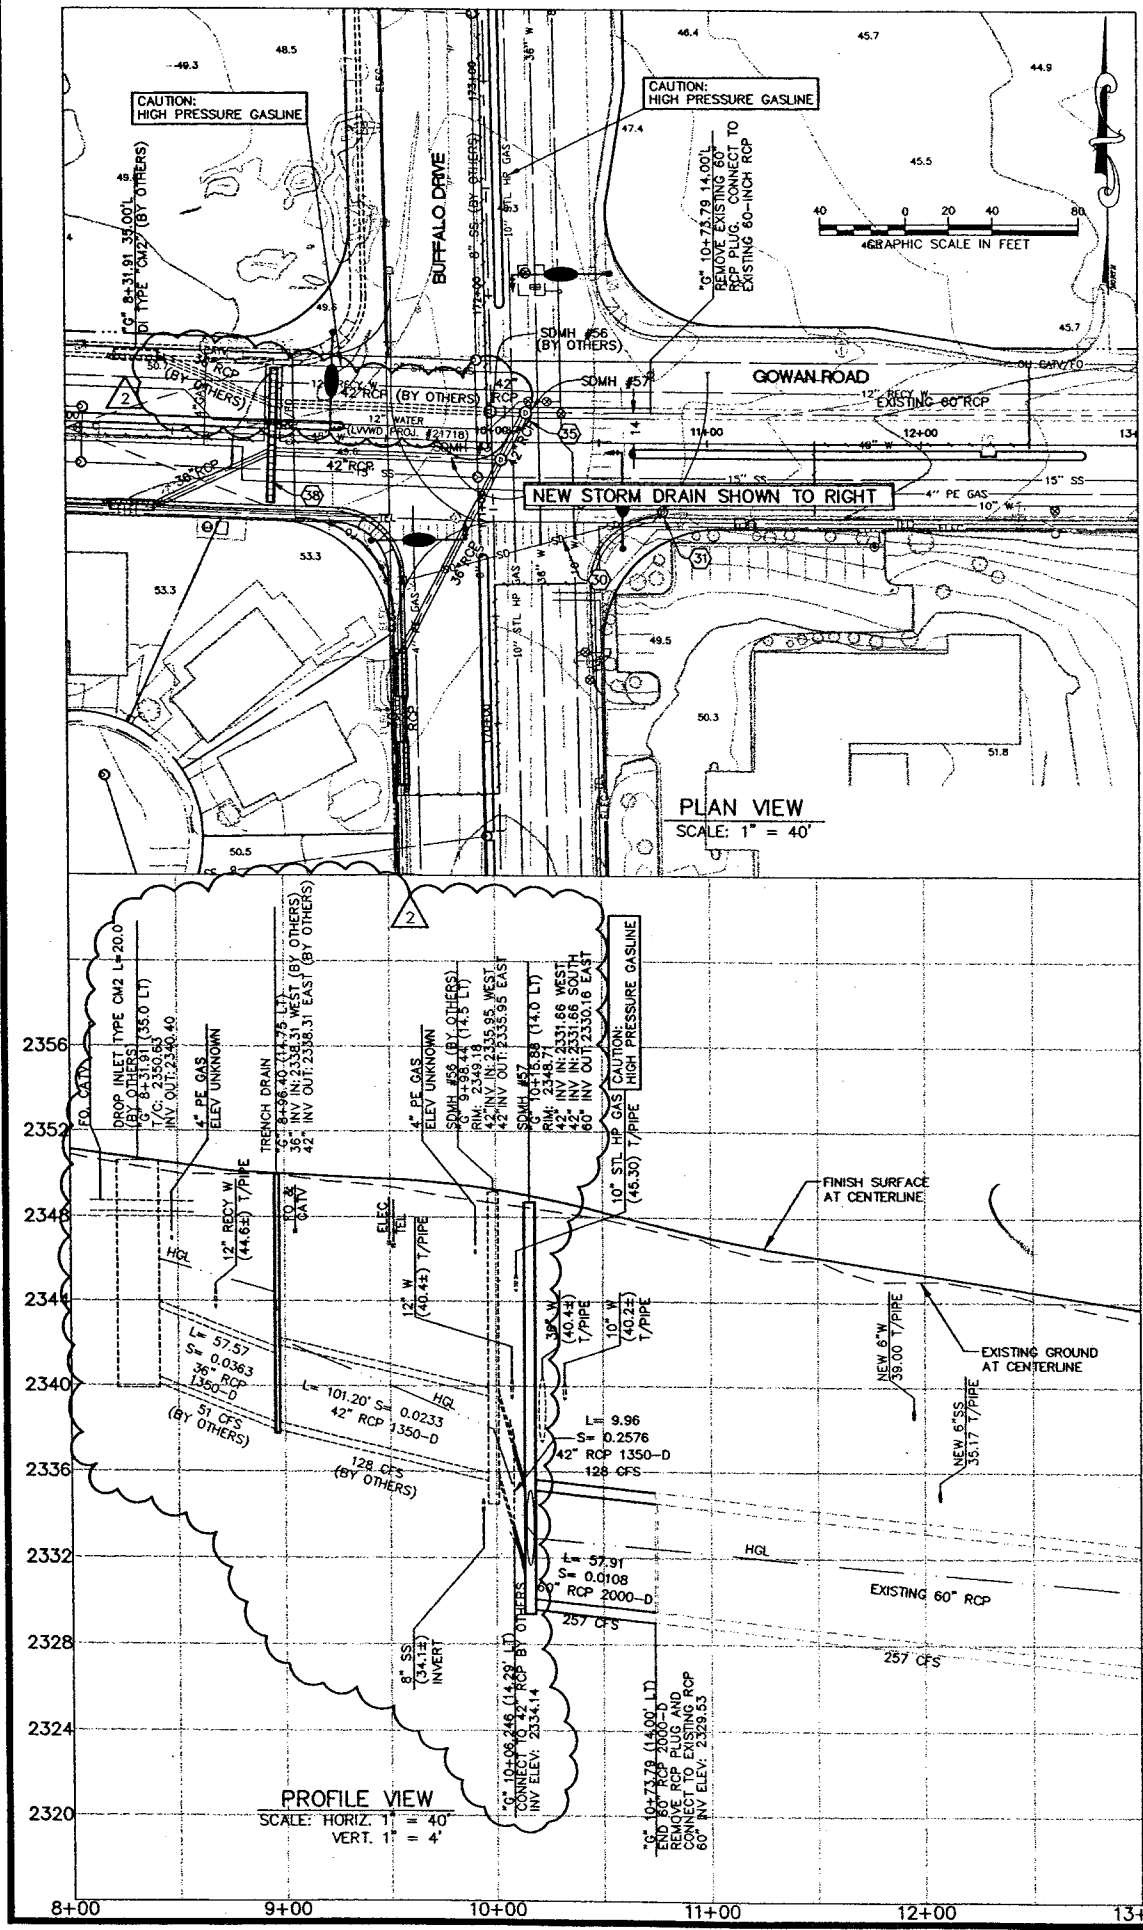

Call before you Dig.
1-800-227-2600
UNDERGROUND SERVICE (US)

CALL BEFORE YOU DO OVERHEAD
1-702-593-6111