




LAS VEGAS VALLEY WATER DISTRICT DATE

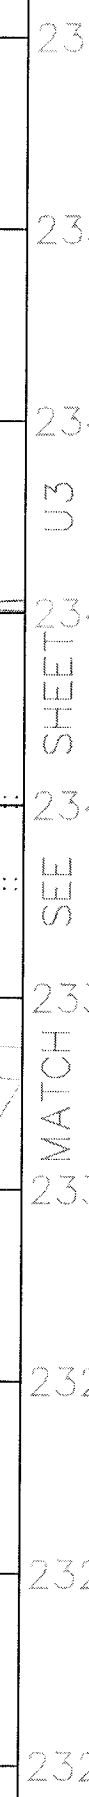

U2
58 JAN 93
107-V3593
AS-BUILT

3	9/22/03	BGR
2	7/16/03	BGR
1	3/18/03	BGR



PROJECT NO: SCALE:	CHECKED BY: DATE:	TITLE:
	PROJECT NO: SCALE:	CHECKED BY: DATE:

U2
93
7-V3593
S-BUILT

S-BUILT