
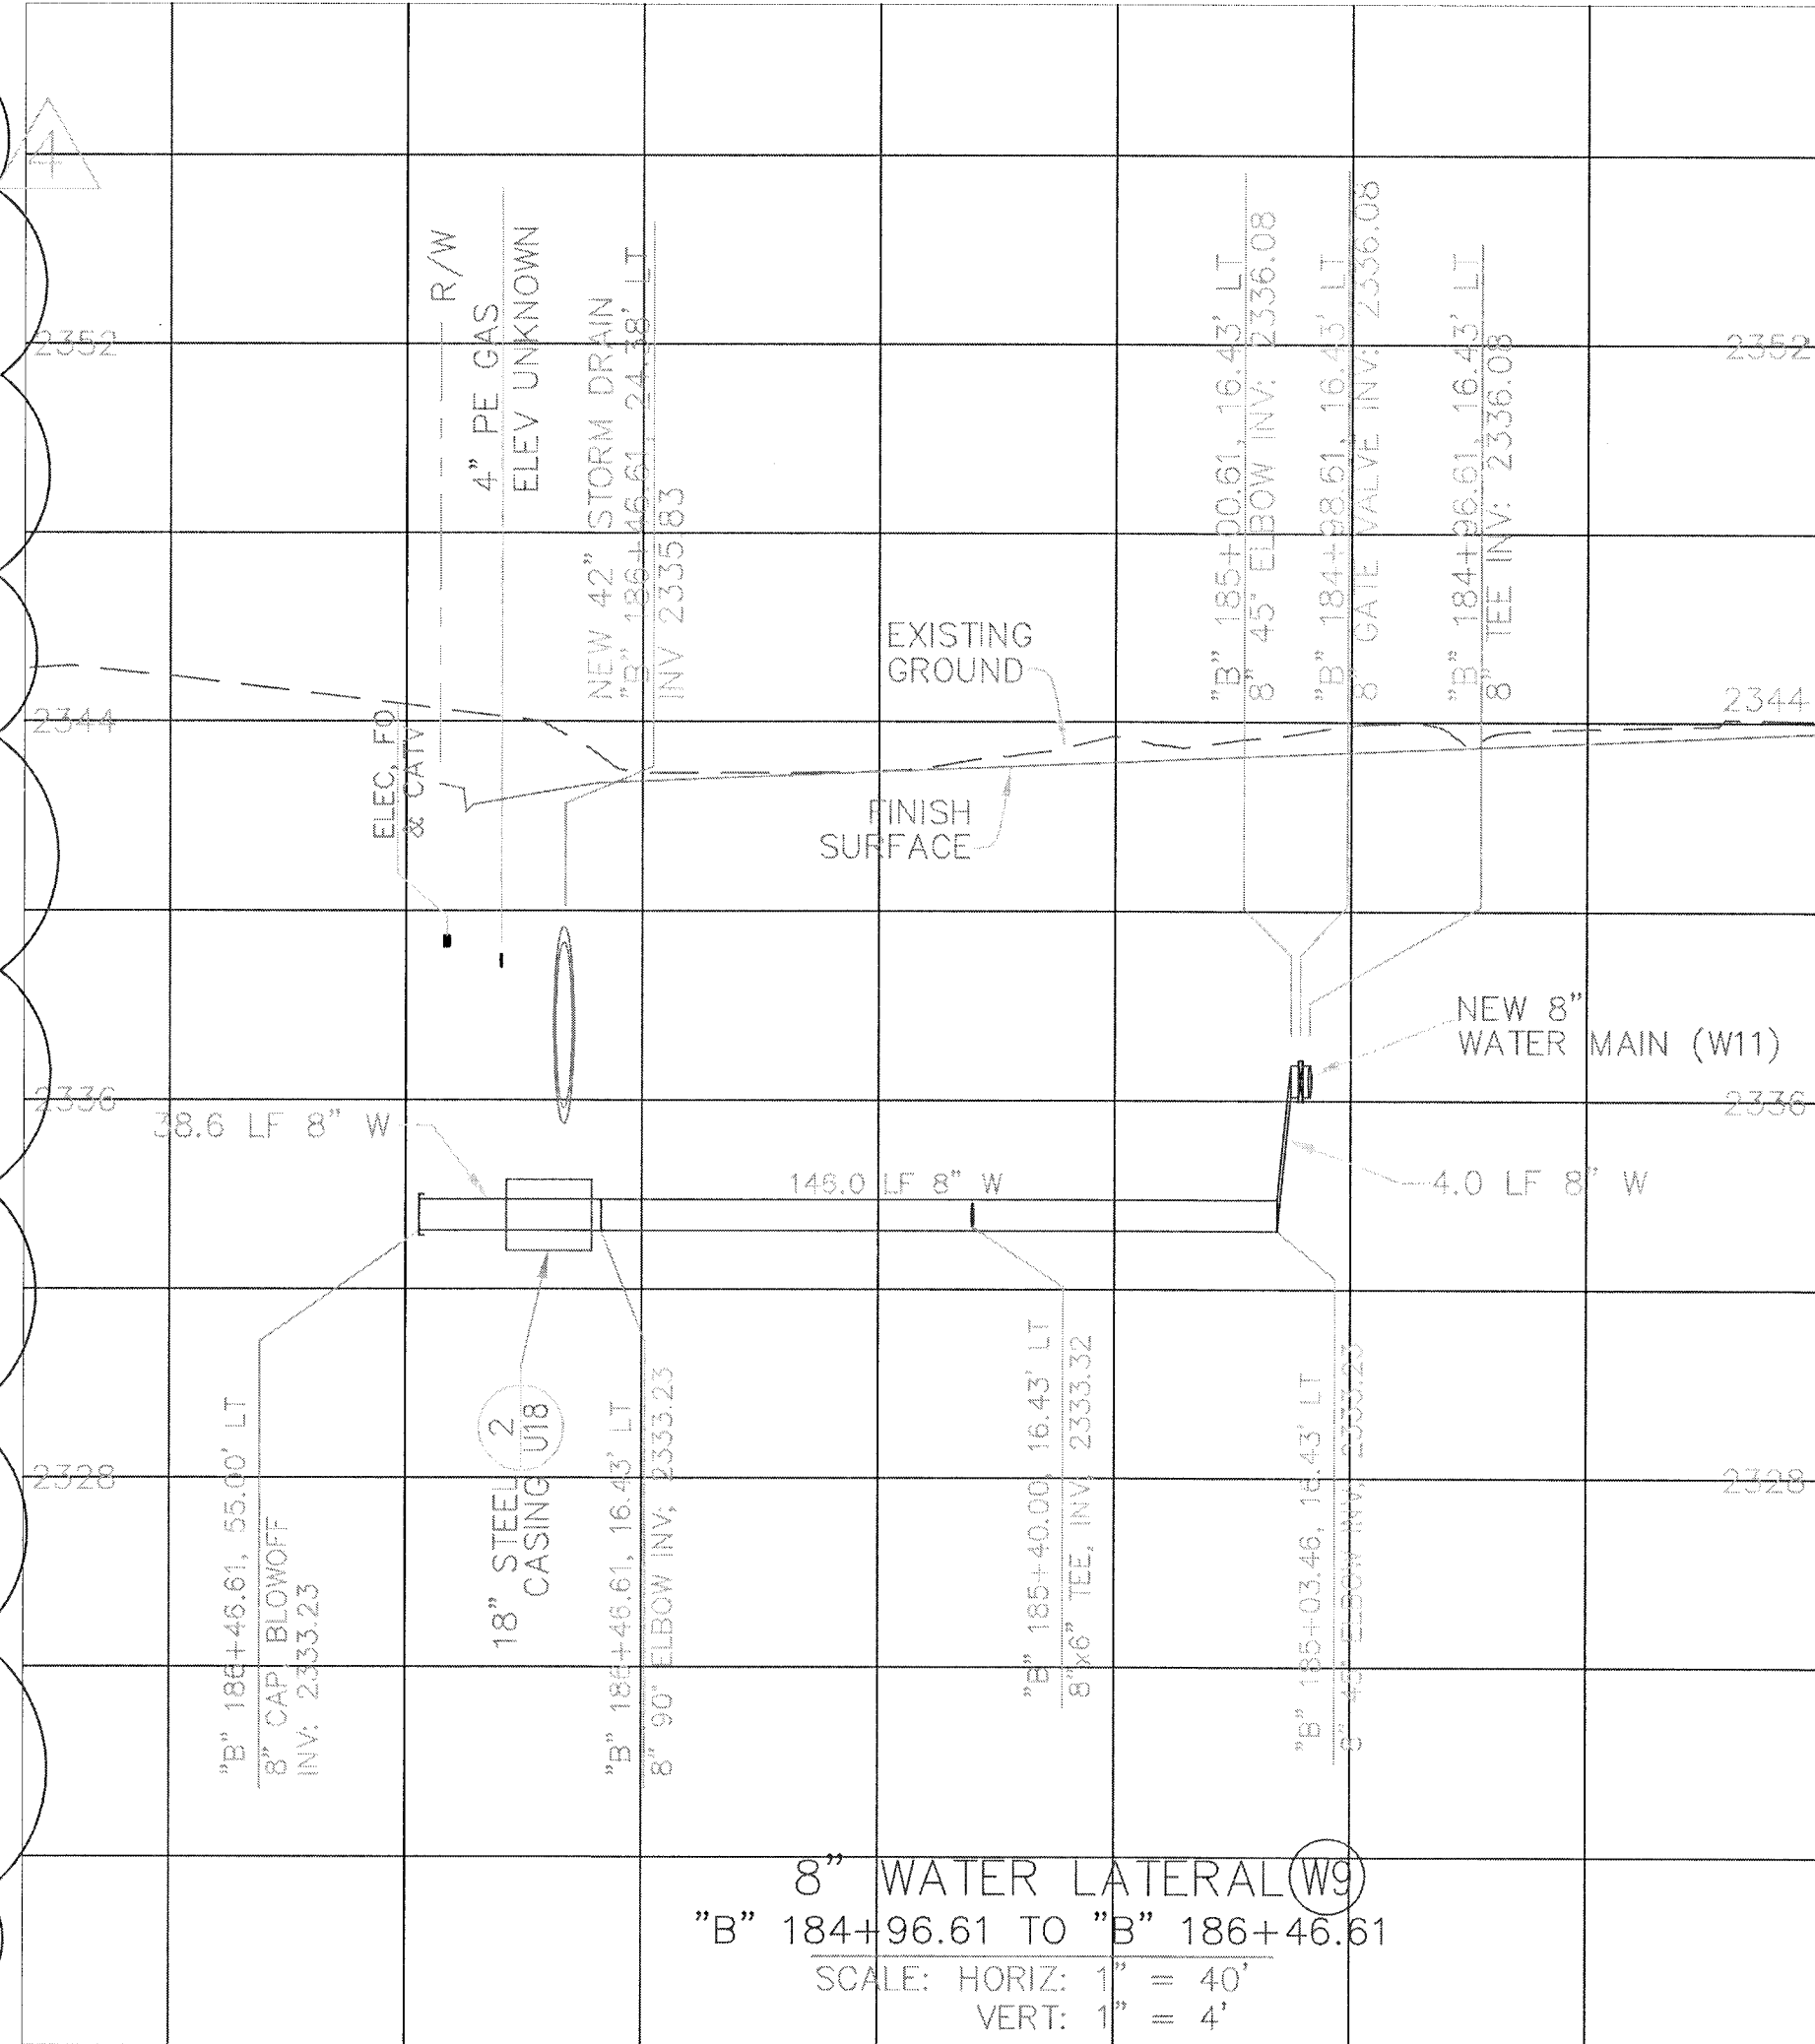
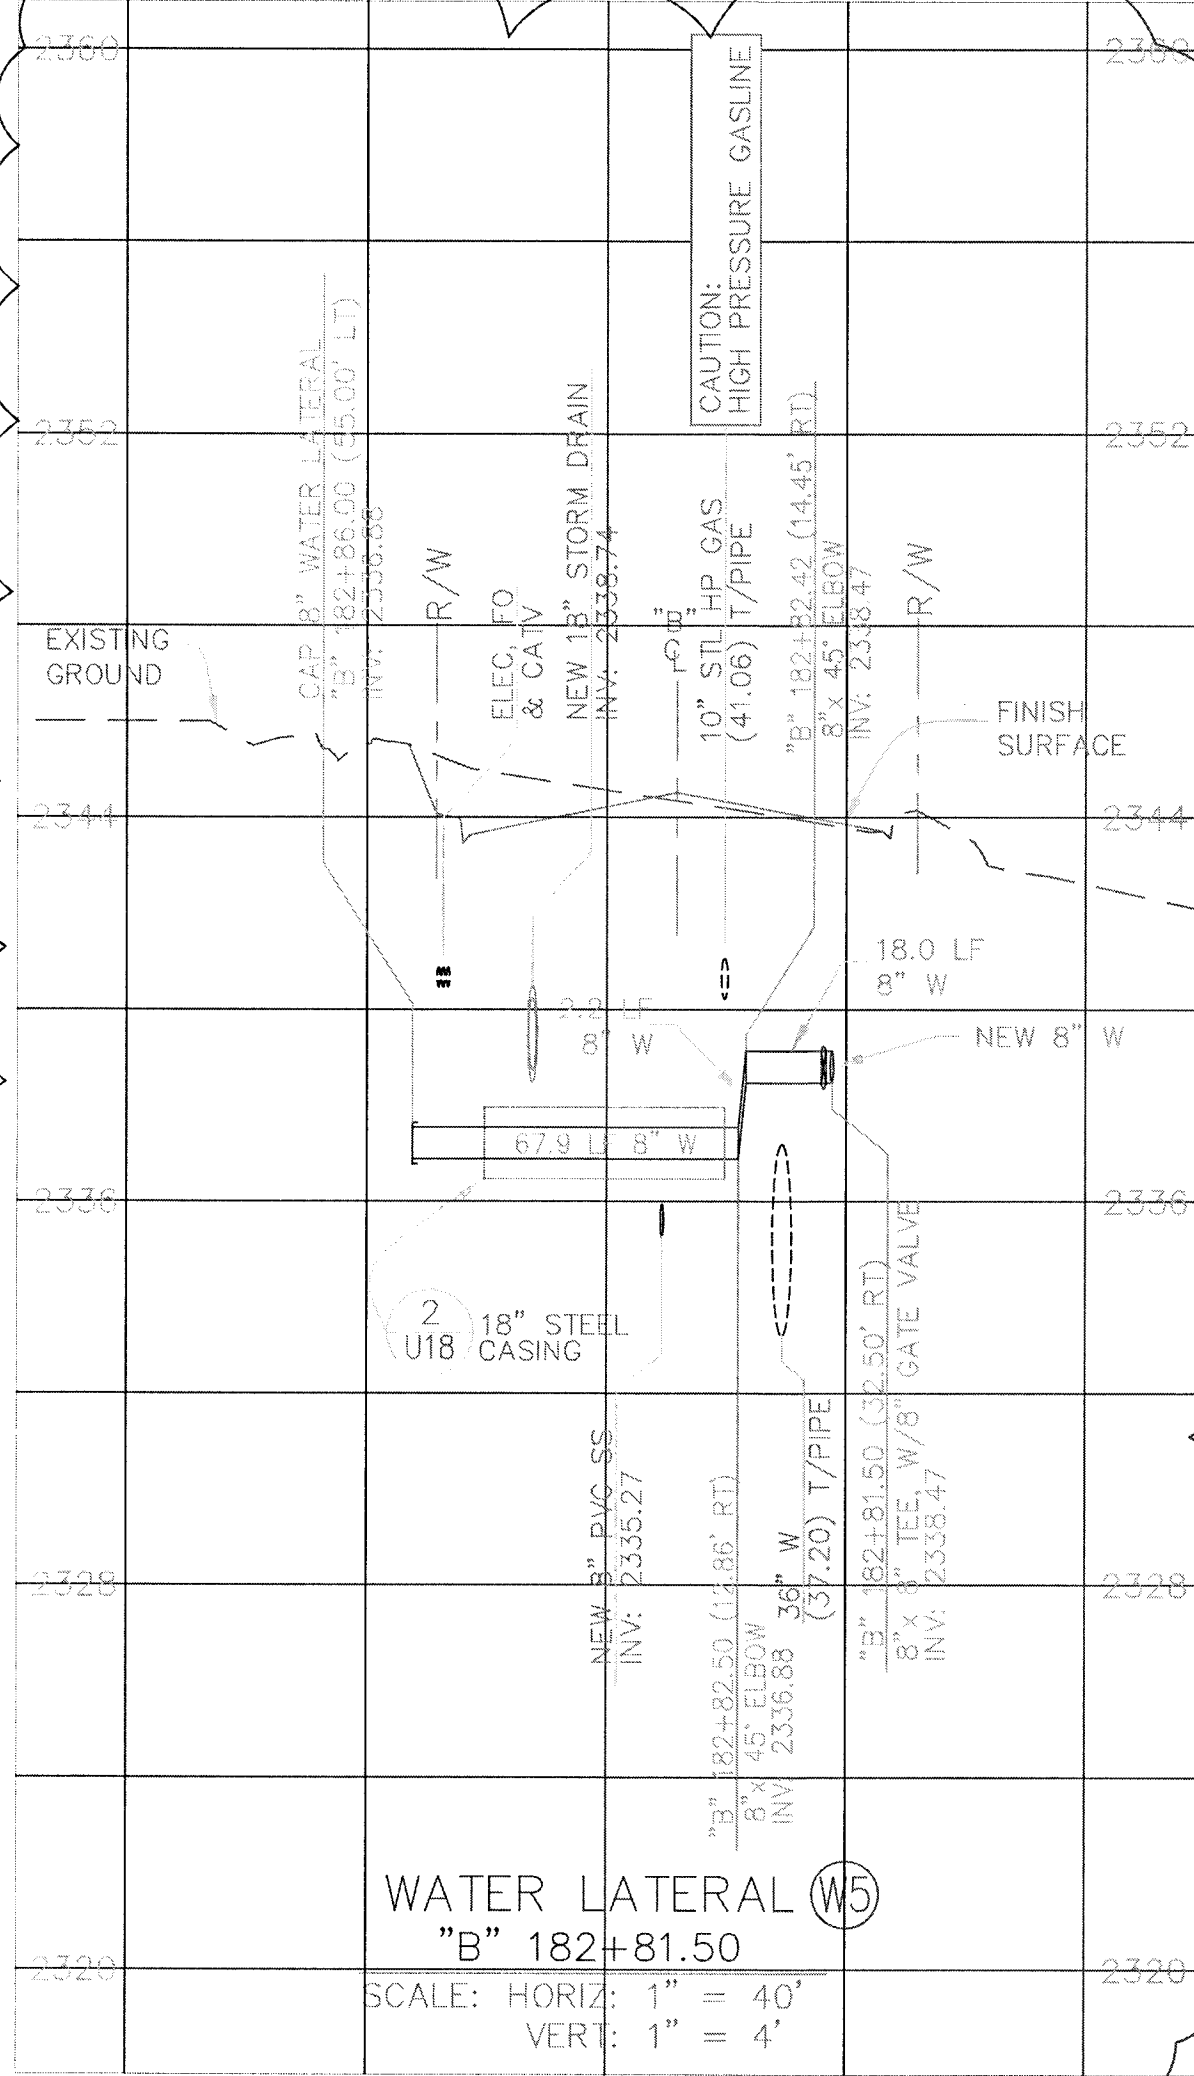
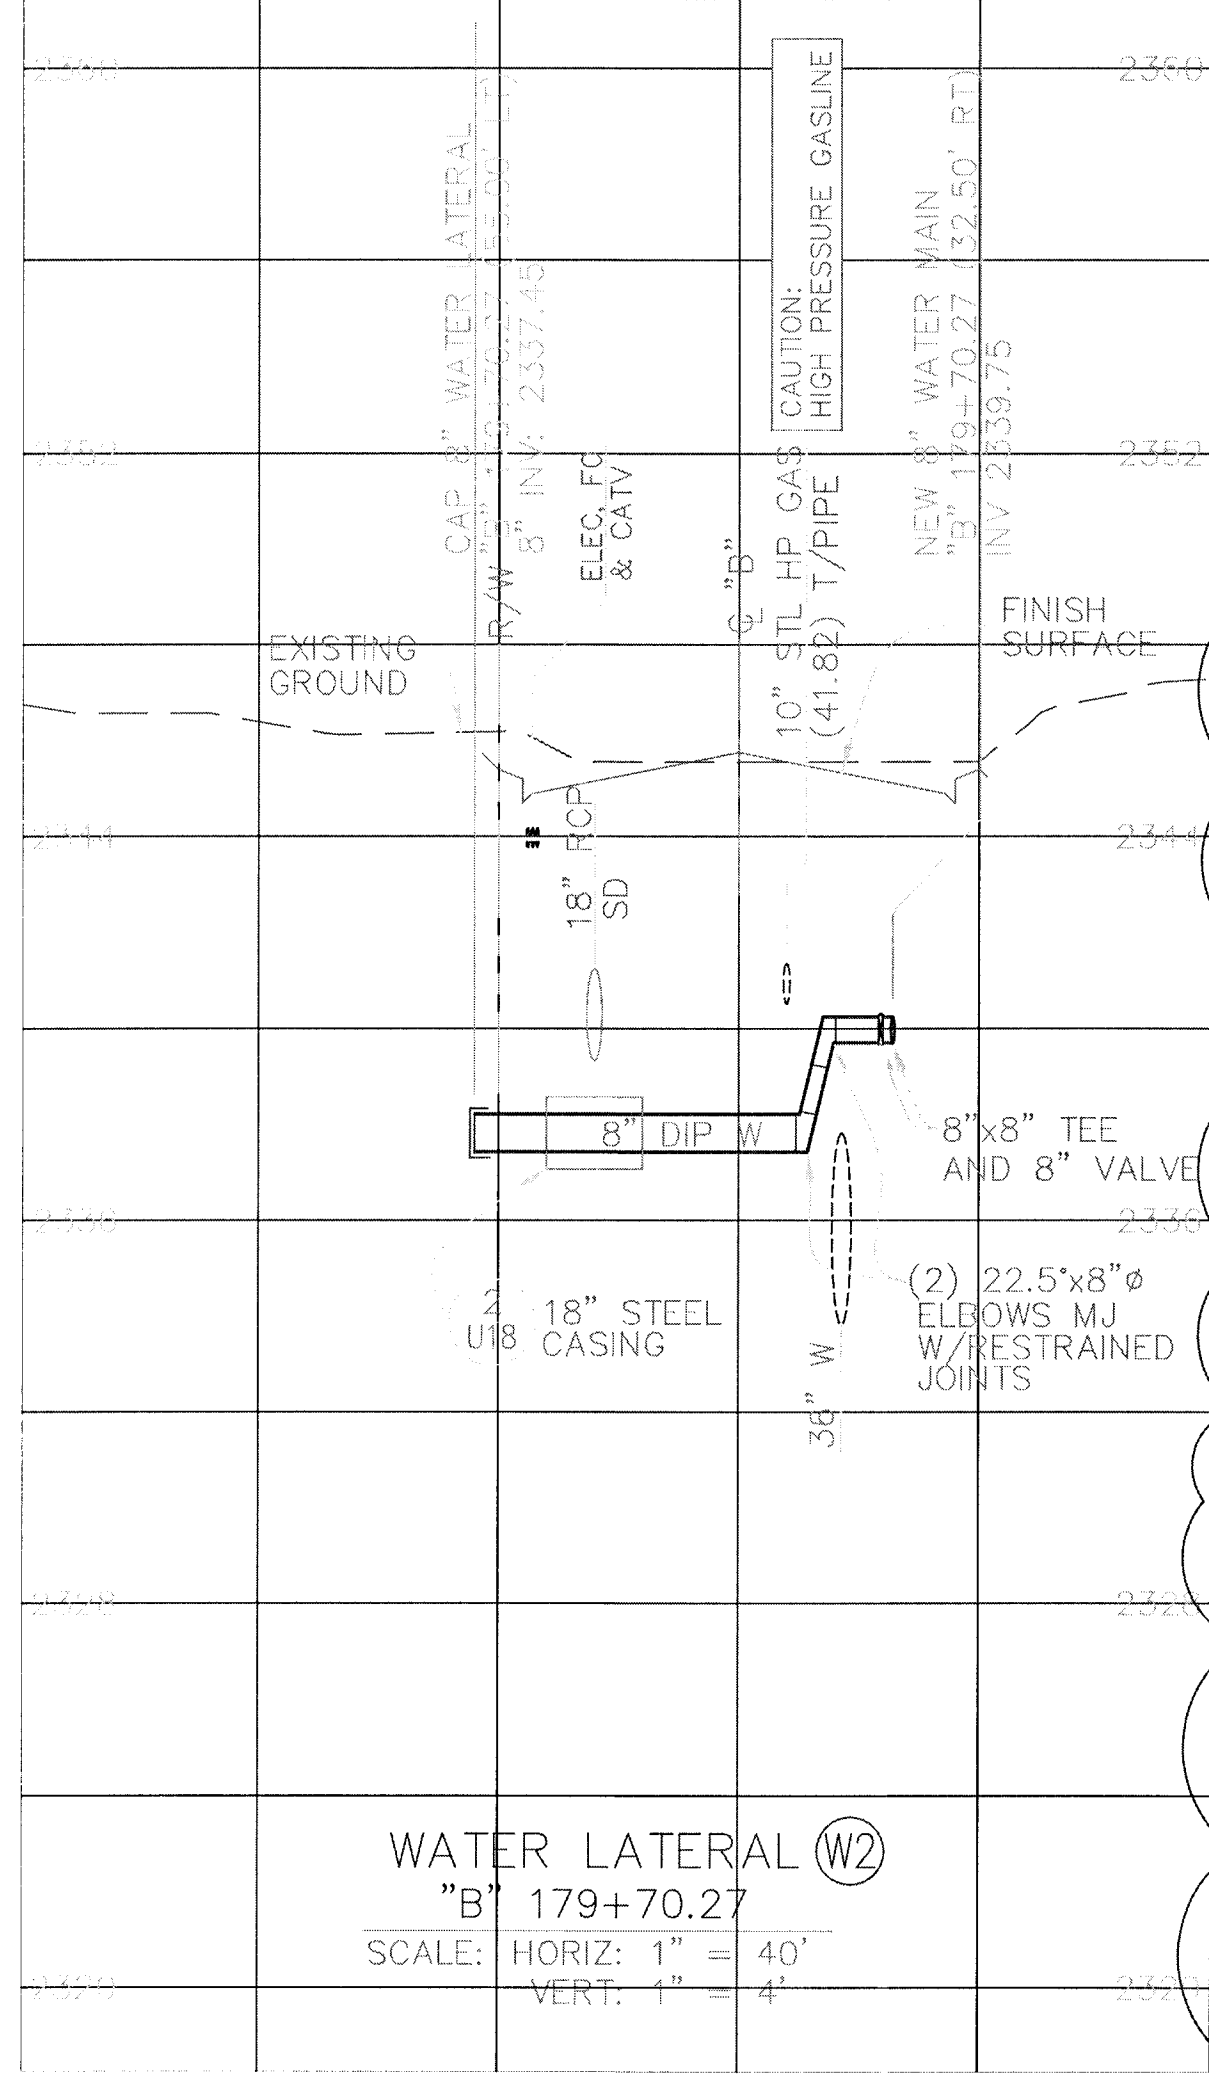
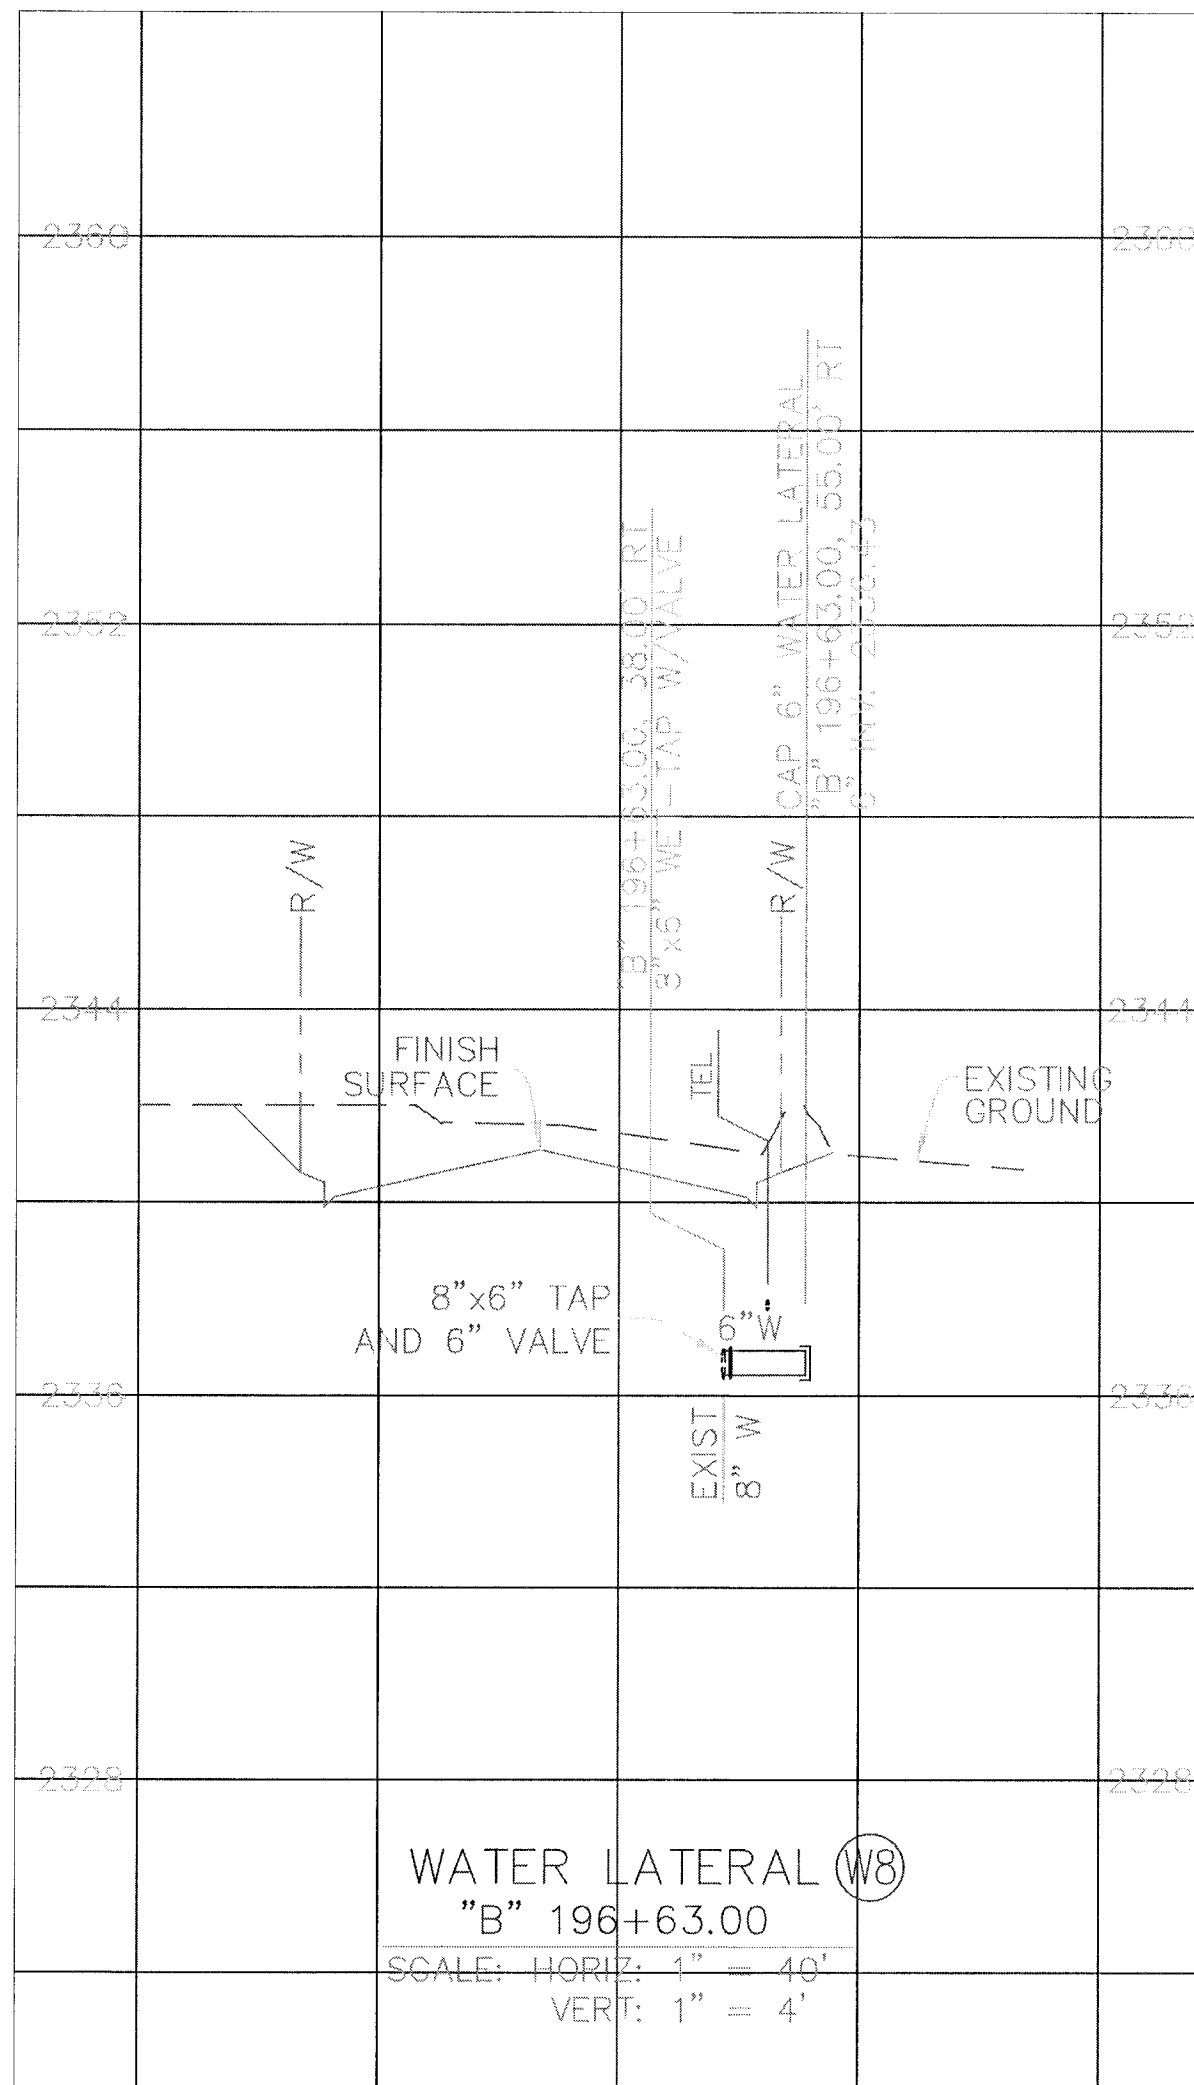
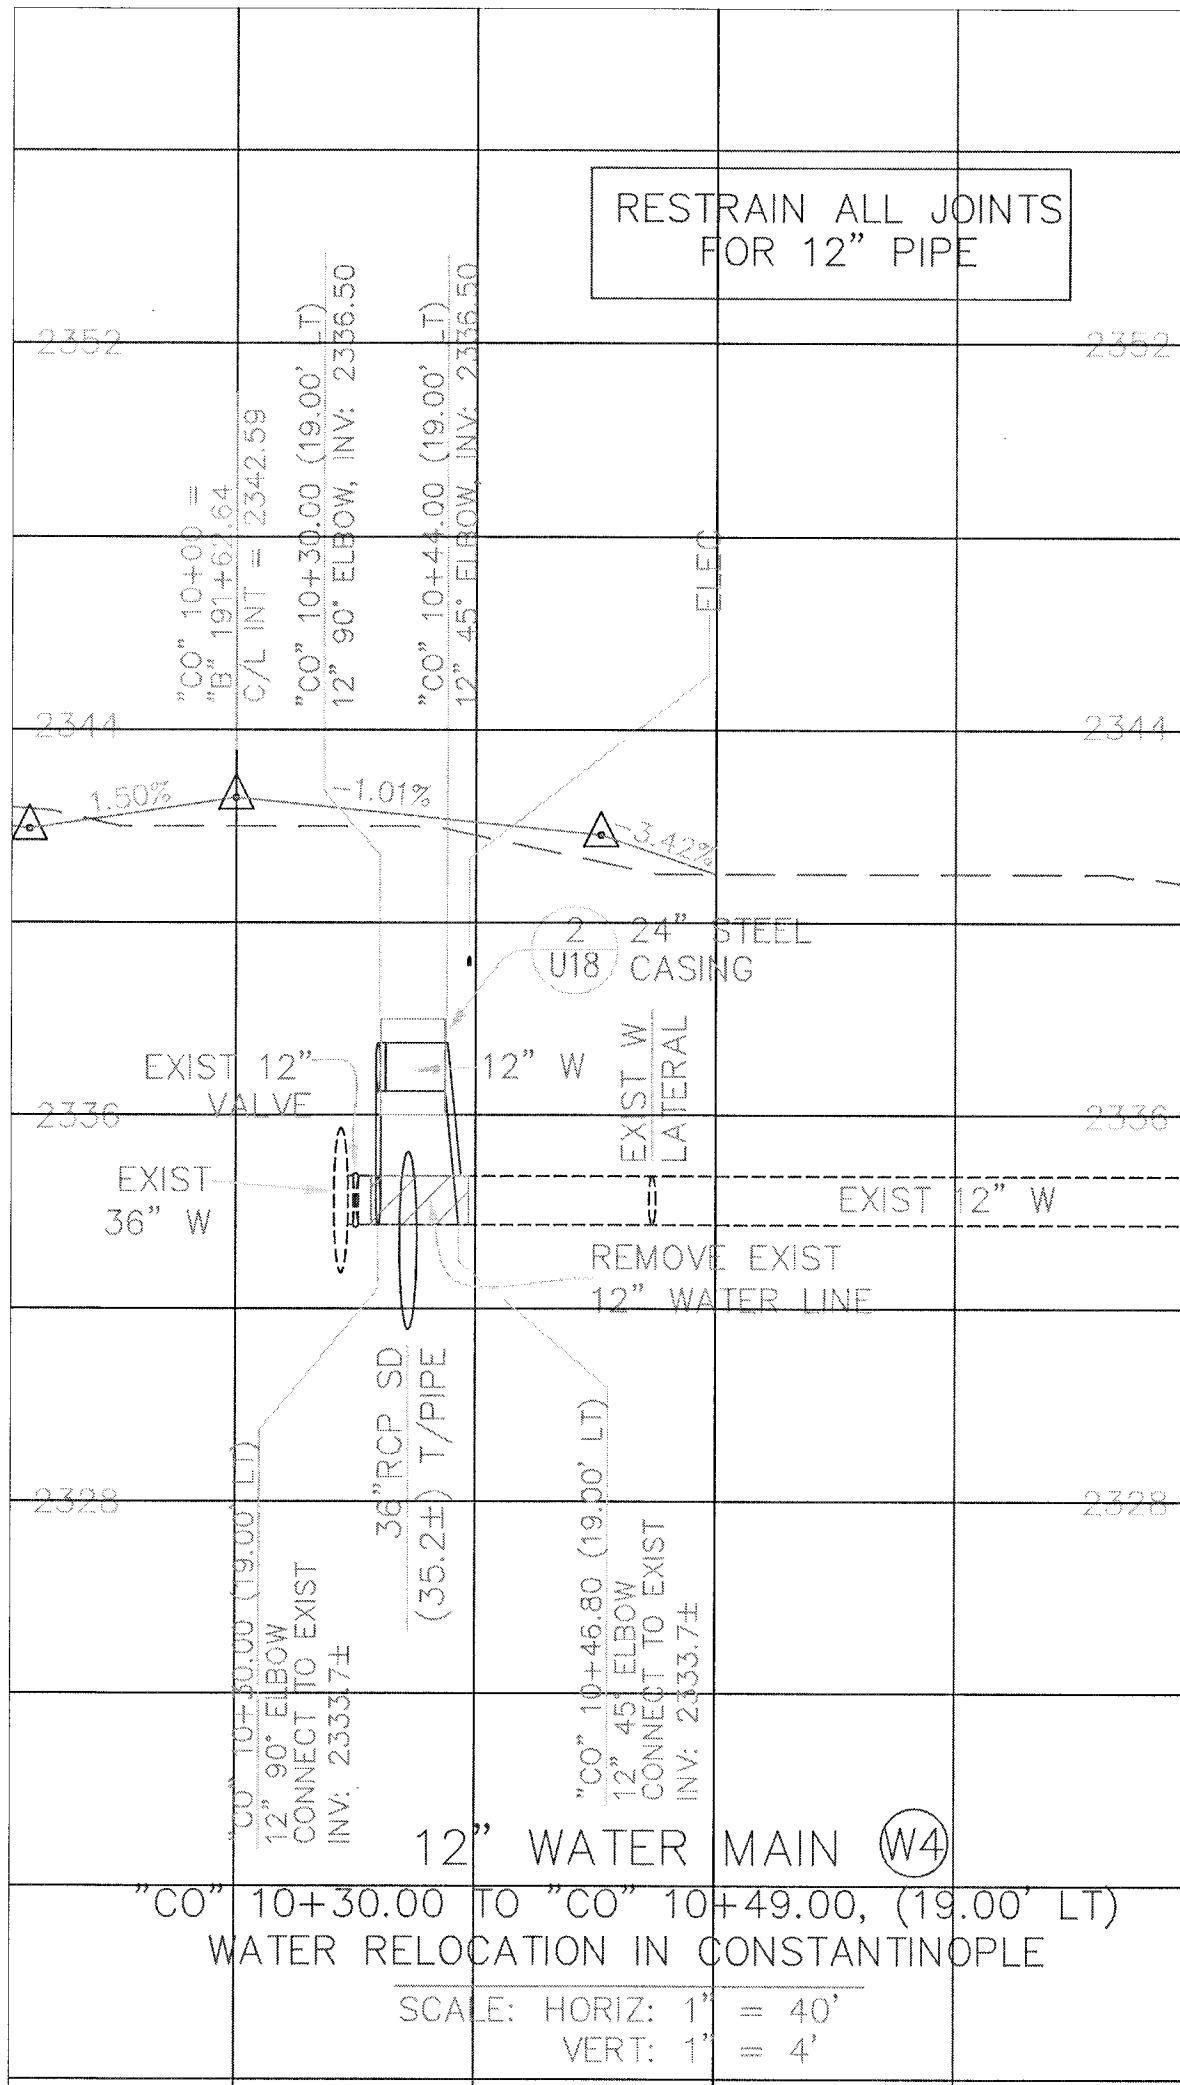
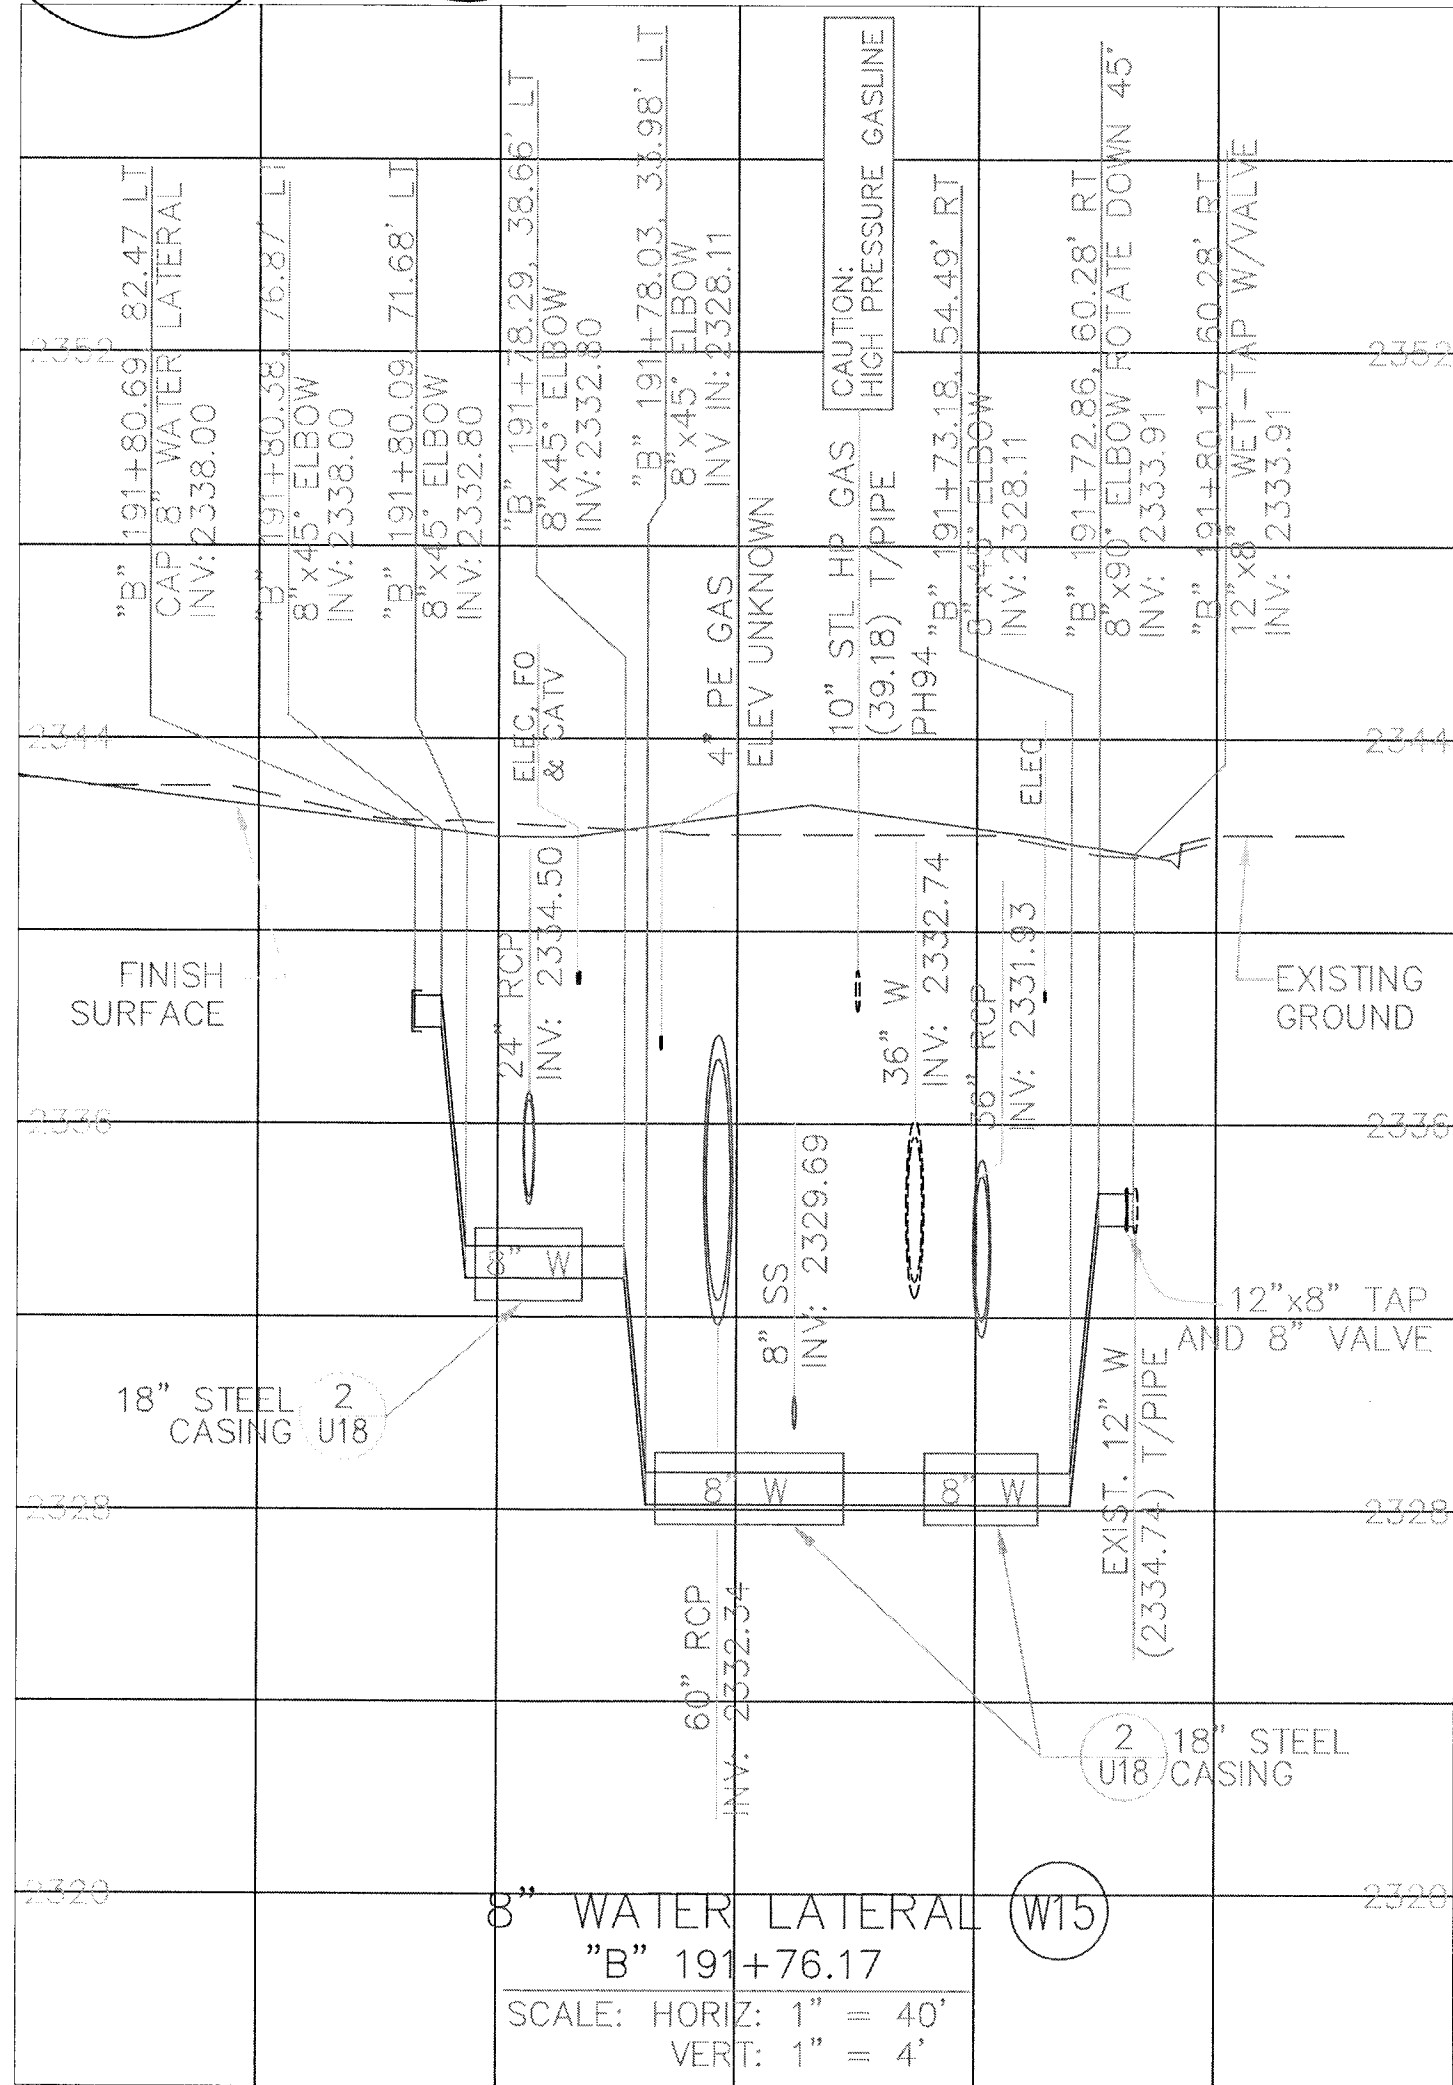


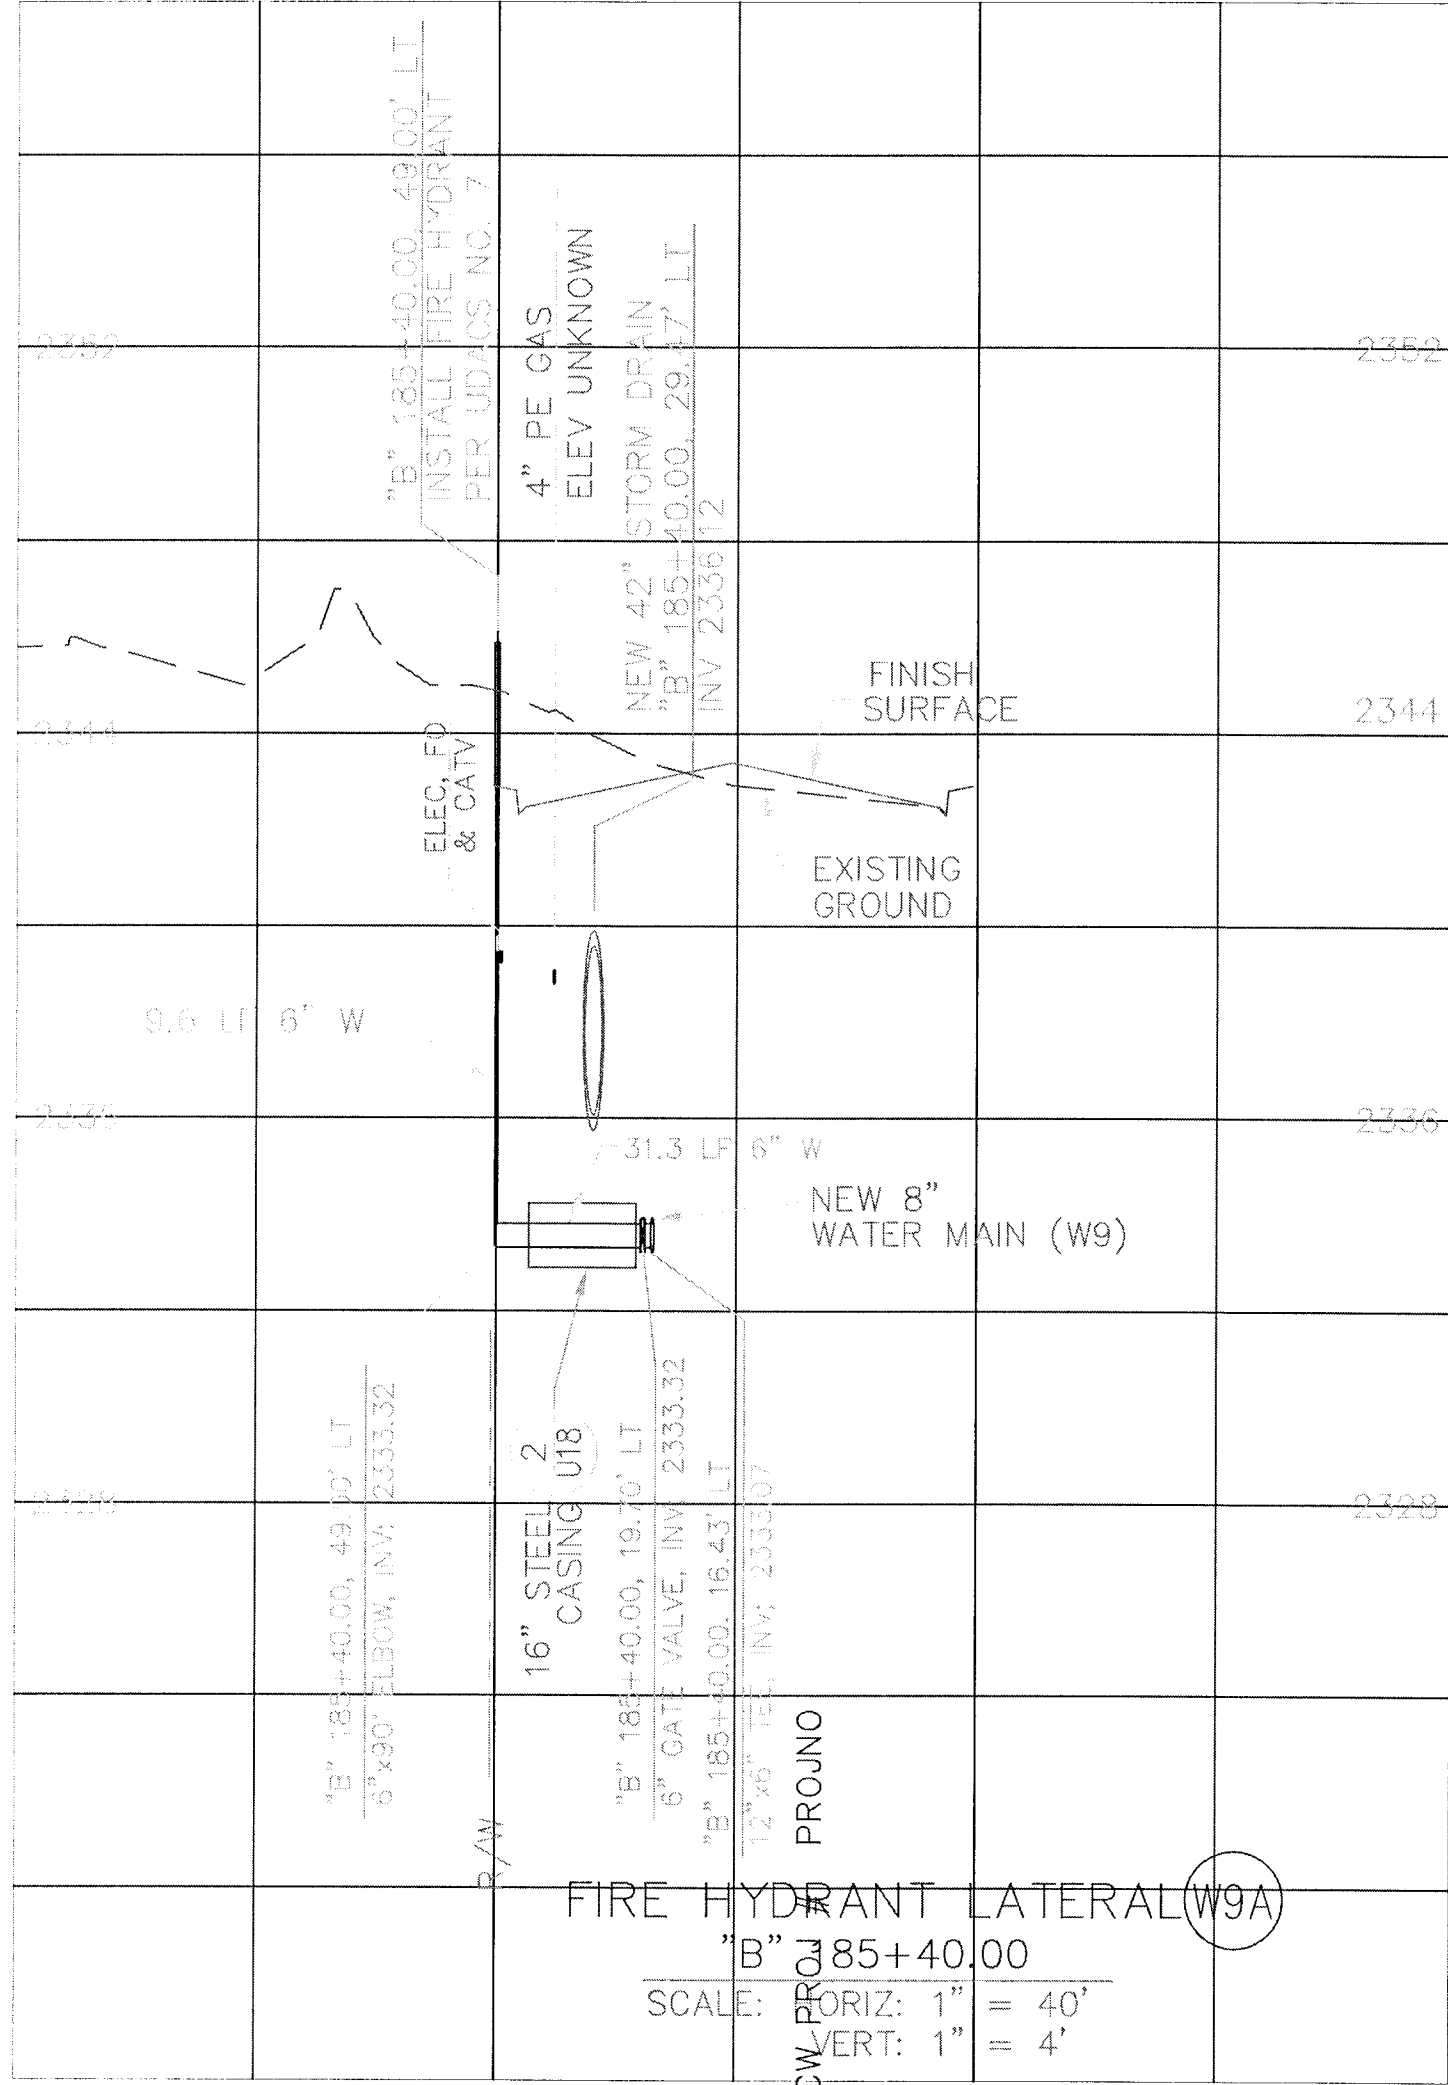

APPROVED FOR CONSTRUCTION
LAS VEGAS VALLEY WATER DISTRICT
DATE

	DRAWN BY: [Signature]		SHEET: 72 OF 93	PROJECT NO: 107-V3593	SCALE: AS-BUILT	TITLE: BUFFALO DRIVE WATERLINE LATERAL PROFILES	DEPARTMENT OF PUBLIC WORKS 400 EAST STEWART LAS VEGAS, NEVADA, NV 89101 (702) 229-6276	 G.C. WALLACE, INC. Engineers/Planners/Surveyors	9/24/03 BGR 9/05/03 BGR 7/08/03 BGR 3/18/03 BGR	WATER LATERAL ADDED REVISED FI LATERAL ADDED REVISED WATER LATERALS
	DESIGNED BY: [Signature]	CHECKED BY: [Signature]								