


**ROOF PLAN - GYMNASIUM**

SCALE: 1/8" = 1'-0"

**ROOF PLAN KEY NOTES**

1. FILASTER FEATURE, TYPICAL, SEE EXTERIOR ELEVATIONS.
2. ROOF DRAIN w/ 12" x 12" MTL. LATHE COVER GRILL AND 3" DIA. DRAIN PIPE (8" BELOW) TO REMAIN.
3. BUILT-UP ROOF, TYP. TO REMAIN.
4. REMOVE COVERED WALKWAY & RAMP, SALVAGE ROOF TILES FOR FUTURE USE. SEE DETAIL 1/D4.01, 3/D4.01
5. ROOF ACCESS LADDER TO REMAIN
6. 6" x 6" SCUPPER w/ DOWNSPOUT TO REMAIN.
7. CHIMNEY TO REMAIN.
8. CLAY TILE ROOF, TYP. TO REMAIN.
9. 4" x 1" SCUPPER TO REMAIN.
10. COMPOSITION SHINGLE ROOF TO REMAIN.
11. 18" x 4" STEP ABOVE ROOF, TYPICAL REMAIN.
12. 11" H RAISED PLATFORM (ABANDONED SKYLIGHT TYP.) TO REMAIN, TYPICAL AS SHOWN.
13. VENT CAP TO BE REMOVED. SEE DETAIL 1A/D4.02, 2/D4.02 FOR CLOSURE OF OPENINGS. REFER TO MECHANICAL DRAWINGS FOR FURTHER INFORMATION. COORDINATE ALL WORK WITH HAZARDOUS MATERIAL REMEDIATION.
14. REMOVE EXISTING MECHANICAL UNITS. REFER TO MECHANICAL DRAWINGS. SEE DETAIL 1B/D4.02, 2/D4.02 FOR CLOSURE OF OPENINGS. COORDINATE ALL WORK WITH HAZARDOUS MATERIAL REMEDIATION.
15. REMOVE ROOF TILES AND FRAMING. SALVAGE ROOF TILES FOR REUSE, PRIOR TO WORK REVIEW METHOD WITH OWNER.
16. REPAIR ROOF TO MATCH EXISTING.
17. KEEP MECHANICAL UNIT IN PLACE. REFER TO MECHANICAL DRAWING FOR REUSE OF UNIT.
18. REMOVE EXISTING MECHANICAL UNITS. REFER TO MECHANICAL DRAWINGS. SEE DETAIL 1C/D4.02, 2/D4.02 FOR CLOSURE OF OPENINGS. COORDINATE ALL WORK WITH HAZARDOUS MATERIAL REMEDIATION.


**KEY PLAN**

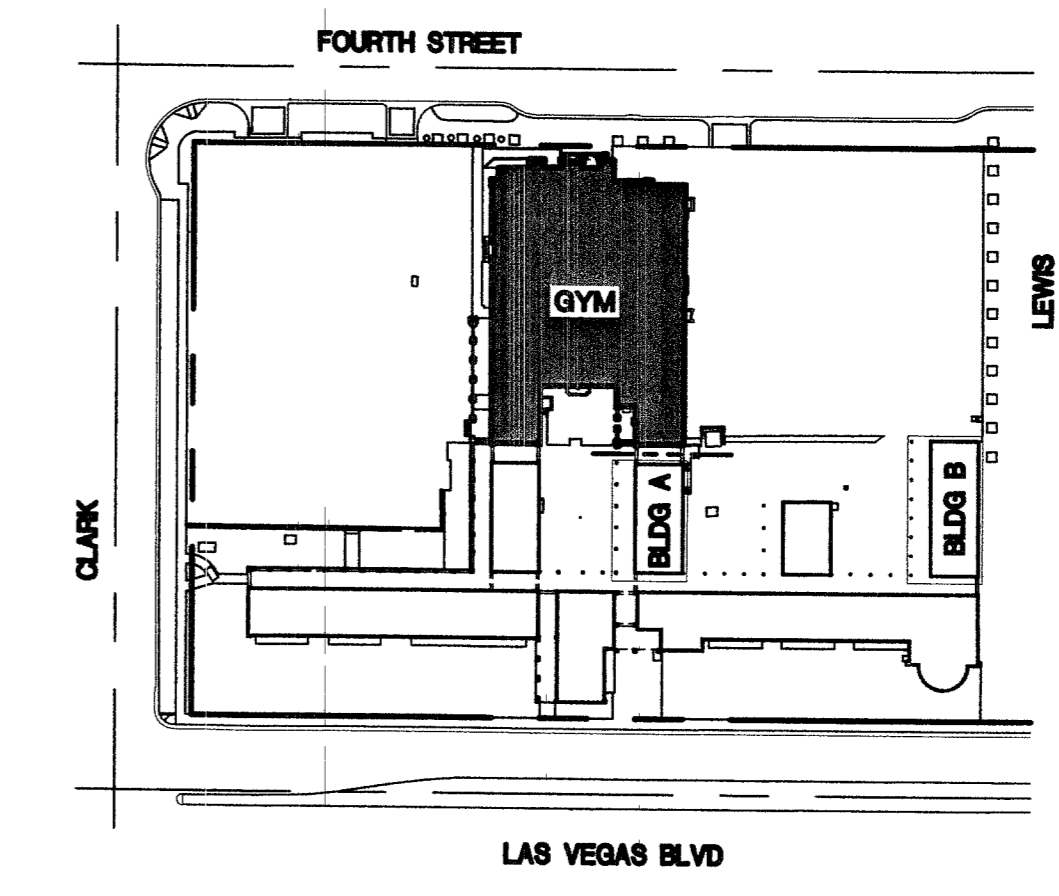

NO.	REVISION
033005	CLARIFICATION REVISIONS

**ESTAR ARCHITECTS**  
 ARCHITECTURE • PLANNING • INTERIOR DESIGN  
 707 BRIDGER AVE., SUITE 400 LAS VEGAS, NEVADA 89101  
 TELEPHONE: (702) 878-0000 FAX: (702) 878-8430  
 www.wagnarchitects.com

5TH STREET SCHOOL  
 400 SOUTH LAS VEGAS BOULEVARD  
 LAS VEGAS, NEVADA 89101  
**ROOFPLAN**

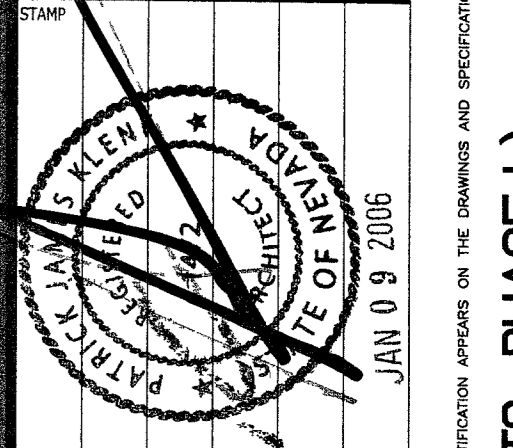

OWNER: CITY OF LAS VEGAS  
 DEPARTMENT OF PUBLIC WORKS  
 ARCHITECTURAL SERVICES

400 EAST STEWART AVENUE  
 LAS VEGAS, NEVADA 89101  
 PHONE: (702) 229-5535  
 FAX: (702) 386-4846  
 TDD: (702) 386-9108

DRAWN	JLR
FILE	D4148_s401_demo.dwg
DATE	01/01/05
SCALE	AS NOTED
BID NO	05B34103
CLY DWG NO	RD-65C
SHT NO	9

**D4.01**

REVISED 8/27/03

87651

CONSTRUCTION DOCUMENTS ( AS BUILTS - PHASE I )