
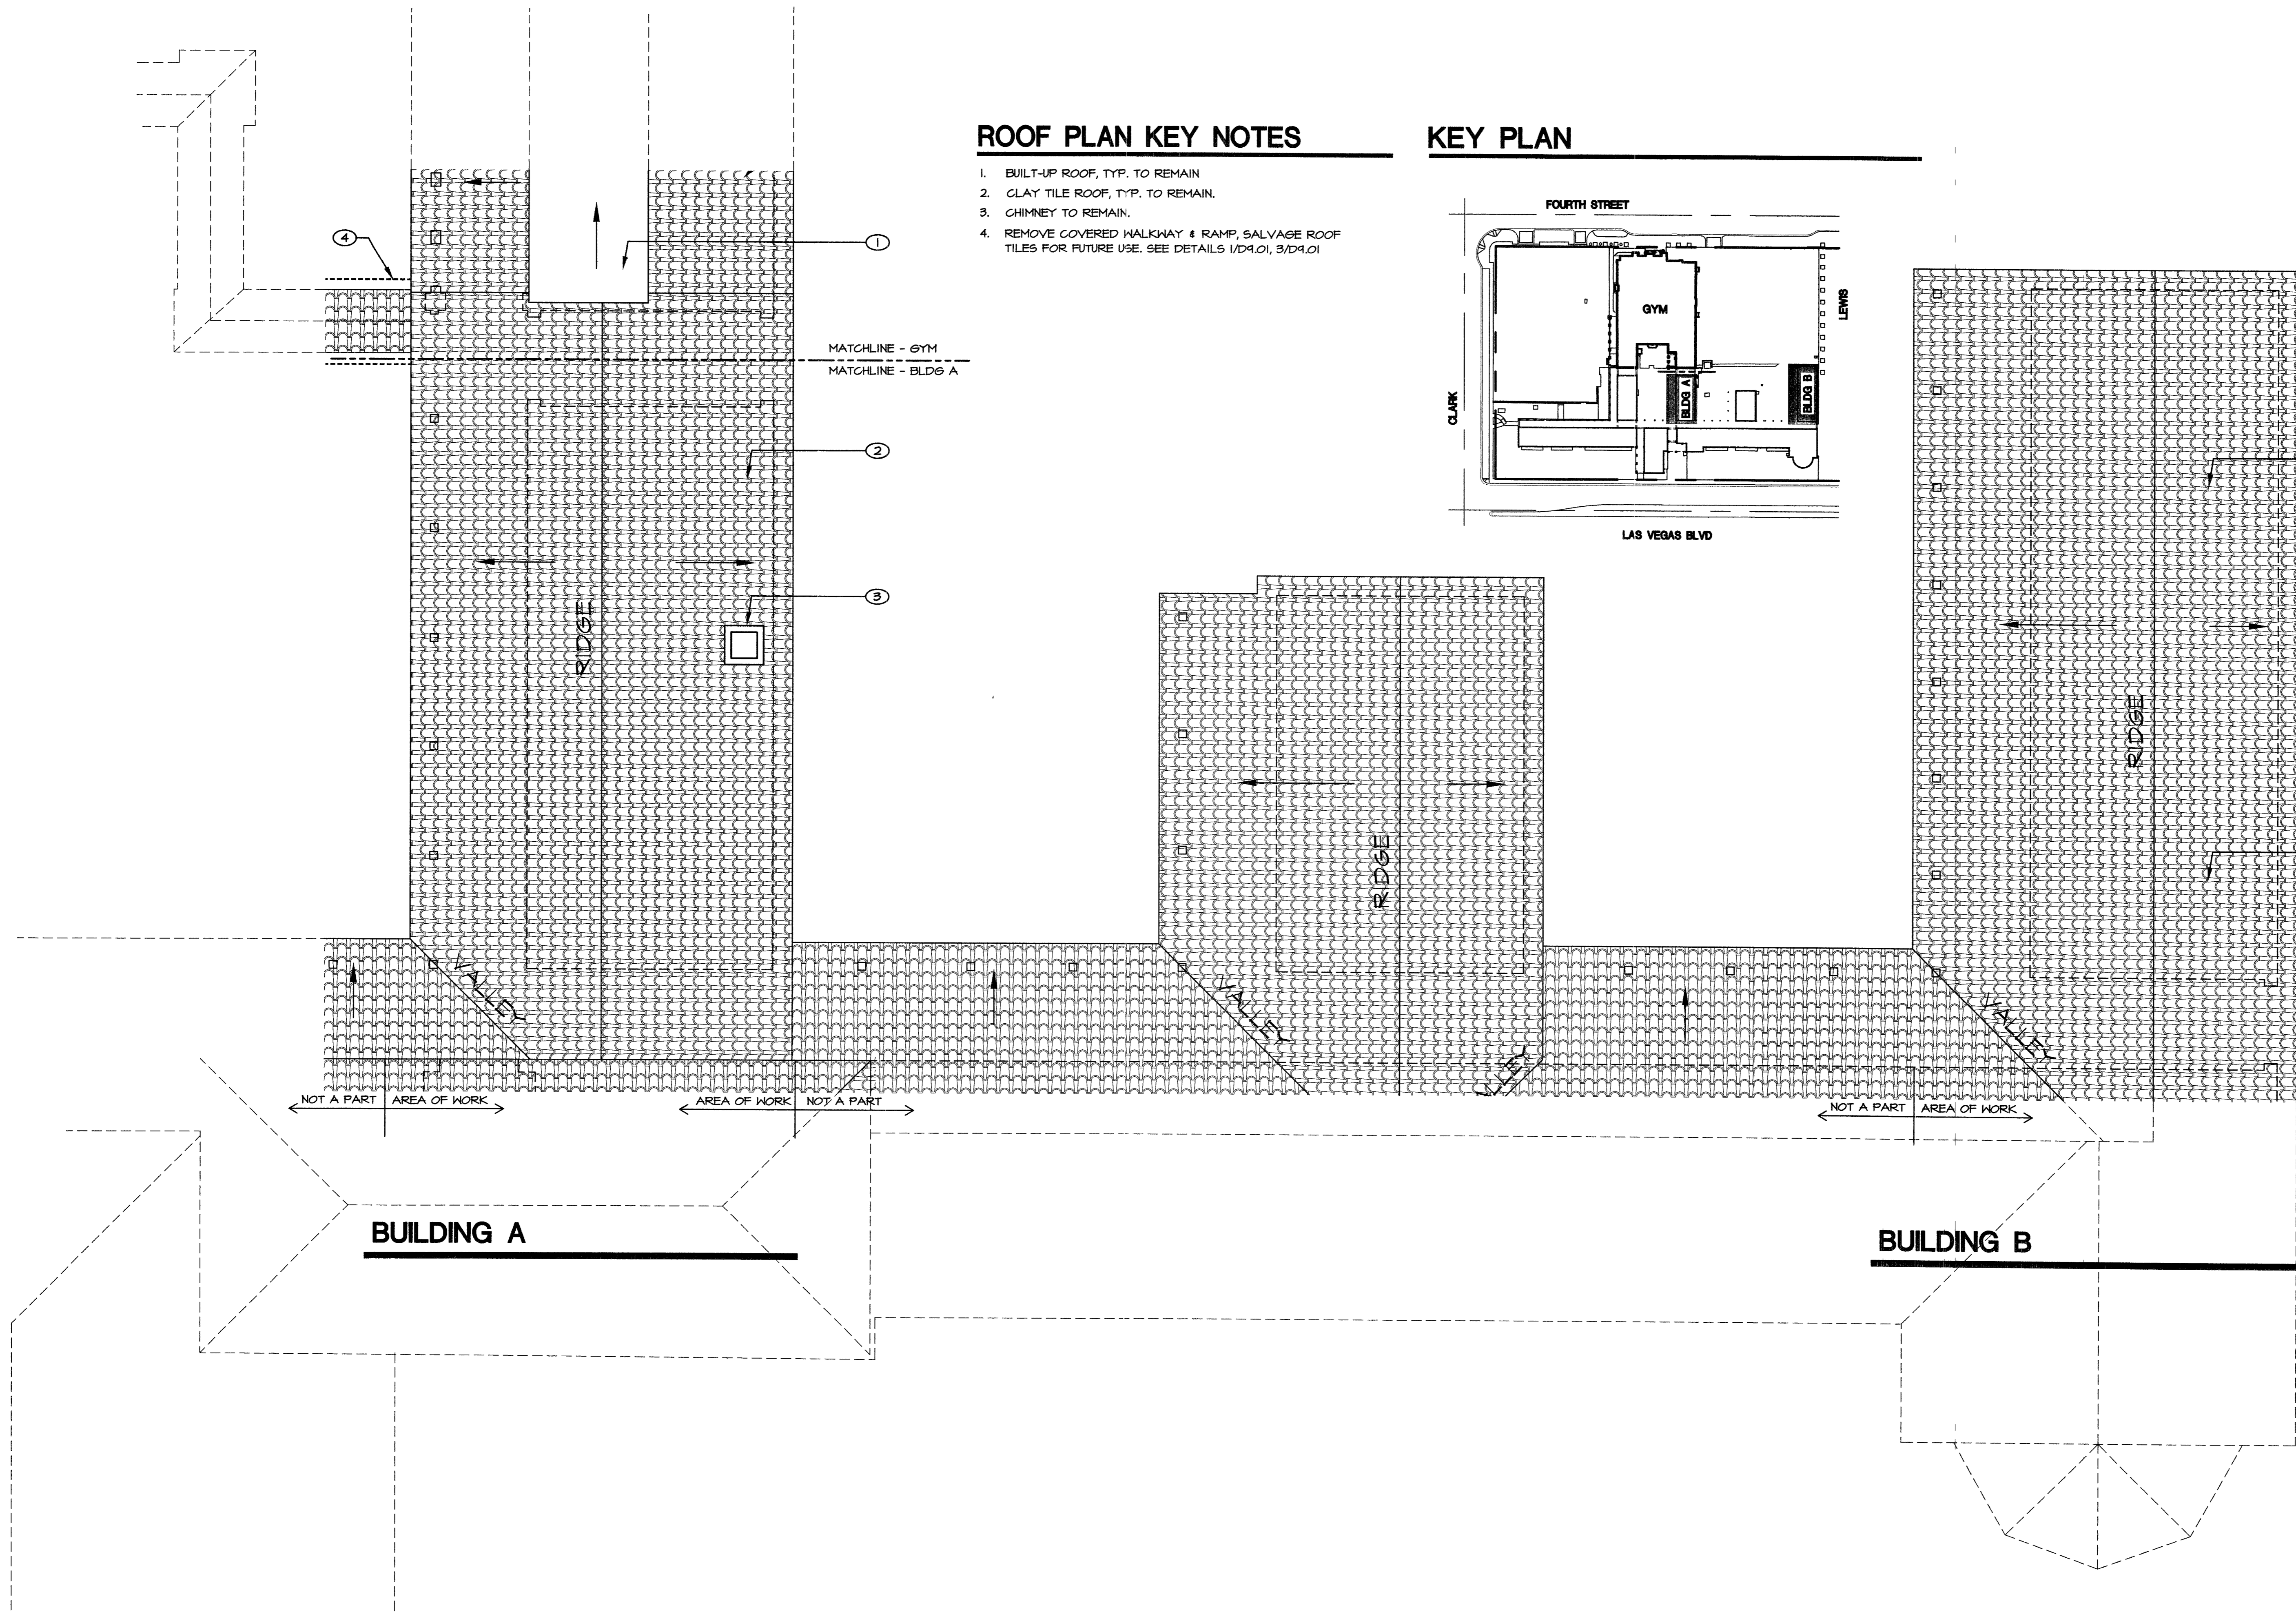


**ROOF PLAN KEY NOTES**


1. BUILT-UP ROOF, TYP. TO REMAIN
2. CLAY TILE ROOF, TYP. TO REMAIN
3. CHIMNEY TO REMAIN.
4. REMOVE COVERED WALKWAY & RAMP, SALVAGE ROOF TILES FOR FUTURE USE. SEE DETAILS 1/D4.01, 3/D4.01

**KEY PLAN**

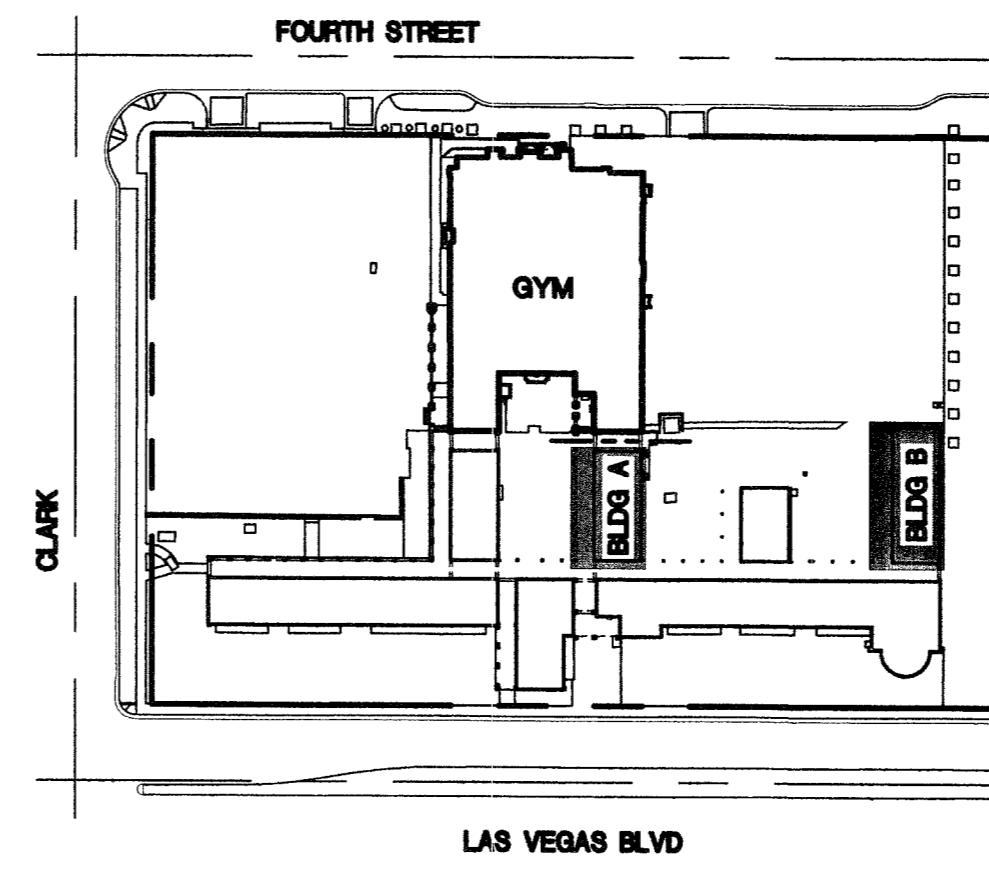

**ROOF PLAN - BUILDING A & B**

SCALE: 1/8" = 1'-0"

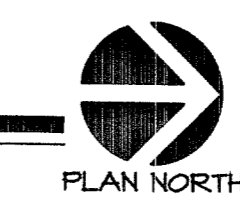

REVISIONS	
CONSULTANT	
<b>WESTAR ARCHITECTS</b> ARCHITECTURE • PLANNING • INTERIOR DESIGN 701 BRIDGER AVE., SUITE 400 LAS VEGAS, NEVADA 89101 TELEPHONE: (702) 878-0000 FAX: (702) 878-8430 WWW.WESTARCHITECTS.COM	
<b>5TH STREET SCHOOL</b> <b>400 SOUTH LAS VEGAS BOULEVARD</b> LAS VEGAS, NEVADA 89101 <b>ROOFPLAN</b>	
DATE	JAN 09 2006
OWNER:	CITY OF LAS VEGAS DEPARTMENT OF PUBLIC WORKS ARCHITECTURAL SERVICES
400 EAST STEWART AVENUE LAS VEGAS, NEVADA 89101 PHONE: (702) 229-6536 FAX: (702) 384-4846 TDD: (702) 386-9108	
DRN:	JLR
FILE:	D4148_a402_demo.dwg
DATE:	01/09
SCALE:	AS NOTED
BID NO:	05B34103
CLY DRG NO:	5B-68C
SHT NO:	10
<b>D4.02</b>	

CONSTRUCTION DOCUMENTS ( AS BUILTS- PHASE I )

87652