



7 NORTH ELEVATION - BUILDING B
 SCALE: 1/8" = 1'-0"

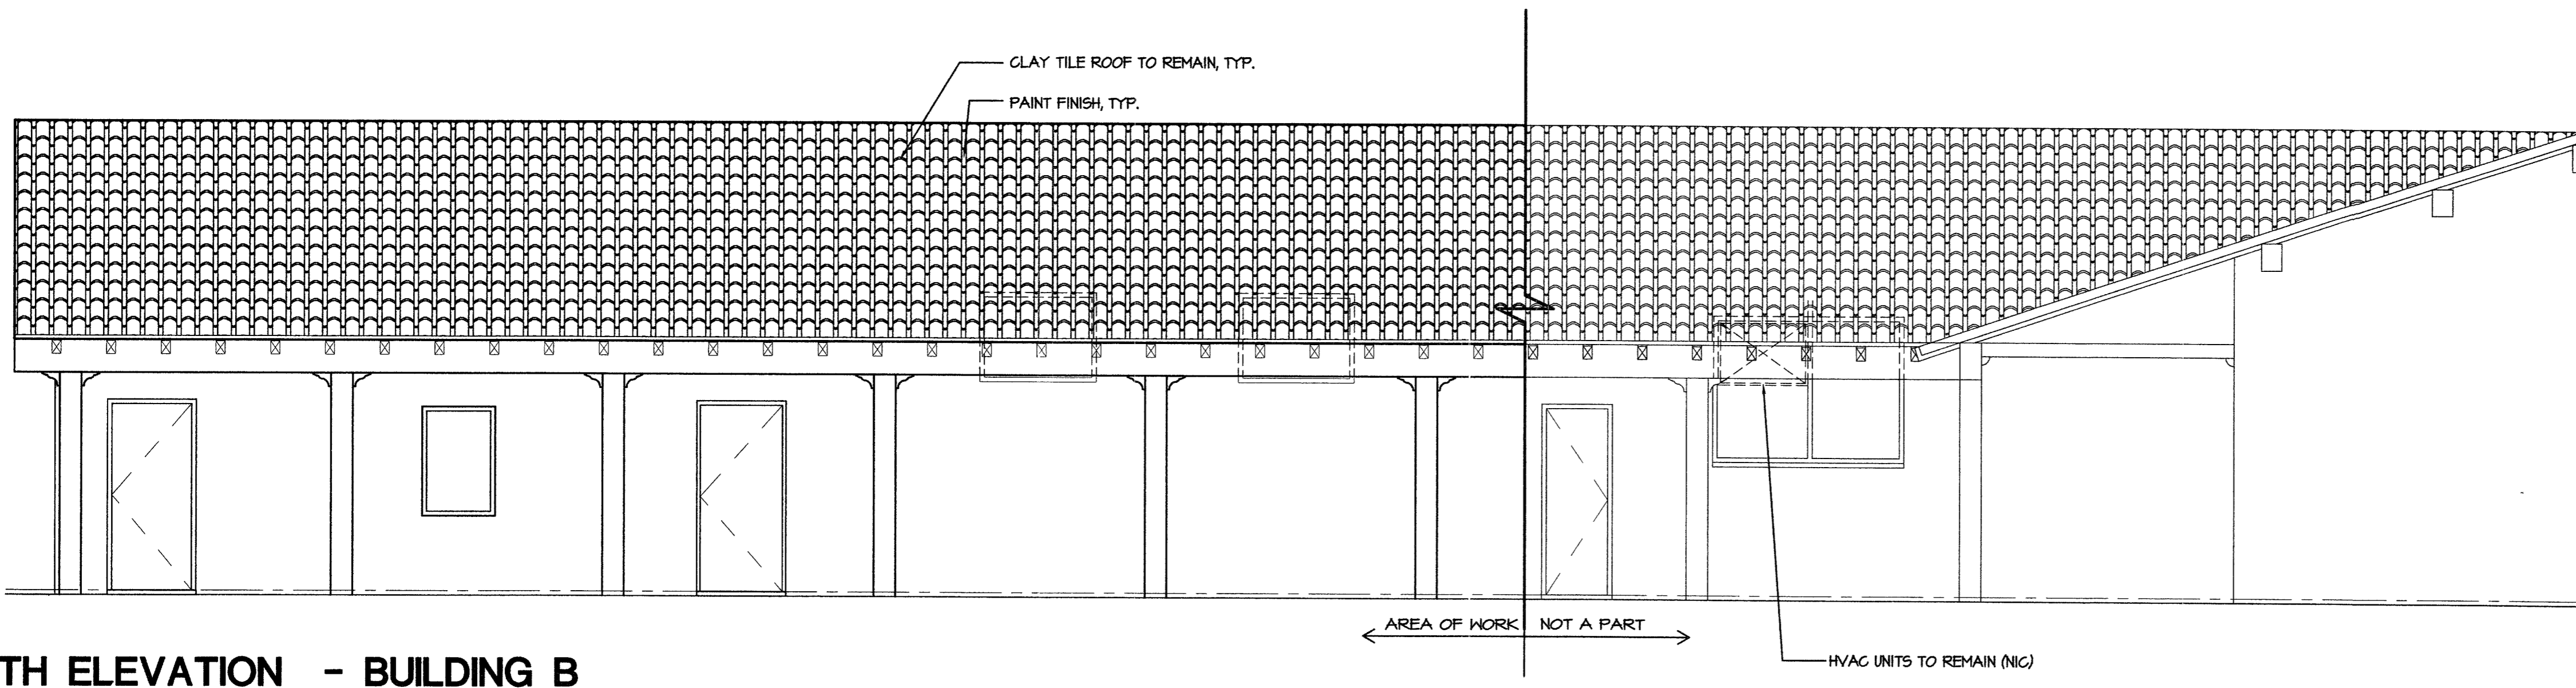

8 SOUTH ELEVATION - BUILDING B
 SCALE: 1/8" = 1'-0"

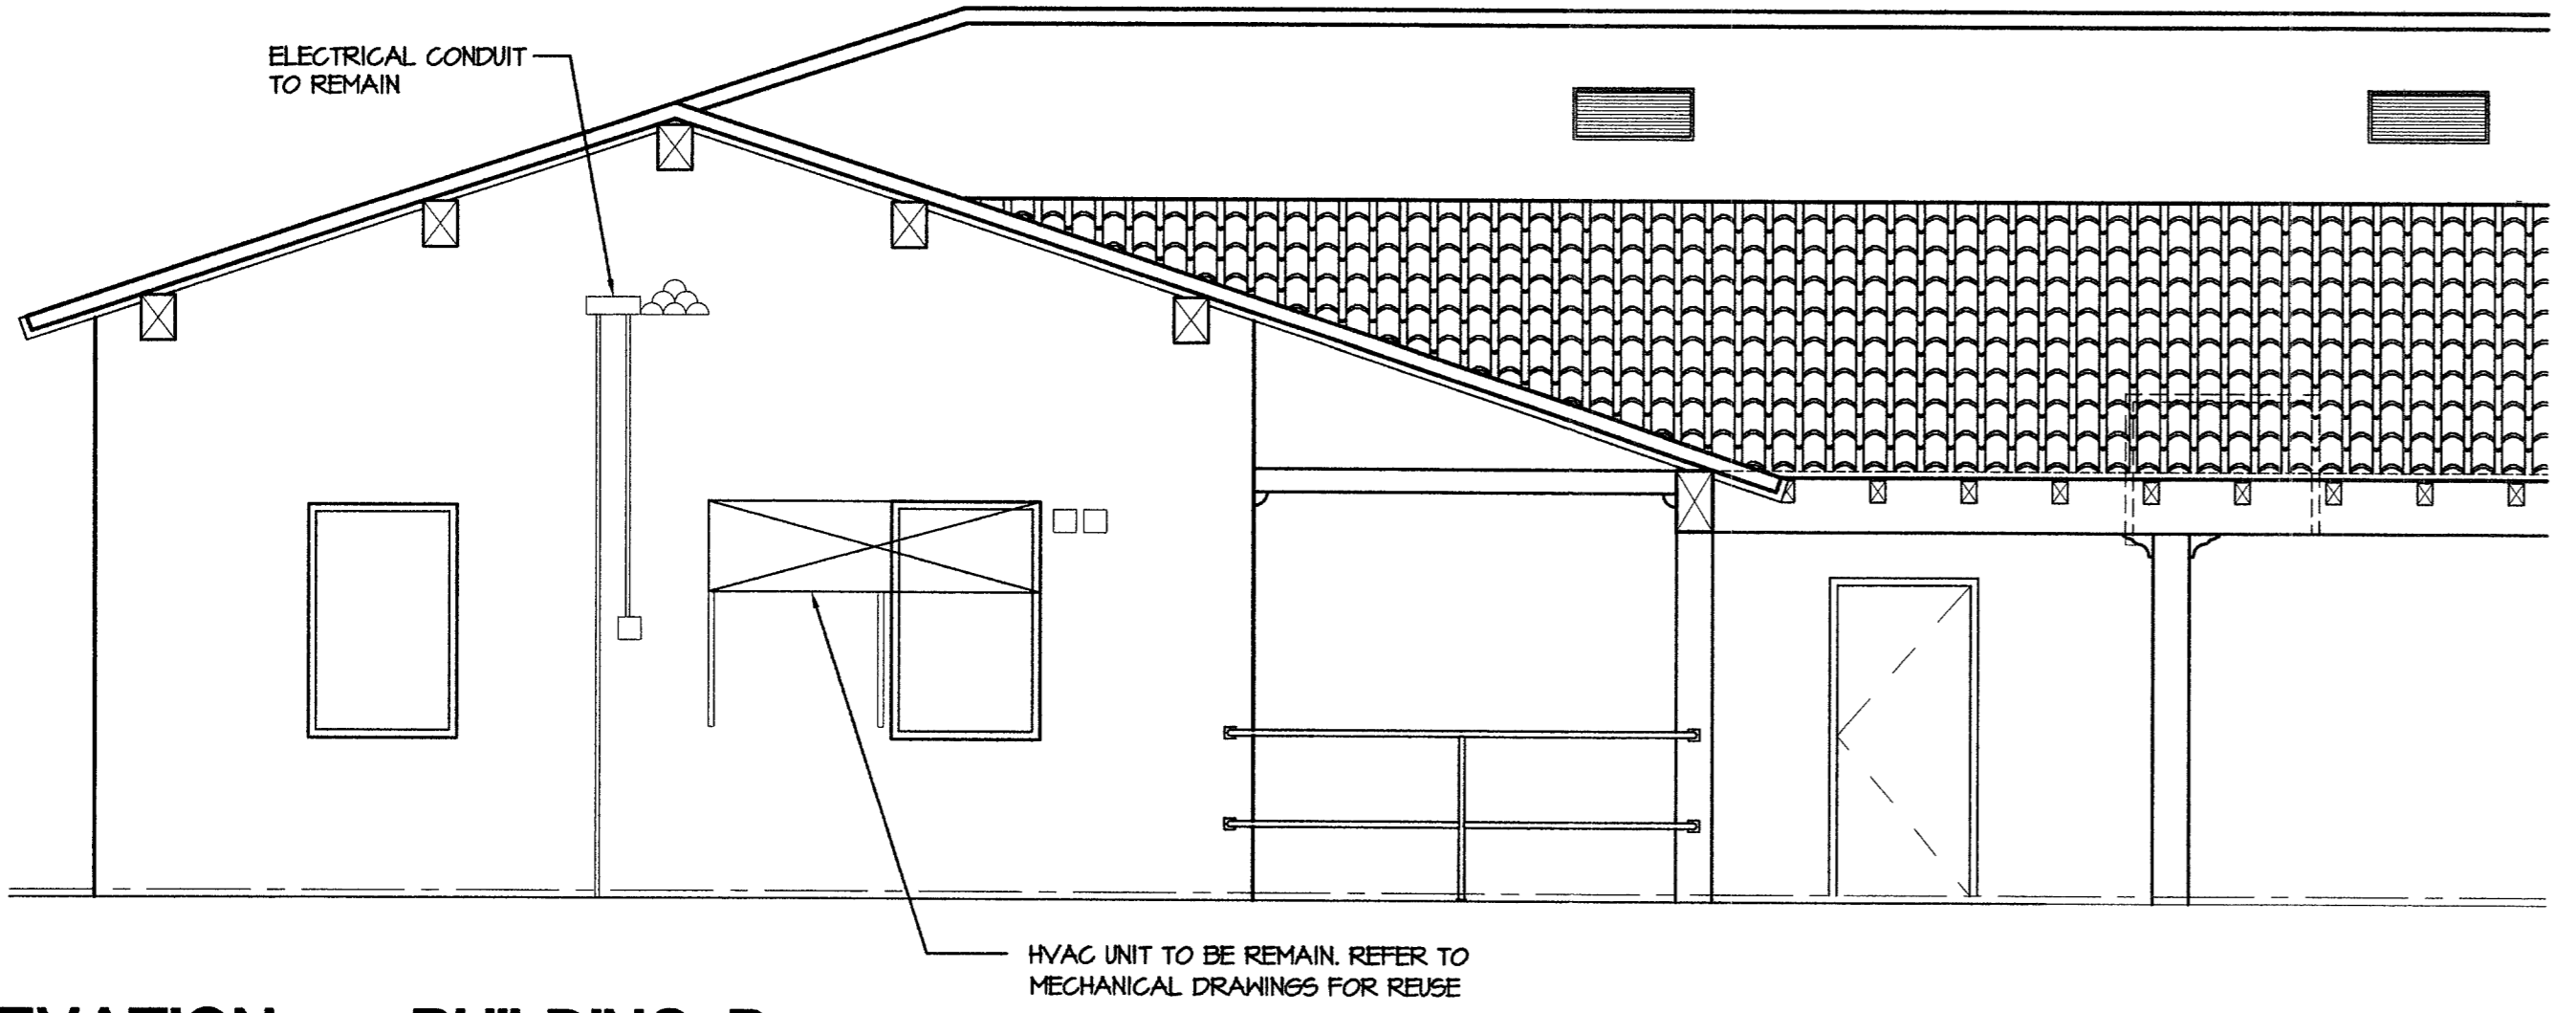


9 WEST ELEVATION - BUILDING B
 SCALE: 1/8" = 1'-0"

87655

REVISORS
 CONSULTANT
WAGNAR ARCHITECTS
 ARCHITECTURE • PLANNING • INTERIOR DESIGN
 701 BRIDGER AVE., SUITE 400 LAS VEGAS, NEVADA 89101
 TELEPHONE: (702) 878-0000 FAX: (702) 878-8430
 www.wagnarchitects.com

5TH STREET SCHOOL
 400 SOUTH LAS VEGAS BOULEVARD
 LAS VEGAS, NEVADA 89101
 ELEVATIONS

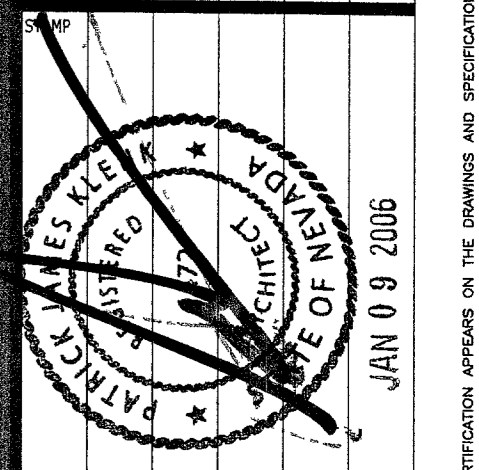

OWNER: CITY OF LAS VEGAS
 DEPARTMENT OF PUBLIC WORKS
 ARCHITECTURAL SERVICES

400 EAST STEWART AVENUE
 LAS VEGAS, NEVADA 89101
 PHONE: (702) 229-5535
 FAX: (702) 386-8846
 TDD: (702) 386-9108

DRAWN: JLJR
 FILE: 04148_a608_demo.dwg
 DATE: 01/07/05
 SCALE: AS NOTED
 BID NO: 06B34108
 CLDWG NO: 5B-65C

1/3
 SHEET NO:
D6.03

REVISED 8/27/03

CONSTRUCTION DOCUMENTS (AS BUILTS - PHASE I)