



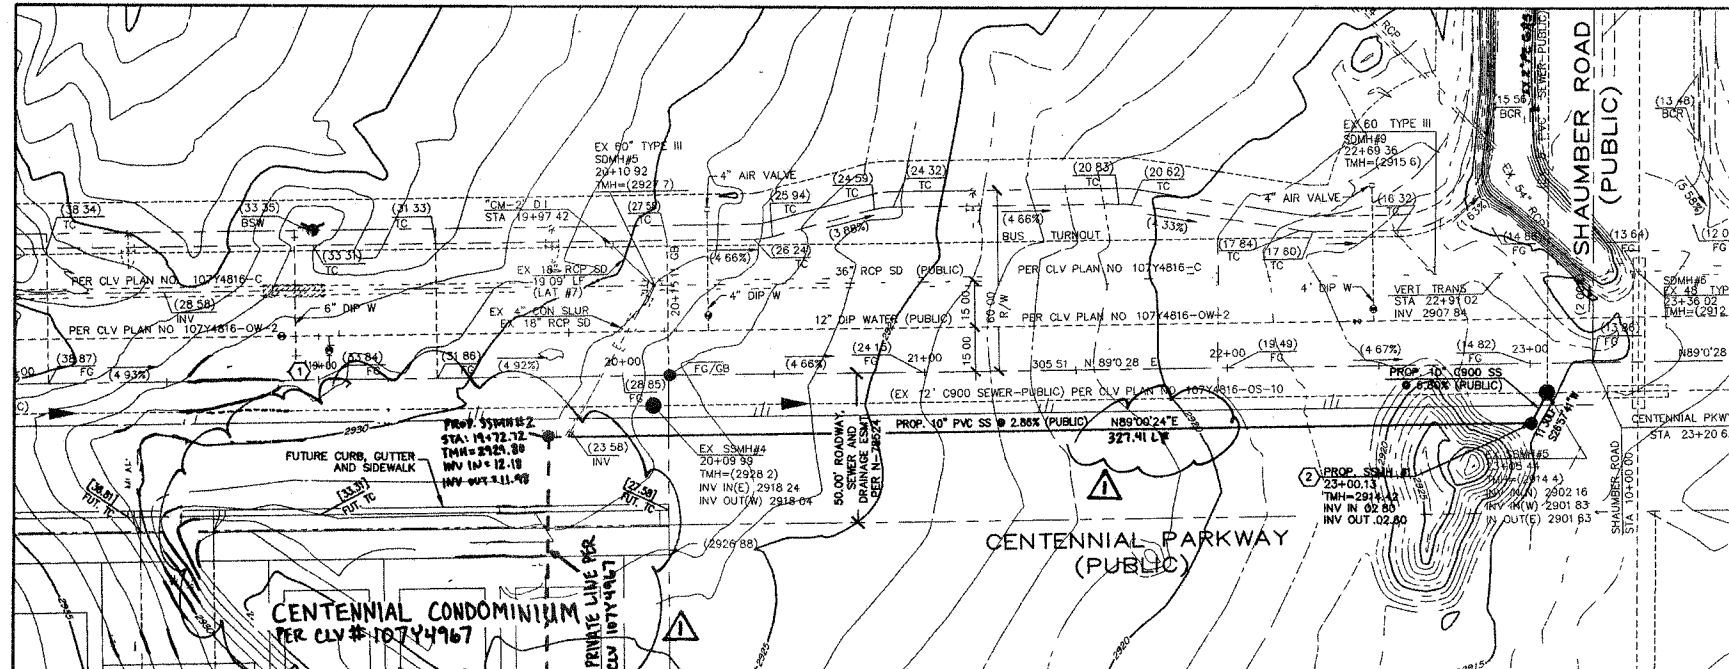


SANITARY SEWER (CENTENNIAL PARKWAY)

(PUBLIC)

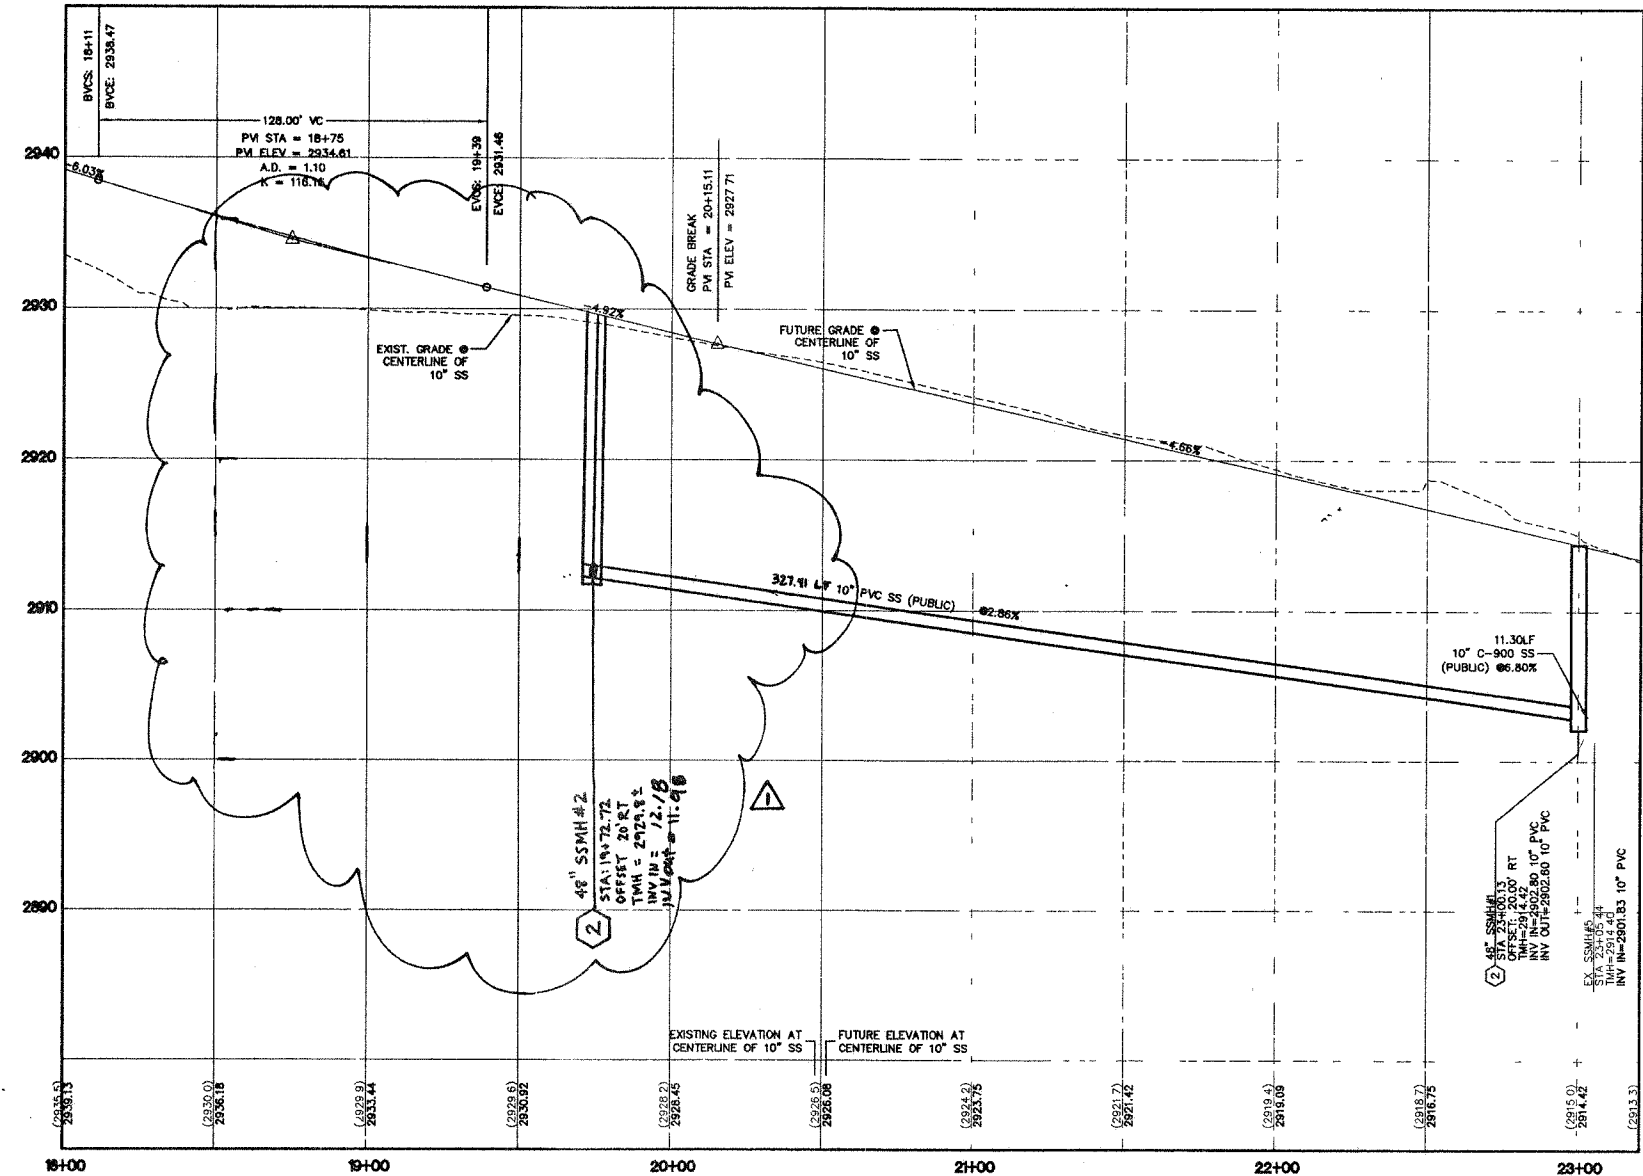


PROFILE

HOR 1" = 30'
VERT 1" = 6'

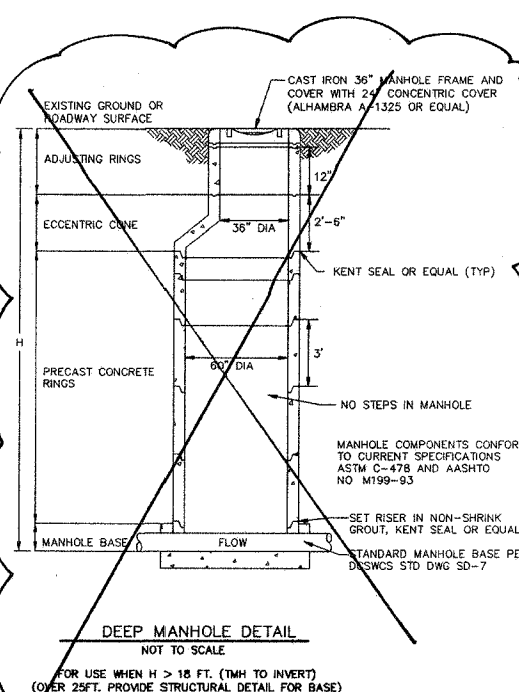


DEEP MANHOLE DETAIL

NOT TO SCALE
(FOR USE WHEN H > 15 FT. (TMH TO INVERT)
(OVER 25FT. PROVIDE STRUCTURAL DETAIL FOR BASE)

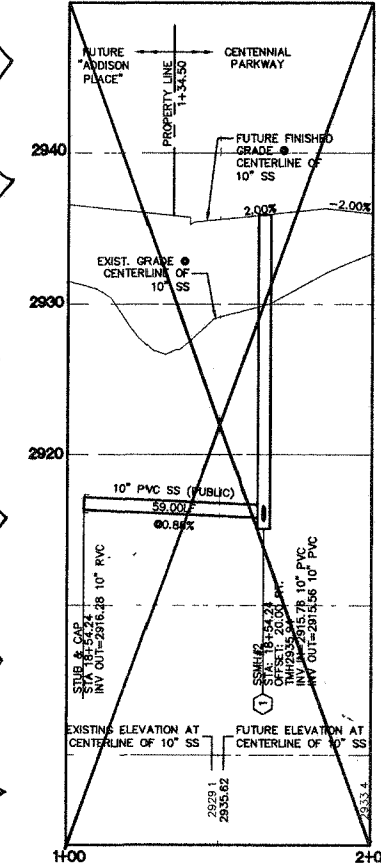

LINE "A" PROFILE

HOR 1" = 30'
VERT 1" = 6'

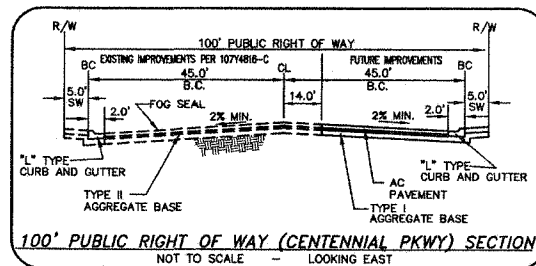


100' PUBLIC RIGHT OF WAY (CENTENNIAL PKWY) SECTION
NOT TO SCALE - LOOKING EAST

ENGINEER
SAMI ALHWAYEK
No. 10502
Exp. 12-31-08
CIVIL

NORTH

6/27/08
FOR REV. ONLY

SCALE 1"=30'
GRAPHIC SCALE
(IN FEET)
1 inch = 30 ft.

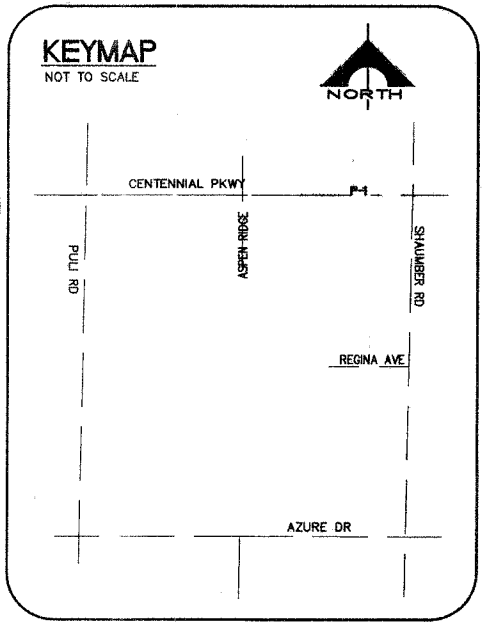

Call before you Dig.
1-800-227-2600
UNDERGROUND SERVICE (USA)

Call before you Dig.
1-702-593-6111

Call before you Dig.
1-702-455-7511
1-702-229-6611

SEWER ASBUILT BUILT PER PLAN CONSTRUCTION NOTES

- CONSTRUCT STANDARD SEWER MANHOLE PER DCSWCS STD DWG SD-1.

NOTE:
ALL EXISTING UTILITIES SHOWN FOR GRAPHICAL PURPOSES ONLY. CONTRACTOR RESPONSIBLE FOR UTILITY LOCATE AND VERIFICATION. ENGINEER MUST BE NOTIFIED OF ANY DESPEPENCY.

BASIS OF BEARINGS
N 00°37'29" W - BEING ALONG THE WEST LINE OF THE NORTHWEST QUARTER (NW 1/4) OF THE NORTHWEST QUARTER (NW 1/4) OF SECTION 25, TOWNSHIP 19 SOUTH, RANGE 60 EAST, M.D.M. AS SHOWN BY THAT CERTAIN MAP RECORDED IN FILE 104 AT PAGE 74 OF SURVEYS IN THE OFFICE OF THE COUNTY RECORDER, CLARK COUNTY, NEVADA.

BENCHMARK
CLV BENCHMARK: BLV80 30W4
NAVD 88V.2002 ELEVATION: 834.6354 (METERS), 2738.30(FOOT)
RIVET AND PLATE IN CONCRETE PAD (ELEC) NE CORNER OF HUALAPAI & TROPICAL PARKWAY.

GRADING NOTES

- ADD 2900 FT TO ALL PROPOSED ELEVATIONS.
- ALL GRADING FILL PLACEMENT AND COMPACTION, TRENCH BACKFILL, OVEREXCAVATION, RETAINING WALL BENCHING AND BACKFILL, AND SITE CLEARING SHOWN HEREON SHALL BE IN CONFORMANCE WITH THE GEOTECHNICAL EXPLORATION REPORT.

ENGINEER
G.C. WALLACE, INC.
No. 10502
Exp. 12-31-08
CIVIL

DATE: 10/13/06

DESIGN: []
DRAWN: []
CHECK: []
ISSUE DATE: []
PLOT DATE: 10-31-06
PLOT TIME: 09:54:10

111052
97006
120333

307V979
H#17410

CLV DWS# 17410

3 OF 3 SHTS

P-1

SEWER ASBUILT

CENTENNIAL PARKWAY SEWER

SEWER PROFILE

STA 18+54.24 TO 23+05.44