




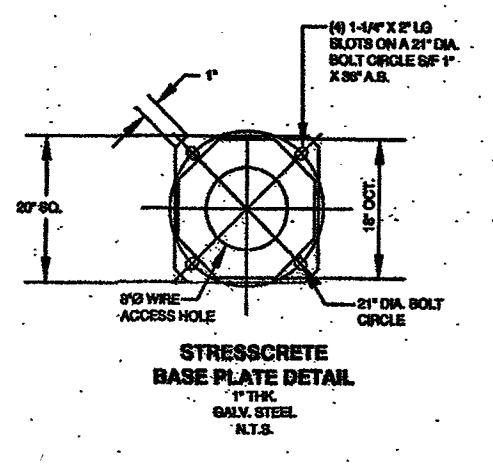


1. *Chlorophyll a* and *Chlorophyll b* were determined by the method of Lichtenthaler and Sponholz (1980). The total chlorophyll content was determined by the method of Arar and Johnson (1977). The carotenoid content was determined by the method of Lichtenthaler and Sponholz (1980). The total carotenoid content was determined by the method of Arar and Johnson (1977). The total protein content was determined by the method of Lowry et al. (1951). The total lipid content was determined by the method of Bligh and Dyer (1959). The total carbohydrate content was determined by the method of Dubois and Gilles (1950). The total nucleic acid content was determined by the method of Burton (1956). The total ash content was determined by the method of AOAC (1990). The total moisture content was determined by the method of AOAC (1990). The total dry matter content was determined by the method of AOAC (1990). The total organic acid content was determined by the method of AOAC (1990). The total alkaloid content was determined by the method of AOAC (1990). The total flavonoid content was determined by the method of AOAC (1990). The total phenolic content was determined by the method of AOAC (1990). The total tannin content was determined by the method of AOAC (1990). The total saponin content was determined by the method of AOAC (1990). The total sterol content was determined by the method of AOAC (1990). The total glycoside content was determined by the method of AOAC (1990). The total alkaloid content was determined by the method of AOAC (1990). The total flavonoid content was determined by the method of AOAC (1990). The total phenolic content was determined by the method of AOAC (1990). The total tannin content was determined by the method of AOAC (1990). The total saponin content was determined by the method of AOAC (1990). The total sterol content was determined by the method of AOAC (1990). The total glycoside content was determined by the method of AOAC (1990).




CLOAKING NO. 1045-4149  
 CANNISTER  
 MATERIAL: ALUMINUM  
 FINISH: BLACK/BLACK  
 COATING REQUIRED:  
 1 COAT ANTI-OXIDANT  
 PAINT LENGTH

Diagram illustrating the required bolt placement for a street light pole:

- BASE OF STREET LIGHT POLE SET 2" BELOW GRADE
- TOP OF BOLT TO BE 12" BELOW GRADE IN SIDEWALK AREAS. BOLTS SHALL HAVE 12" OF CONCRETE COVER IN ALL AREAS

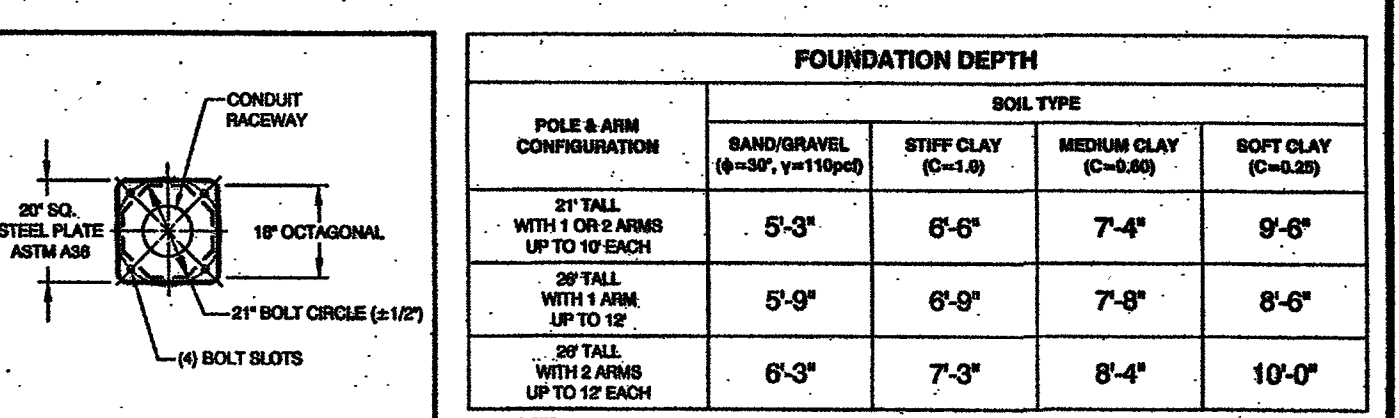

|                                                                                                              |  |                                                                             |  |
|--------------------------------------------------------------------------------------------------------------|--|-----------------------------------------------------------------------------|--|
| NOTES:                                                                                                       |  | 1. 2" CONCRECTOR MEASURED IN HPS PER SQUARE FOOT.                           |  |
| 2. CONTRACTOR SHALL DETERMINE ADEQUATE TYPE BY TAKING UNDISTURBED SAMPLES AS REQUIRED BY THE CITY ENGINEERS. |  | 3. ANALYSIS BY PROFESSIONAL STRUCTURAL ENGINEER ON FILE WITH CITY ENGINEER. |  |
| AGENCY APPROVED                                                                                              |  | L                                                                           |  |
| UNIFORM STANDARD DRAWINGS<br>CLARK COUNTY AREA                                                               |  |                                                                             |  |
| CITY OF LAS VEGAS<br>STREET LIGHT POLE FOUNDATION<br>FOR DOWNTOWN CENTENNIAL<br>AND TOWN CENTER AREAS        |  |                                                                             |  |
| DATE 11-6-17                                                                                                 |  | DWG. NO. 343                                                                |  |

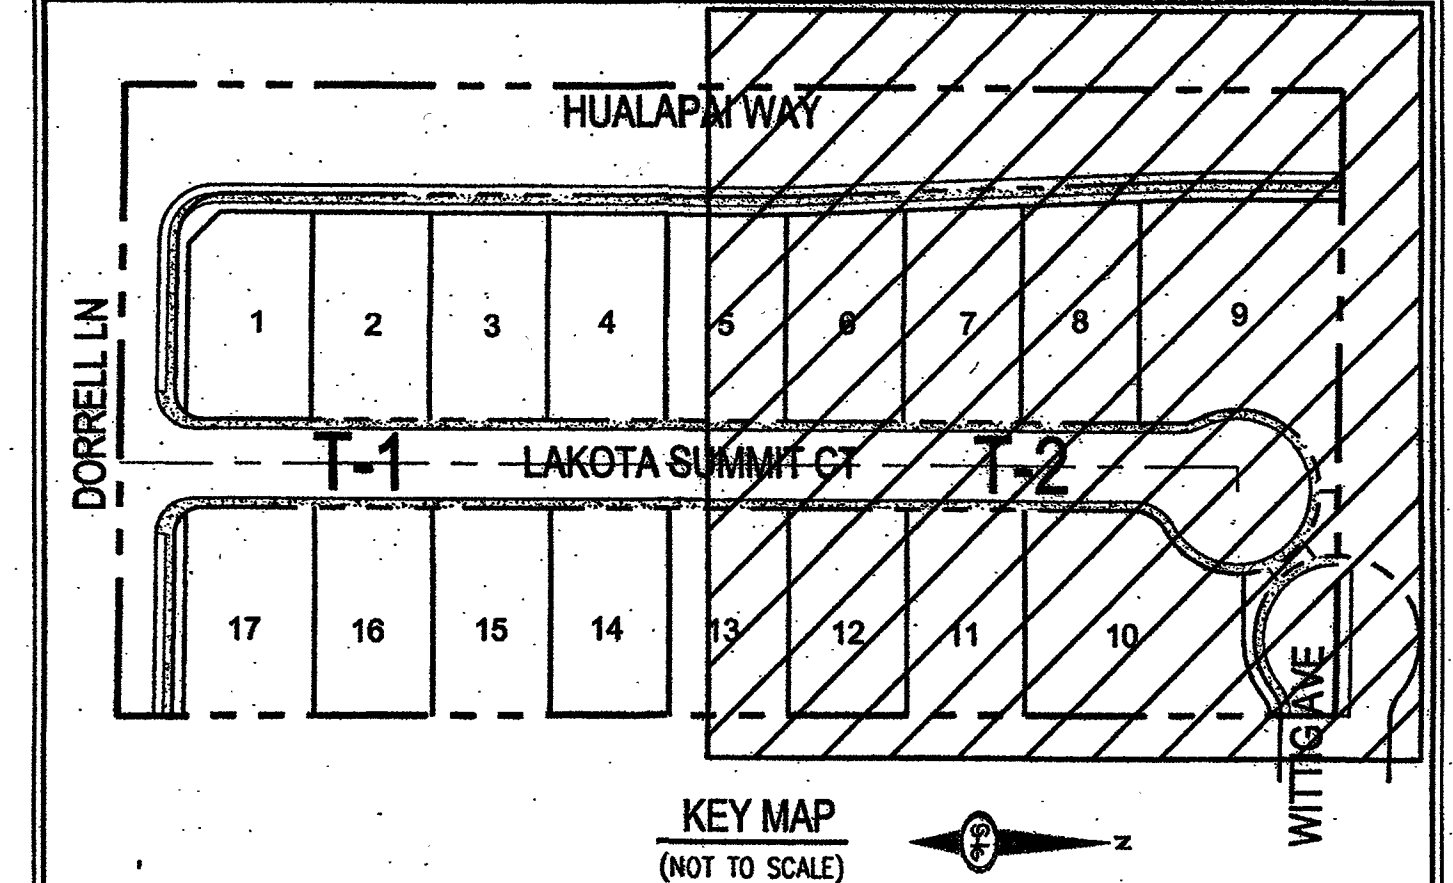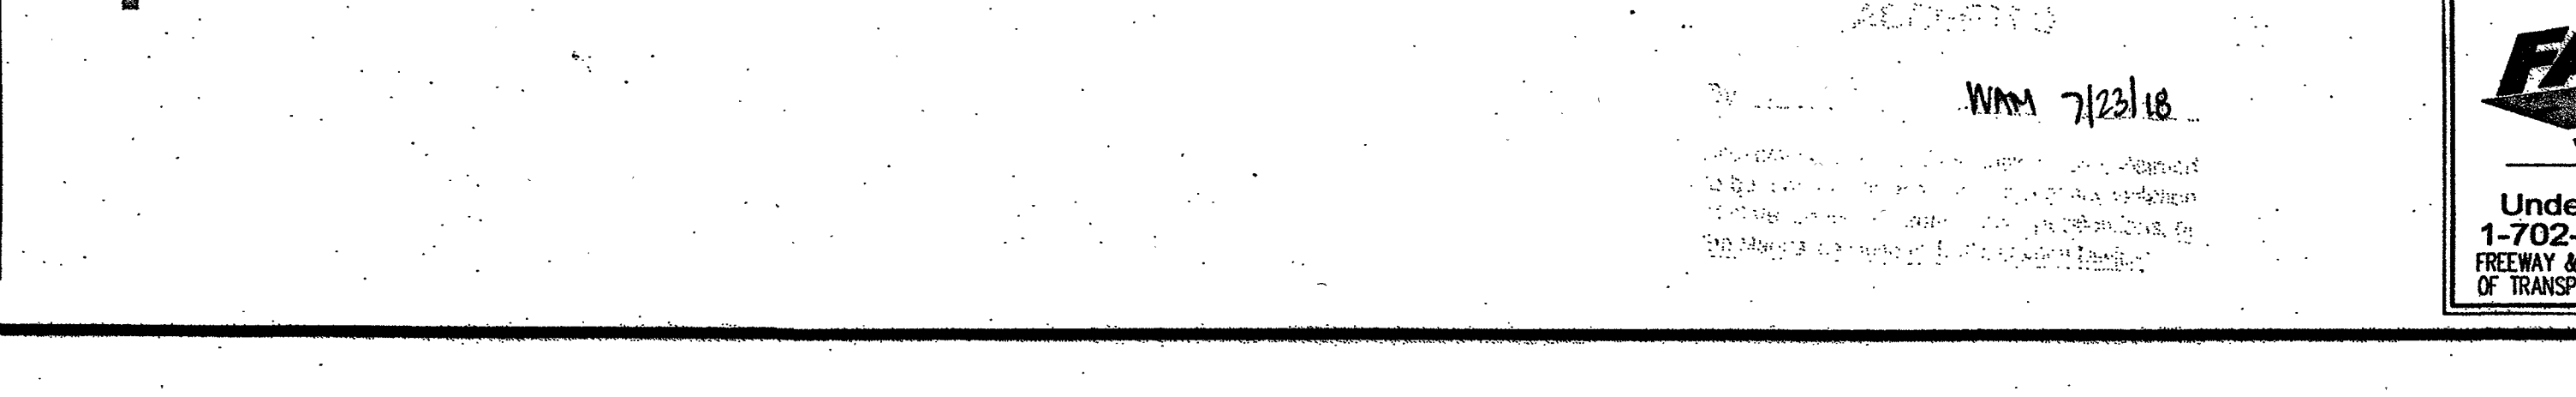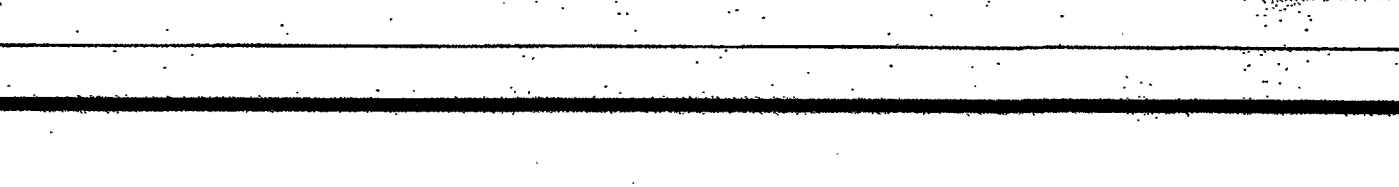

| RAMP TRANSITION LENGTHS |                   |                  |                  |
|-------------------------|-------------------|------------------|------------------|
| RAMP NO.                | GRADE %<br>TO "A" | "A" (FT)<br>MIN. | "B" (FT)<br>MIN. |
| ①                       | -6 TO -5.01       | 4.5'             | 21.5'            |
| ②                       | -5 TO -4.01       | 4.5'             | 15.0'            |
| ③                       | -4 TO -3.01       | 4.5'             | 12.0'            |
| ④                       | -3 TO -2.01       | 4.5'             | 9.5'             |
| ⑤                       | -2 TO 2           | 8.0'             | 8.0'             |
| ⑥                       | 2.01 TO 3         | 9.5'             | 4.5'             |
| ⑦                       | 3.01 TO 4         | 12.0'            | 4.5'             |
| ⑧                       | 4.01 TO 5         | 15.0'            | 4.5'             |
| ⑨                       | 5.01 TO 6         | 21.5'            | 4.5'             |

## TRAFFIC GENERAL NOTES

1. REPLACE ALL TRAFFIC CONTROL DEVICES (SIGNS, ROAD OR PAVEMENT MARKINGS, LIGHTS) CLARK COUNTY'S JURISDICTION, THAT ARE DISTURBED, DESTROYED, MOVED OR MODIFIED BY TRENCING ACTIVITIES TO CLARK COUNTY'S SATISFACTION. ALL MATERIAL USED SHALL MEET CLARK COUNTY'S SPECIFICATIONS OR WILL BE AN APPROVED EQUIVALENT.
2. IN THE EVENT THAT THE TRAFFIC SIGNAL, TRAFFIC LOOP DETECTORS OR ASSOCIATED EQUIPMENT ARE DAMAGED BY CONTRACTOR, THE CONTRACTOR WILL HIRE AN IWA MEMBER IF ELECTRICAL CONTRACTOR TO MAKE REPAIRS FOR UNIFORM SPECIFICATION NO. 625.5-01.02.
3. ALL SENIOR / STORM DRAIN CROSSING WATER TRENCHES SHALL CONFORM TO SECTION 2.2.2 OF THE UNIFORM DESIGN AND CONSTRUCTION STANDARDS FOR POTABLE WATER SYSTEMS (UWSS) FOR WATER AND STORM MAIN CROSSINGS AND CLEARANCES.
4. THE CONTRACTOR IS TO VERIFY THE ACTUAL FIELD CONDITIONS OF ALL LOTS AND INSTALL SENIOR CHECK VALVES WHERE REQUIRED PER THE LATEST EDITION OF THE UNIFORM PLUMBING CODE.

**A. STREETLIGHT LOCATION DETAIL**  
NOT TO SCALE

**BENCHMARK**

BENCHMARK NUMBER: 6LY9019NWW6

RIVET AND PLATE IN A LIVID CONCRETE PAD AT THE NORTHEAST CORNER OF DORRELL LANE & HUALAPAI WAY.

ELEVATION = 2834.10 FEET, 863.834 METERS  
N.A.V.D. 88 DATUM

PER THE CITY OF LAS VEGAS BENCHMARKS - 2008 ADJUSTMENT  
(UPDATED 05/24/2010)

FLOW 1.750 GPM AT 20 P.S.I. RESIDUAL

[illegible]

22

|                                                                                                           |         |
|-----------------------------------------------------------------------------------------------------------|---------|
| DATE:                                                                                                     | 6/5/18  |
| DRAFTER:                                                                                                  | SS      |
| DESIGNER:                                                                                                 | SS      |
| CHECKED:                                                                                                  | KMB     |
| PROJECT NO.                                                                                               | RAH1701 |
|                                                                                                           |         |
| <div style="text-align: center;"> <h1>T-2</h1> <p>SHEET 16 OF 25</p> <p>L18-00373<br/>10756079</p> </div> |         |