

5300 Lytton

4 Hatwood 9-27-79

CITY OF LAS VEGAS, NEVADA

DEPARTMENT OF BUILDING & SAFETY - ELECTRICAL APPLICATION & PERMIT

ADDRESS OF CONSTRUCTION: 5300 Lytton OWNER'S NAME: BOB MULLER Inv # 375

CIRCLE: New Bldg. Add'n.: Remodel; TYPE OF BLDG.: SPD ART. # PUBLIC COMM.

Swimming pool STATE LICENSE # 11728 CITY LICENSE # 06884

CONTRACTOR'S NAME: Center Line Electric

NUMBER	FIXTURE OR INSTALLATION	UNIT PRICE	TOTAL
	Rm addition, carport or garage enclosure	4.00	
	Temporary power	4.00	
1	Light, receptacle or switch outlet	.20	.20
	Wall or ceiling space heater	.35	
	Garbage grinder outlet	.35	
	Dishwasher outlet	.35	
	Clothes dryer outlet	.35	
	Automatic clothes washer	.35	
	Electric range outlet	.35	
	Electric water heater outlet	.35	
	Special purpose outlet	.35	
	X-ray unit and its appurtenances	5.00	
	Watts of festoon lighting (Watts) First 3,000 watts for each additional thousand watts	4.00 1.50	
1	Horsepower each motor first horsepower or less for each additional horsepower	1.75 .35	1.75
	Electric (including any single meter socket) for each additional socket	3.00 .35	
	Air conditioning service	1.50	
	Each KW(KVA) Generator (Transformer, Welder) First 100 KVA for each additional KW(KVA)	2.00 .01	
	Speaker, signal or alarm outlet	.15	
	Amplifiers	.50	
	Control panels	.25	
	Main control racks	1.00	
	T.V. and radio antennas-master system only	.75	
	Minimum fee for any permit	4.00	
	TOTAL FEE		4.00

Approval for the work under this permit will be given only after refuse and debris have been removed from job site and public right of way.

I hereby certify that I have carefully examined and read the above application; that the same is true and correct; and that the work herein described is to be done in accordance with all the provisions of the applicable Ordinances of the City of Las Vegas, Nevada and State laws whether herein specified or not.

SIGNED Cabin C. Page #470 DATE 3/26/74
 MASTER (ELECTRICIAN) (TECHNICIAN) (OWNER)

BUILDING DEPARTMENT Miller DATE 3/26/74

#12860 PERMIT NO. 8982 PERMIT SET 406

RECEIPT

\$04.00

YOUR RECEIPT
THANK YOU

BEST BE MACHINE VALIDATED
29 MAR 69

D. Gloria Caly 10/7/80

CITY OF LAS VEGAS, NEVADA

LOG NO. & AREA

DEPARTMENT OF BUILDING & SAFETY

CONST. VAL. \$

APPLICATION & BUILDING PERMIT for
Fence, Wall, Retaining Wall.

ADDRESS
CONSTRUCTION

5300 Lytton Ave. Las Vegas

OWNER: James O. & Lorraine B. Murphy

LOT(s)

BLOCK

SUBDIVISION

LYTTON HILLS

ZONE

R1

Materials of construction:

Block

Concrete

Wire

Wood

Other

Yes

No

PLANS:

☐

☐

CALCS:

☐

☐

ARCHITECT:

ENGINEER:

CONTRACTOR:

OWNER

STATE
LICENSE #

CITY
LICENSE #


TOTAL SQUARE FEET:

TOTAL LINEAL FEET:

Remarks:

CONDITIONS OF THE PERMIT:

1. Any type of retaining wall must be engineered by a Civil or Structural Engineer.
2. If a home owner takes out the Building Permit and if the owner sublets the work to a Contractor, then the Contractor must take out the permit and pay for it.
3. No fence or wall can be built on City property or rights-of-way, but this is not intended to preclude construction within utility easements if utilities will not be damaged or made inaccessible.
4. The fence or wall shall not enclose any water meter, light standard, or fire alarm box and shall not come closer than 24" from the nearest fire hydrant outlet.
5. Department Inspectors must approve footings before concrete is poured and block wall reinforcing before grouting is done.
6. Maximum height of any wall or fence is 6', side and rear yards; 4' maximum in front yard with the vertical surface above the height of 2' — 50% open.
7. I must not obstruct required on-site parking space (2 spaces for each dwelling unit) by the erection of this fence or wall.
8. By the signing of this application I herewith agree to the requirements outlined above.

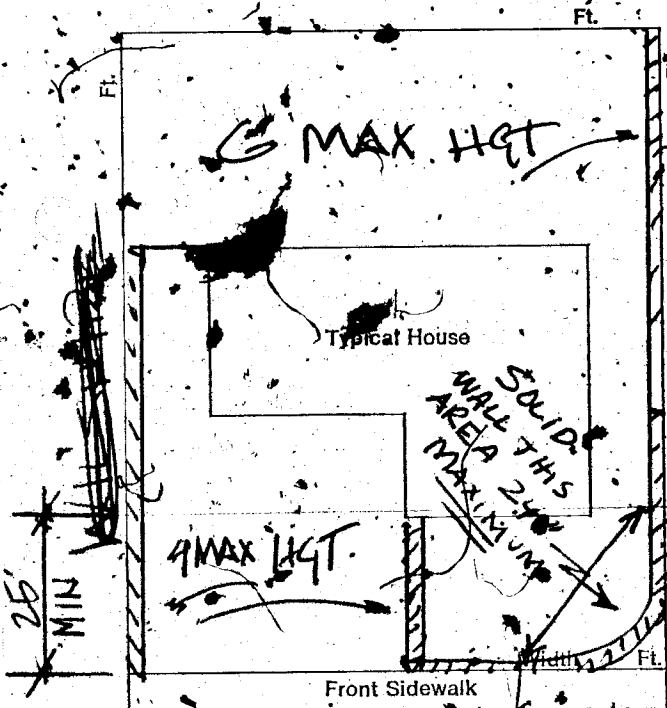

* FENCE HGT ON CORNER MUST
BE APPROVED BY TRAFFIC
ENGINEER

SIGNED:

CONTRACTOR ☐

AGENT ☐

OWNER ☒

DATE:

Date:

4/13/73

Date:

4-13-73

Date:

4-13-73

Date:

900

PLANNING DEPT:

PUBLIC WORKS DEPT:

BUILDING DEPT:

#12850

PERMIT NO:

PERMIT FEE

RECEIPT

4453 \$009.00 8

CITY OF LAS VEGAS
DEPT. OF
BUILDING & SAFETY

MUST BE MACHINE VALIDATED

16 APR 73

DEPARTMENT OF BUILDING & SAFETY
CITY OF LAS VEGAS, NEVADA

OWNER James Murphy

ADDRESS 5300 Lytton Ave.

KARDEX CARD
FENCE & RETAINING
WALLS

DATE 4-13-73

CONTRACTOR Owner

PERMIT NO. 10634

LOT 1 BLOCK 1 SUBDIVISION Char Hills # 1 block fence

Fence (wire, wood, etc.)

Walls (masonry, rock, etc.)

Location

Final Inspection

Location 215-7-73

Footings 215-7-73

Wall Steel 1st

Final Inspection

Retaining Wall (masonry)

Retaining Wall (concrete)

Location

Footings

Wall Steel 1st

Bond Beam 1st

Final Inspection

Location

Footings

Wall Steel 1st

Final Inspection

23.14.8

ADDRESS

LOG NO.

AREA

5300 Lytton Ave.

DEPT. of BLDG & SAFETY—CITY of LAS VEGAS, NEVADA																																																																	
OWNER	ADDRESS	DATE																																																															
RALPH ENGELSTAD	5300 Lytton Ave.	8-15-62																																																															
GEN. CONT.	same	TYPE OF STRUCTURE <u>S.F. Dwl.</u>																																																															
PERMIT NO. <u>11991</u>	LEGAL DESCRIPTION <u>Lot 1 Block 1 Chas. hills #1</u>																																																																
<table border="1"><thead><tr><th>BUILDING</th><th>MECHANICAL</th><th>ELECTRICAL</th></tr></thead><tbody><tr><td>LOCATION <u>215-7-73</u></td><td>PLUMBING CONT. <u>215-7-73</u></td><td>TEMP. POLE CONT. <u>215-7-73</u></td></tr><tr><td>FIREPLACE FTS.</td><td>PERMIT NO. <u>7292</u> DATE <u>8-12-62</u></td><td>PERMIT NO. <u>10634</u> DATE <u>4-13-73</u></td></tr><tr><td>FOOTINGS <u>215-7-73</u></td><td>HEAT & VENT. AC CONT. <u>Hairwell</u></td><td>INSPECTION <u>215-7-73</u> DATE <u>4-13-73</u></td></tr><tr><td>FOUNDATION WALL</td><td>PERMIT NO. <u>4465</u> DATE <u>2-12-62</u></td><td>ELECTRICAL CONT. <u>215-7-73</u> DATE <u>4-13-73</u></td></tr><tr><td>STEM WALL <u>Burly 8-28-62</u></td><td>SEWER CONT. <u>215-7-73</u></td><td>PERMIT NO. <u>5577</u> DATE <u>5-24-62</u></td></tr><tr><td>FLOOR FRAMING</td><td>PERMIT NO. <u>7292</u> DATE <u>8-12-62</u></td><td>FIXTURES CONT. <u>215-7-73</u> DATE <u>4-13-73</u></td></tr><tr><td>SLAB <u>Burly 8-5-62</u></td><td>ROUGH SOL. <u>215-7-73</u></td><td>PERMIT NO. <u>10634</u> DATE <u>4-13-73</u></td></tr><tr><td>CHIMNEY STEEL (FIREPLACE) <u>Burly 8-18-62</u></td><td>ROUGH WATER <u>215-7-73</u></td><td>SLAB <u>215-7-73</u> DATE <u>4-13-73</u></td></tr><tr><td>WALL STEEL</td><td>TOP-OUT <u>215-7-73</u></td><td>ROUGH <u>215-7-73</u> DATE <u>4-13-73</u></td></tr><tr><td>COLUMN STEEL</td><td>ROUGH GAS <u>215-7-73</u></td><td>FINAL ROUGH <u>215-7-73</u> DATE <u>4-13-73</u></td></tr><tr><td>BEAM STEEL</td><td>AC ROUGH DUCT <u>215-7-73</u></td><td>FINAL FIXTURE <u>215-7-73</u> DATE <u>4-13-73</u></td></tr><tr><td>STEEL FABRICATION</td><td>REF. ROUGH PIPING <u>215-7-73</u></td><td>TEMPORARY SERVICE <u>215-7-73</u> DATE <u>4-13-73</u></td></tr><tr><td>FRAMING <u>Chas. 10-9-62</u></td><td>FINAL PLUMBING <u>215-7-73</u></td><td></td></tr><tr><td>ROOF SHEATHING <u>215-7-73</u></td><td>FINAL GAS <u>215-7-73</u></td><td></td></tr><tr><td>INTERIOR</td><td>FINAL AIR COND. <u>215-7-73</u></td><td></td></tr><tr><td>DRYWALL <u>HB 2-24-62</u></td><td>FINAL REFRIG. <u>215-7-73</u></td><td></td></tr><tr><td>LATHING <u>HB 10-18-62</u></td><td>FINAL SEWER <u>215-7-73</u></td><td></td></tr><tr><td>BACKING (SIDING)</td><td>FINAL SEPTIC TANK <u>215-7-73</u></td><td></td></tr><tr><td>PLASTER <u>215-7-73</u></td><td></td><td></td></tr><tr><td>FINAL BLDG <u>215-7-73</u> DATE <u>12-12-62</u></td><td></td><td></td></tr></tbody></table>			BUILDING	MECHANICAL	ELECTRICAL	LOCATION <u>215-7-73</u>	PLUMBING CONT. <u>215-7-73</u>	TEMP. POLE CONT. <u>215-7-73</u>	FIREPLACE FTS.	PERMIT NO. <u>7292</u> DATE <u>8-12-62</u>	PERMIT NO. <u>10634</u> DATE <u>4-13-73</u>	FOOTINGS <u>215-7-73</u>	HEAT & VENT. AC CONT. <u>Hairwell</u>	INSPECTION <u>215-7-73</u> DATE <u>4-13-73</u>	FOUNDATION WALL	PERMIT NO. <u>4465</u> DATE <u>2-12-62</u>	ELECTRICAL CONT. <u>215-7-73</u> DATE <u>4-13-73</u>	STEM WALL <u>Burly 8-28-62</u>	SEWER CONT. <u>215-7-73</u>	PERMIT NO. <u>5577</u> DATE <u>5-24-62</u>	FLOOR FRAMING	PERMIT NO. <u>7292</u> DATE <u>8-12-62</u>	FIXTURES CONT. <u>215-7-73</u> DATE <u>4-13-73</u>	SLAB <u>Burly 8-5-62</u>	ROUGH SOL. <u>215-7-73</u>	PERMIT NO. <u>10634</u> DATE <u>4-13-73</u>	CHIMNEY STEEL (FIREPLACE) <u>Burly 8-18-62</u>	ROUGH WATER <u>215-7-73</u>	SLAB <u>215-7-73</u> DATE <u>4-13-73</u>	WALL STEEL	TOP-OUT <u>215-7-73</u>	ROUGH <u>215-7-73</u> DATE <u>4-13-73</u>	COLUMN STEEL	ROUGH GAS <u>215-7-73</u>	FINAL ROUGH <u>215-7-73</u> DATE <u>4-13-73</u>	BEAM STEEL	AC ROUGH DUCT <u>215-7-73</u>	FINAL FIXTURE <u>215-7-73</u> DATE <u>4-13-73</u>	STEEL FABRICATION	REF. ROUGH PIPING <u>215-7-73</u>	TEMPORARY SERVICE <u>215-7-73</u> DATE <u>4-13-73</u>	FRAMING <u>Chas. 10-9-62</u>	FINAL PLUMBING <u>215-7-73</u>		ROOF SHEATHING <u>215-7-73</u>	FINAL GAS <u>215-7-73</u>		INTERIOR	FINAL AIR COND. <u>215-7-73</u>		DRYWALL <u>HB 2-24-62</u>	FINAL REFRIG. <u>215-7-73</u>		LATHING <u>HB 10-18-62</u>	FINAL SEWER <u>215-7-73</u>		BACKING (SIDING)	FINAL SEPTIC TANK <u>215-7-73</u>		PLASTER <u>215-7-73</u>			FINAL BLDG <u>215-7-73</u> DATE <u>12-12-62</u>		
BUILDING	MECHANICAL	ELECTRICAL																																																															
LOCATION <u>215-7-73</u>	PLUMBING CONT. <u>215-7-73</u>	TEMP. POLE CONT. <u>215-7-73</u>																																																															
FIREPLACE FTS.	PERMIT NO. <u>7292</u> DATE <u>8-12-62</u>	PERMIT NO. <u>10634</u> DATE <u>4-13-73</u>																																																															
FOOTINGS <u>215-7-73</u>	HEAT & VENT. AC CONT. <u>Hairwell</u>	INSPECTION <u>215-7-73</u> DATE <u>4-13-73</u>																																																															
FOUNDATION WALL	PERMIT NO. <u>4465</u> DATE <u>2-12-62</u>	ELECTRICAL CONT. <u>215-7-73</u> DATE <u>4-13-73</u>																																																															
STEM WALL <u>Burly 8-28-62</u>	SEWER CONT. <u>215-7-73</u>	PERMIT NO. <u>5577</u> DATE <u>5-24-62</u>																																																															
FLOOR FRAMING	PERMIT NO. <u>7292</u> DATE <u>8-12-62</u>	FIXTURES CONT. <u>215-7-73</u> DATE <u>4-13-73</u>																																																															
SLAB <u>Burly 8-5-62</u>	ROUGH SOL. <u>215-7-73</u>	PERMIT NO. <u>10634</u> DATE <u>4-13-73</u>																																																															
CHIMNEY STEEL (FIREPLACE) <u>Burly 8-18-62</u>	ROUGH WATER <u>215-7-73</u>	SLAB <u>215-7-73</u> DATE <u>4-13-73</u>																																																															
WALL STEEL	TOP-OUT <u>215-7-73</u>	ROUGH <u>215-7-73</u> DATE <u>4-13-73</u>																																																															
COLUMN STEEL	ROUGH GAS <u>215-7-73</u>	FINAL ROUGH <u>215-7-73</u> DATE <u>4-13-73</u>																																																															
BEAM STEEL	AC ROUGH DUCT <u>215-7-73</u>	FINAL FIXTURE <u>215-7-73</u> DATE <u>4-13-73</u>																																																															
STEEL FABRICATION	REF. ROUGH PIPING <u>215-7-73</u>	TEMPORARY SERVICE <u>215-7-73</u> DATE <u>4-13-73</u>																																																															
FRAMING <u>Chas. 10-9-62</u>	FINAL PLUMBING <u>215-7-73</u>																																																																
ROOF SHEATHING <u>215-7-73</u>	FINAL GAS <u>215-7-73</u>																																																																
INTERIOR	FINAL AIR COND. <u>215-7-73</u>																																																																
DRYWALL <u>HB 2-24-62</u>	FINAL REFRIG. <u>215-7-73</u>																																																																
LATHING <u>HB 10-18-62</u>	FINAL SEWER <u>215-7-73</u>																																																																
BACKING (SIDING)	FINAL SEPTIC TANK <u>215-7-73</u>																																																																
PLASTER <u>215-7-73</u>																																																																	
FINAL BLDG <u>215-7-73</u> DATE <u>12-12-62</u>																																																																	
APPROVED FOR OCCUPANCY <u>June 12 12-62</u> INSPECTOR <u>215-7-73</u>																																																																	
APPROVED FOR METER <u>7/11/62 12-62</u>																																																																	
PLEASE NOTE REMARKS ON REVERSE SIDE																																																																	

5300 Lytton Ave.

T-31

4