

2813 Milo Way

L 14 B 14

RICHFIELD VILLAGE #4-A

ZONE R-1

G. Gatewood December 4, 1970

CITY OF LAS VEGAS, NEVADA

LOG NO. & AREA

DEPARTMENT OF BUILDING & SAFETY

APPLICATION & BUILDING PERMIT - for:

Dwellings, Duplexes, Misc. Residential Const.

ADDRESS OF CONSTRUCTION: 2813 MILO WAY

OWNER: JACK J BERTOLA

LOT(s) 14 BLOCK 14 SUBDIVISION RICHFIELD VILLAGE UN #4A ZONE: R-1

Existing structure on lot: Dwelling ☐ Accessory bldgs. ☐ Vacant lot ☐ Other ☐

PROPOSED CONSTRUCTION: ENCL CARPORT (2 walls) USE: Hobby shops

MATERIALS OF CONSTRUCTION: Wood Frame ☐ Concrete Block ☐ Reinforced Concrete ☐ Steel Frame ☐

SQUARE FEET OF FLOOR AREAS: 1st 2nd 3rd Other TOTAL SQ. FT. 200


FIRE ZONE: 1 2 3 Occupancy Group A B C D E F G H I J-1-2-3-4-5 CONST. TYPE: I II III IV V

ARCHITECT: ENGINEER: NO. of UNITS NO. of STORIES

Plans Submitted: Yes ☐ No ☐ Calculations Submitted: Yes ☐ No ☐ Sewer Fee Req'd. Yes ☐ No ☐

CONTRACTOR: OWNER STATE LICENSE # CITY LICENSE #

ADD'L. PERMITS REQ'D: Air Cond. ☐ Elec. ☒ Plumbing ☐ Signs ☐ Paving ☐ Fence ☐ Public Walks ☐ Curb-gutters ☐ Incinerators ☐ Fire Sprinkling System ☐

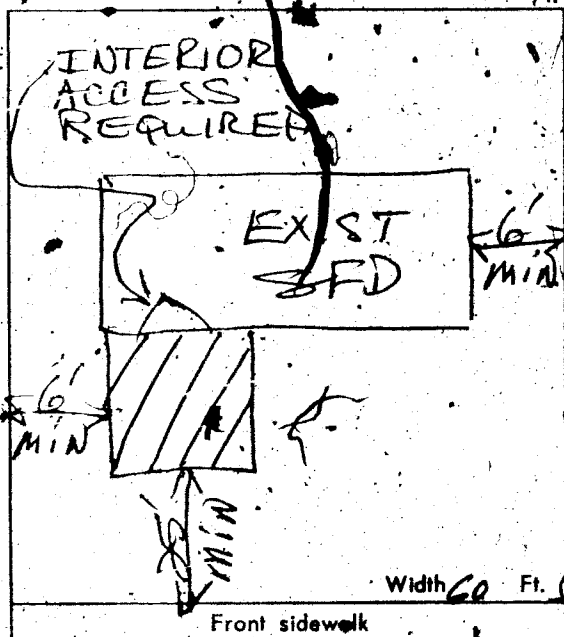

CONDITIONS OF THE PERMIT:

- I agree to call the City Building Department for inspections before concrete is poured, before rough wiring, electrical, plumbing, framing is covered. Also for Air conditioning, sheet-rock and sheathing inspection.
- I agree that when the job is completed that I will call for final inspection before occupancy.
- I agree to perform all construction in accordance with City Ordinances and Building Codes.
- The Contractor's signature below denotes authority from the owner to sign in his behalf and that the owner is aware of all requirements of this application and permit. Separate permits must be taken out for work outlined above this agreement.
- I have read and understand the contents of this application and permit; I hereby state that the information I have supplied on this application is true and correct.

SIGNED: JACK J. BERTOLA Contractor

BY: Agent or Owner

CLARK COUNTY HEALTH DEPT.

LAS VEGAS FIRE DEPARTMENT

PLANNING DEPT: M. Q. Date: 1-30-70

PUBLIC WORKS DEPT: R. P. Date: 1-30-70

BUILDING DEPT: R. P. Date: 1-30-70

PERMIT NO: 50936 PERMIT FEE \$ 600

RECEIPT

8523 \$006.00 - 8

CITY OF LAS VEGAS
DEPT. OF
BUILDING & SAFETY

MUST BE MACHINE VALIDATED
- 2 FEB 70

Nov 7/1963

10-5-82

DEPT. of BLDG & SAFETY—CITY of LAS VEGAS, NEVADA

OWNER J. J. BERTOLA ADDRESS 2813 Milo Way DATE 2/2/ 70

GEN. CONT. owner TYPE OF STRUCTURE Emc carport

PERMIT NO. 50936 LEGAL DESCRIPTION _____

BUILDING		MECHANICAL	ELECTRICAL
LOCATION _____	PLUMBING CONT. _____	TEMP. POLE CONT. _____	
FIREPLACE FTS. _____	PERMIT NO. _____ DATE _____	PERMIT NO. <u>7</u> DATE _____	
FOOTINGS _____	HEAT & VENT. AC CONT. _____	INSPECTION _____ DATE _____	
FOUNDATION WALL _____	PERMIT NO. _____ DATE _____	ELECTRICAL CONT. _____	
FLOOR FRAMING _____	SEWER CONT. _____	PERMIT NO. _____ DATE _____	
SLAB _____	PERMIT NO. _____ DATE _____	FIXTURES CONT. _____	
CHIMNEY STEEL (FIREPLACE) _____	ROUGH SOIL _____	PERMIT NO. _____ DATE _____	
WALL STEEL _____	ROUGH WATER _____	SLAB _____	
COLUMN STEEL _____	TOP-OUT _____	ROUGH _____	
BEAM STEEL _____	ROUGH GAS _____	FINAL ROUGH _____	
FRAMING _____	AC ROUGH DUCT _____	FINAL FIXTURE _____	
ROOF SHEATHING _____	REF. ROUGH PIPING _____	FINAL ELECTRICAL _____	
INTERIOR _____	FINAL PLUMBING _____	TEMPORARY SERVICE _____	
EXTERIOR _____	FINAL GAS _____		
DRYWALL _____	FINAL AIR COND. _____		
LATHING _____	FINAL REFRIG. _____		
BACKING (SHIMS) _____	FINAL SEWER _____		
PLASTER SCRATCH _____	FINAL SEPTIC TANK _____		
PLASTER BROWN _____			
URBAN REDEVELOPMENT APPROVAL _____			
FINAL BLDG. _____ DATE <u>6-22-70</u>			

no inspection

APPROVED FOR OCCUPANCY & METER _____

INSPECTOR _____ DATE _____

PLEASE NOTE REMARKS ON REVERSE SIDE 2813 Milo Way LOG # _____ AREA # _____ 23.04

DEPT. of BLDG & SAFETY—CITY of LAS VEGAS, NEVADA

OWNER Alameda Homes Corp ADDRESS 2813 Milo Way DATE 10-22-62

GEN. CONT. Same TYPE OF STRUCTURE SFD

PERMIT NO. 13428 LEGAL DESCRIPTION Lot 14 block 14 Richfield Village #4 A

BUILDING		MECHANICAL	ELECTRICAL
LOCATION <u>June 11-28-62</u>	PLUMBING CONT. <u>Hammond</u>	TEMP. POLE CONT. _____	
FIREPLACE FTS. _____	PERMIT NO. <u>11364</u> DATE <u>11-28-62</u>	PERMIT NO. _____ DATE _____	
FOOTINGS <u>June 11-28-62</u>	HEAT & VENT. AC CONT. <u>Hammond</u>	INSPECTION _____ DATE _____	
FOUNDATION WALL _____	PERMIT NO. <u>527</u> DATE <u>11-28-62</u>	ELECTRICAL CONT. <u>Hammond</u>	
STEM WALL _____	SEWER CONT. <u>Hammond</u>	PERMIT NO. <u>11364</u> DATE <u>11-28-62</u>	
FLOOR FRAMING _____	PERMIT NO. <u>11364</u> DATE <u>11-28-62</u>	FIXTURES CONT. _____	
SLAB <u>June 11-28-62</u> <u>H322563</u>	ROUGH SOIL <u>Bully 1-2-63</u>	PERMIT NO. _____ DATE _____	
CHIMNEY STEEL (FIREPLACE) _____	ROUGH WATER <u>Bully 1-2-63</u>	SLAB <u>Miller 2-5-63</u>	
WALL STEEL _____	TOP-OUT <u>Bully 2-5-63</u>	ROUGH _____	
COLUMN STEEL _____	ROUGH GAS <u>Miller 2-5-63</u>	FINAL ROUGH _____	
BEAM STEEL _____	AC ROUGH DUCT <u>Miller 2-5-63</u>	FINAL FIXTURE _____	
STEEL FABRICATION _____	REF. ROUGH PIPING _____	TEMPORARY SERVICE _____	
FRAMING <u>H3 2-5-63</u>	FINAL PLUMBING <u>SW 5-27-63</u>		
ROOF SHEATHING <u>H3 2-5-63</u>	FINAL GAS <u>SW 5-27-63</u>		
INTERIOR _____	FINAL AIR COND. <u>SW 5-27-63</u>		
EXTERIOR _____	FINAL REFRIG. _____		
DRYWALL <u>1-5-63</u>	FINAL SEWER <u>Miller 2-5-63</u>		
LATHING _____	FINAL SEPTIC TANK _____		
BACKING (SHIMS) <u>H3 2-5-63</u>			
PLASTER SCRATCH _____			
PLASTER BROWN _____			
FINAL BLDG. <u>LL</u> DATE <u>5-23-63</u>			

APPROVED FOR OCCUPANCY LL 5-23-63

APPROVED FOR METER Miller 5-23-63

INSPECTOR _____ DATE _____

PLEASE NOTE REMARKS ON REVERSE SIDE 2813 Milo Way LOG # T 61 AREA # 4 23.04